


5-03  
BUT

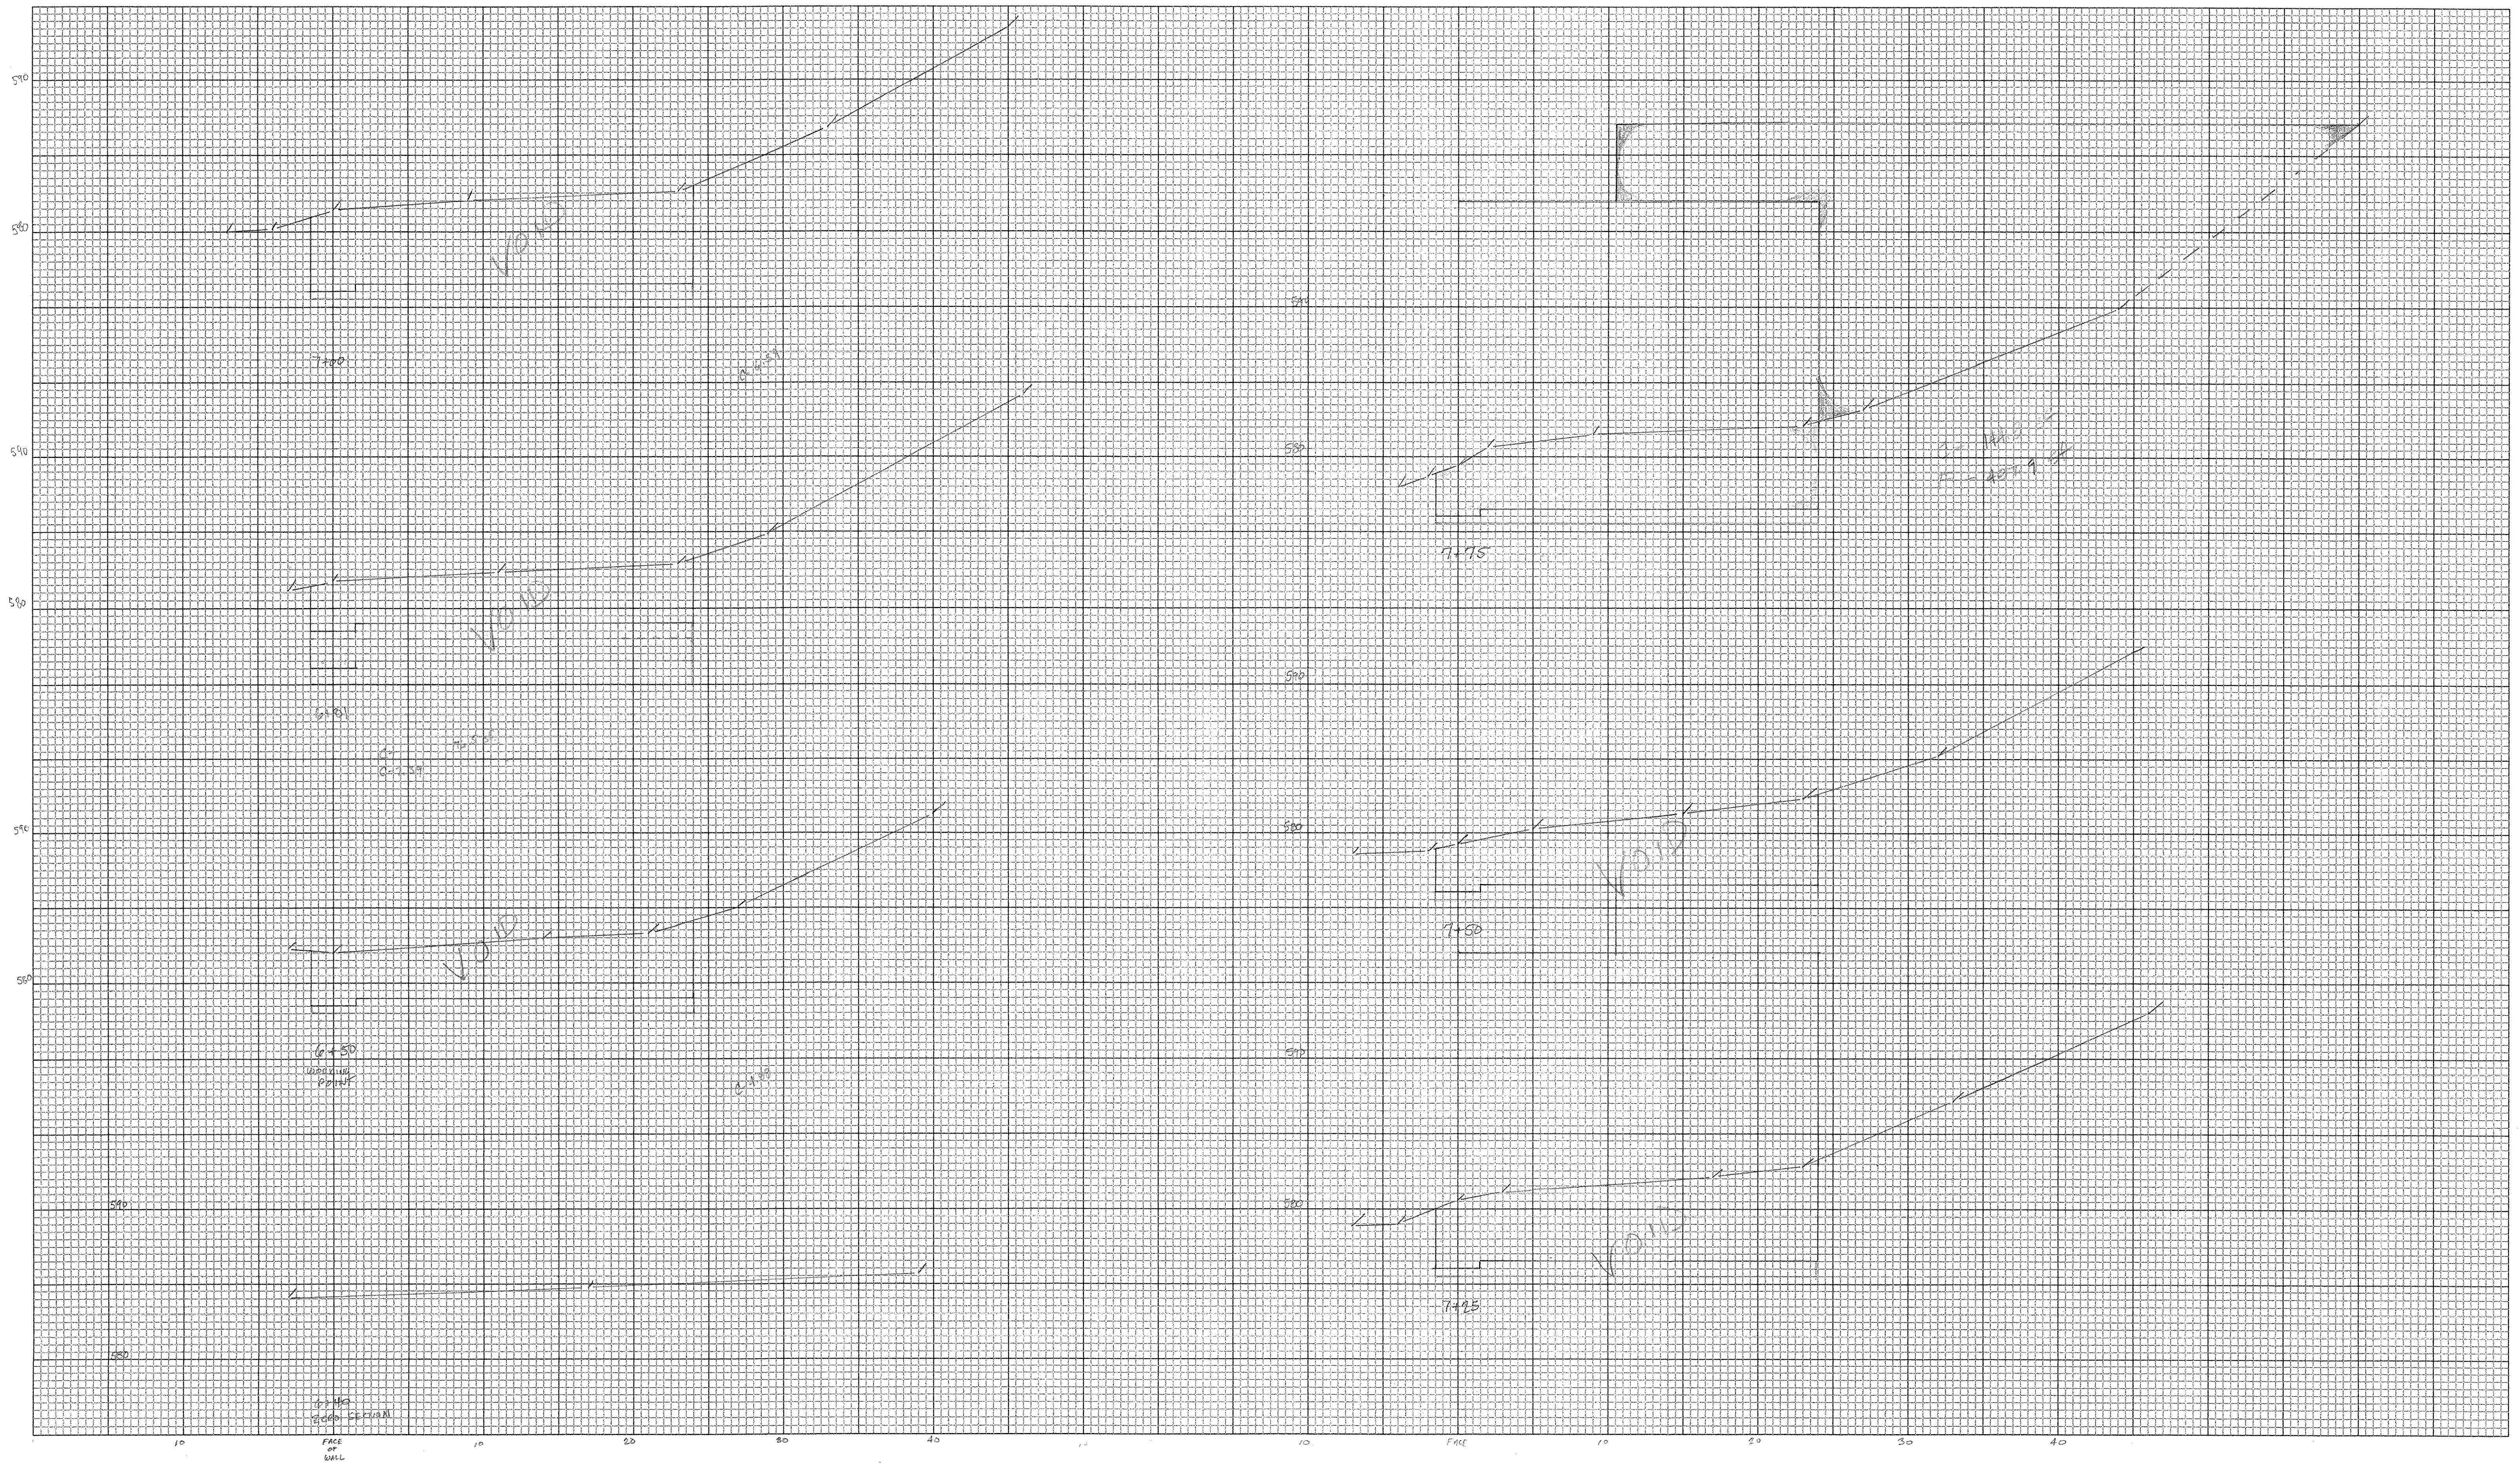

Blue - Structure Excavation  
 Green - Granular Borrow

# CROSS SECTION SHEET

PROJECT NAME: FAIR FAX - ST. ALBAN 2nd 099-3 (27)  
 PROJECT NUMBER: \_\_\_\_\_  
 FILE NAME: STRUCTURE EXCAVATION @ MSE WALL #2 PLOT DATE: 05-JUN-2000 09  
 PROJECT LEADER: \_\_\_\_\_ DRAWN BY: KNP/CS  
 DESIGNED BY: \_\_\_\_\_ CHECKED BY: 39/  
 const: g:/common/cadd/e-xsection.dgn SHEET 2 OF 3

1" = 5 ft