
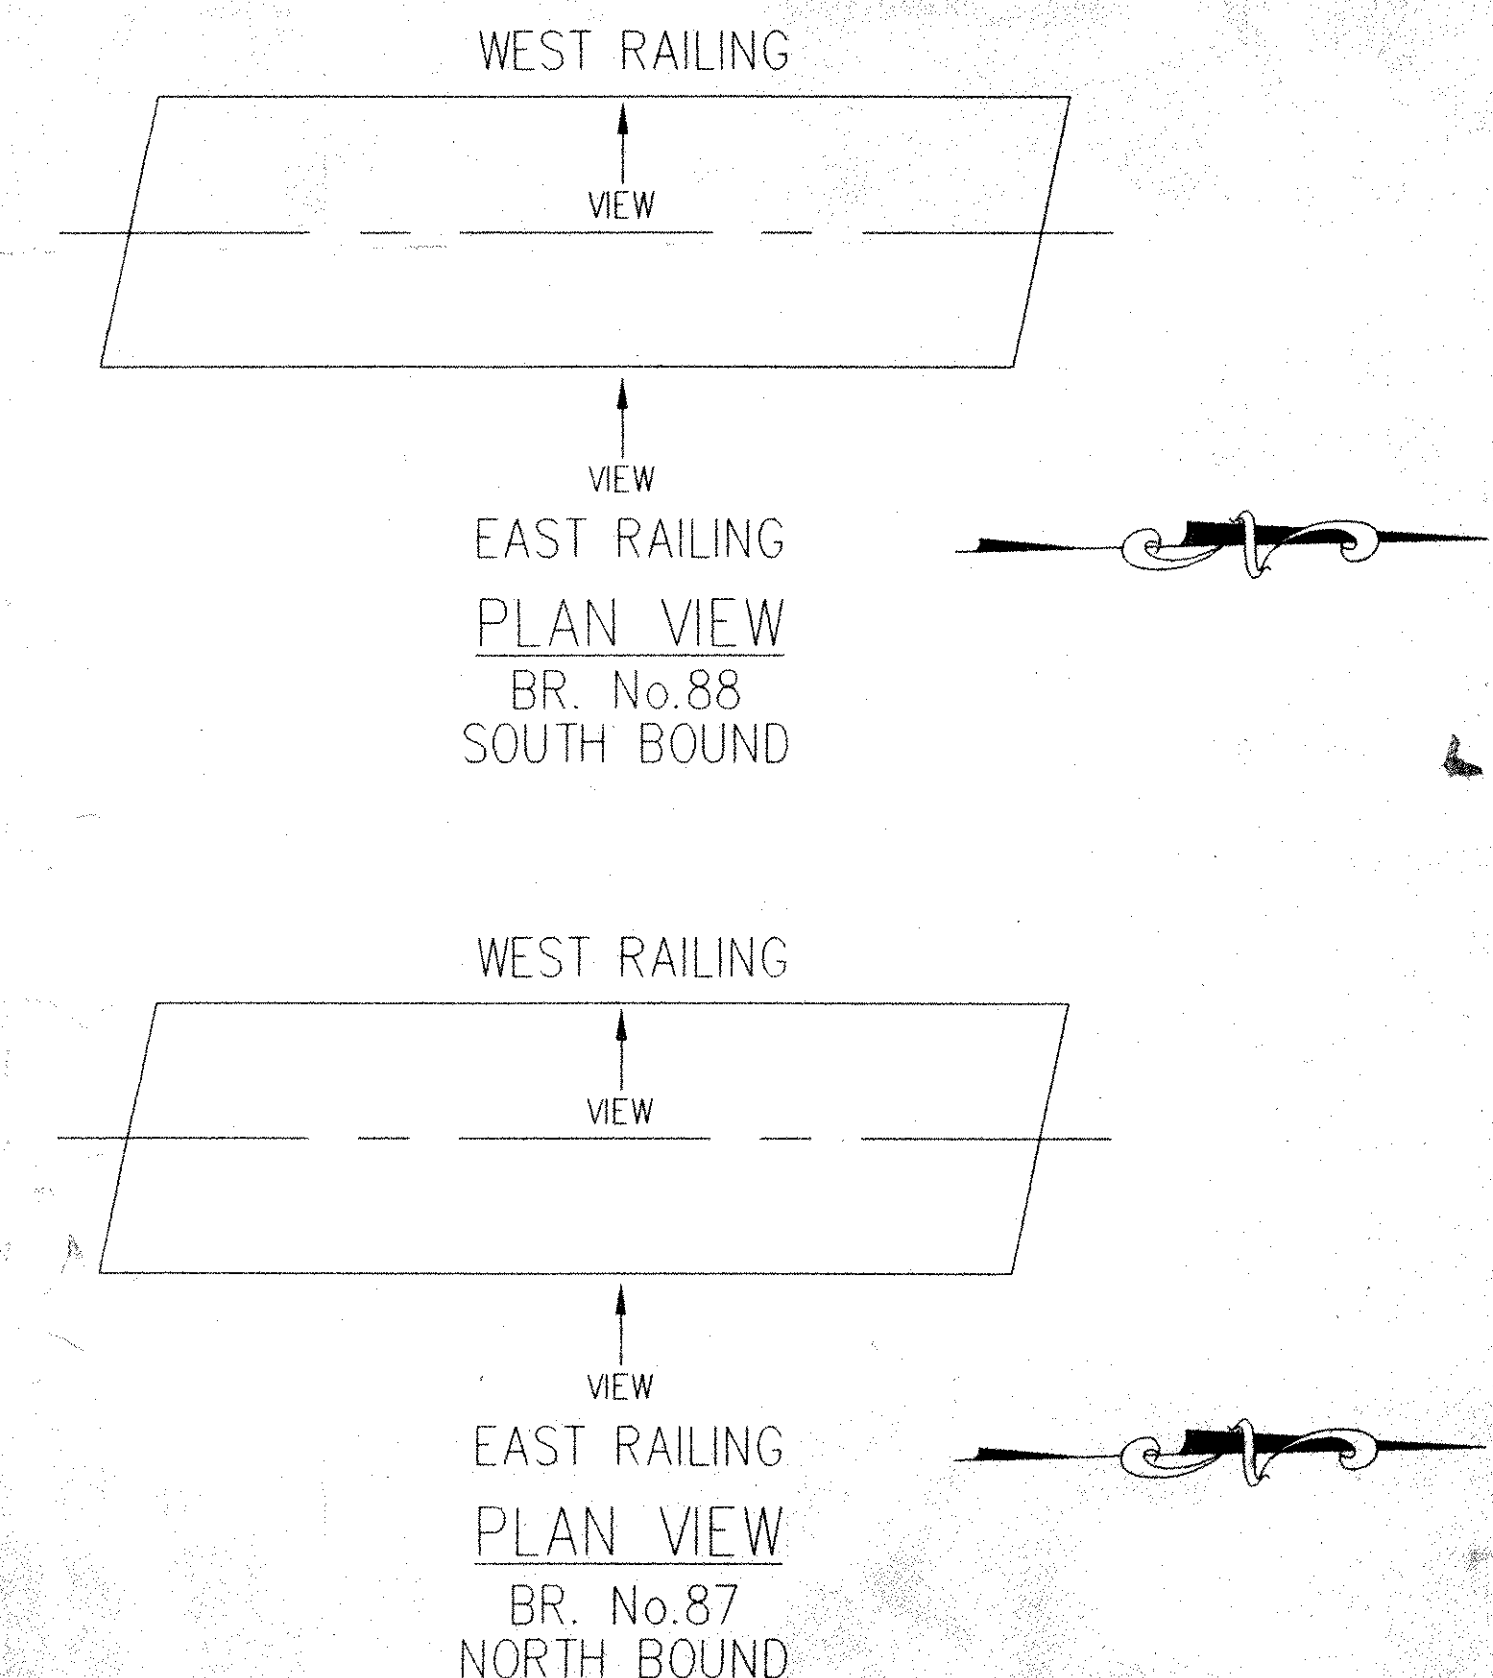
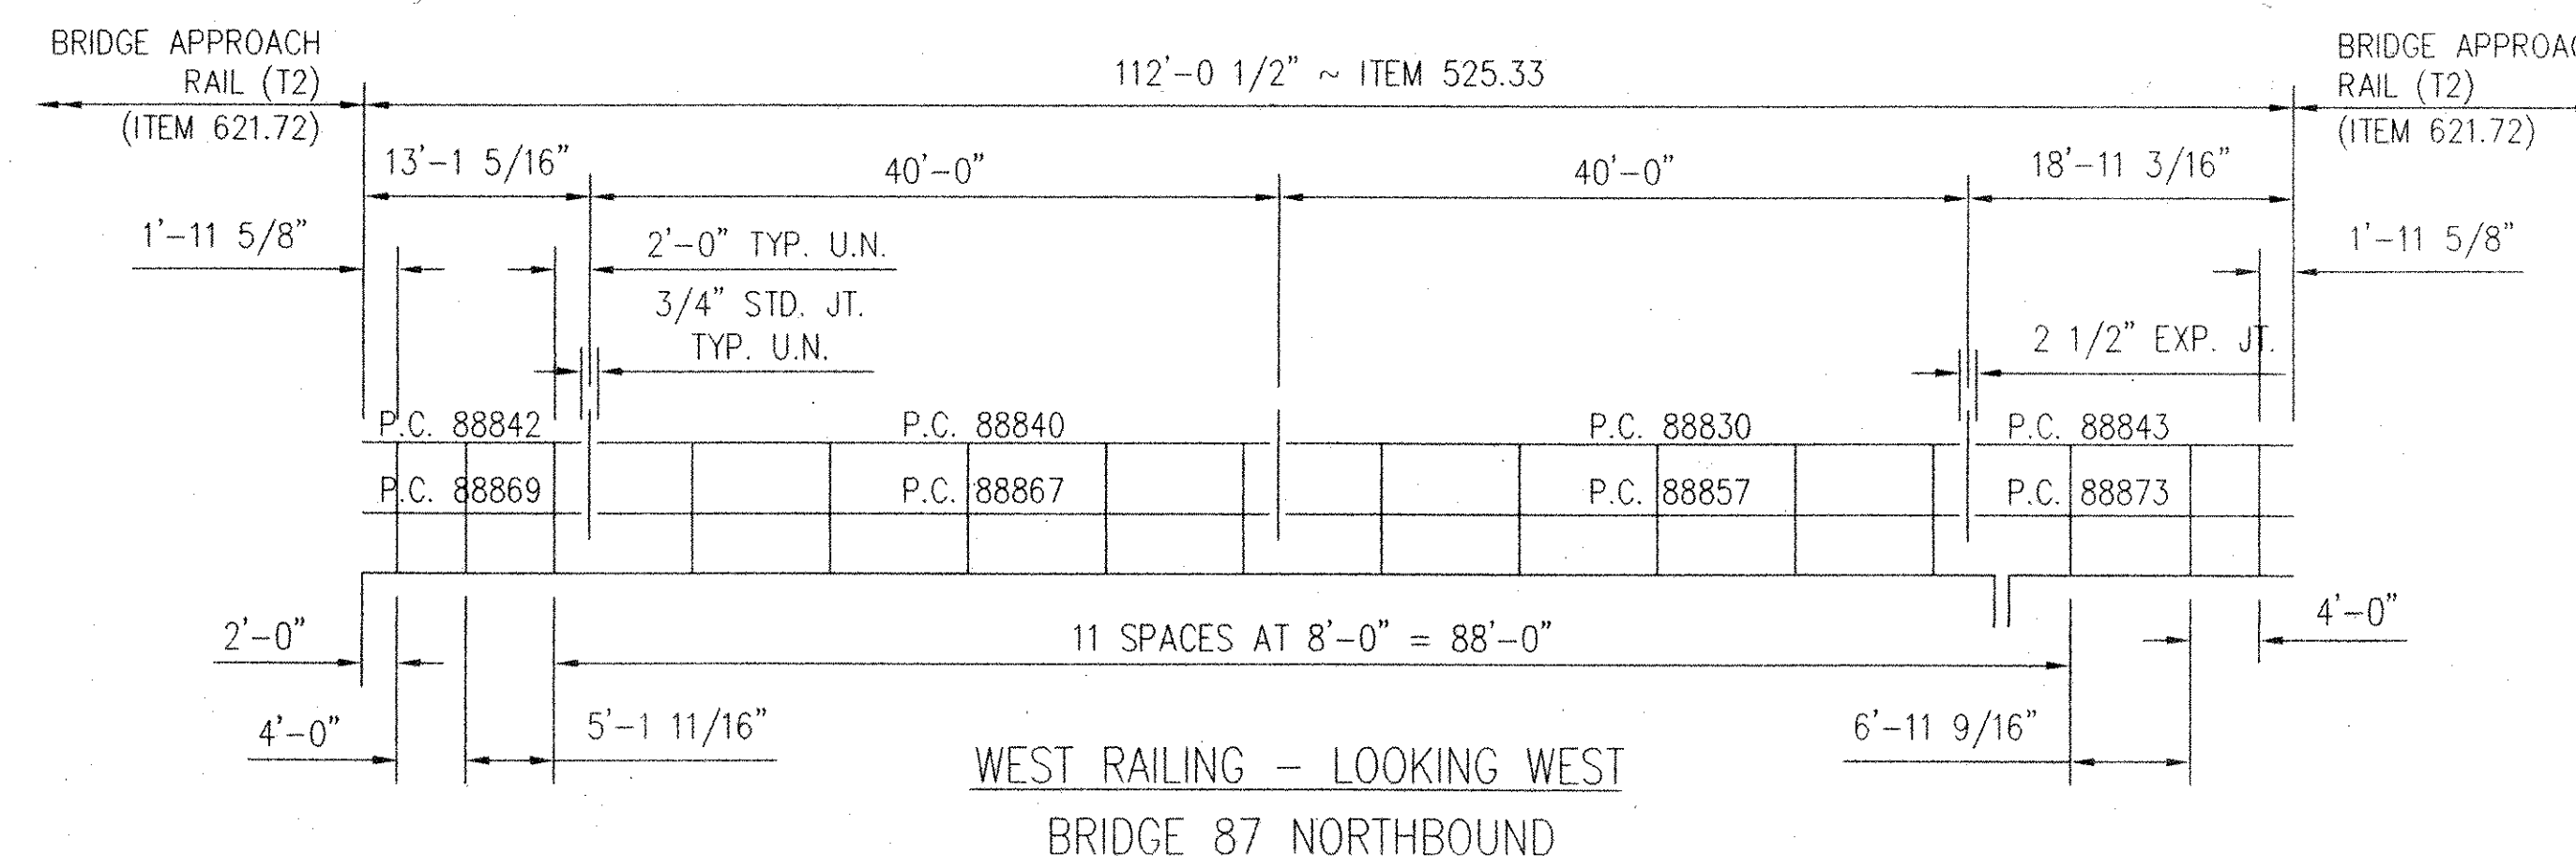
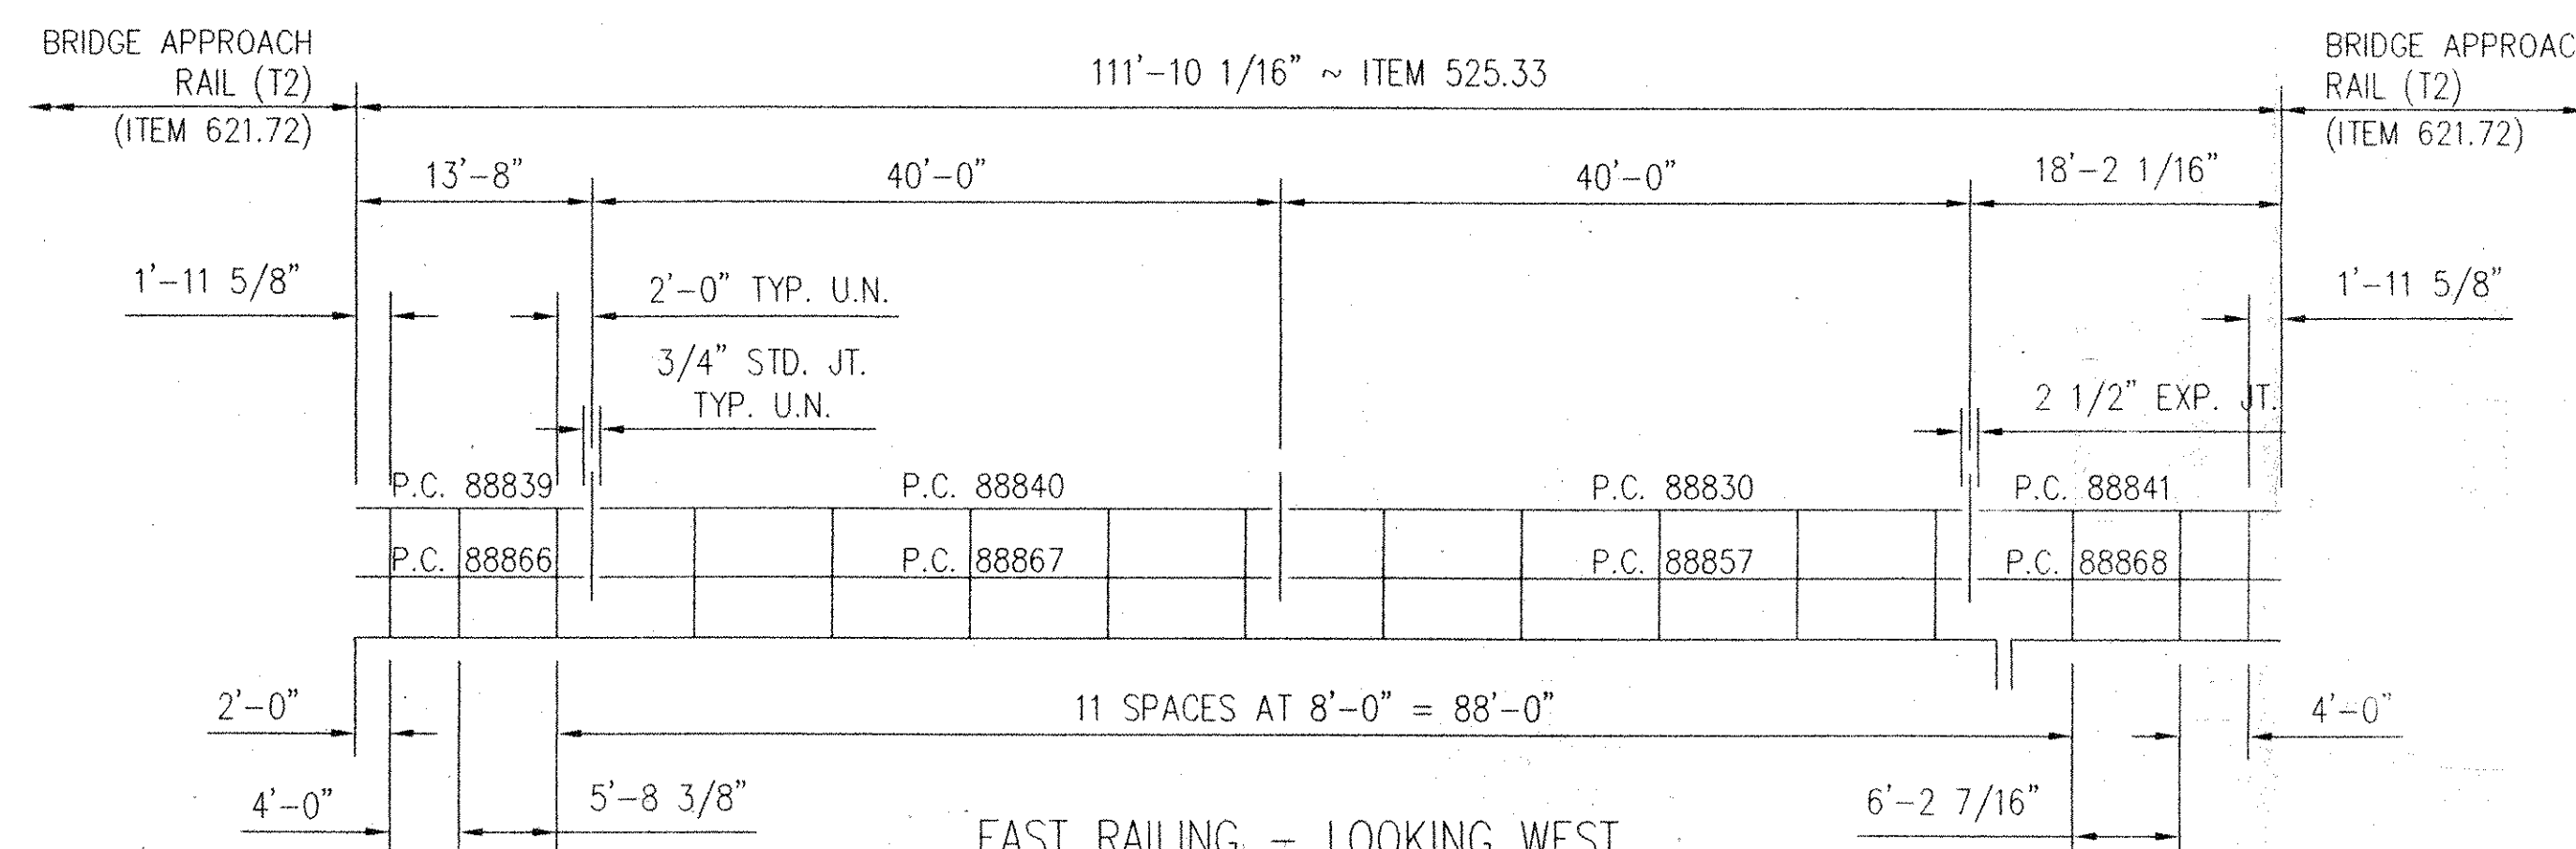
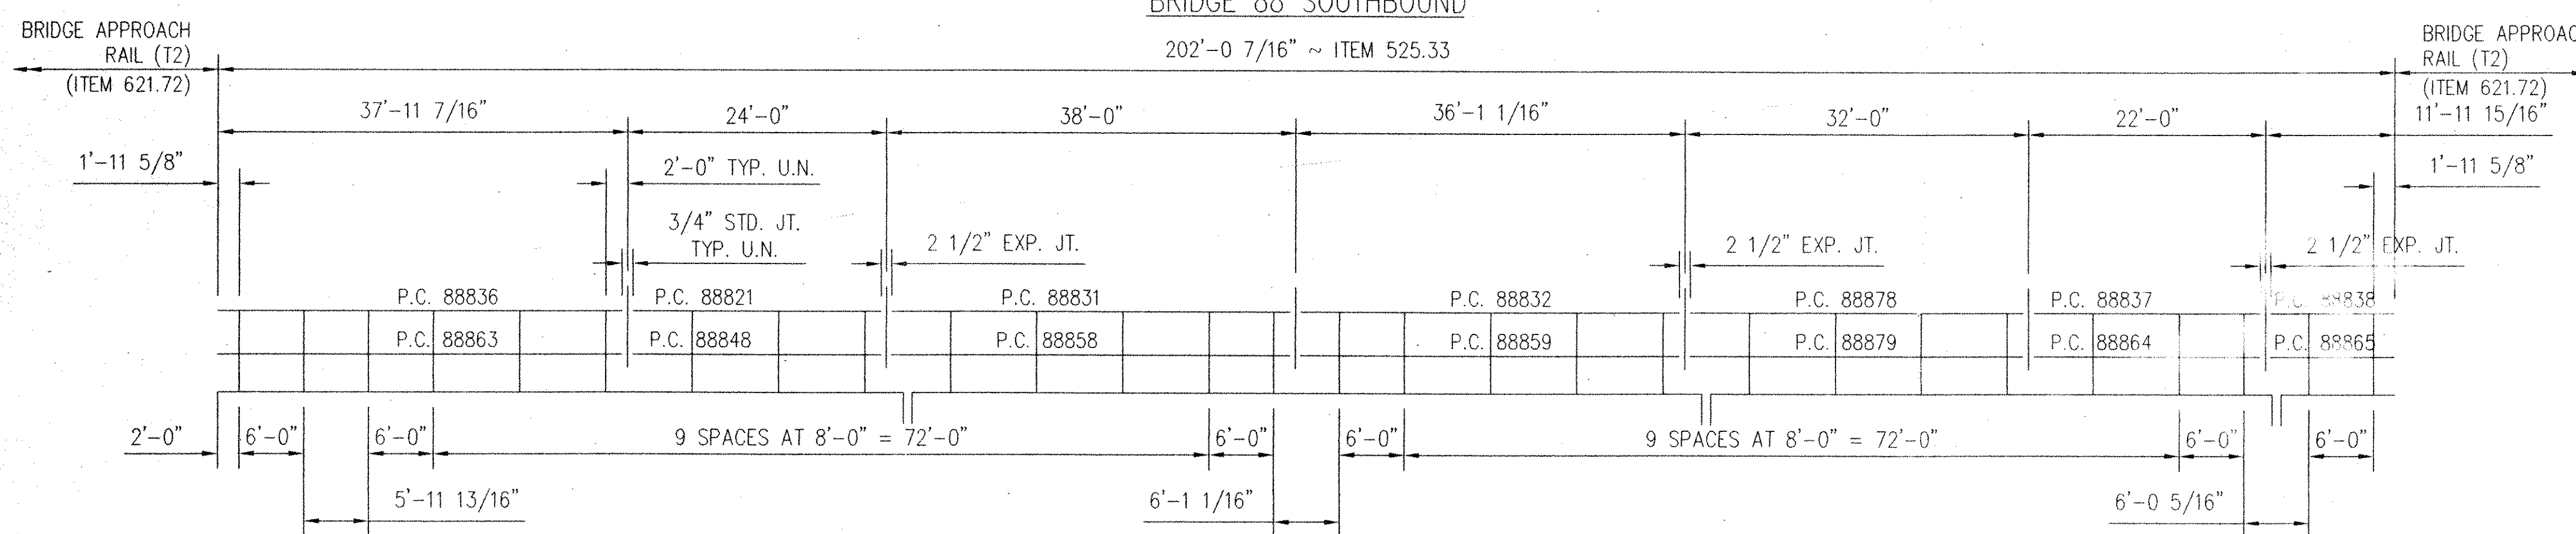


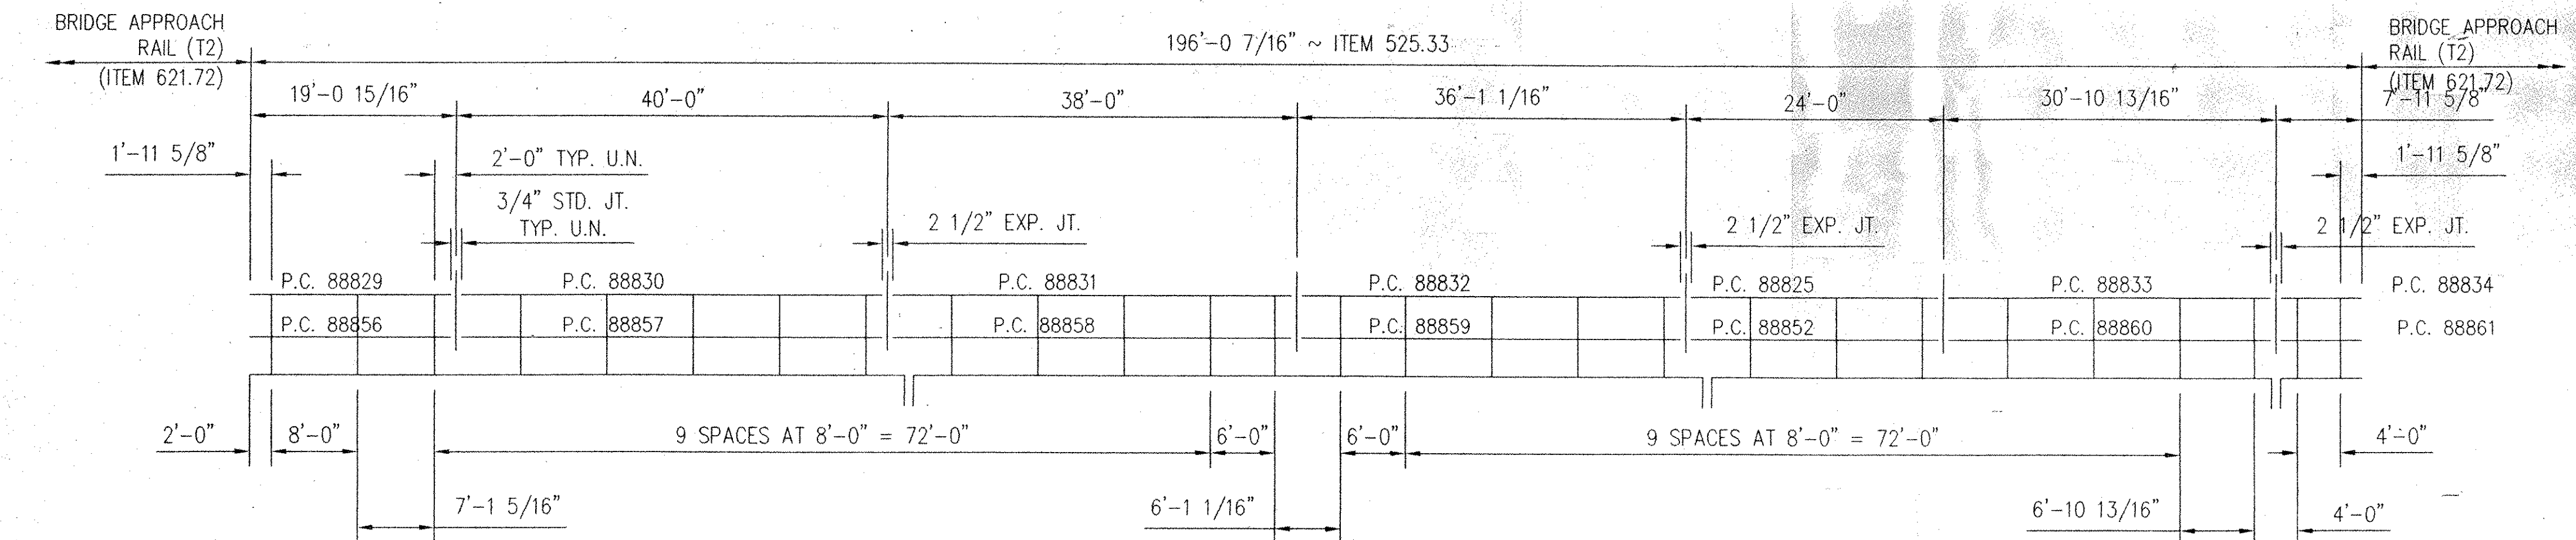

GIRARD ENGINEERING DEPT.
ISSUED
 MAY 17 2001
 TRINITY INDUSTRIES, INC.
 1170 N. STATE STREET
 GIRARD, OHIO 44420

APPROVAL DRAWING

FOR DETAILS SEE SHEET D1, D2, D3 & D4 OF 4 (22) 102392

V.A.O.T.
RECEIVED
 OK'D BY JEL OK'D BY G.Roy
 5-30-01 6-4-01
MAY 24 2001
 RESUBMIT APPROVED
 BY G.Roy DATE 6-4-01

NOTES:

1. ALL RAILING POSTS ARE PC-27782.
2. ALL TS 8" x 4" RAIL SPLICES ARE PC 35107.
3. ALL TS 4" x 4" RAIL SPLICES ARE PC 35103.
4. TOTAL PAY LENGTH: 1231.48 LIN. FT.
5. FINISH: GALV. A123,
HARDWARE: GALV. A153.

This drawing and the information shown thereon is the sole property of TRINITY INDUSTRIES, INC. Neither the drawing nor such information is to be used for any purpose other than that for which it was specifically furnished by TRINITY INDUSTRIES, INC.

ITEM NUMBER 525.33 T2 STEEL BRIDGE RAIL (PL2)			
STATE OF VERMONT AGENCY OF TRANSPORTATION INTERSTATE ROUTE 89		DRAWN SAR	
TOWNS OF FAIRFAX, FAIRFAX & ST. ALBANS COUNTY OF FRANKLIN		CHECKED S.H.	
STATE PROJECT NO. IM 089-3(27) BRIDGE NO. 87/88		SCALE: N.T.S.	
CUSTOMER NORTHLAND SPECIALTIES	P.O. No. VERBAL	DATE 4/30/01	ENG. FILE # 22-102392-E2
TRINITY INDUSTRIES, INC. 423		SHT.No. E2 OF 3	REV. 0
HIGHWAY SAFETY PRODUCTS 2525 STEMMONS FREEWAY, DALLAS, TX 75207		TRINITY SALES ORDER NO. 102392	