


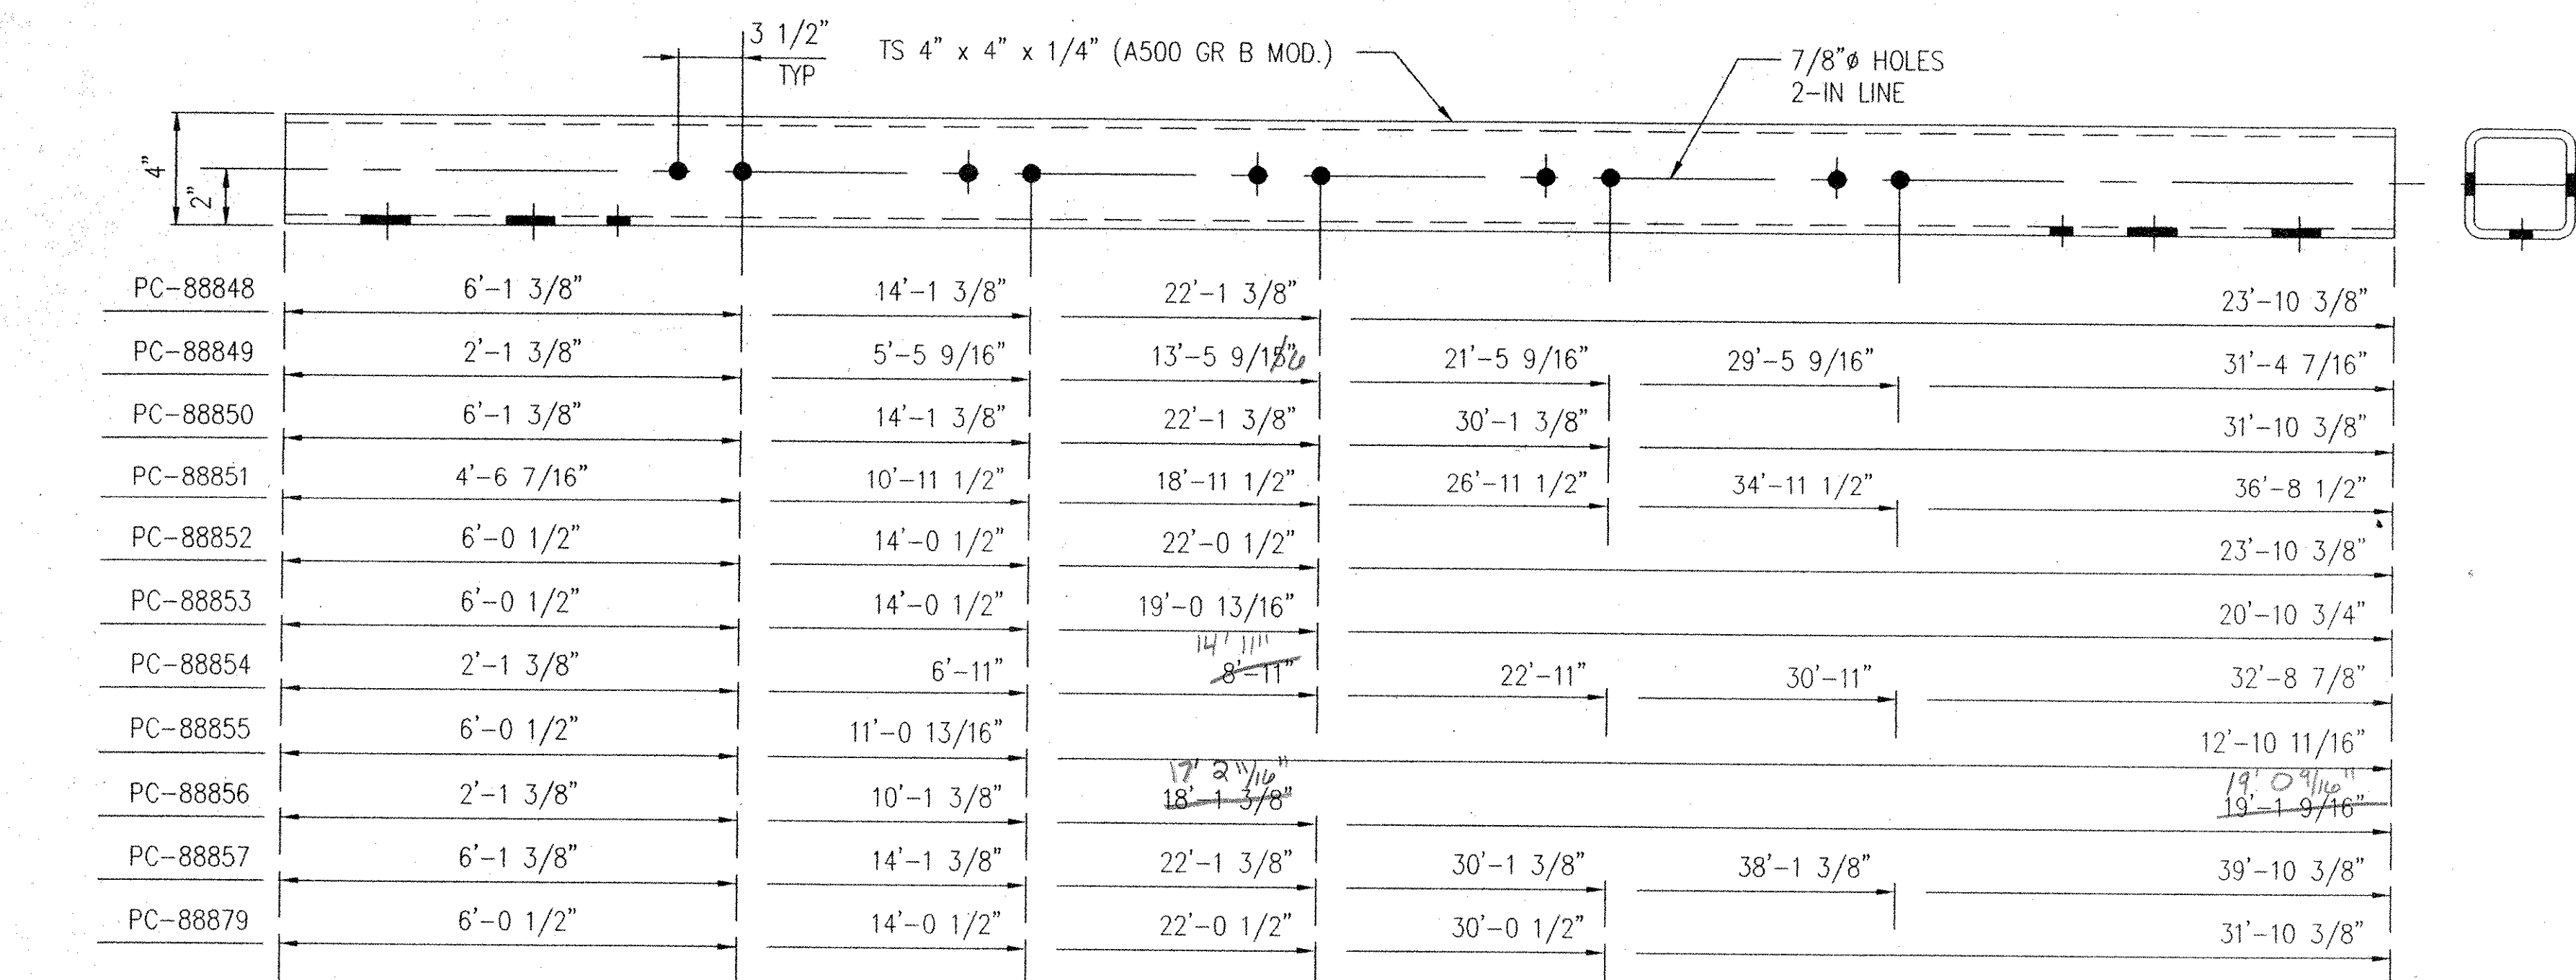

This drawing and the information shown thereon is the sole property of TRINITY INDUSTRIES, INC. Neither the drawing nor such information is to be used for any purpose other than that for which it was specifically furnished by TRINITY INDUSTRIES, INC.

REV.				CHK'D	BY	DATE	REMARKS	
ITEM NUMBER 525.33 T2 STEEL BRIDGE RAIL (PL2)								
STATE OF VERMONT AGENCY OF TRANSPORTATION INTERSTATE ROUTE 89 TOWNS OF FAIRFAX, FAIRLAND & ST. ALBANS COUNTY OF FRANKLIN STATE PROJECT NO. IM 089-3(27) BRIDGE NOS. 87/88							DRAWN SAR	
							CHECKED S.H.	
							SCALE: N.T.S.	
CUSTOMER			NORTHLAND SPECIALTIES		P.O. No.		DATE	
					VERBAL		5/1/01	
 TRINITY INDUSTRIES, INC. 426 HIGHWAY SAFETY PRODUCTS 2535 STEPHENS FREEWAY, DALLAS, TX 75207							ENG. FILE # 22-102392-02 SHT.No. D2 OF 4 TRINITY SALES ORDER NO. REV.	