
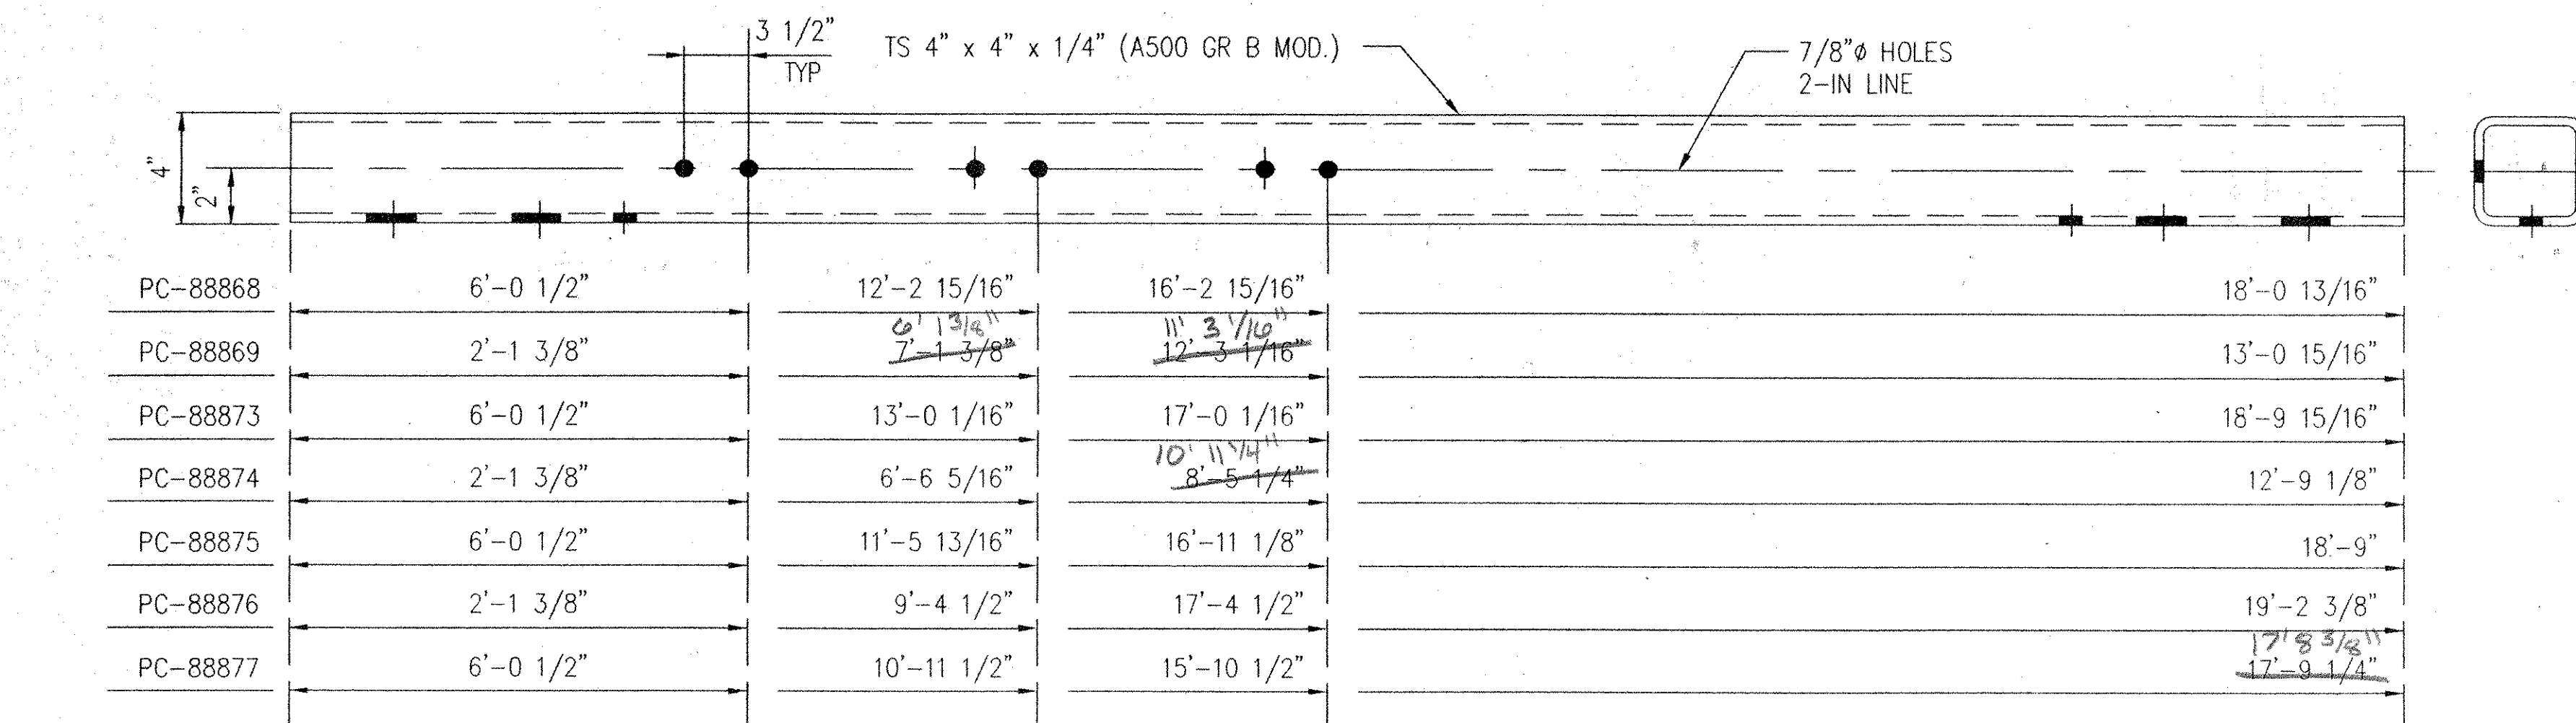


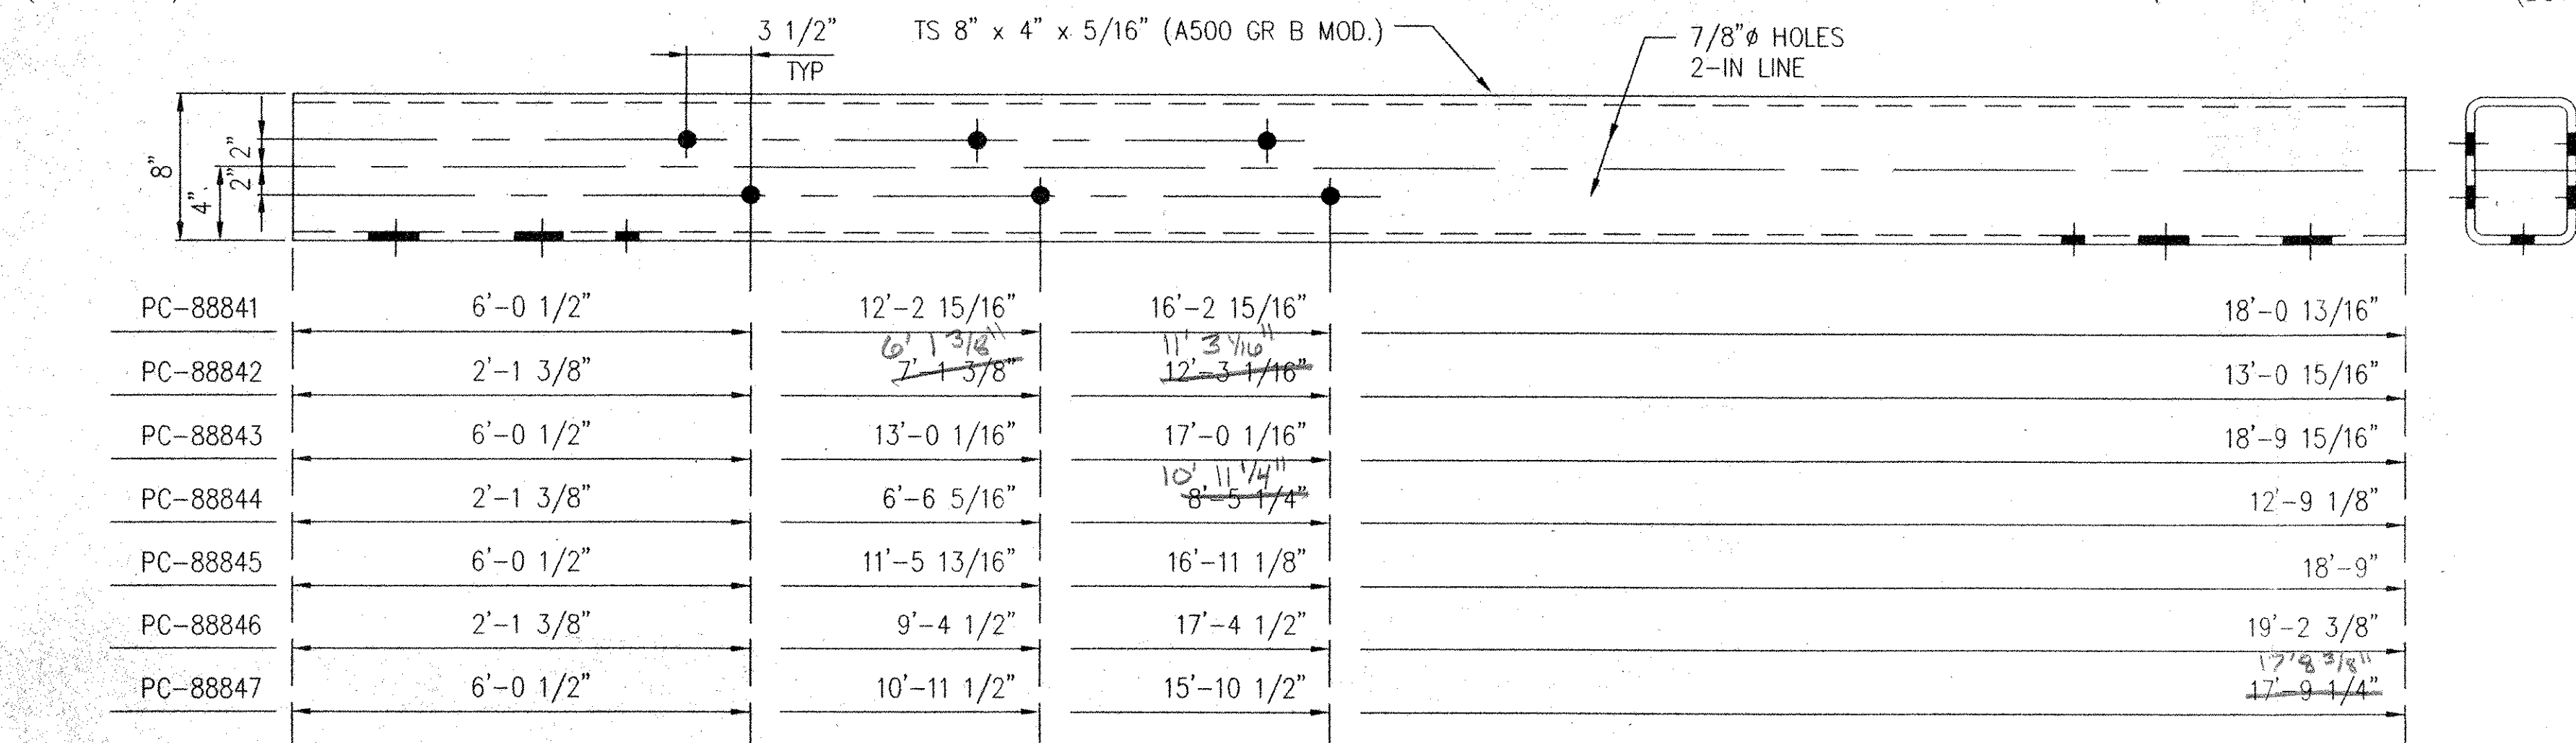


NOTES:

APPROVAL DRAWING

GIRARD ENGINEERING DEPT.
ISSUED
MAY 17 2001
TRINITY INDUSTRIES, INC.
1170 N. STATE STREET
GIRARD, OHIO 44420

1. FOR GENERAL NOTES PLEASE REFER TO SHEET D1 OF 4
2. FOR ERECTION LAYOUT SEE SHEET E1, E2 & E3 OF 3 (22) 102392

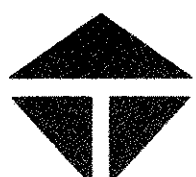2. FOR ERECTION EXCEPT SEE SHEET LT, E2 & E3 OF 5 (22) 102392			
REV.	CHK'D	BY	DATE
REMARKS			
ITEM NUMBER 525.33 T2 STEEL BRIDGE RAIL (PL2)			
STATE OF VERMONT AGENCY OF TRANSPORTATION INTERSTATE ROUTE 89 TOWNS OF FAIRFAX, FAIRLAND & ST. ALBANS COUNTY OF FRANKLIN STATE PROJECT NO. IM 089-3(27)			DRAWN SAR CHECKED S.H. SCALE: N.T.S.
CUSTOMER	NORTHLAND SPECIALTIES	P.O. No.	DATE
		VERBAL	5/2/01
 TRINITY INDUSTRIES, INC. HIGHWAY SAFETY PRODUCTS 2525 STEMMONS FREEWAY, DALLAS, TX 75207			ENG. FILE # 22-102392-D4 SHT.No. D4 OF 4 TRINITY SALES ORDER NO. (22) 102392

V.A.O.T.
RECEIVED
OK'D BY JEL OK'D BY G. Roy
5/30/01 6.4.01
MAY 24 2001
RESUBMIT _____ APPROVED ASW
BY G. Roy DATE 6.4.01

This drawing and the information shown thereon is the sole property of TRINITY INDUSTRIES, INC. Neither the drawing nor such information is to be used for any purpose other than that for which it was specifically furnished by TRINITY INDUSTRIES, INC. nor is any reproduction or reuse without written permission.

TRINITY INDUSTRIES, INC. 428
HIGHWAY SAFETY PRODUCTS
2525 STEMMONS FREEWAY, DALLAS, TX 75207