




HEADWALL H1 PLAN VIEW

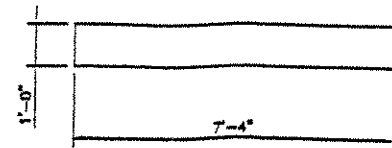


HEADWALL H2 PLAN VIEW

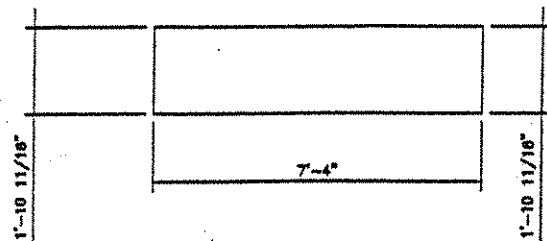


HEADWALL H1 ELEVATION VIEW

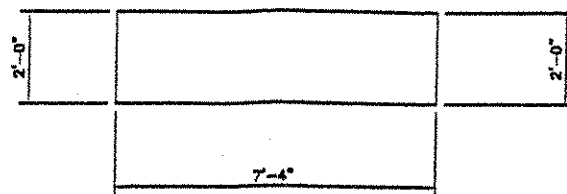


HEADWALL H2 ELEVATION VIEW

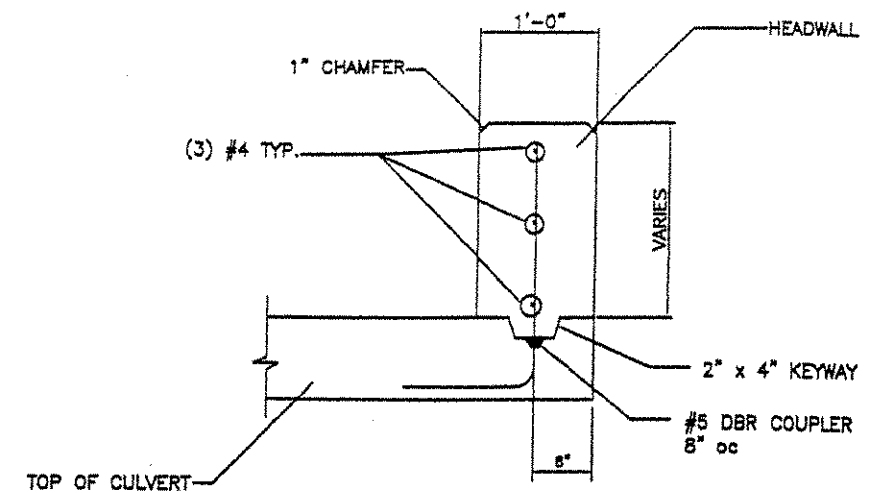


HEADWALL DETAIL

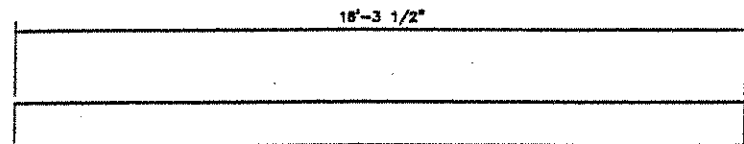


CUTOFF WALL C1 PLAN VIEW

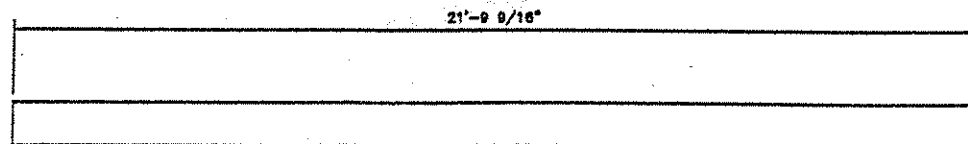


CUTOFF WALL C2 PLAN VIEW

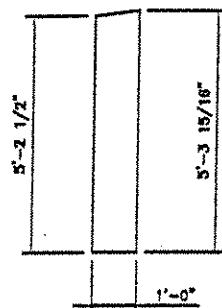

CUTOFF WALL C1 END VIEW

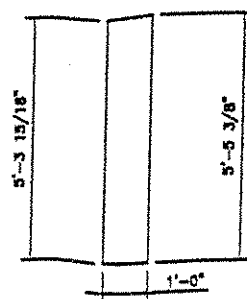


CUTOFF WALL C2 END VIEW

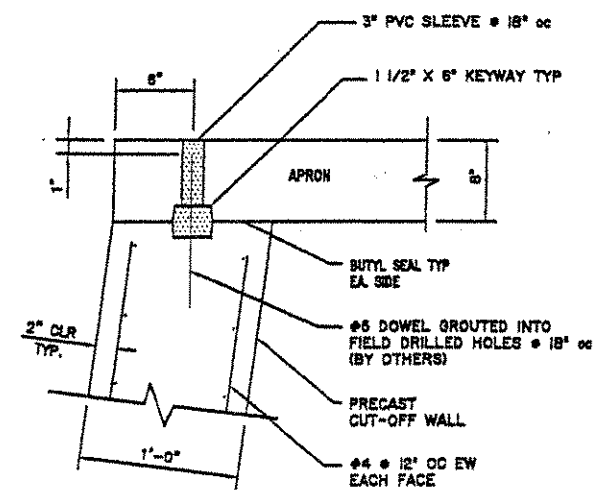

CUTOFF WALL DETAIL

V.I.A.O.T
RECEIVED
OK'D BY *E. Roy* 3-21-01 OK'D BY *mgl* 3-29-01
MAR 21 2001
REQUEST *mgl* APPROVED
DATE 3-29-01

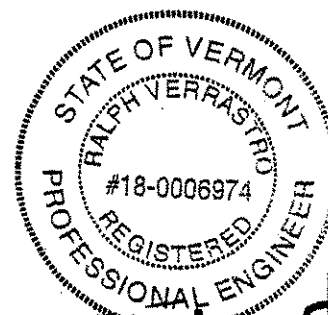

Ralph Verrastro
2/21/01

TOWN OF ST. ALBANS, VT.		SHEET 3 OF 3
6'-0" x 6'-0" x 78'-0" BR 87-3 NORTHBOUND		
DELTA ENGINEERS, P.C. ENGINEERS • ARCHITECTS	CONTRACTOR: 431	