
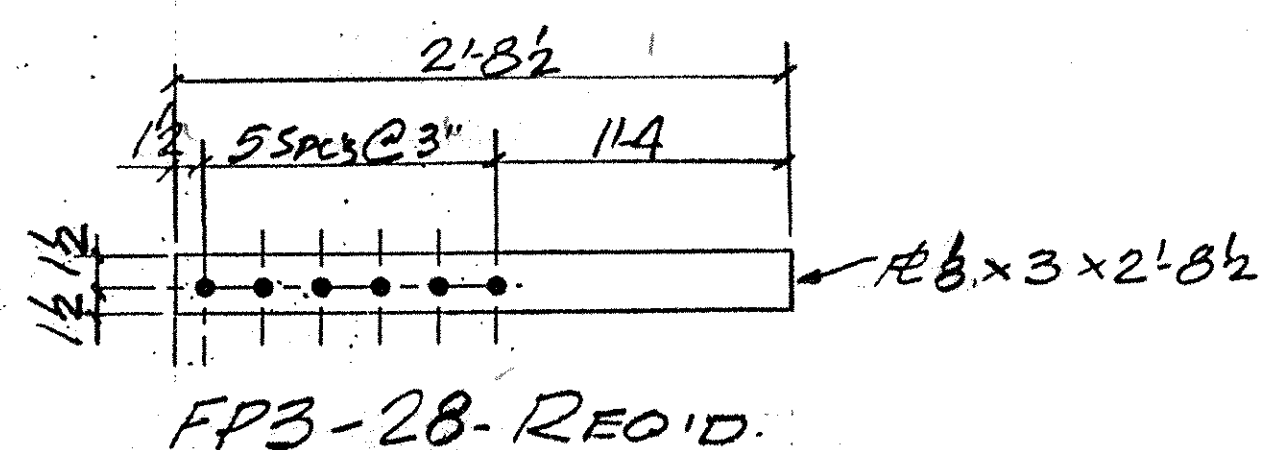
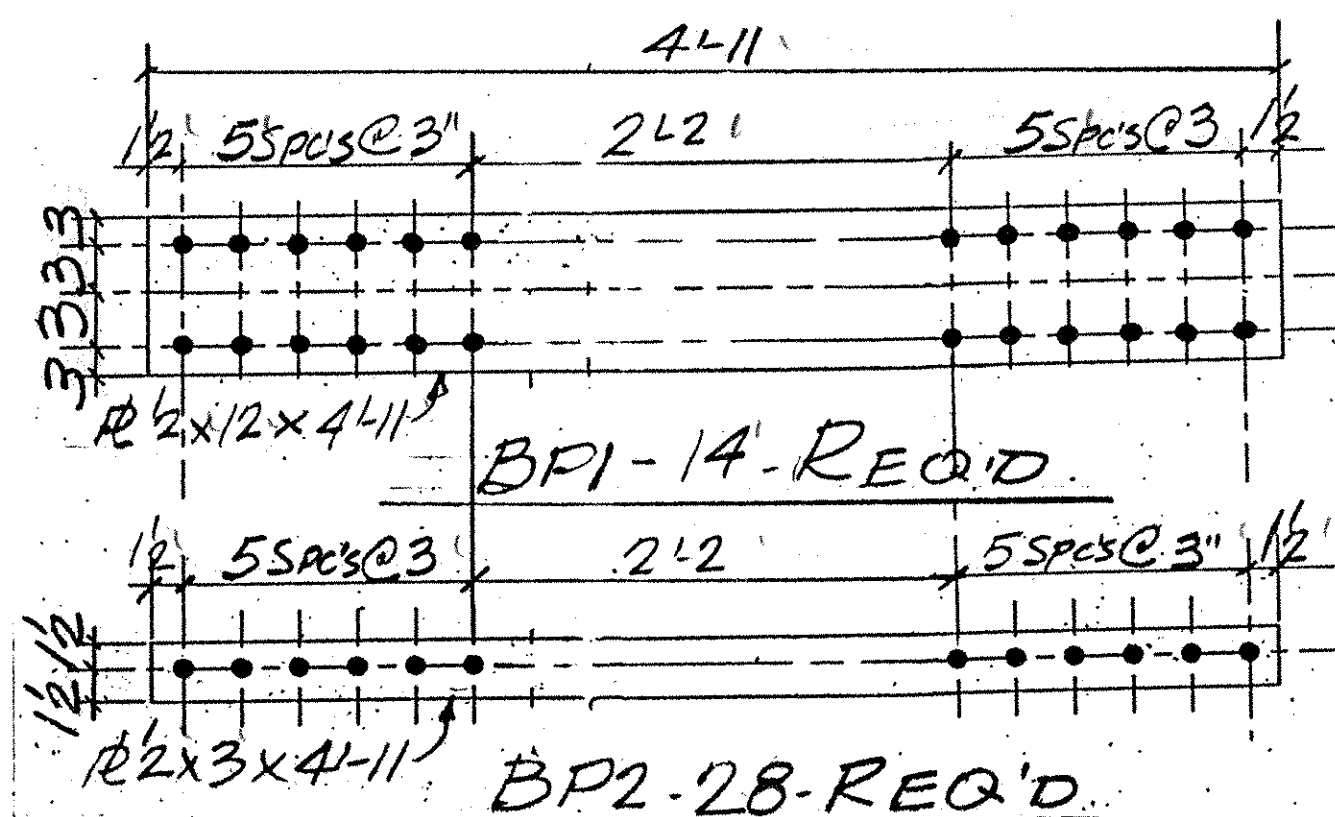
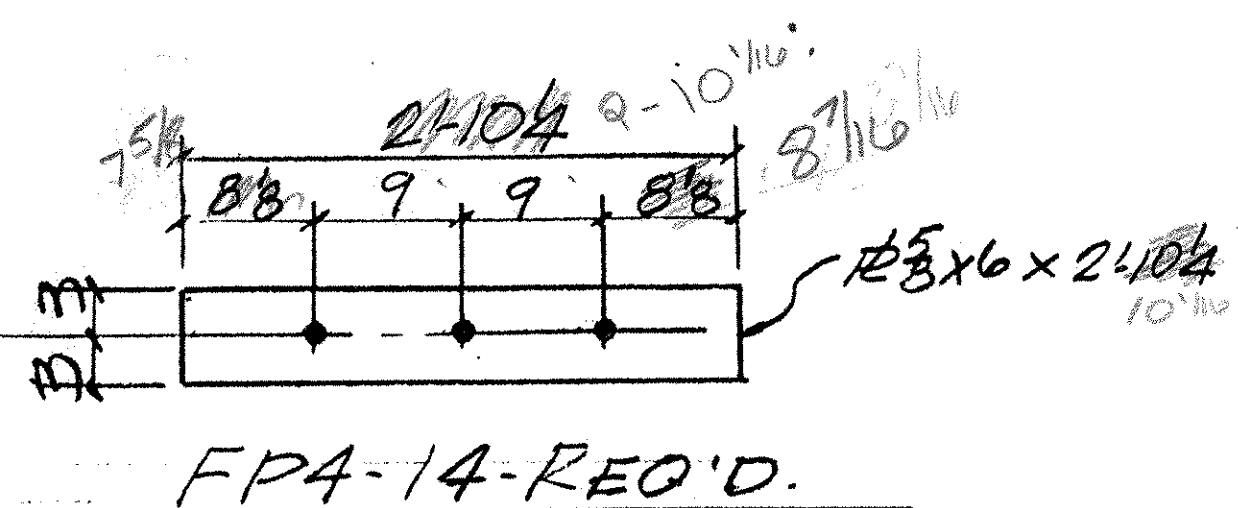
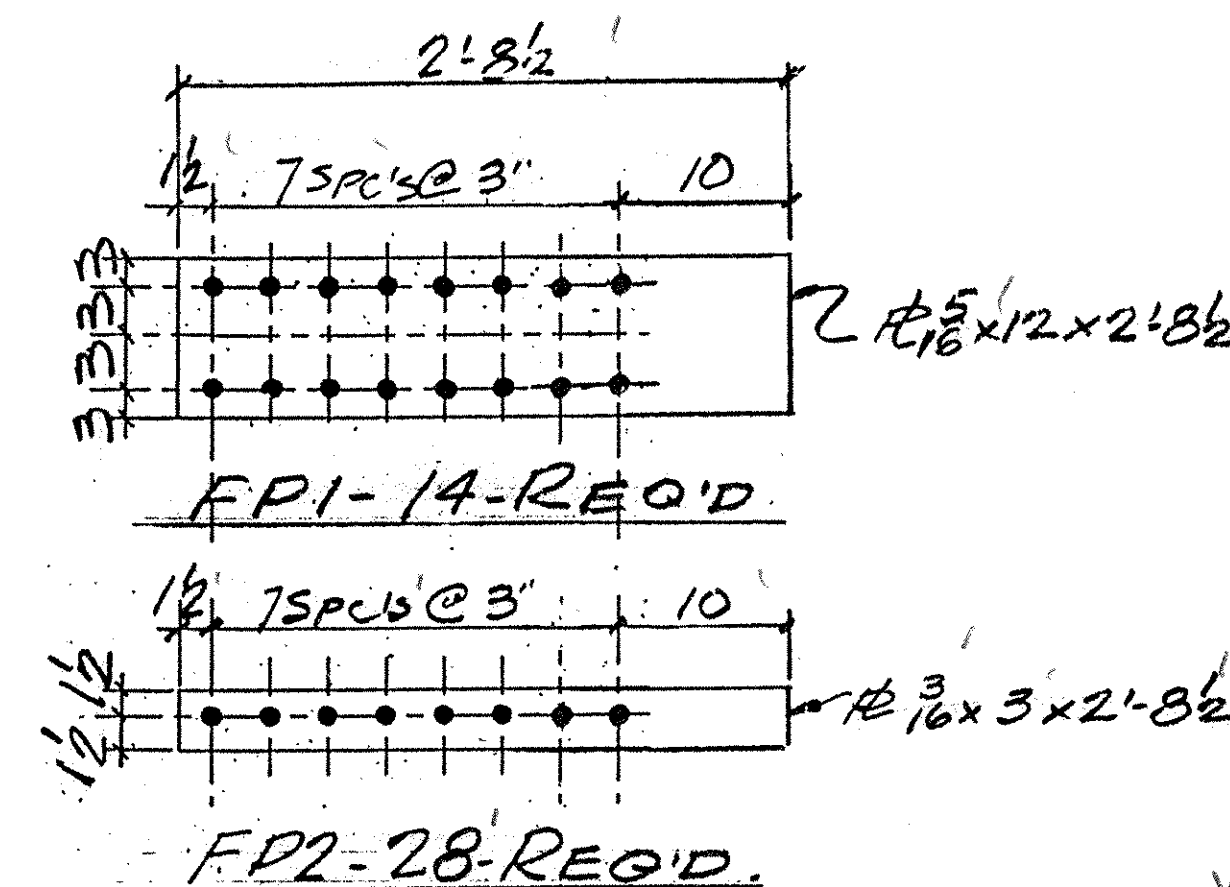
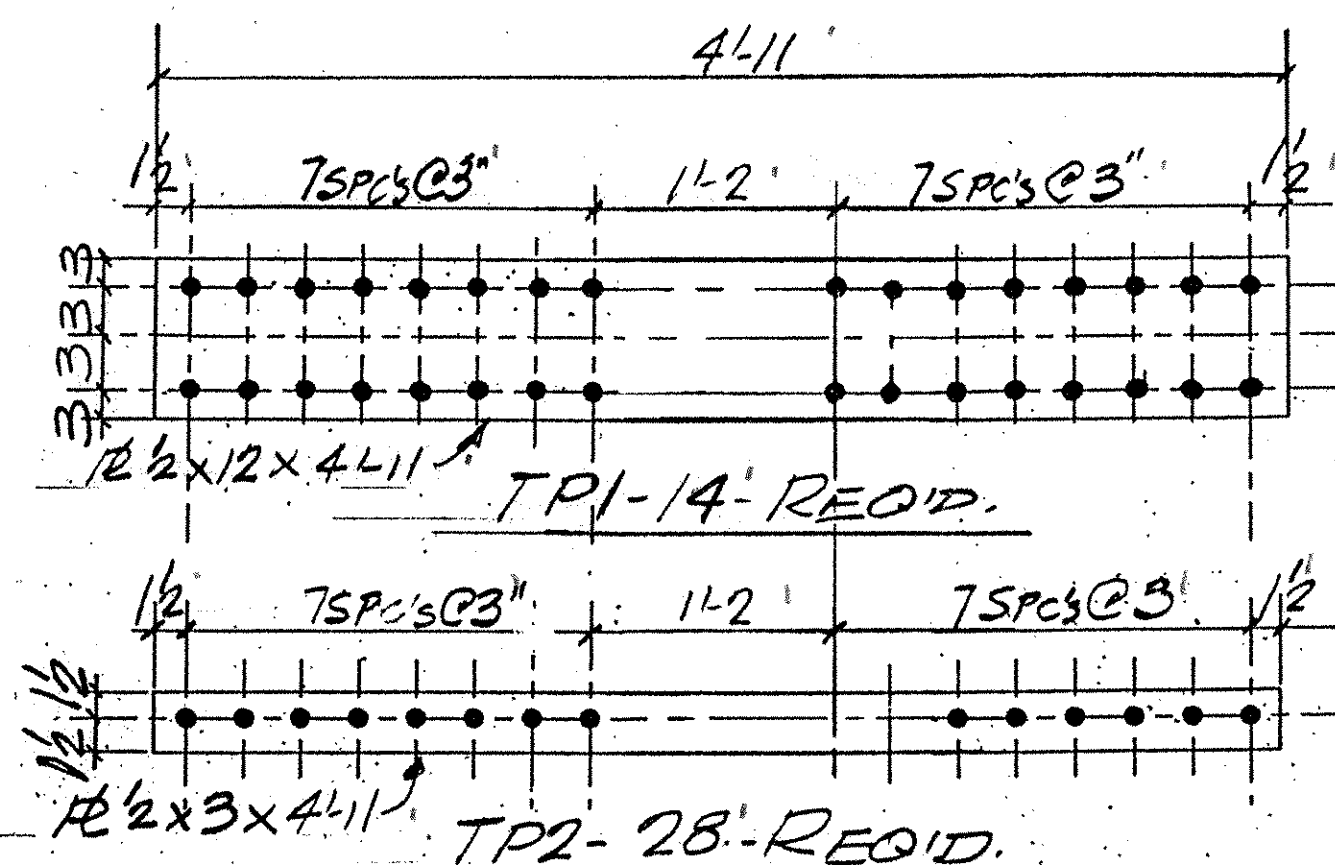
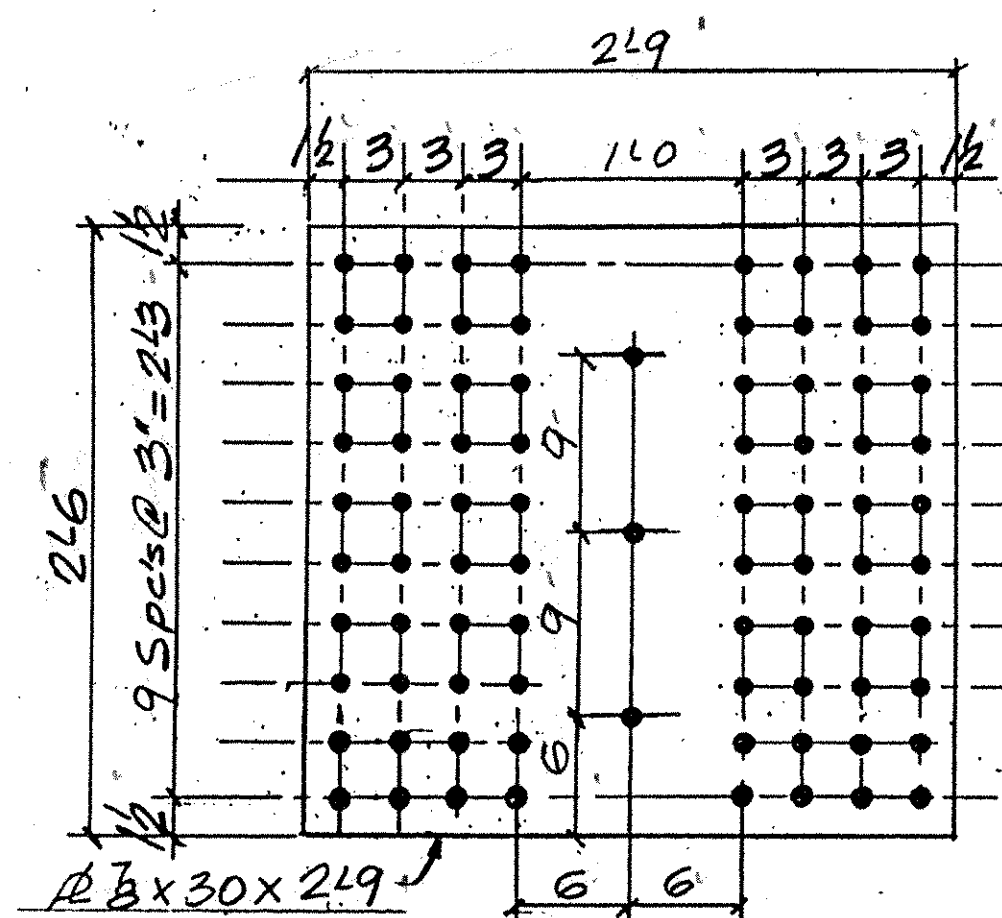
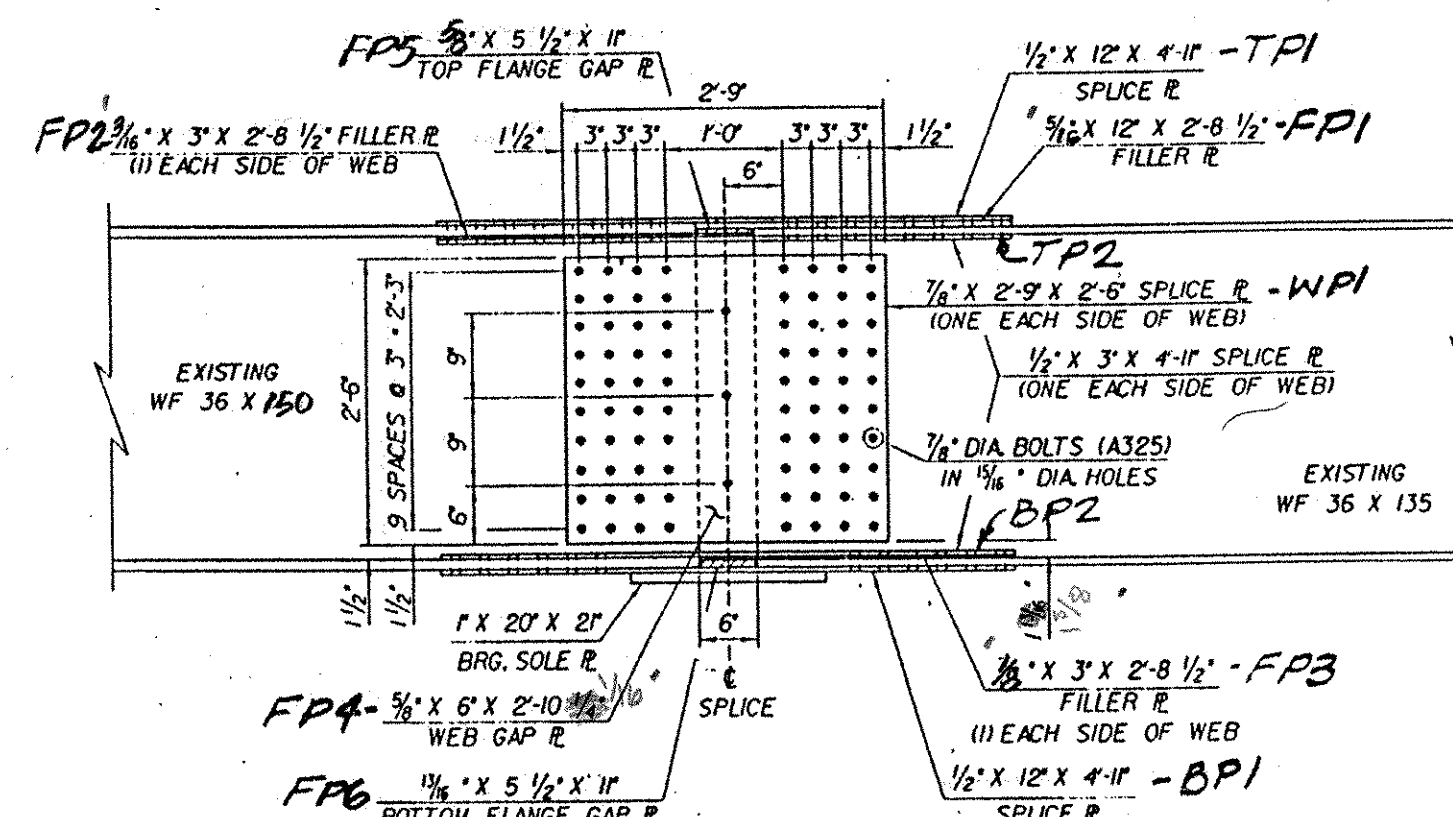
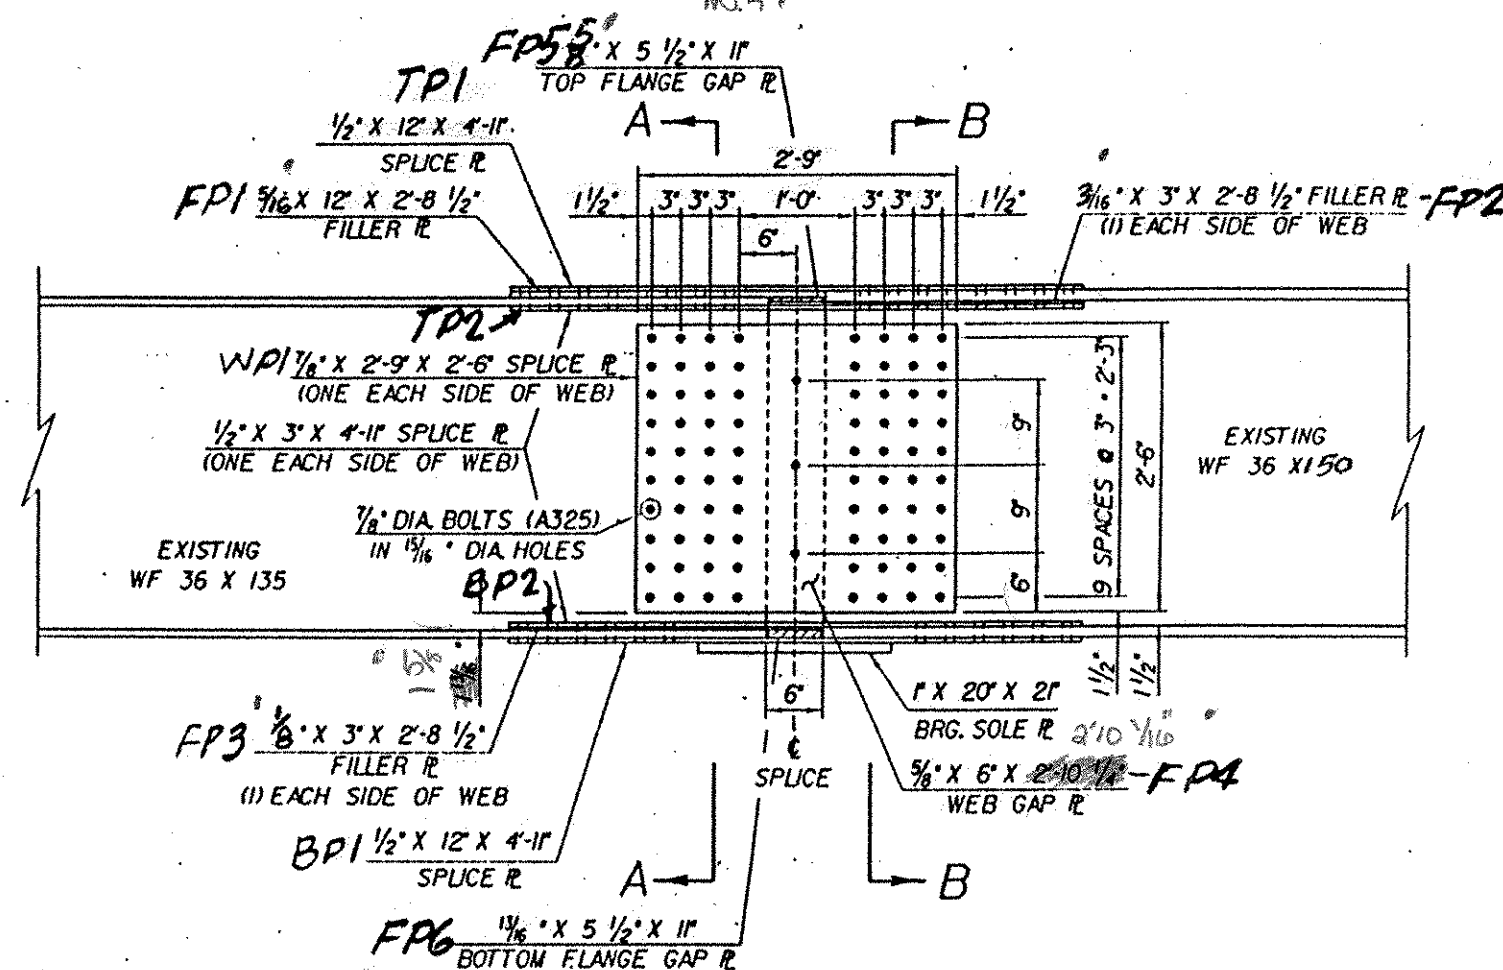
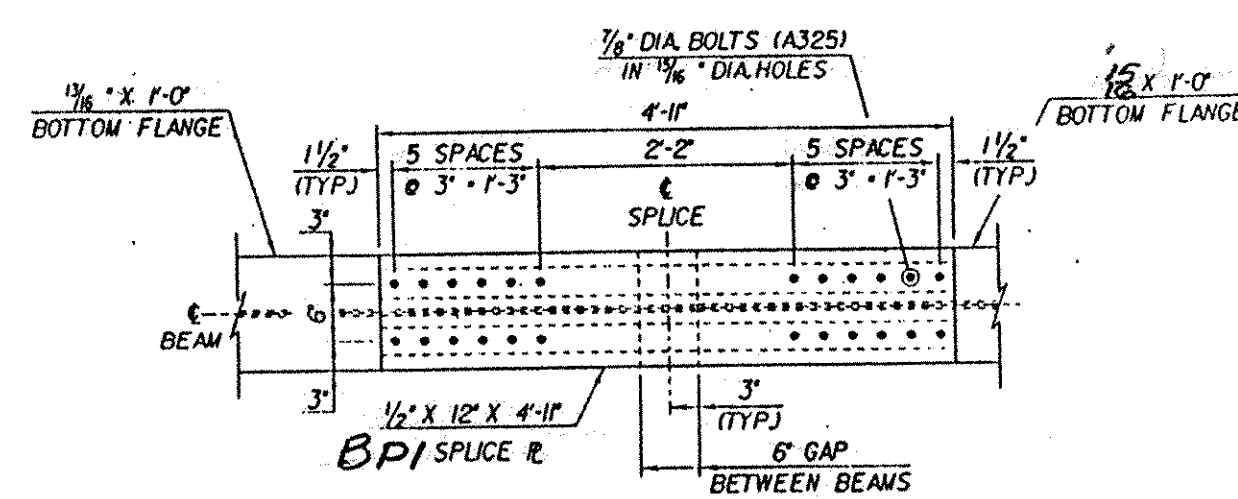


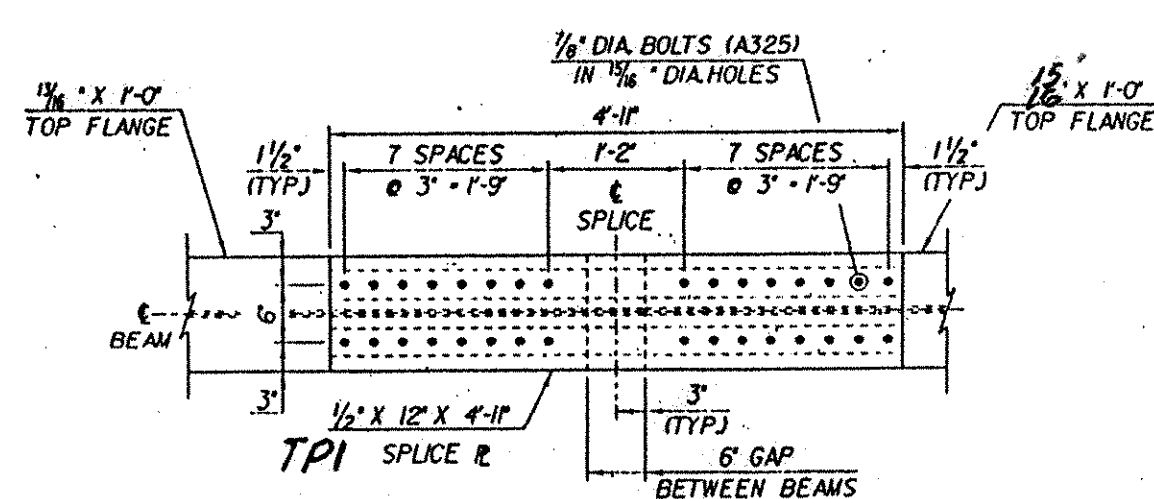

ABM INFO		SHOP BILL				JOB NO. 132	DWG. NO. 54		
PAGE	LINE	NO.	DESCRIPTION	FT	IN	ASSEM. MARK	SHIPPING MARK	REMARKS	WEIGHT
		28	R 1/2 x 30	2	9		WPI	CVN	
		14	R 1/2 x 12	4	11		TP1	CVN	
		14	DO	4	11		BPI	CVN	
		28	R 1/2 x 3	4	11		TP2	CVN	
		28	DO	4	11		BP2	CVN	
		14	R 5/8 x 12	2	8 1/2		FP1		
		28	R 3/8 x 3	2	8 1/2		FP2		
		28	R 5/8 x 3	2	8 1/2		FP3		
		14	R 5/8 x 6	2	10 1/16		FP4		
		14	R 5/8 x 5 1/2		11		FP5	NO FAB	
		14	R 1 1/8 x 5 1/2		11		FP6	NO FAB	
FIELD BOLTS (MIG- TYPE 1-GALV.) W/ NUT & WASHER									
		1120	3" H.S. BOLTS	33			FIELD	WASHER	
		336	DO	34			DO	BOT. FLG.	
		448	DO	32			DO	TOP FLG.	

PAY ITEM 506.60

[illegible]

REV.	REMARKS	DATE	DWN	CHK	APP	Q.A.	NO.	DIA.	LGT	TYPE	WASH
	PROJECT NO. <u>11-089-3 (27)</u> STATE BRIDGE NO. <u>88N</u>										
	MATERIAL <u>AS-5110</u> <u>M12 70 GR50</u>	ELECTRODES: <u>-</u>		HOLES: <u>1 1/8" Ø</u>				SHOP BOLTS: <u>-</u>			
	SURFACE PREP. & PAINT: <u>PREP: SSPC-SP10</u>										
	<u>PRIMER - WATER</u> <u>MILC-21NC</u>										

DESCRIPTION: <u>SPLICE PLATES PIER 334</u>	DRAWN BY	DATE
JOB: <u>BRIDGE 88N</u>	JPF	2-0
<u>T-89 OVER ST. ALBANS SO. STATE HIGHWAY</u>	CHKD BY	
<u>FAIRFAX & FAIRFIELD - ST. ALBANS, VT.</u>	EJ	
	APPROV BY	
	Q.A.	
CUSTOMER: <u>J.A. McDONALD</u>		
CASCO BAY STEEL STRUCTURES, INC.	JOB NO.	DRG. NO.
75 SPRING HILL ROAD	132	54
SACO, MAINE 04072	435	REV. 1
PHONE (207) 282-7360		
FAX. (207) 282-1179		

SHOP NOTE: SPLICE PLATES PRIME ONLY