




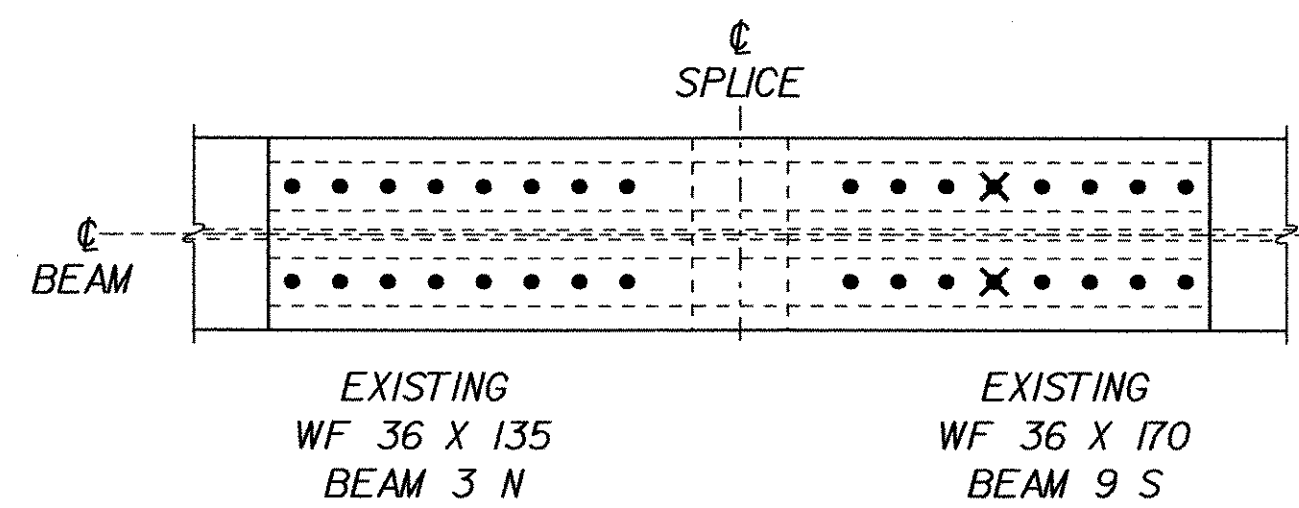


BEAM NO. 3 TO BEAM NO. 9

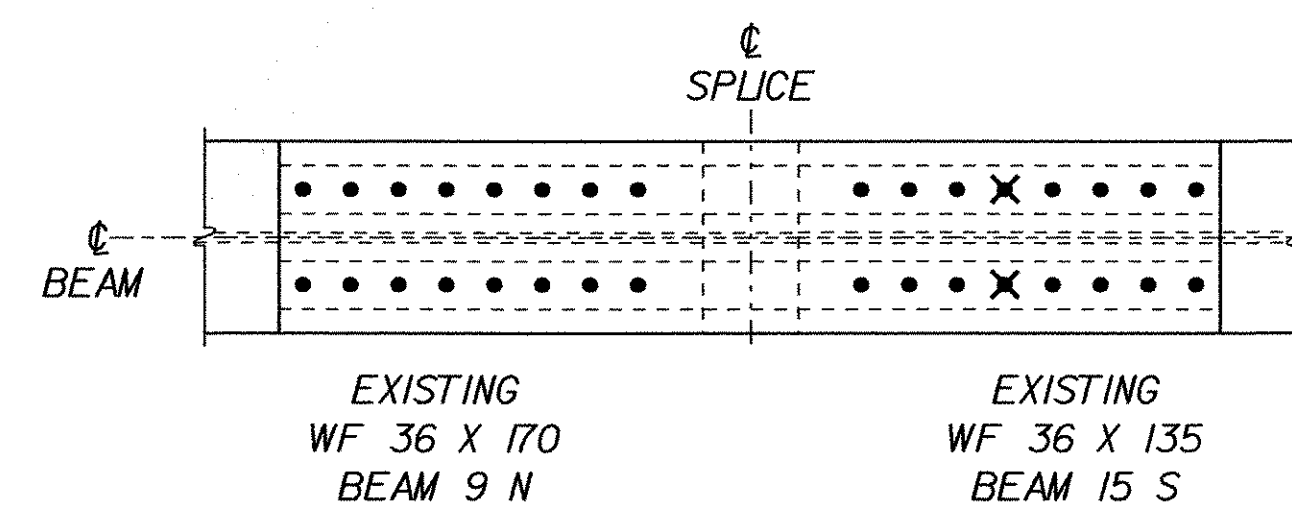


BEAM NO. 9 TO BEAM NO. 15

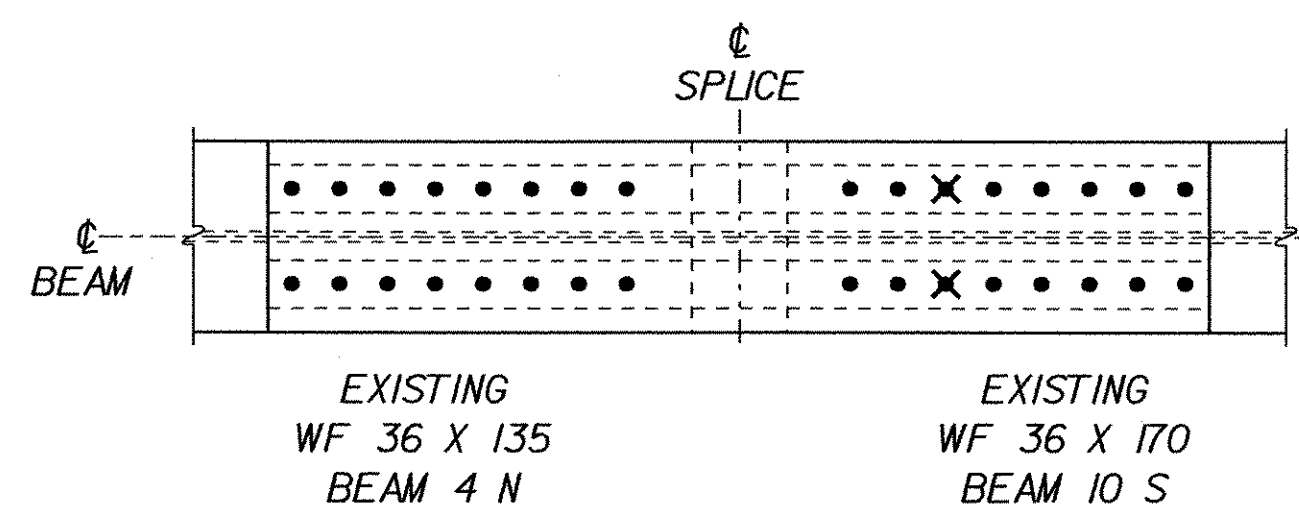


BEAM NO. 4 TO BEAM NO. 10

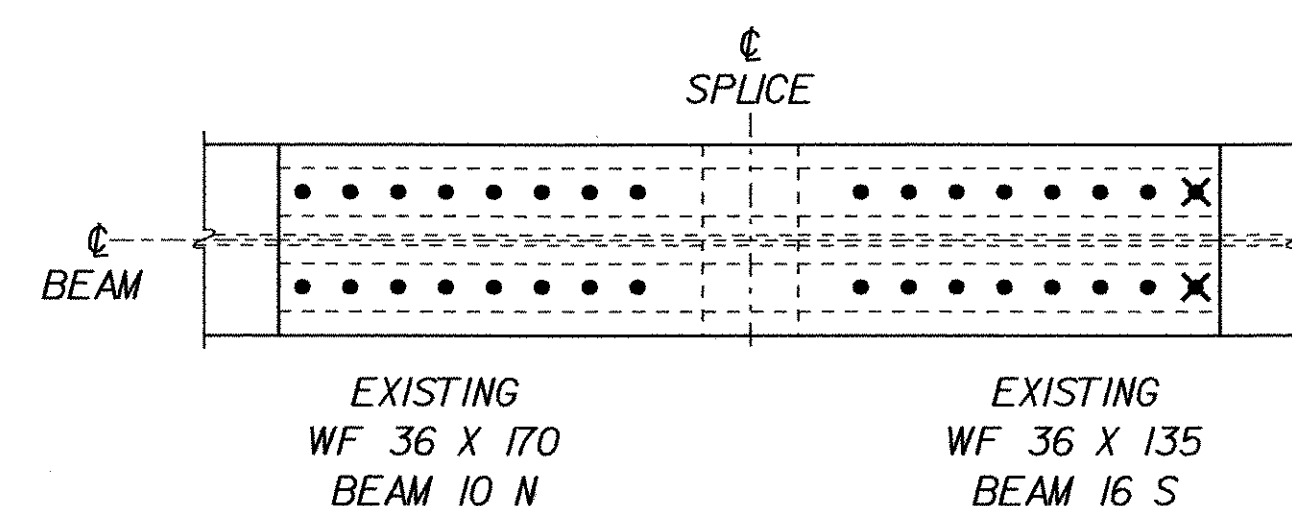


BEAM NO. 10 TO BEAM NO. 16

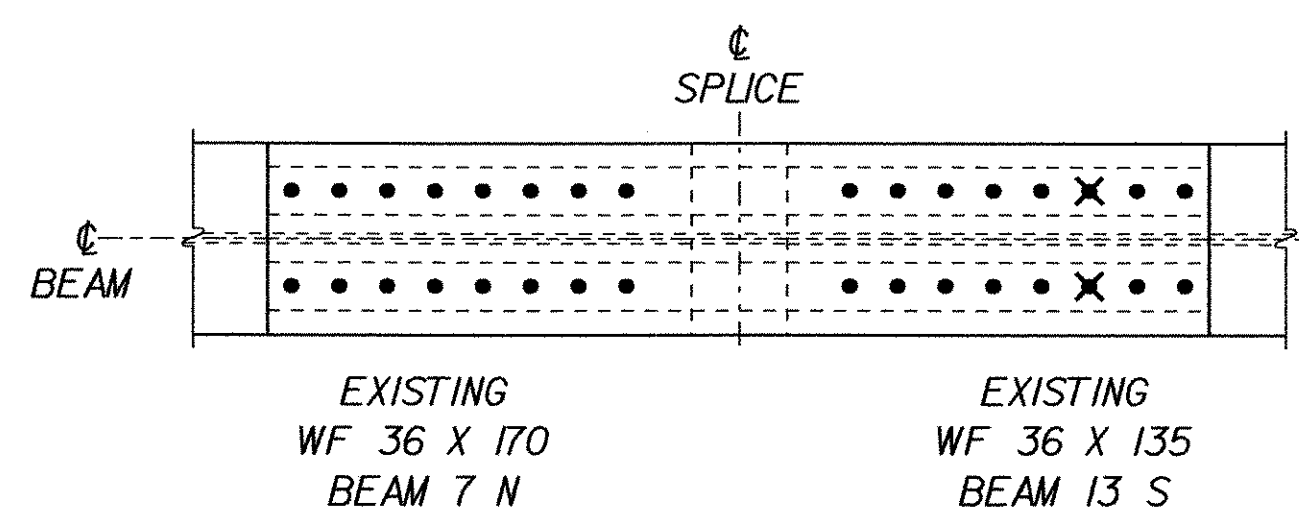

BEAM NO. 7 TO BEAM NO. 13

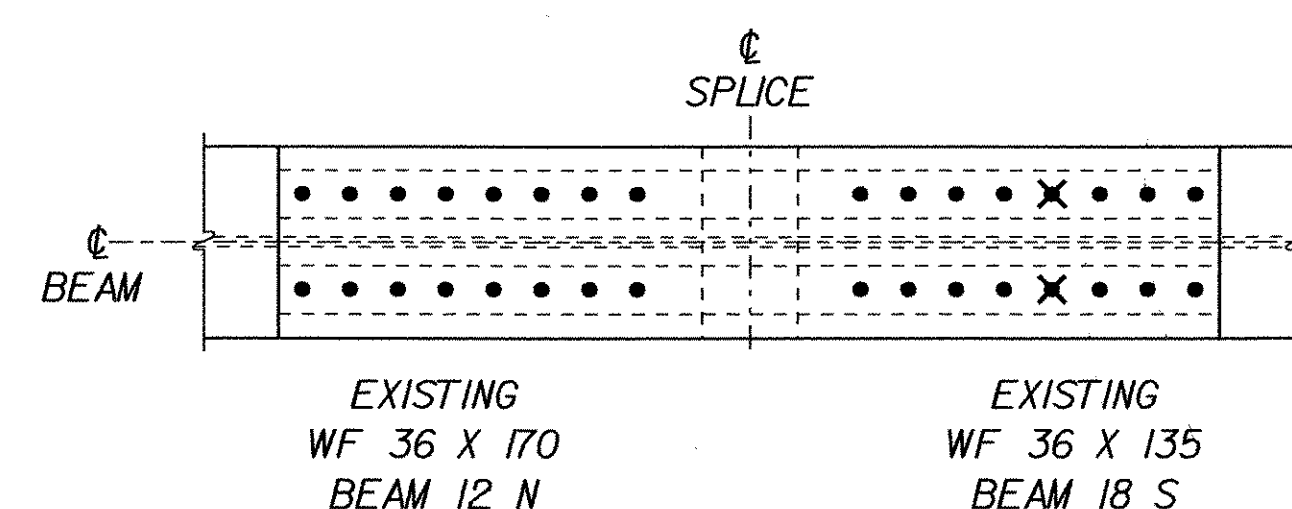

BEAM NO. 12 TO BEAM NO. 18

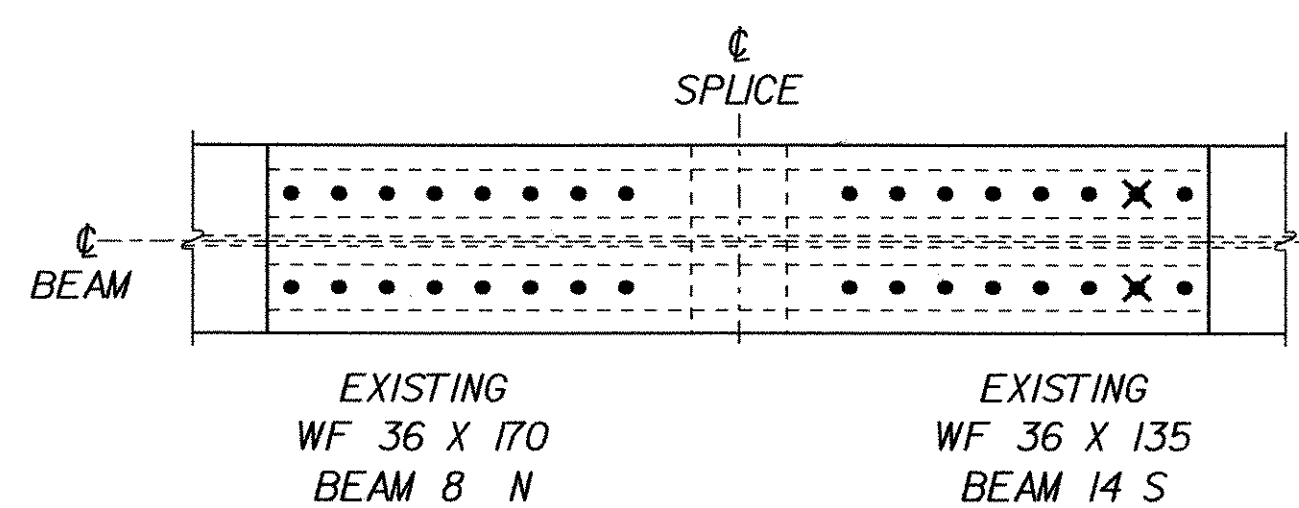

BEAM NO. 8 TO BEAM NO. 14

STRUCTURES COPY

SCALE: 1" = 1'-0"

STATE OF VERMONT AGENCY OF TRANSPORTATION			
Town Of FAIRFAX-FAIRFIELD-ST. ALBANS		Bridge No.	88S
Highway No.		Log Sta.	
1-89		Surv. Sta.	
1-89 OVER ST. ALBANS SOUTH STATE HIGHWAY (EXIT 19)			
88S BEAM SPLICE MODIFICATIONS - TOP FLANGE			
Designed By M. LOZIER		Drawn By G. ROY	
Checked By M. LOZIER		Bridge Design Supervisor	
Date 8/01		Date 8/01	
PROJECT FAIRFAX-FAIRFIELD-ST. ALBANS		PROJECT NO. 1M 089 - 3 (27)	
I.G.C. Info. 96a056Structures\sa056bwldgn		sa056fl1.i	
Bridge Sheet No.		Sheet 1 of 2 455	