


MSE Wall #2
WW #2 & #3 Step Points
#1 elev = 588.80
#2 elev = 586.34
#3 elev = 583.88
#4 elev = 581.42
#5 elev = 578.96
#6 elev = 576.50
#7 elev = 574.04
#8 elev = 571.58
#9 elev = 569.12
#10 elev = 566.66
#11 elev = 564.20

MSE #1
WW #1 & WW #2 Step Points
#1 elev = 587.84
#2 elev = 585.38
#3 elev = 582.92
#4 elev = 580.46
#5 elev = 577.99
#6 elev = 575.53
#7 elev = 573.07
#8 elev = 570.61

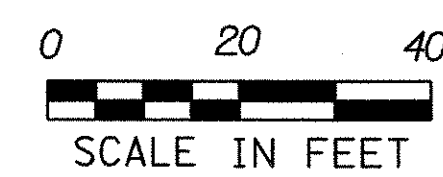

PROJECT NAME:	Fairfax-Fairfield-St.Albans
PROJECT NUMBER:	IM 089-3 (27)
FILE NAME:	87a007/survey/xa007hsv.dgn
PROJECT LEADER:	DESIGNED BY:
PLOT DATE:	21-MAR-2003
DRAWN BY:	R. Bullock
CHECKED BY:	
SHEET	144 OF 1468