




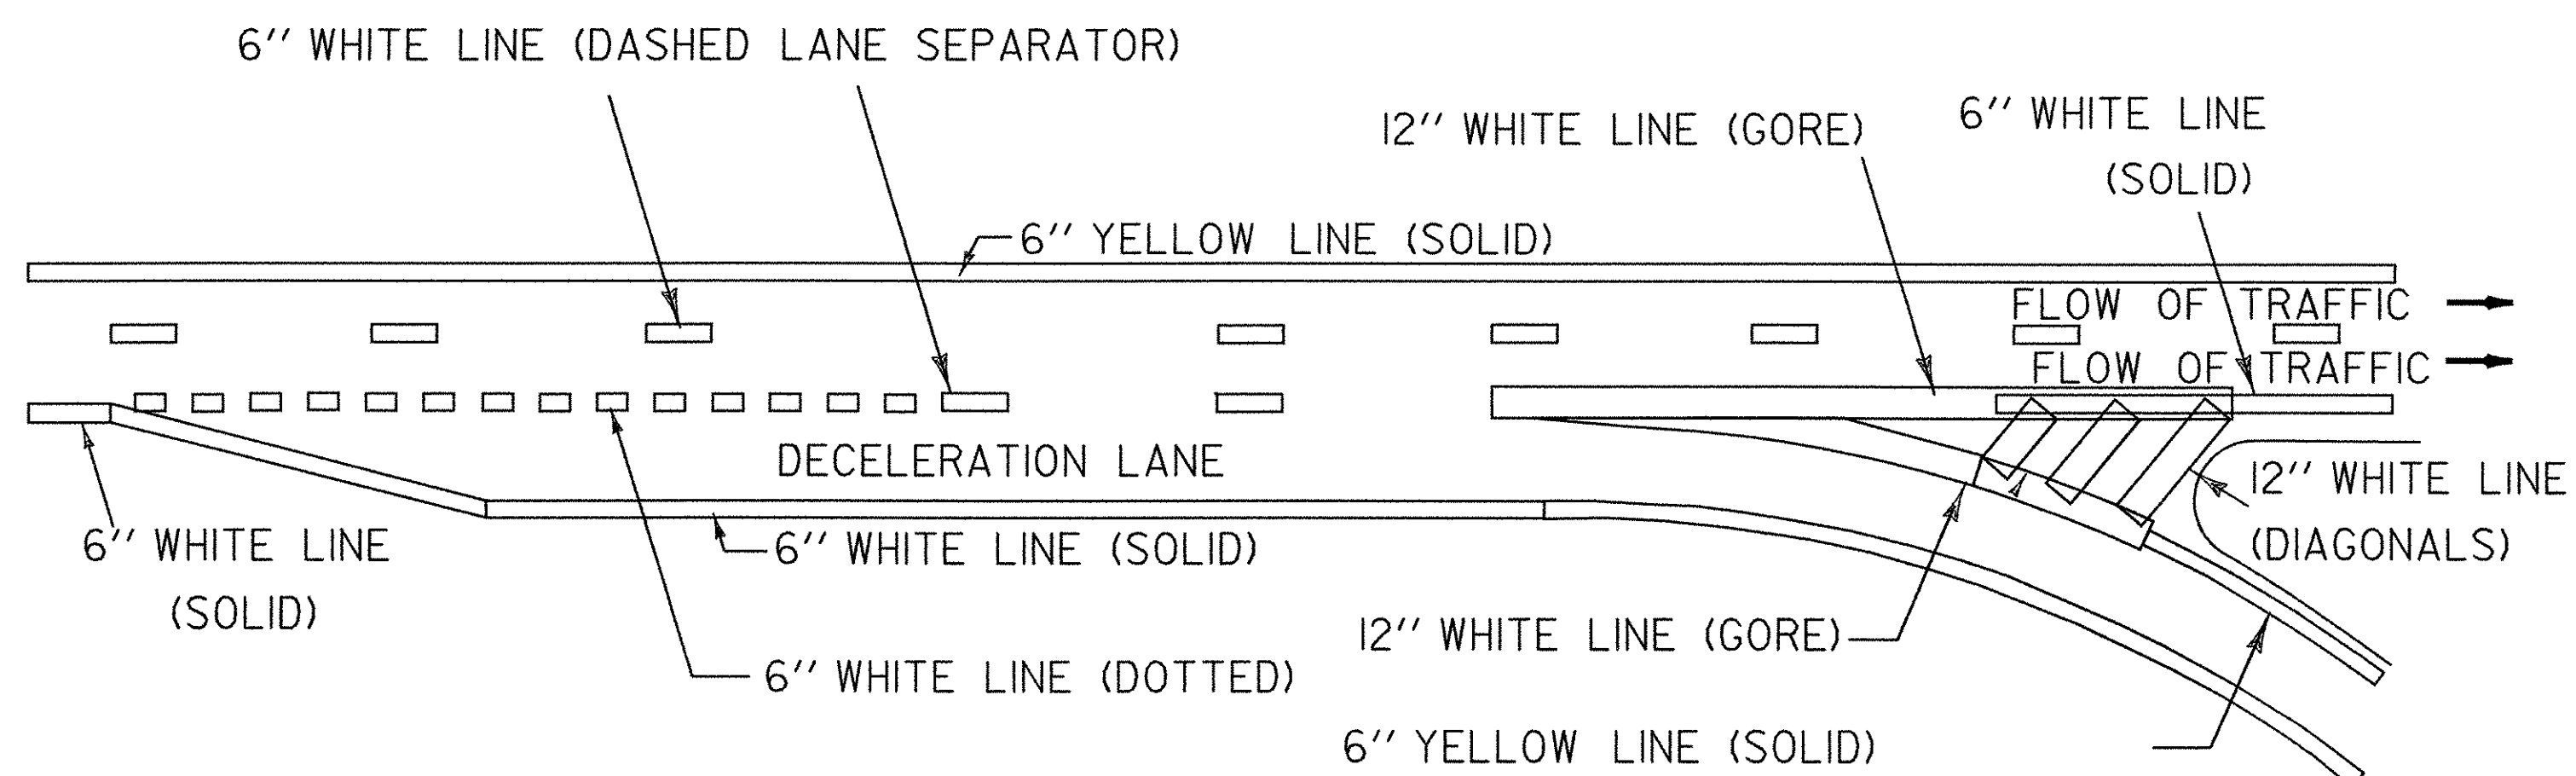

INTERCHANGE 19 EXIT RAMP D SOUTHBOUND

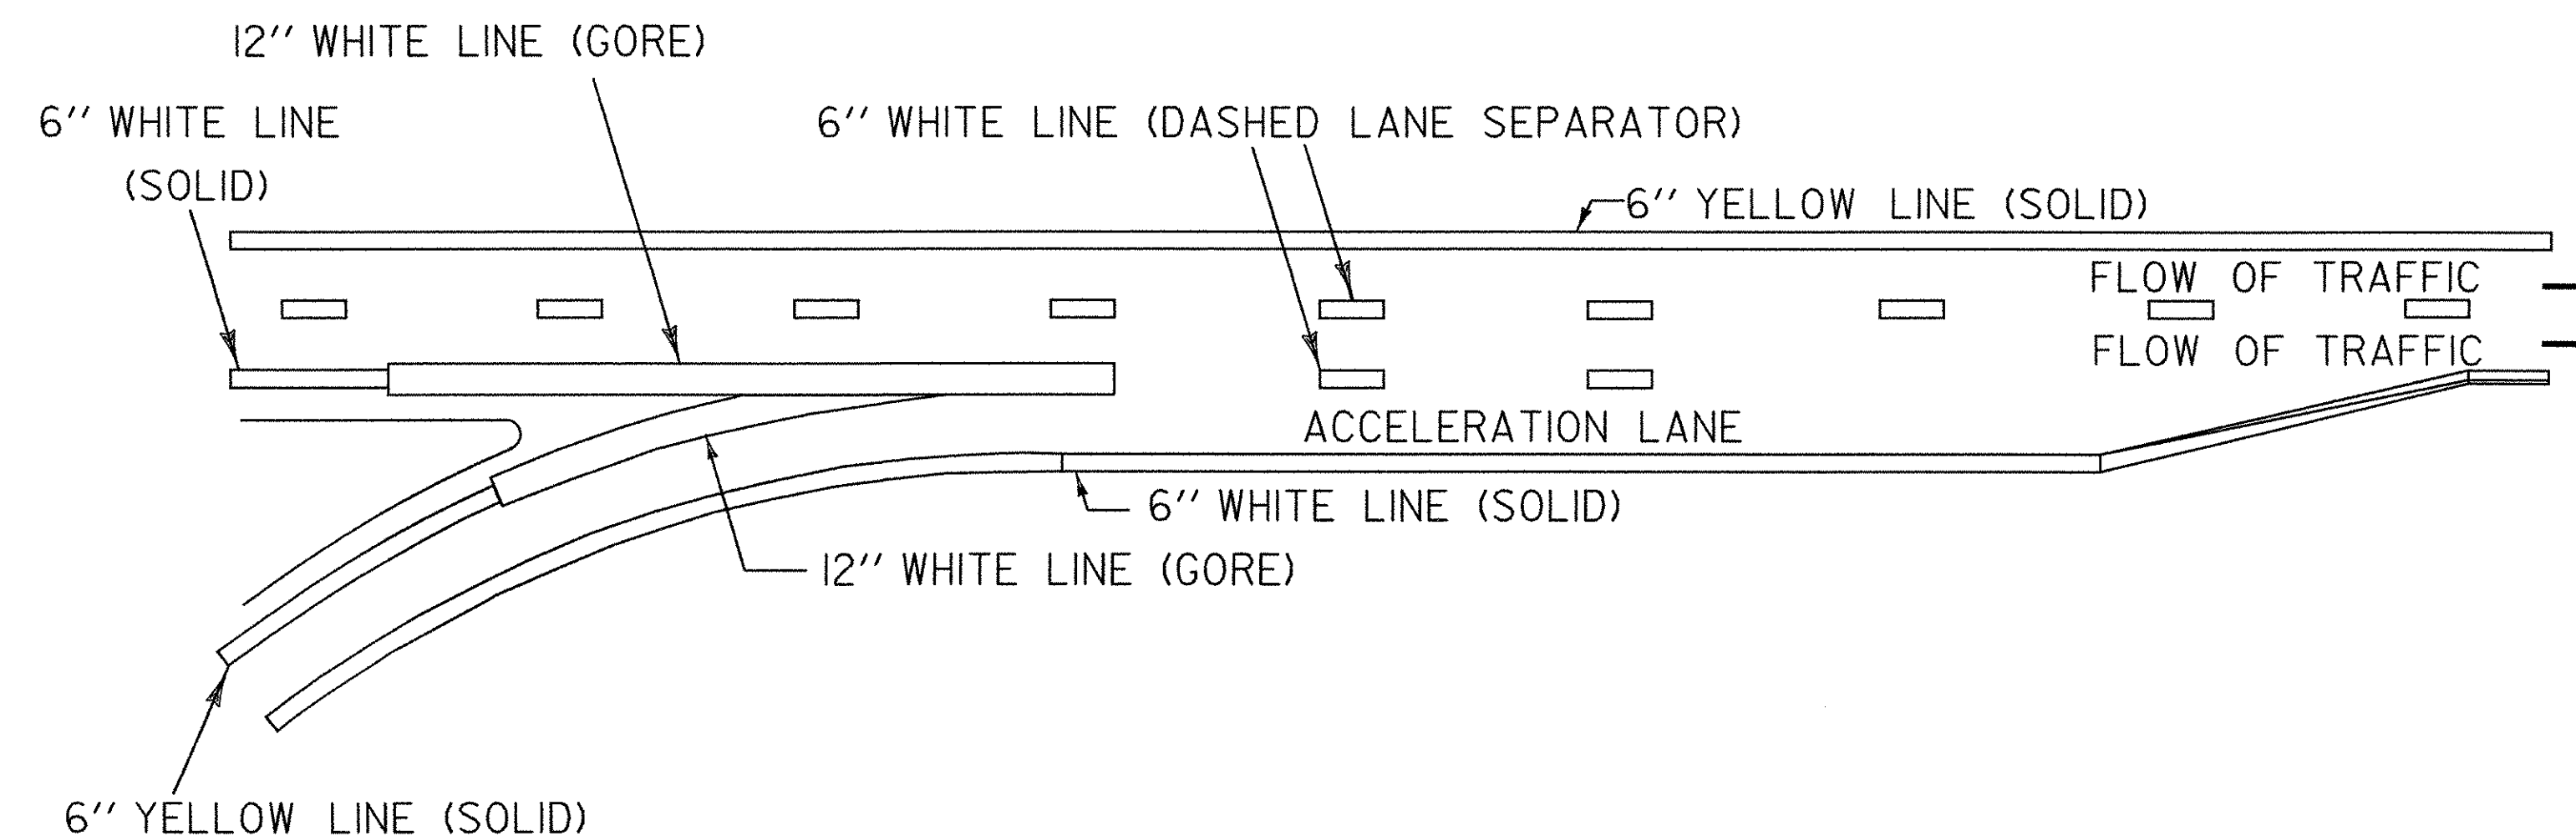

INTERCHANGE 19 ON RAMP C SOUTHBOUND

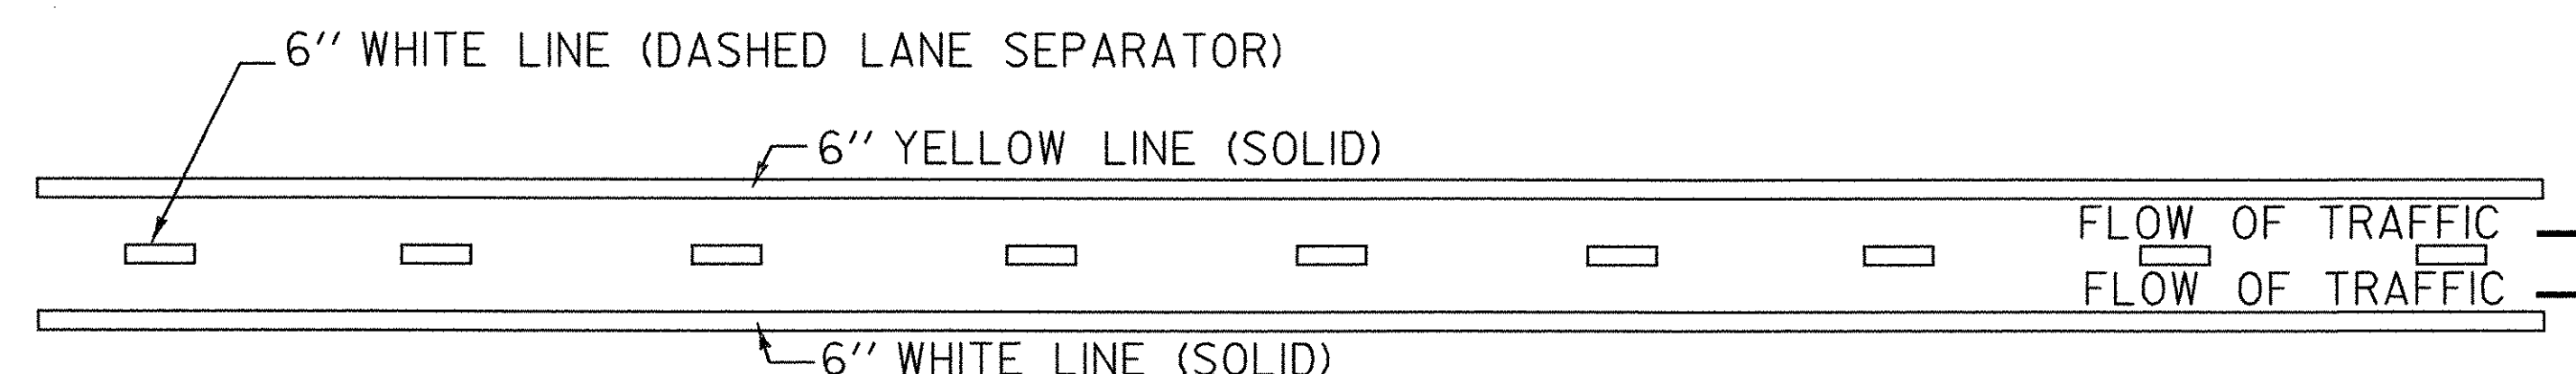

TYPICAL SOUTHBOUND MARKINGS

DURABLE 6" WHITE LINE

STA. 3282+50 CL - STA. 3444+54 CL (DASHED)
 STA. 3282+50 LT - STA. 3401+85 LT END TAPER RAMP C (SOLID)
 STA. 3401+85 LT END TAPER RAMP C - STA. 10+66 RT RAMP C (SOLID)
 STA. 3409+50 LT GORE RAMP C - STA. 3434+68 LT GORE RAMP D (SOLID)
 STA. 3435+68 LT ALONG RAMP D- STA. 3439+00 LT (DOTTED)
 STA. 3439+00 LT ALONG RAMP D- STA. 3443+54 LT (SOLID)
 RAMP D, RIGHT, TO VT 104 INTERSECTION (SOLID)

DURABLE 12" WHITE LINE

STA. 3408+60 LT - STA. 3409+50 LT (GORE EXIT FROM RAMP C)(SOLID)
 STA. 3434+68 LT - STA. 3435+68 LT GORE ENTRANCE TO RAMP D) (SOLID)

DURABLE 6" YELLOW LINE

STA. 3280+00 RT - STA. 3443+54 RT (SOLID)
 RAMP C 10+66 LT - 28+00 LT (SOLID)
 RAMP D, LEFT, TO ST. ALBANS SOUTH STATE HIGHWAY INTERSECTION (SOLID)

TYPICAL SOUTHBOUND PAVEMENT MARKINGS

NOT TO SCALE

PROJECT: FAIRFAX-FAIRFIELD-ST. ALBANS	PROJECT NO.: IM 089-3(27)
DESIGN FILE NAME: /87A007B/DESIGN/DA007FRM.DGN	PLOT DATE: 19-AUG-2000
IPARM FILE NAME: DA007SPM.I	SURVEY DATE:
SURVEYED BY:	DRAWN BY: SQUAD B
SQUAD LEADER: DELLA SANTA	SHEET: 29 OF 370