




VT 104 TYPICAL

- FOR TRAVELWAY AND SHOULDERS:
- 3 1/2'' BITUMINOUS CONCRETE PAVEMENT  
(1 1/2'' TYPE III S OVER 2'' TYPE II S) (PG 64-34)
  - 4 1/2'' BITUMINOUS CONCRETE PAVEMENT (TYPE I S) (PG 64-34)
  - 24'' SUBBASE OF ~~DENSE GRADED CRUSHED STONE~~ GRAVEL

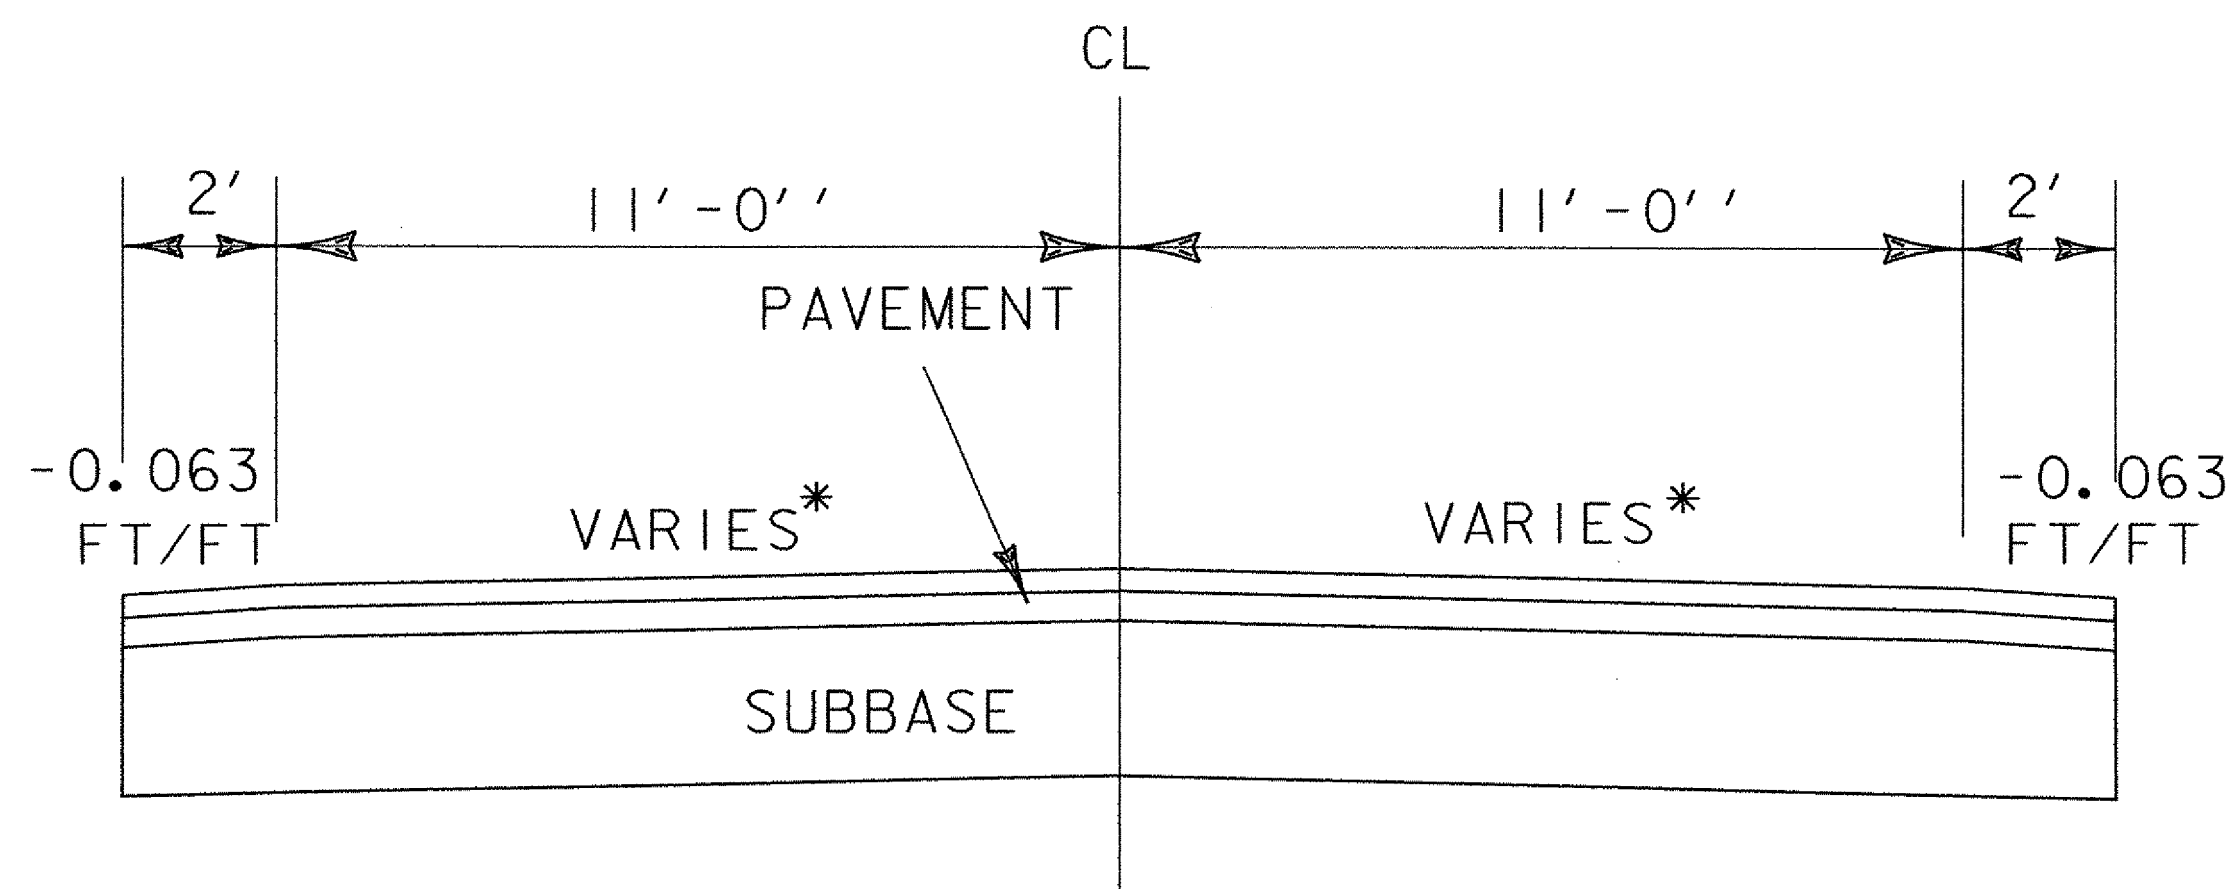

\* REFER TO THE CROSS SECTIONS

VT 104 POT 106+00 =  
VT 105 POT 205+00

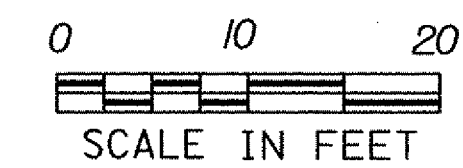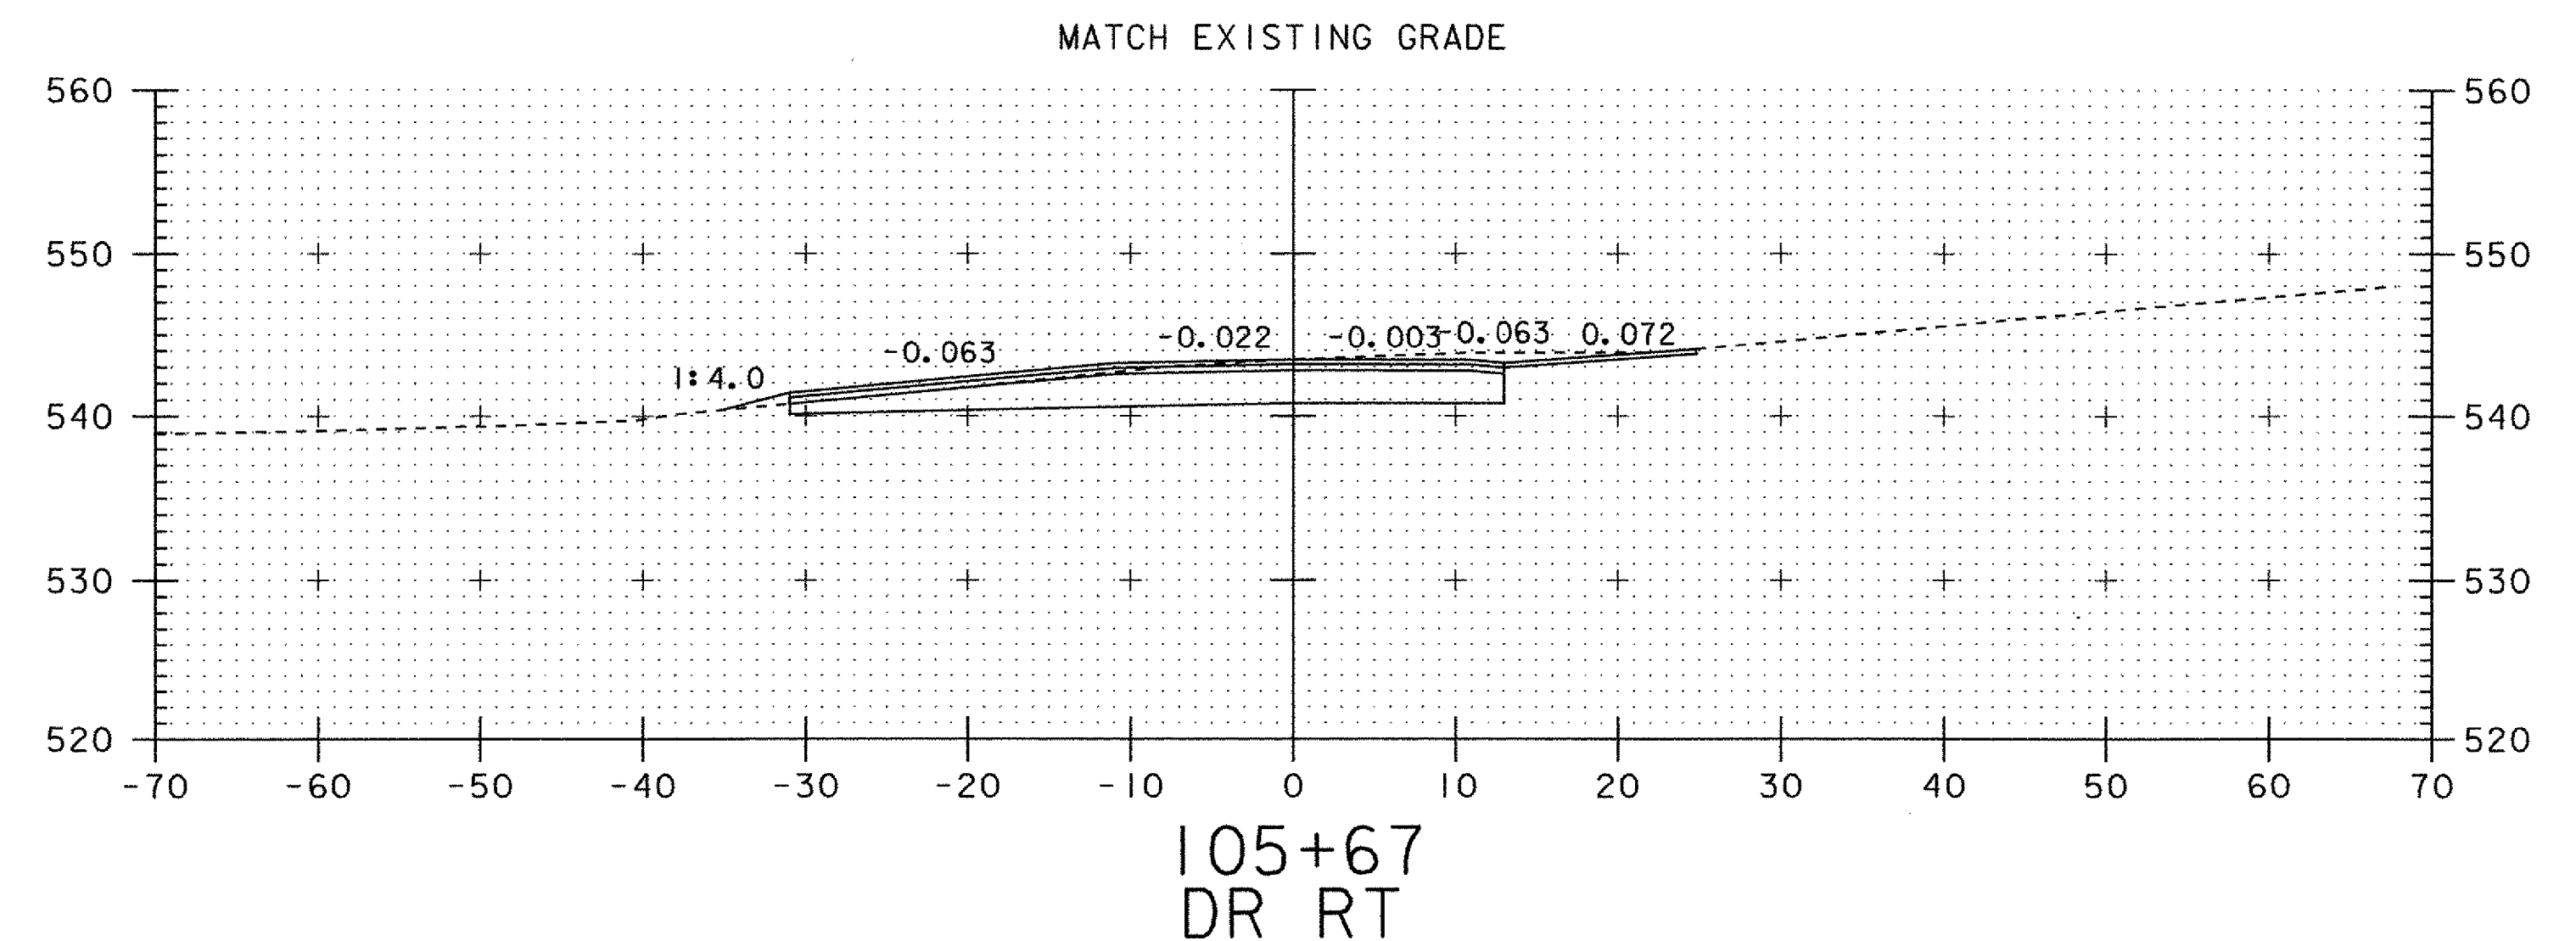

PROJECT: <b>FAIRFAX-FAIRFIELD-ST. ALBANS</b>	PROJECT NO.: <b>IM 089-3(27)</b>
DESIGN FILE NAME: /87A007B/DESIGN/DA007XS2.DGN	PLOT DATE: 22-SEP-2000
IPARM FILE NAME: DA007TXLJ	SURVEY DATE: 9/90
SURVEYED BY: R. MOREAU	DRAWN BY: SQUAD B
SQUAD LEADER: DELLA SANTA	SHEET: 40A OF 370