



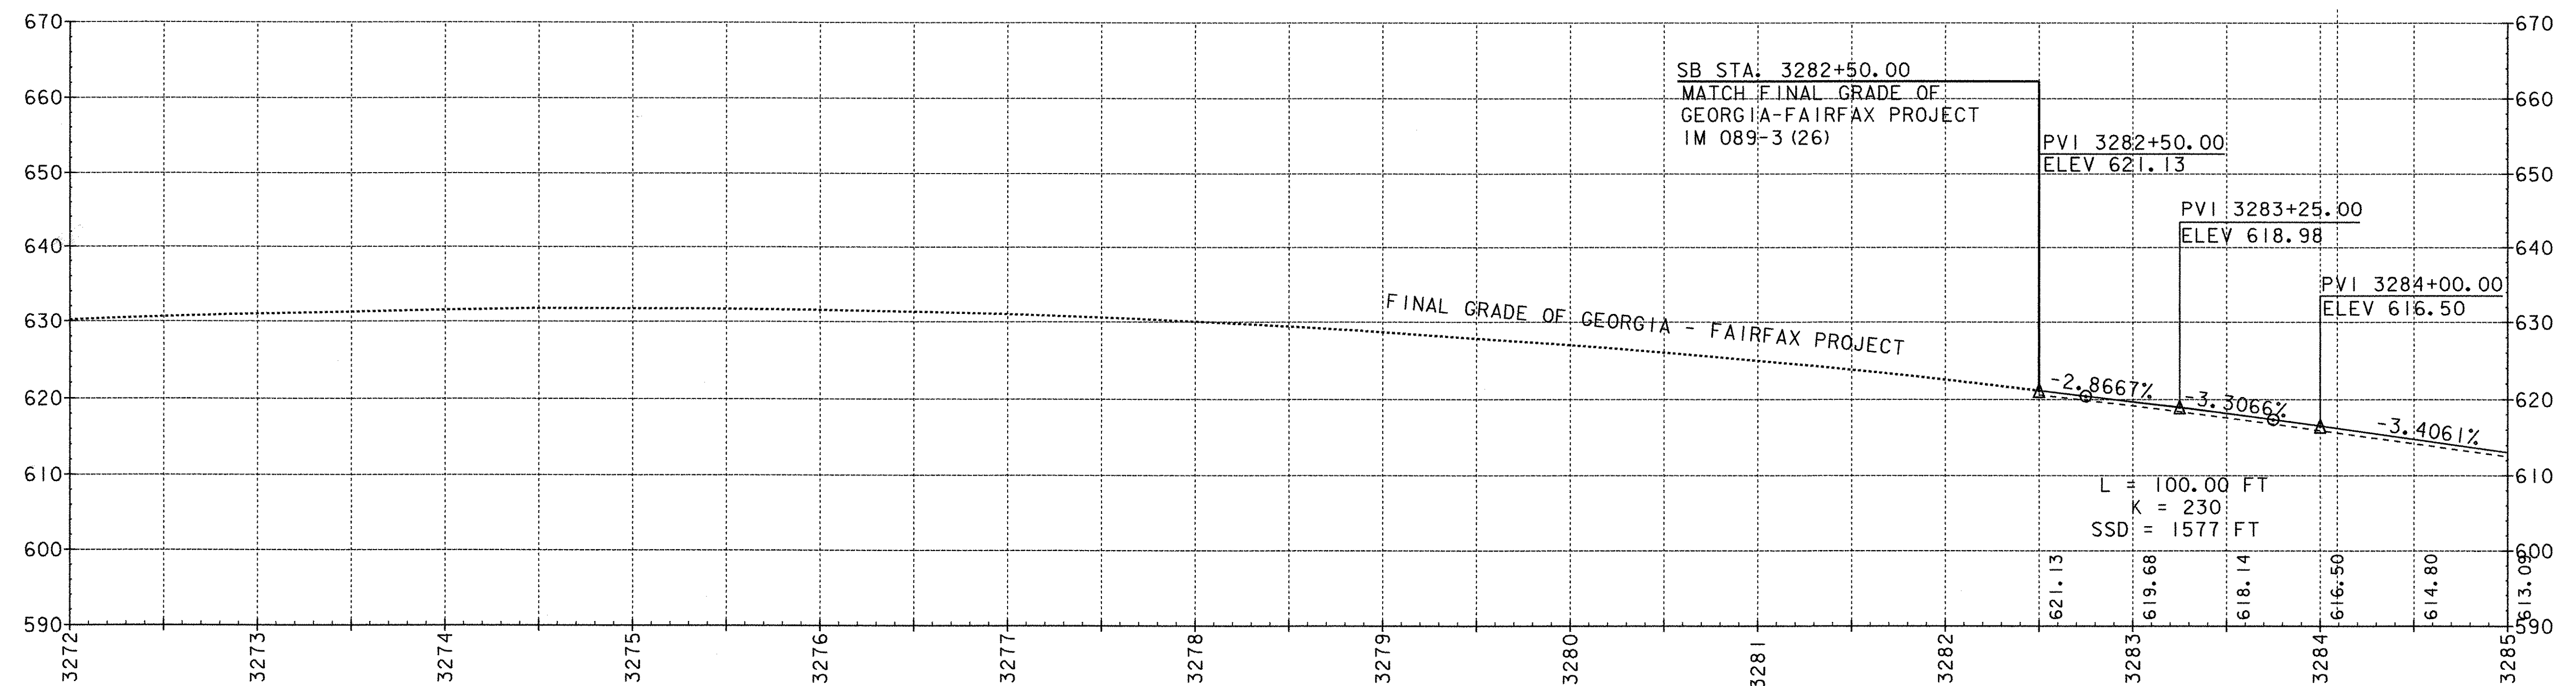

SOUTHBOUND GRADE PROFILE ALONG MEDIAN SIDE (REFER TO TYPICAL SHEET)
STA. 3272+00 - 3285+00

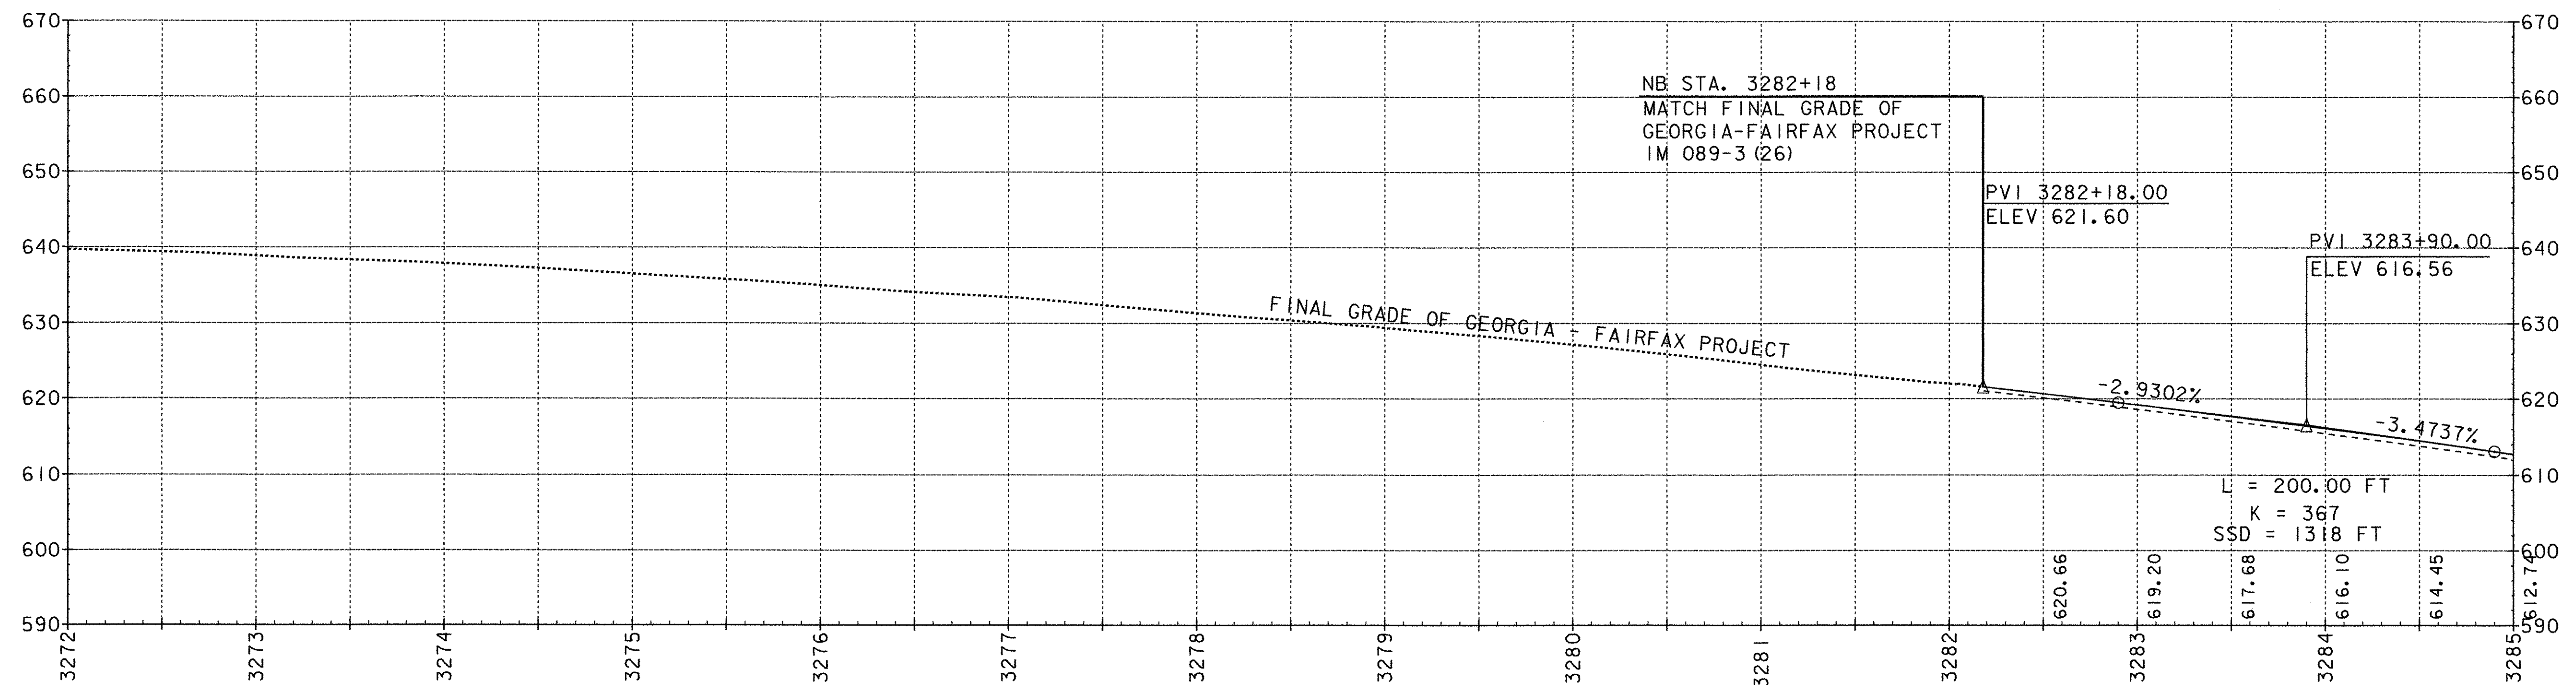

NORTHBOUND GRADE PROFILE ALONG MEDIAN SIDE (REFER TO TYPICAL SHEET)
STA. 3272+00 - 3285+00

DATUM
VERTICAL NAVD88
HORIZONTAL NAD83(92)



PROJECT: FAIRFAX - FAIRFIELD - ST. ALBANS		PROJECT NO.: IM 089-3(27)
DESIGN FILE NAME:	/87A007B/DESIGN/DA007XSLDGN	PLOT DATE: 04-OCT-2000
IPARM FILE NAME:	DA007POI	SURVEY DATE: 6/98
SURVEYED BY:	ORVIS	DRAWN BY: SQUAD B
SQUAD LEADER:	DELLA SANTA	SHEET: 50 OF 370