

STEEL BEAM GUARD RAIL
(SOUTHBOUND)
3333+00 LT - 3343+00 LT
3333+50 RT - 3336+50 RT

REMOVAL AND DISPOSAL
OF GUARD RAIL
(SOUTHBOUND)
3333+00 LT - 3349+00 LT
3334+12 RT - 3336+88 RT

REMOVAL OF EXISTING FENCE (MOD.)
STA. 3336+12 SB LT
STA. 3336+40 SB LT
WOVEN WIRE FENCE W/STEEL POSTS
STA. 3336+12 SB LT
STA. 3336+40 SB LT




MATCH LINE SB STA. 3333+00

MATCH LINE NB STA. 3333+00

MATCH LINE SB STA. 3349+00

MATCH LINE NB STA. 3349+00

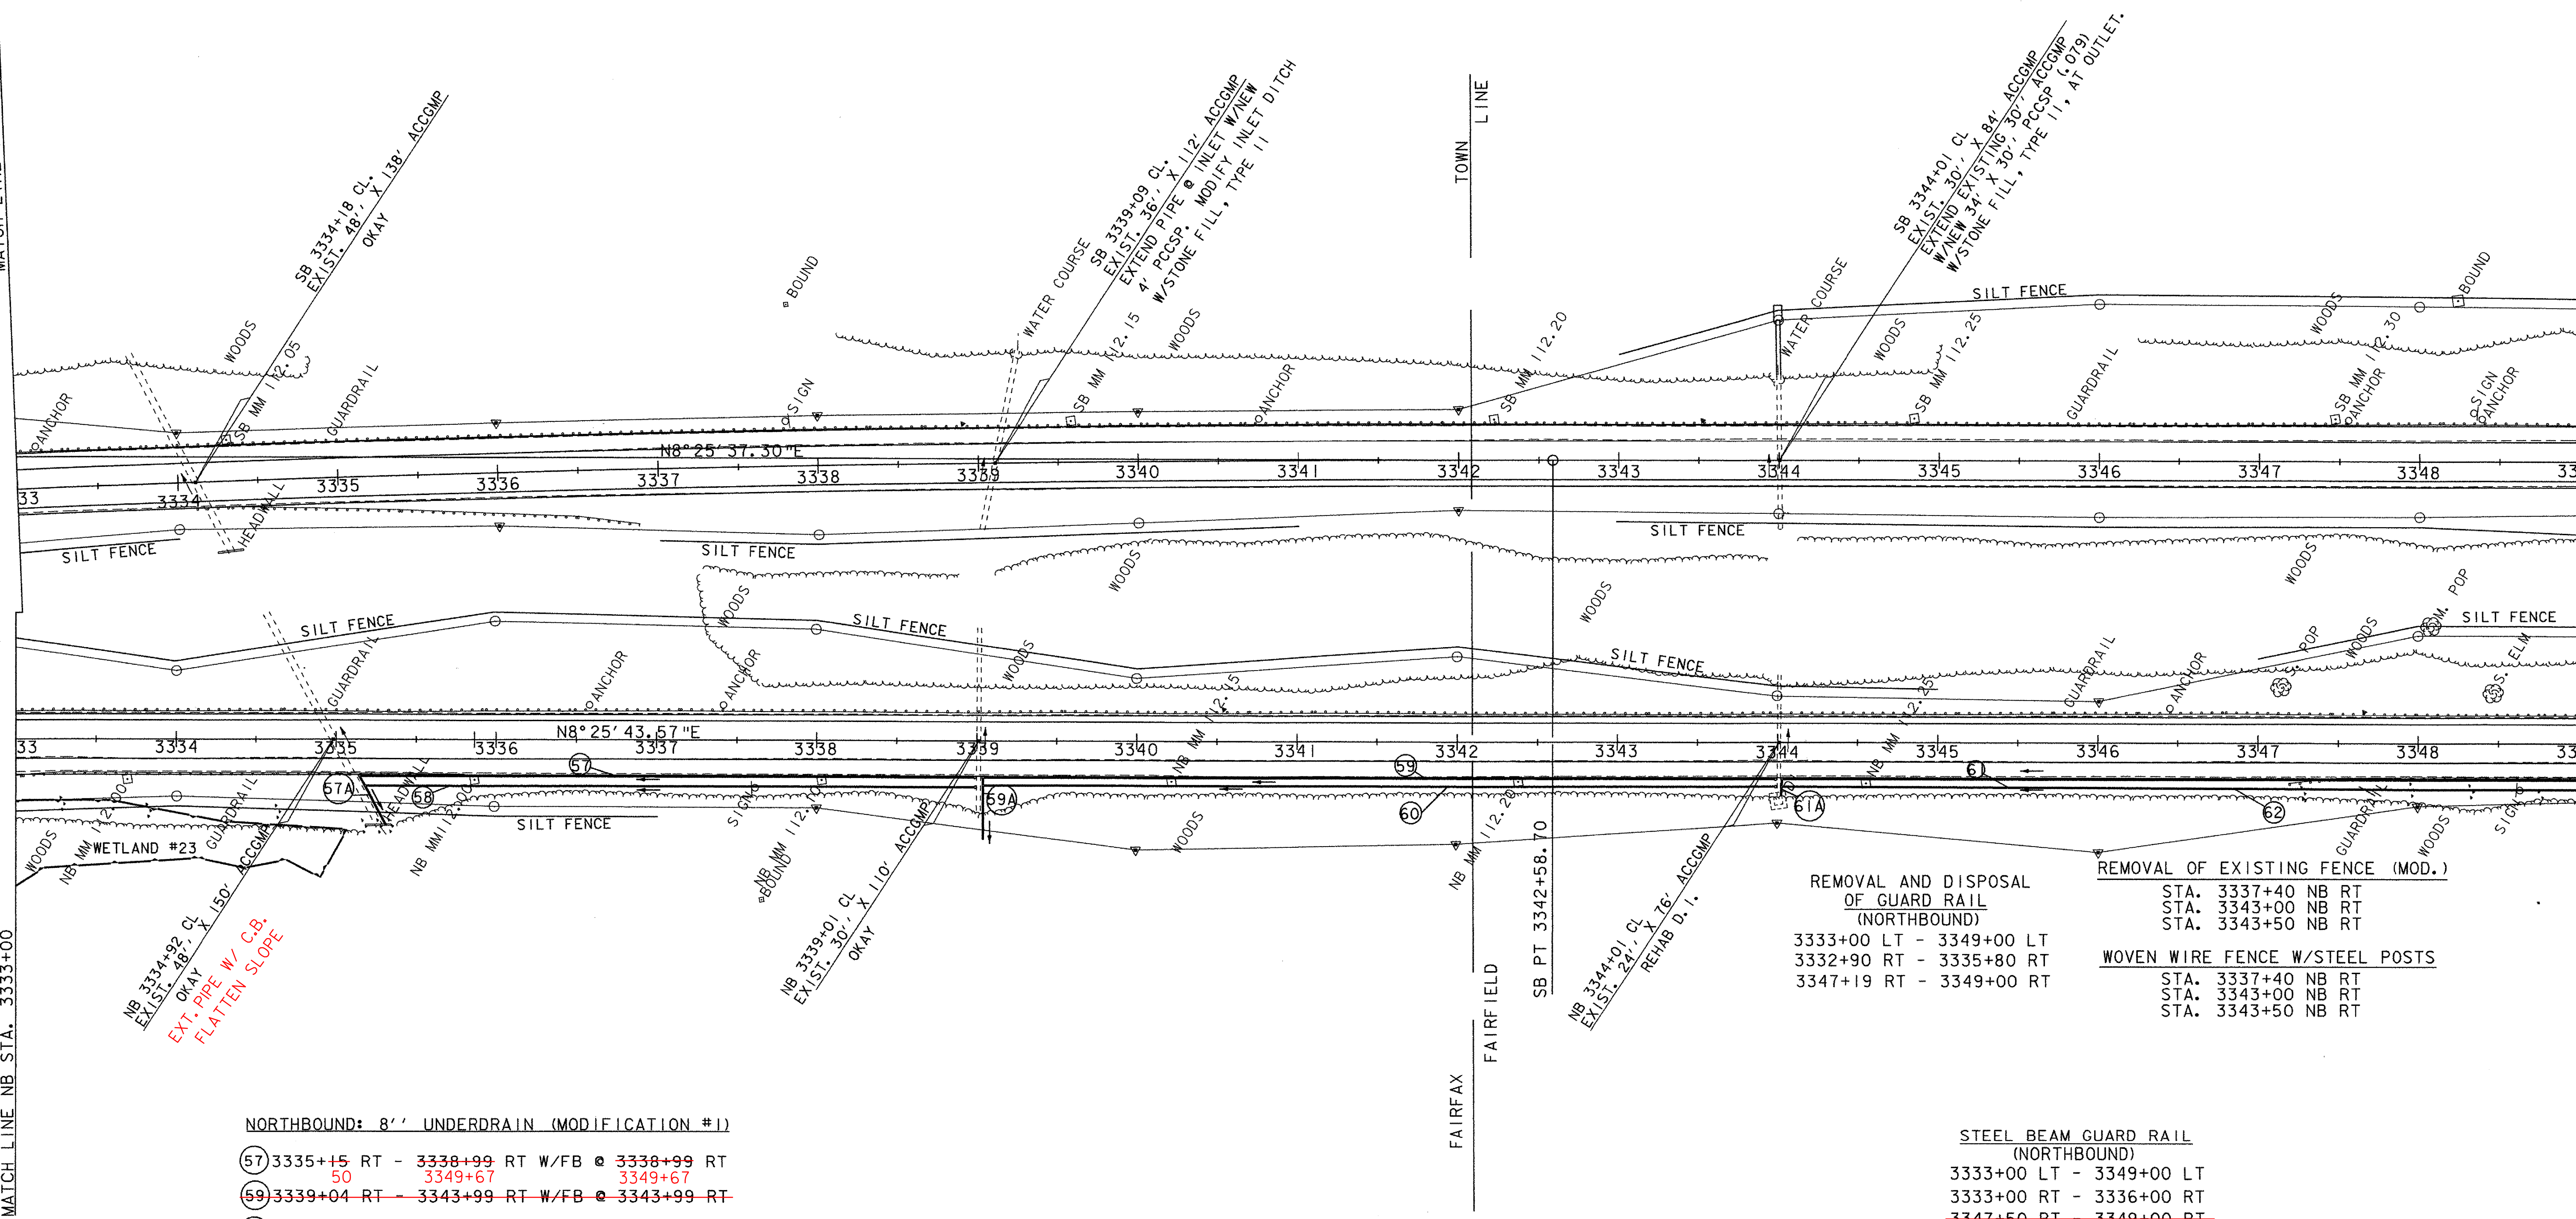

NORTHBOUND: 8" UNDERDRAIN (MODIFICATION #1)

- (57) 3335+15 RT - 3338+99 RT W/FB @ 3338+99 RT
- (59) 3339+04 RT - 3343+99 RT W/FB @ 3343+99 RT
- (61) 3344+03 RT - 3349+68 RT W/FB @ 3349+68 RT

NORTHBOUND: 8" UNDERDRAIN (MODIFICATION #2)

- (58) 3335+18 RT - 3338+99 RT W/FB @ 3338+99 RT
- (60) 3339+05 RT - 3343+99 RT W/FB @ 3343+99 RT
- (62) 3344+03 RT - 3349+68 RT W/FB @ 3349+68 RT


NORTHBOUND: 8" UNDERDRAIN CARRIER PIPE

- (57A) 3335+15 RT W/FB @ 3335+15 RT
- (59A) 3339+04 RT W/FB @ 3339+04 RT
- (61A) 3344+03 RT W/FB @ 3344+03 RT

REMOVAL AND DISPOSAL
OF GUARD RAIL
(NORTHBOUND)
3333+00 LT - 3349+00 LT
3332+90 RT - 3335+80 RT
3347+19 RT - 3349+00 RT

REMOVAL OF EXISTING FENCE (MOD.)
STA. 3337+40 NB RT
STA. 3343+00 NB RT
STA. 3343+50 NB RT
WOVEN WIRE FENCE W/STEEL POSTS
STA. 3337+40 NB RT
STA. 3343+00 NB RT
STA. 3343+50 NB RT

STEEL BEAM GUARD RAIL
(NORTHBOUND)
3333+00 LT - 3349+00 LT
3333+00 RT - 3336+00 RT
~~3347+50 RT - 3349+00 RT~~

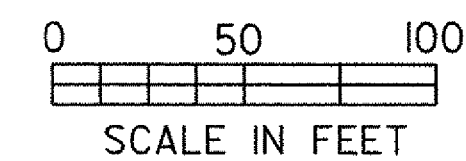

PROJECT: FAIRFAX - FAIRFIELD - ST. ALBANS		PROJECT NO.: IM 089-3(27)	
DESIGN FILE NAME:	/87A007B/DESIGN/DA007NULDGN	PLOT DATE:	18-AUG-2000
IPARM FILE NAME:	DA007L05	SURVEY DATE:	6/98
SURVEYED BY:	ORVIS	DRAWN BY:	SQUAD B
SQUAD LEADER:	DELLA SANTA	SHEET:	57 OF 370