

REMOVAL OF EXISTING FENCE (MOD.)
 STA. 3351+16 SB LT - STA. 3365+00 SB LT
 CHAIN LINK FENCE, 6 FEET
 STA. 3351+16 SB LT - STA. 3365+00 SB LT

REMOVAL AND DISPOSAL
 OF GUARD RAIL
 (SOUTHBOUND)
 3349+00 LT - 3356+10 LT
 3362+26 LT - 3365+00 LT
 3349+42 RT - 3 370+10 RT

STEEL BEAM GUARD RAIL
 (SOUTHBOUND)
 3362+50 LT - 3365+00 LT
 3349+50 RT - 3 370+00 RT

SOUTHBOUND: 8' UNDERDRAIN (MODIFICATION #1)
 (2) 3349+73 LT - 3 370+97 LT W/FB @ 3 370+97 LT
 (3) 3349+73 RT - 3 370+97 RT W/FB @ 3 370+97 RT
 (4) 3353+02 LT - 3355+96 LT W/FB @ 3355+96 LT
 (5) 3353+02 RT - 3355+96 RT W/FB @ 3355+96 RT
 (6) 3356+00 LT - 3363+47 LT W/FB @ 3356+00 LT & 3359+75 LT
 (7) 3356+00 RT - 3363+47 RT W/FB @ 3356+00 RT & 3359+75 LT
 (9) 3363+53 LT - 3365+00 LT W/FB @ 3363+53 LT
 (20) 3363+53 RT - 3365+00 RT W/FB @ 3363+53 RT

SOUTHBOUND: 8' UNDERDRAIN CARRIER PIPE
 (2A) 3349+73 LT W/FB @ 3349+73 LT
 (3A) 3349+73 RT W/FB @ 3349+73 RT
 (4A) 3353+02 LT W/FB @ 3353+02 LT
 (5A) 3353+02 RT W/FB @ 3353+02 RT
 (6A) 3363+47 LT W/FB @ 3363+47 LT
 (17A) 3363+47 RT W/FB @ 3363+47 RT

SOUTHBOUND: 8' UNDERDRAIN (MODIFICATION #2)
 (18) 3355+50 RT - 3363+47 RT W/FB @ 3355+50 RT & 3359+50 RT
 (2) 3363+53 RT - 3365+00 RT W/FB @ 3363+53 RT




MATCH LINE SB STA. 3349+00

MATCH LINE SB STA. 3365+00

MATCH LINE NB STA. 3349+00

MATCH LINE NB STA. 3365+00

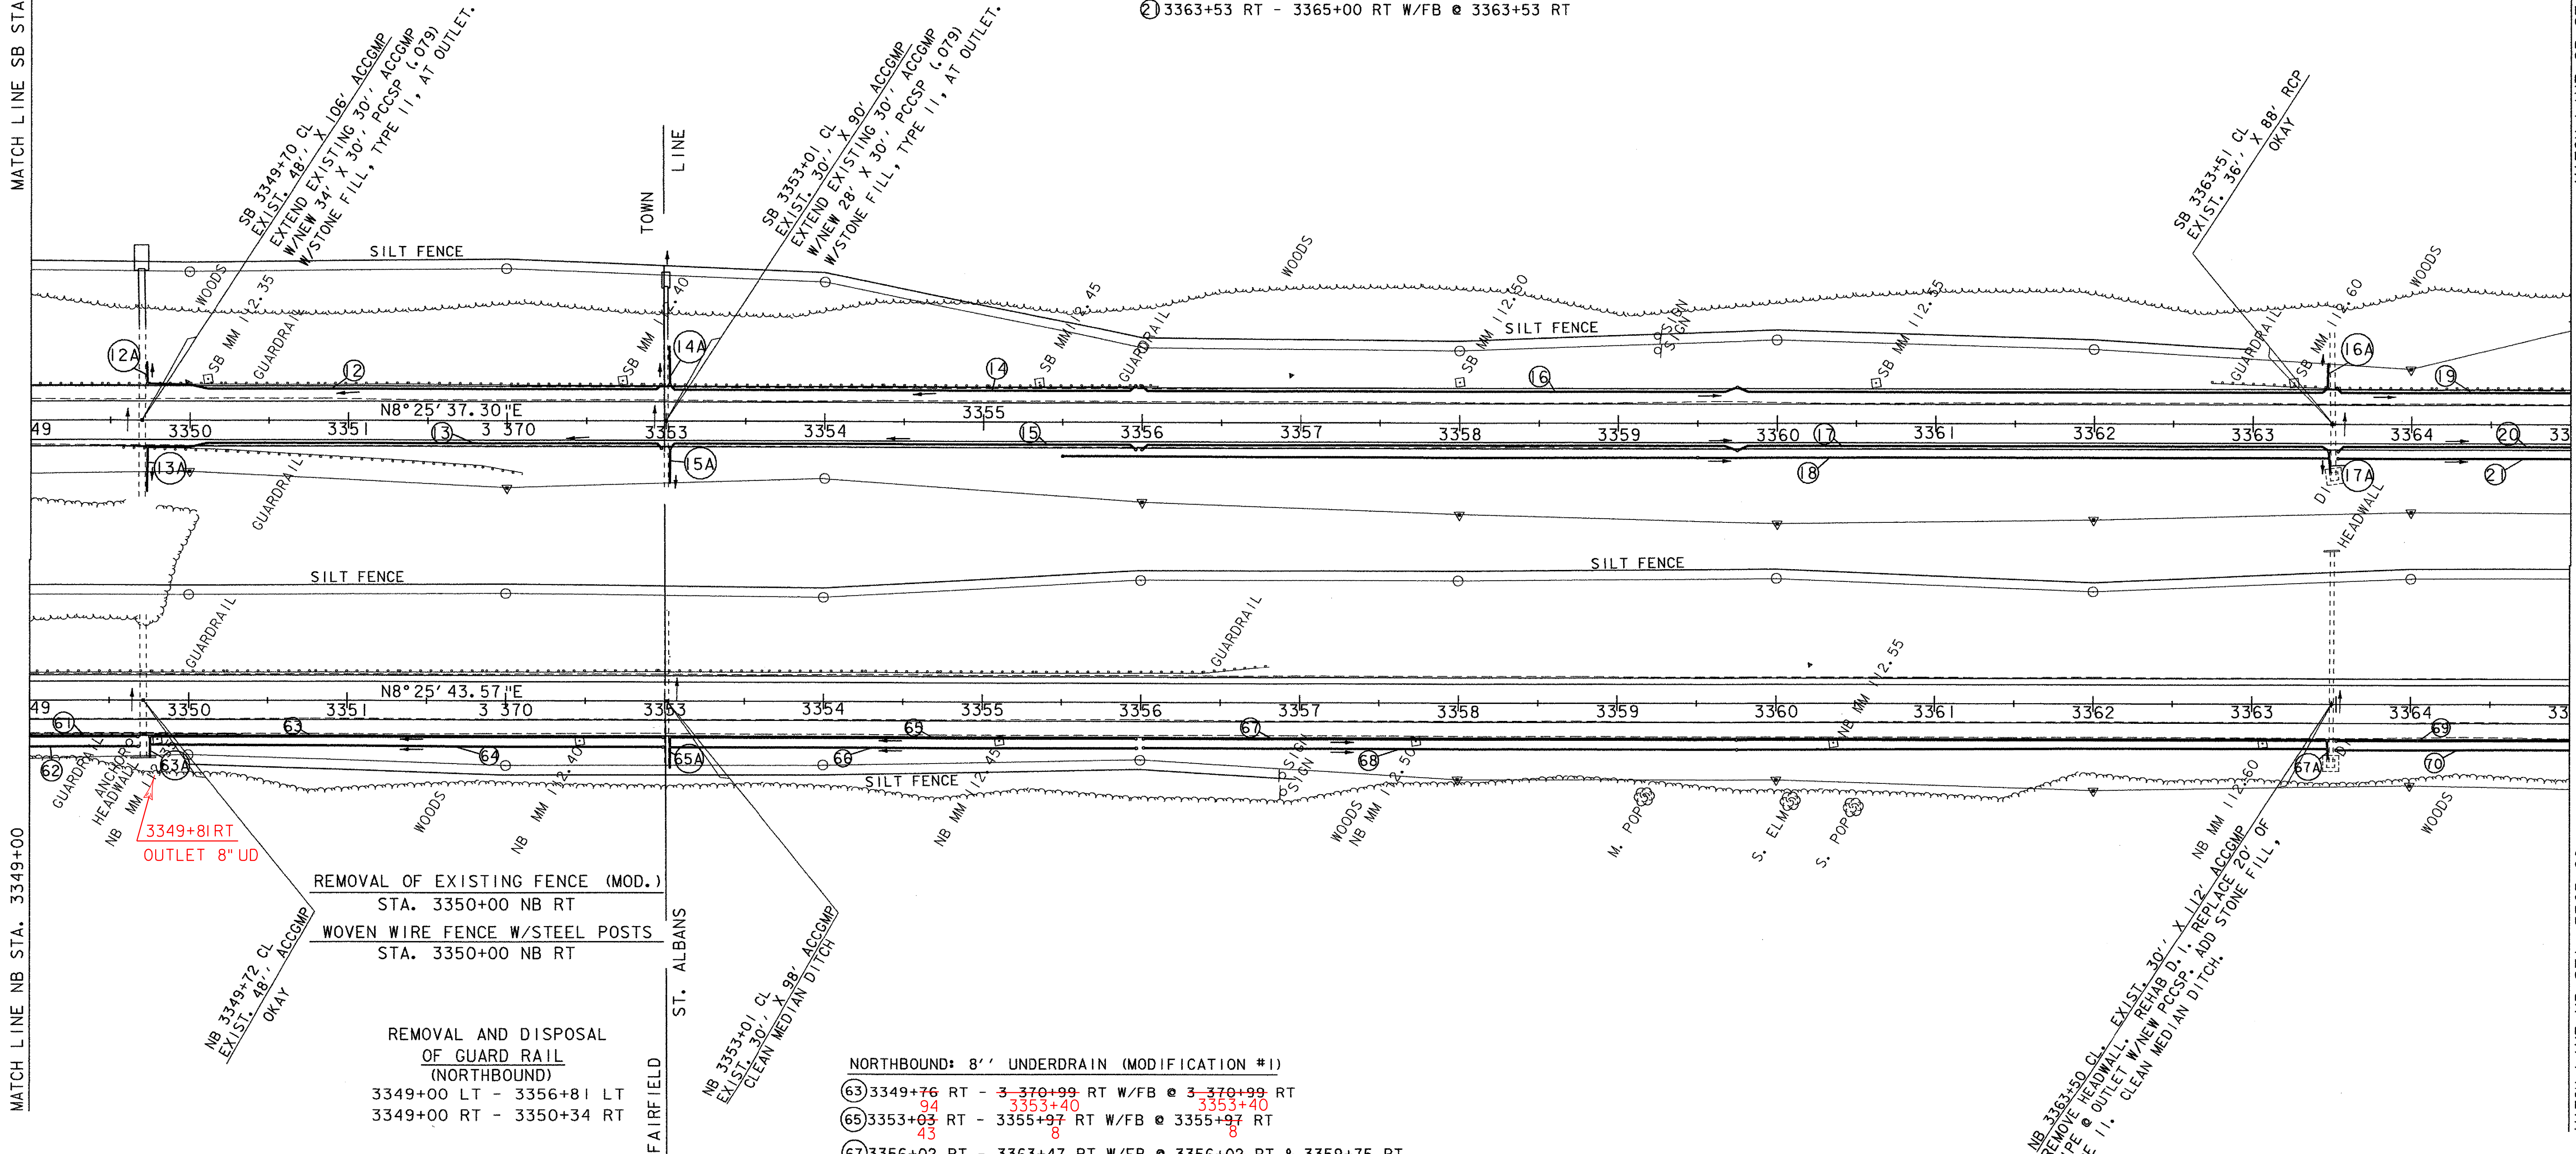

REMOVAL OF EXISTING FENCE (MOD.)
 STA. 3350+00 NB RT
 WOVEN WIRE FENCE W/STEEL POSTS
 STA. 3350+00 NB RT

REMOVAL AND DISPOSAL
 OF GUARD RAIL
 (NORTHBOUND)
 3349+00 LT - 3356+81 LT
 3349+00 RT - 3350+34 RT

STEEL BEAM GUARD RAIL
 (NORTHBOUND)
 3349+00 LT - 3355+50 LT
 3349+00 RT - 3350+50 RT
 ADDED 24"X12" PCCSP W/C.B.


NORTHBOUND: 8' UNDERDRAIN (MODIFICATION #1)
 (63) 3349+76 RT - 3 370+99 RT W/FB @ 3 370+99 RT
 (65) 3353+03 RT - 3355+97 RT W/FB @ 3355+97 RT
 (67) 3356+02 RT - 3363+47 RT W/FB @ 3356+02 RT & 3359+75 RT
 (69) 3363+53 RT - 3365+00 RT W/FB @ 3363+53 RT

NORTHBOUND: 8' UNDERDRAIN (MODIFICATION #2)
 (64) 3349+76 RT - 3 370+99 RT W/FB @ 3 370+99 RT
 (66) 3353+05 RT - 3355+97 RT W/FB @ 3355+97 RT
 (68) 3356+02 RT - 3363+47 RT W/FB @ 3356+02 RT & 3359+75 RT
 (70) 3363+53 RT - 3365+00 RT W/FB @ 3363+53 RT

NORTHBOUND: 8' UNDERDRAIN CARRIER PIPE
 (63A) 3349+76 RT W/FB @ 3349+76 RT
 (65A) 3353+03 RT W/FB @ 3353+03 RT
 (67A) 3363+47 RT W/FB @ 3363+47 RT

NB 3363+50 CL. EXIST. 30' X 112' ACCOMP
 REMOVE HEADWALL, REPAIR D.I., REPLACE 20' OF
 PIPE @ OUTLET W/NEW PCCSP. ADD STONE FILL,
 TYPE II. CLEAN MEDIAN DITCH.

DATUM
 VERTICAL NAVD88
 HORIZONTAL NAD83(92)

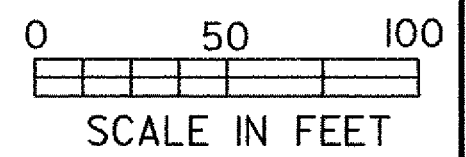

PROJECT: FAIRFAX - FAIRFIELD - ST. ALBANS		PROJECT NO.: IM 089-3(27)
DESIGN FILE NAME: /B7A007B/DESIGN/DA007NUI.DGN	PLOT DATE: 15-NOV-2000	
IPARM FILE NAME: DA007LOG	SURVEY DATE: 6/98	
SURVEYED BY: ORVIS	DRAWN BY: SQUAD B	
SQUAD LEADER: DELLA SANTA	SHEET: 59 OF 370	