



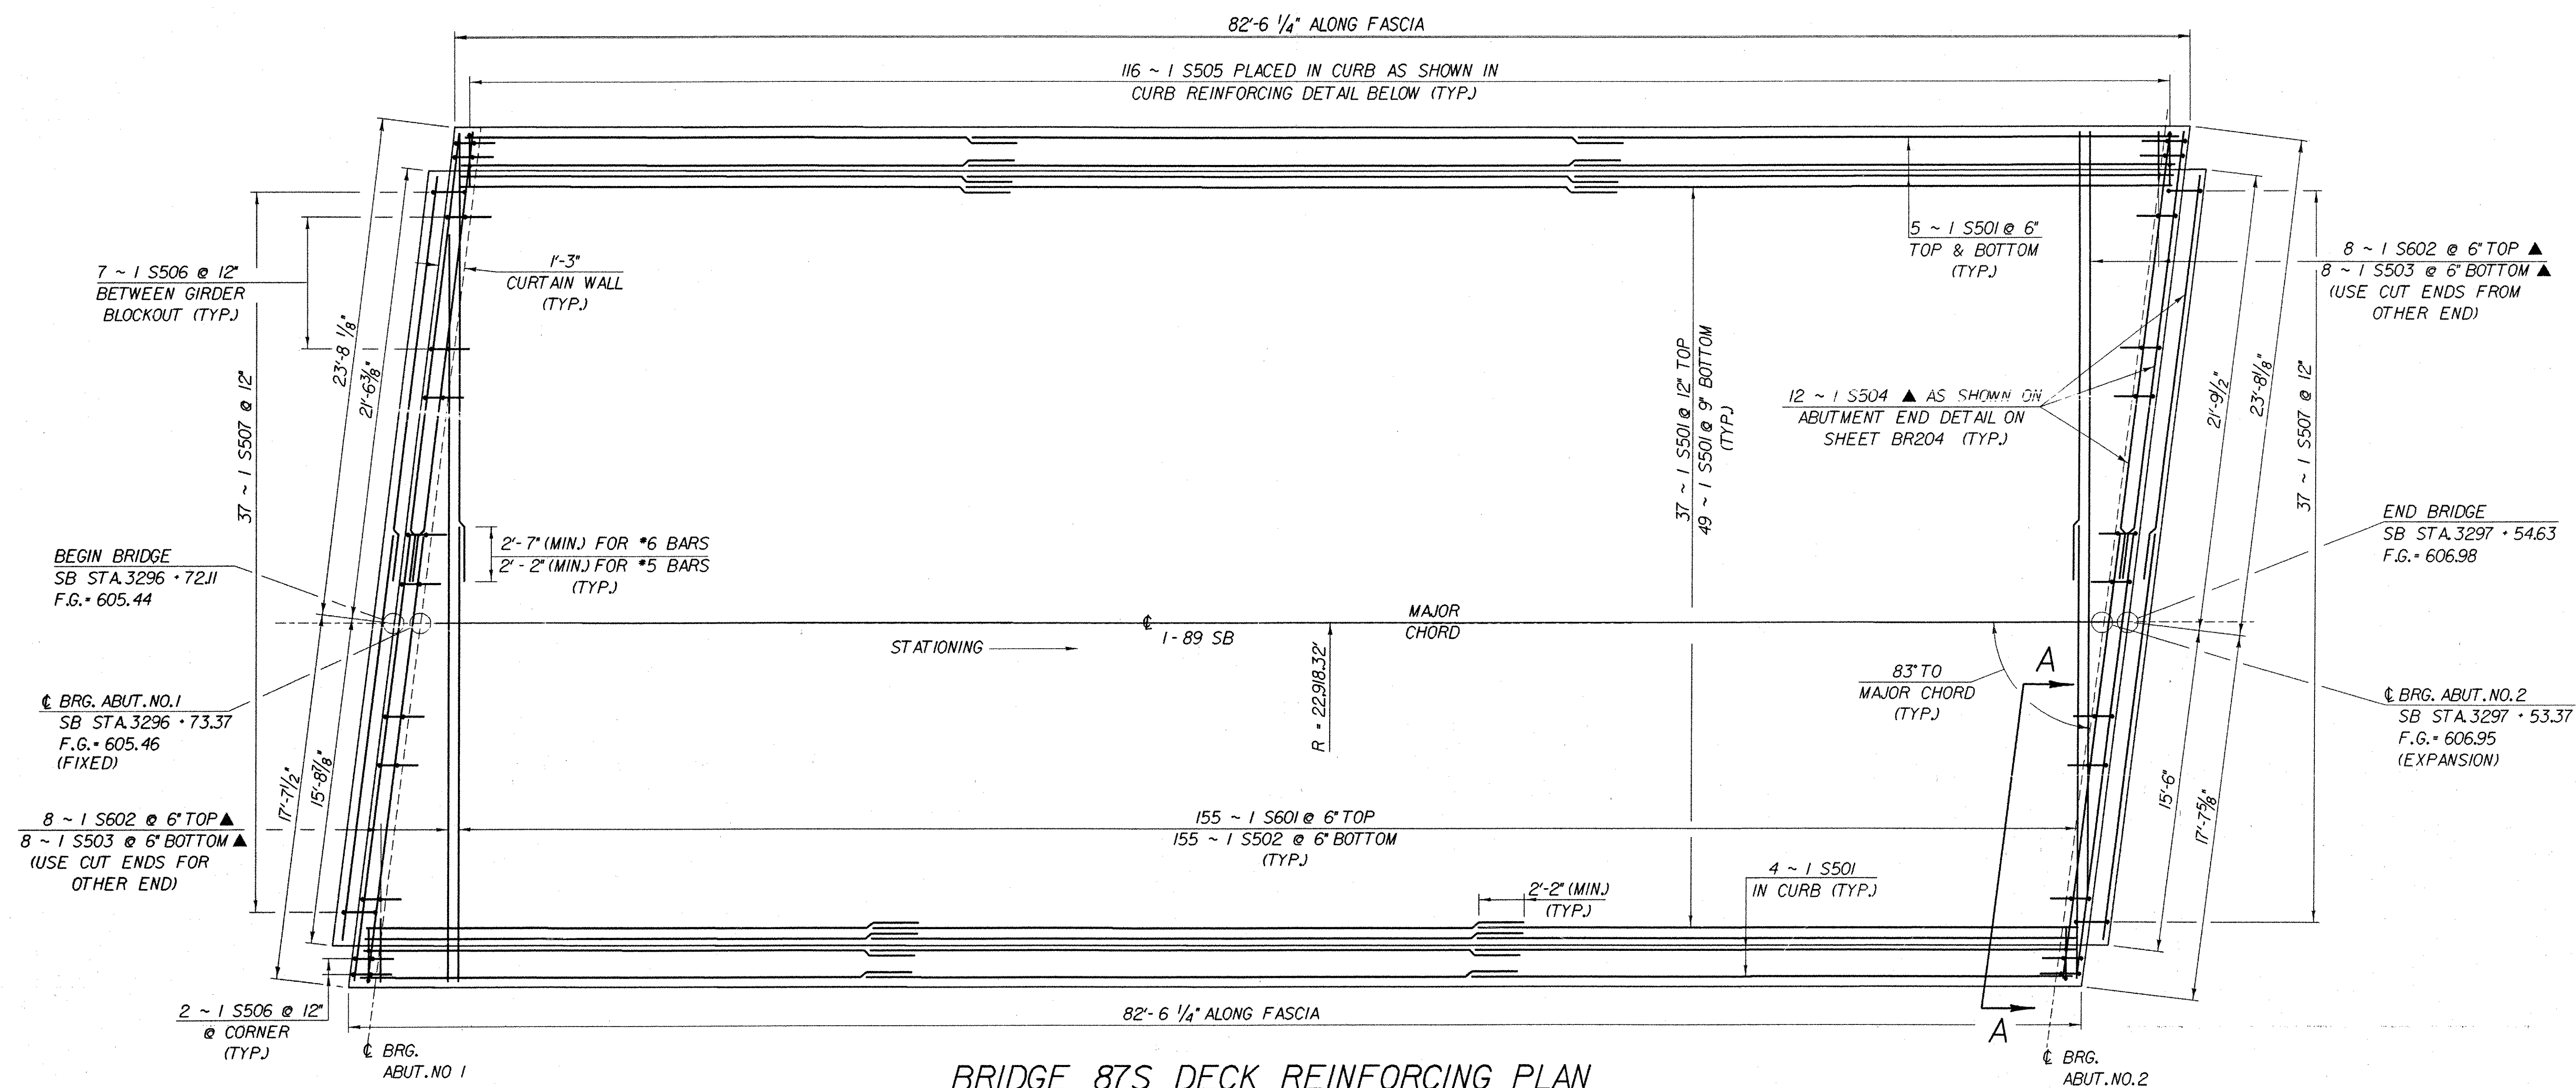


BRIDGE 87S DECK REINFORCING PLAN

SCALE: 1/4" = 1'-0"

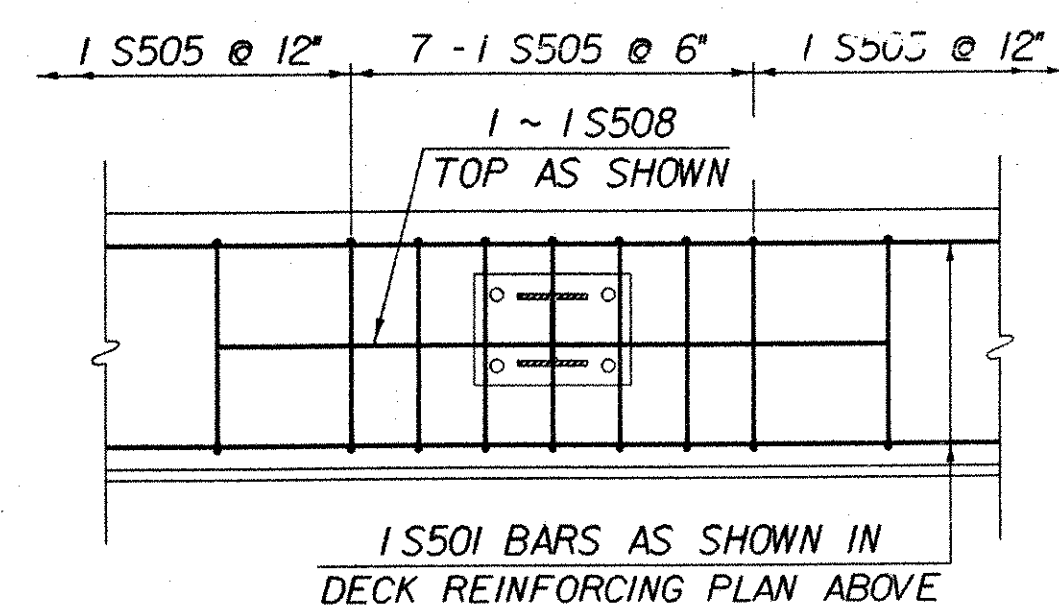

CURB REINFORCING DETAIL

NTS

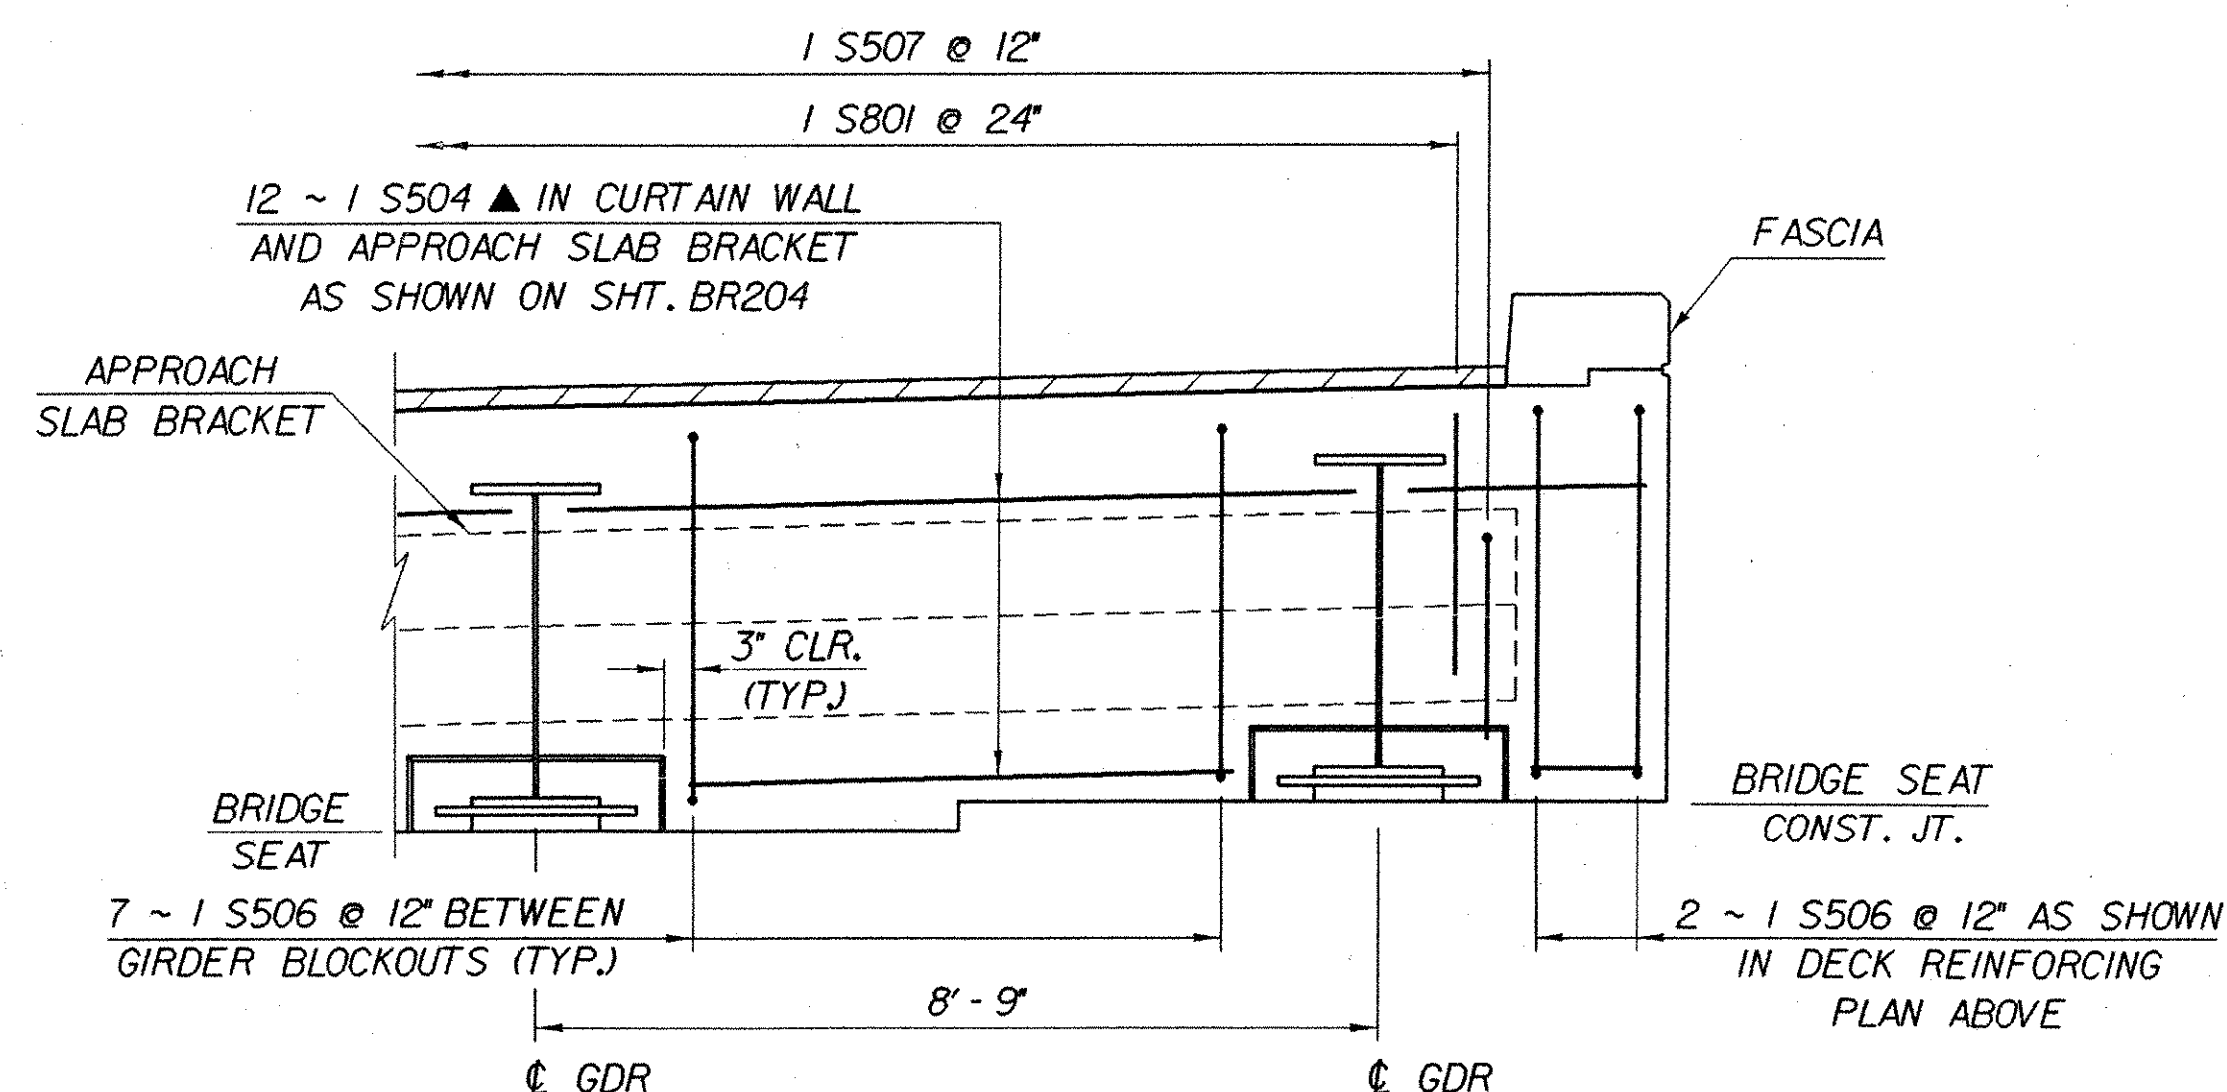

SECTION A - A

SCALE: 1/2" = 1'-0"

IMPORTANT NOTE: BRIDGE FINISHED GRADES ARE CENTERLINE GRADES.

STATE OF VERMONT AGENCY OF TRANSPORTATION

Town Of FAIRFAX-FAIRFIELD-ST. ALBANS	Bridge No. 87 S
Highway No. 1-89	Log Sta. Surv. Sta.
1-89 OVER VT 104	
87S DECK REINFORCING PLAN	
Designed By M. LOZIER	Drawn By K. CHISHOLM
Checked By G. ROY	Bridge Design Supervisor R. R. WHITCOMB
Date 10/99	Date 11/99
PROJECT FAIRFAX-FAIRFIELD-ST. ALBANS	PROJECT NO. 1 M 089 - 3 (27)
I.G.C. Info. 96a056Structures\sa056sp2.dgn	sa056sp5j
Bridge Sheet No. BR205	Sheet 83 of 370

PLOTTED 21-SEP-2000