
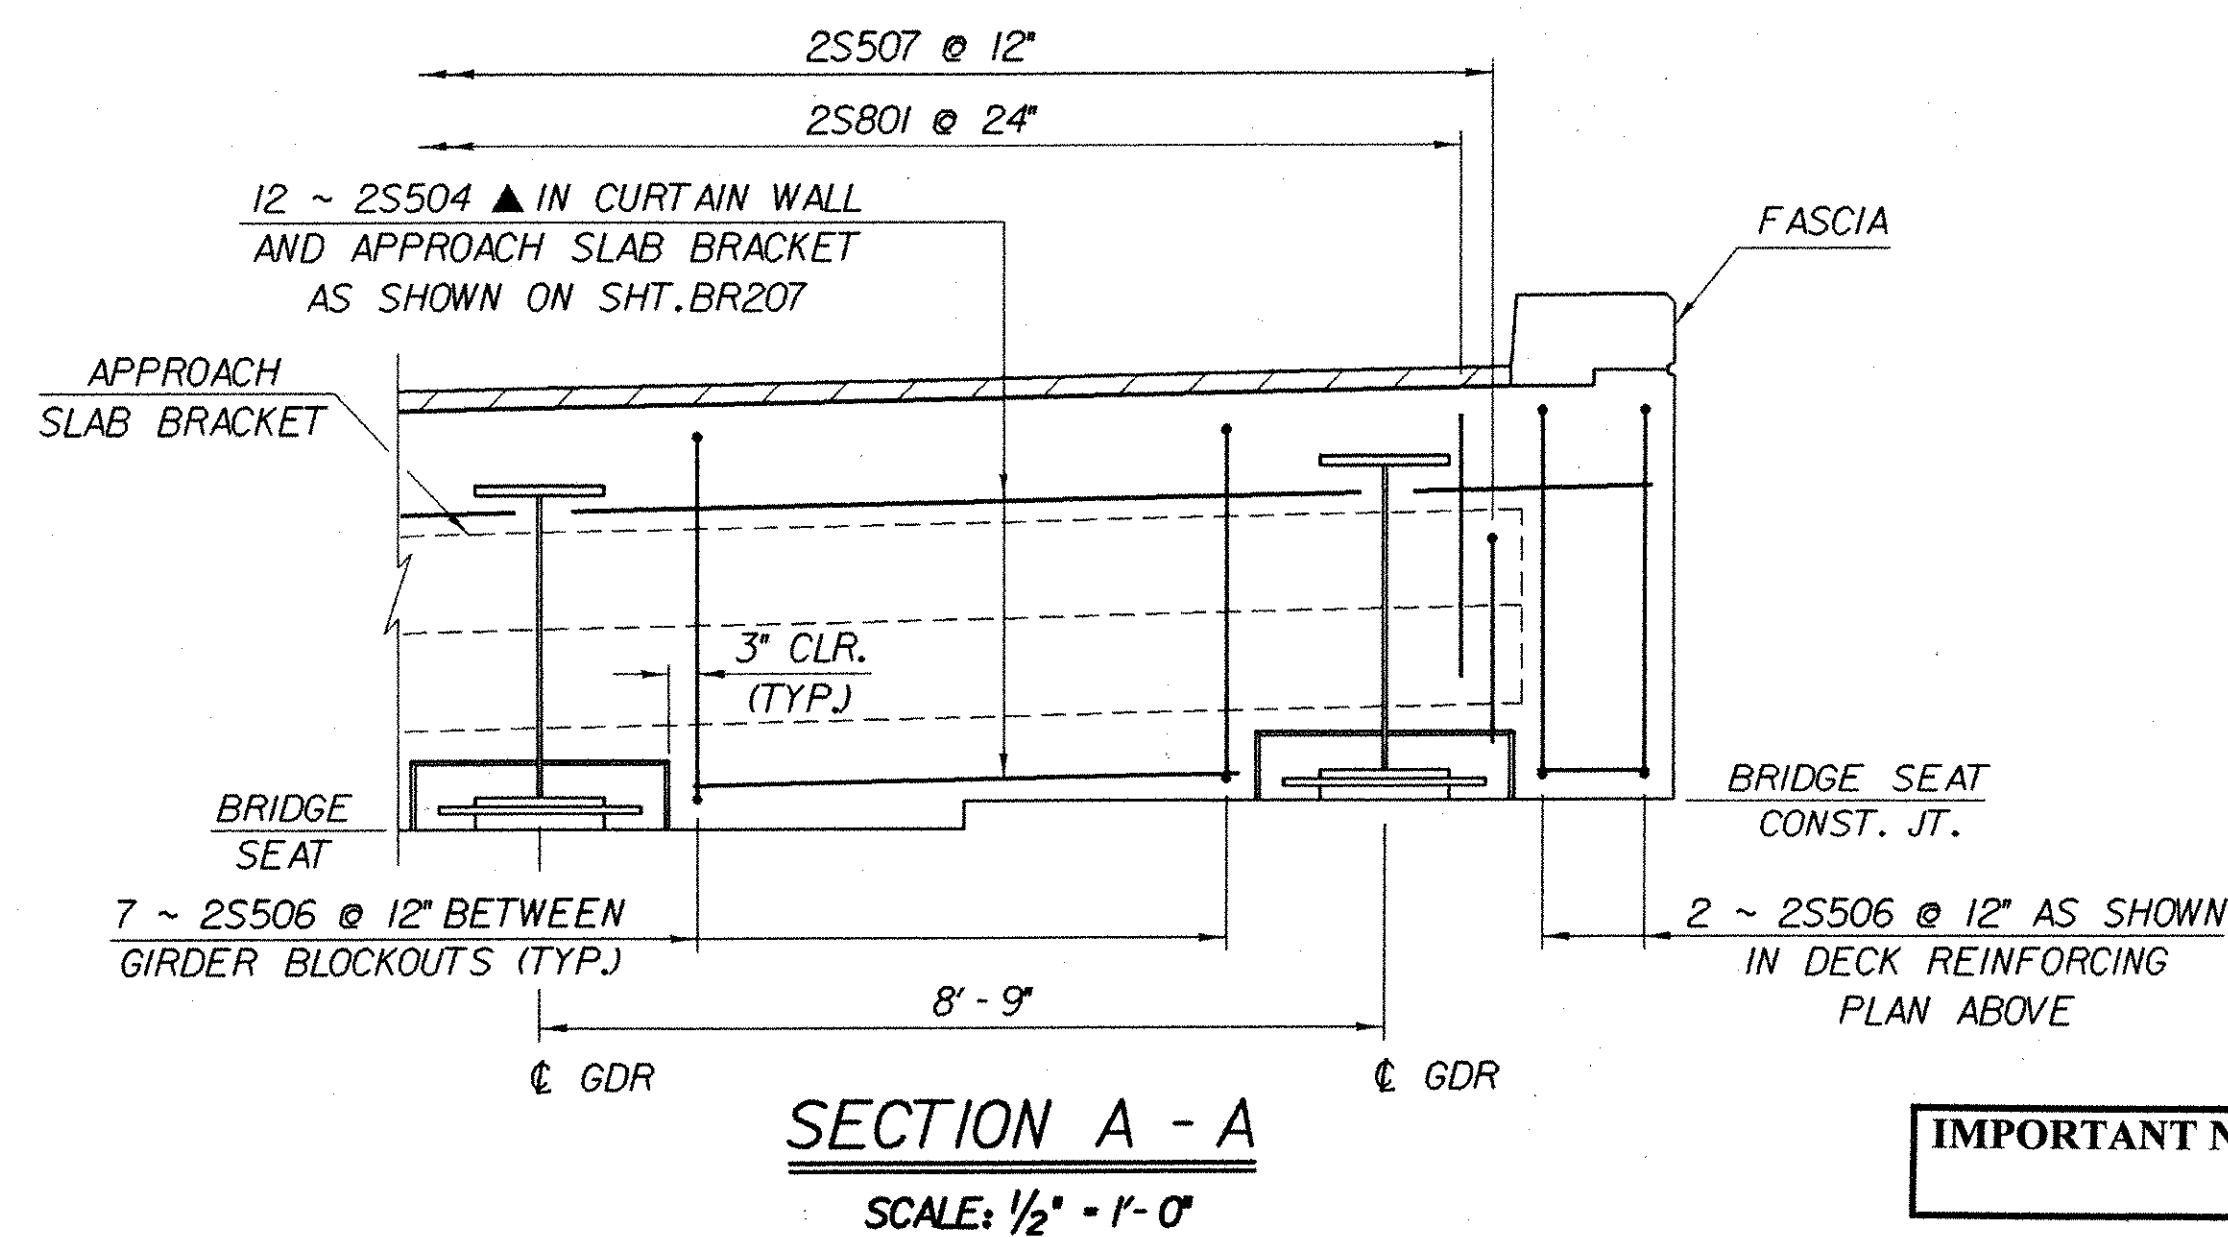


BRIDGE 87N DECK REINFORCING PLAN

SCALE: 1/4" = 1'-0"

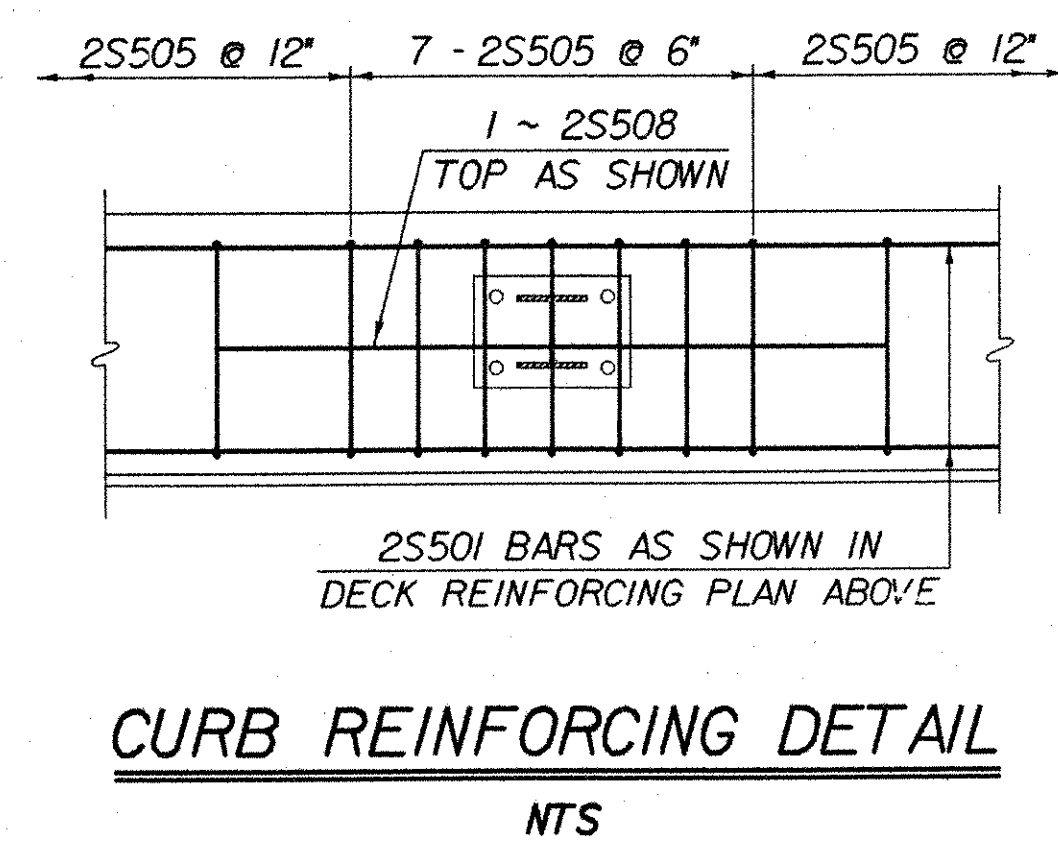

IMPORTANT NOTE: BRIDGE FINISHED GRADES ARE CENTERLINE GRADES.

**STATE OF VERMONT
AGENCY OF TRANSPORTATION**

Town of FAIRFAX-FAIRFIELD-ST. ALBANS		Bridge No. 87 N
Highway No. 1-89	Log Sta. Surv. Sta.	
1-89 NB OVER VT 104		
87N DECK REINFORCING PLAN		
Designed By M.LOZIER	Drawn By K.CHISHOLM	
Checked By G.ROY	Date 10/99	Bridge Design Supervisor R.R.WHITCOMB Date 11/99
PROJECT FAIRFAX-FAIRFIELD-ST. ALBANS		PROJECT NO. 1M 089 - 3 (27)
I.G.C. Info. 96a056\Structures\sa056spl.dgn		sa056spl.dgn
Bridge Sheet No. BR208	Sheet 86 of 370	