
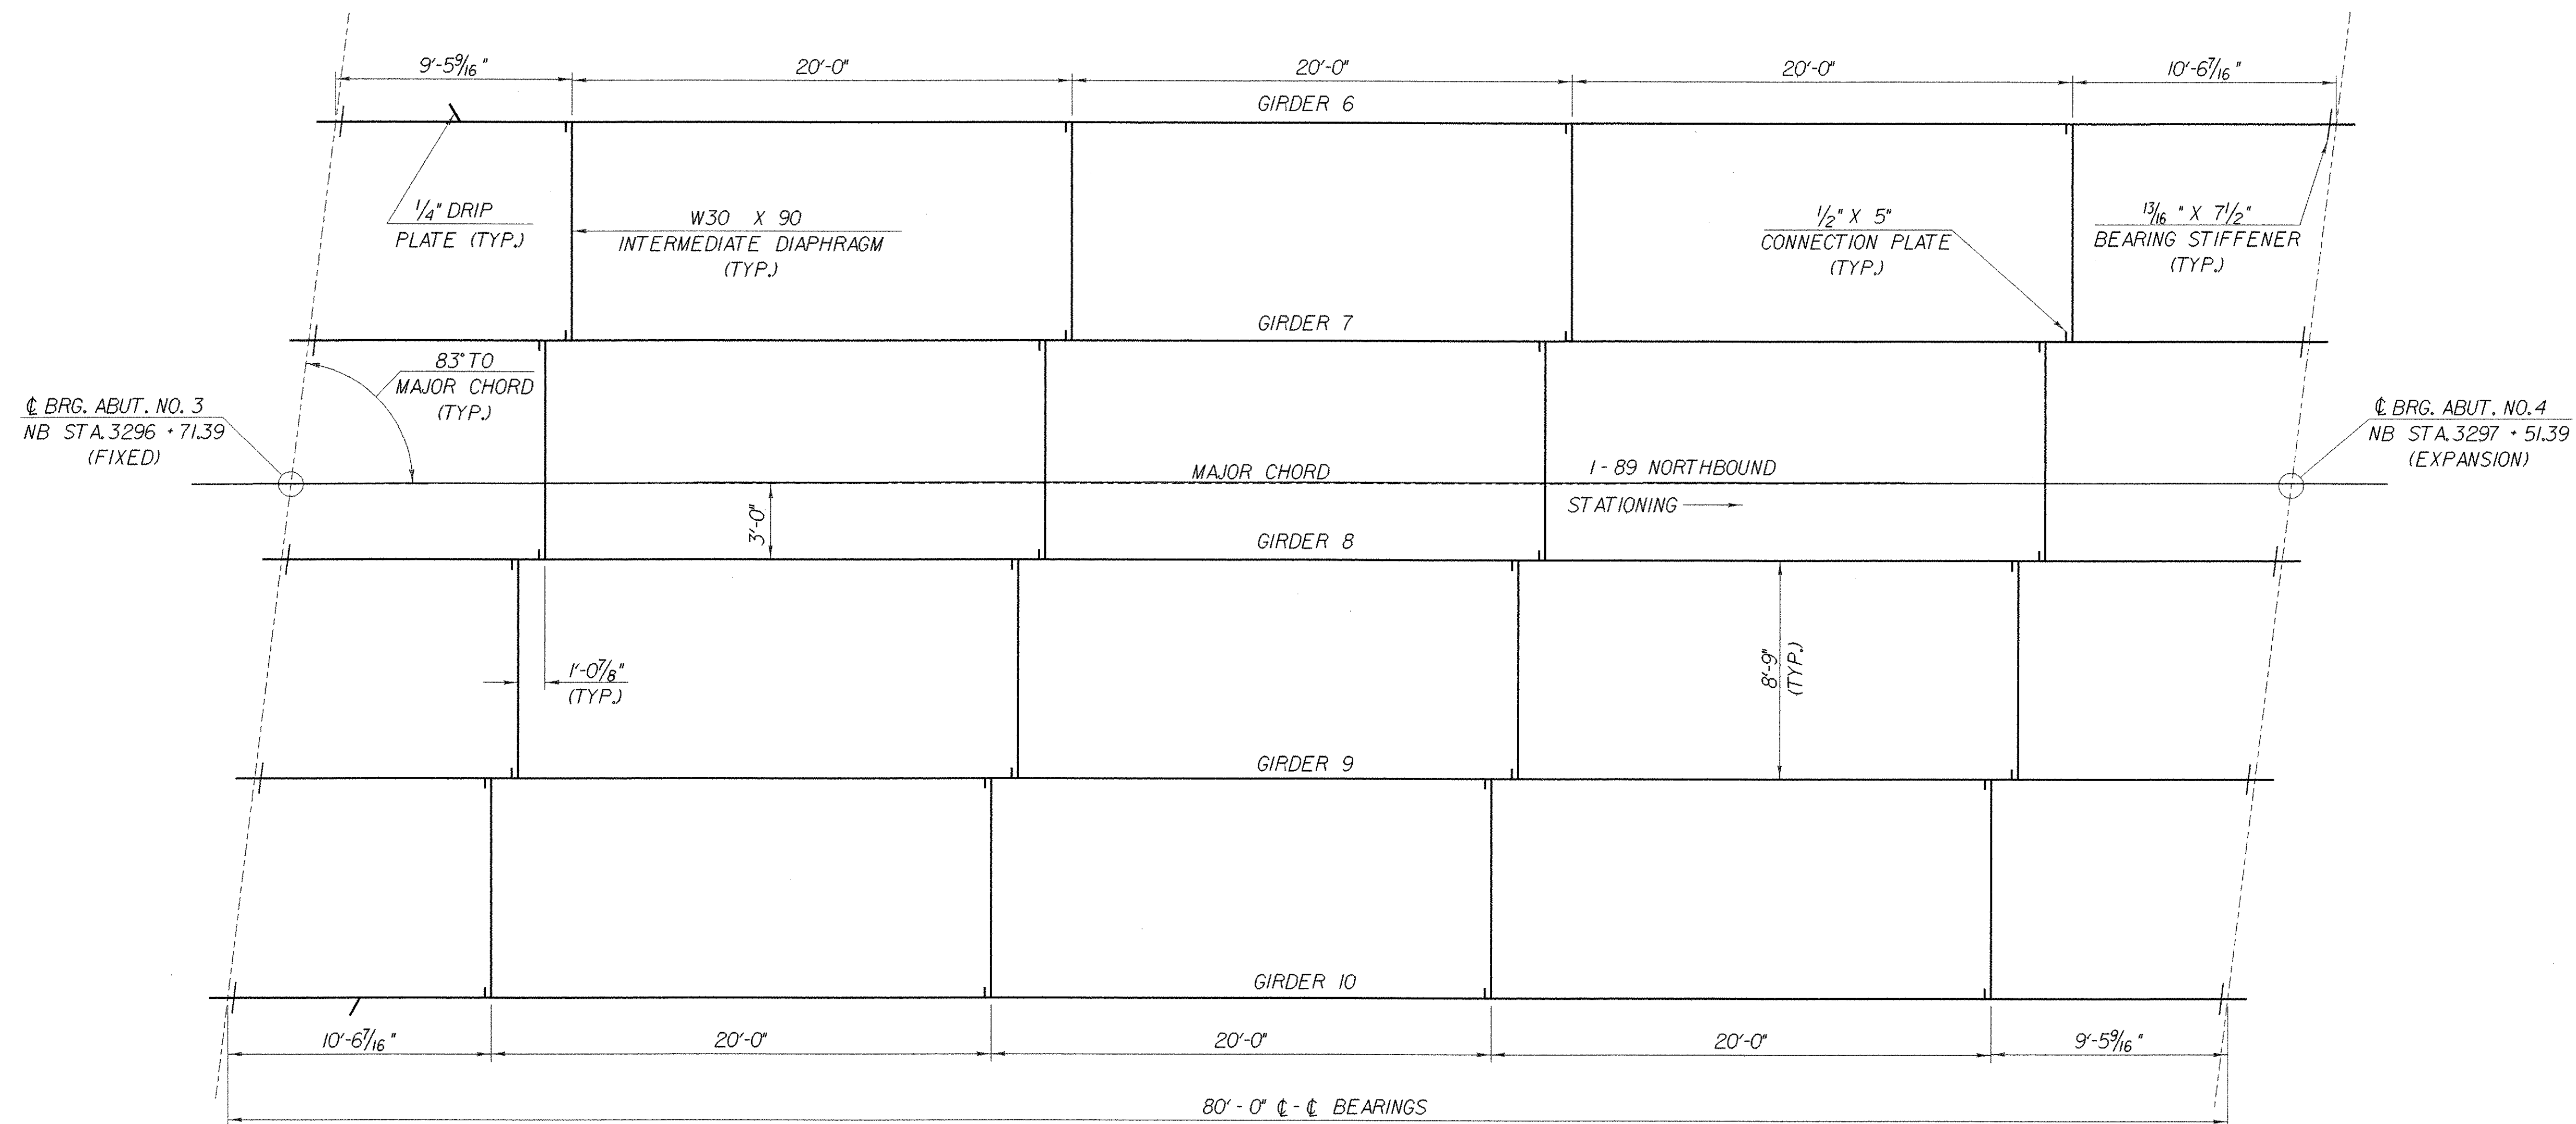


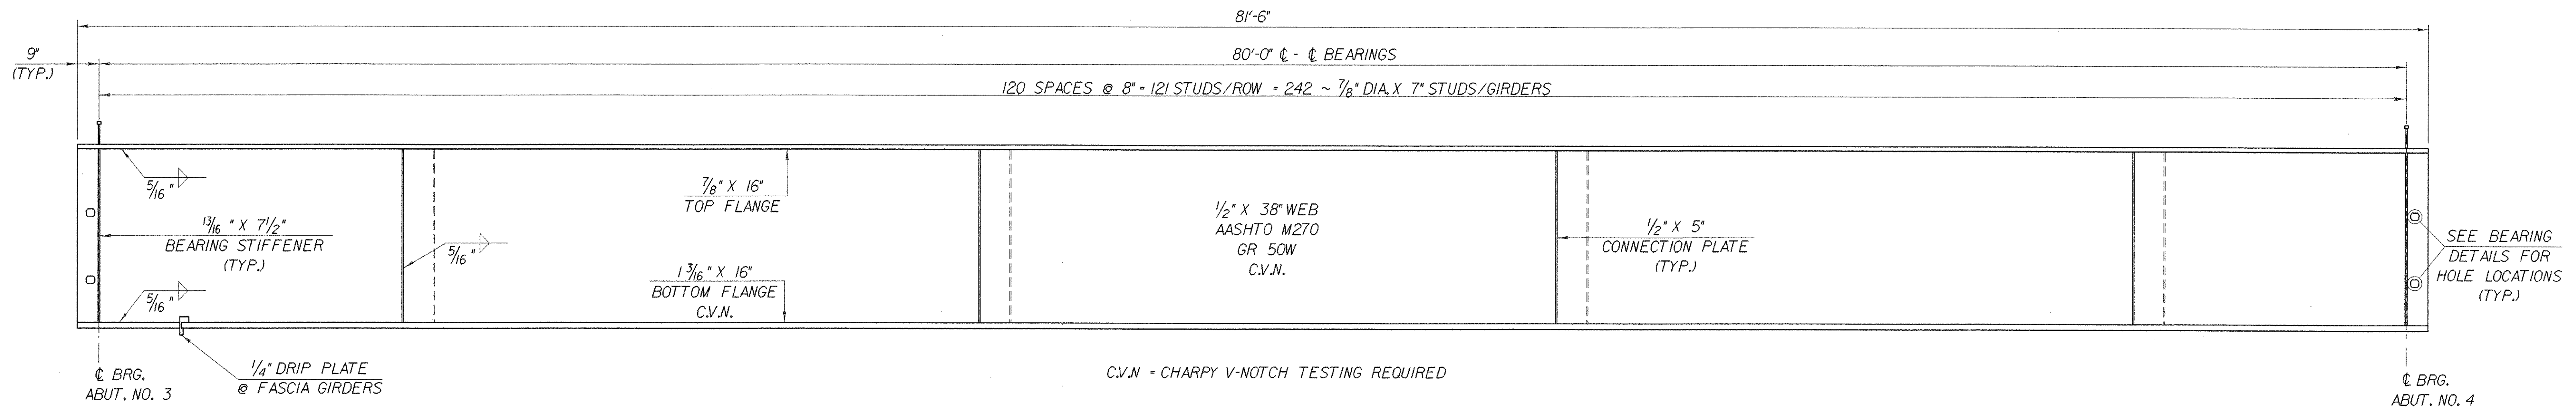

STATE OF VERMONT AGENCY OF TRANSPORTATION			
Town of FAIRFAX-FAIRFIELD- ST. ALBANS	Bridge No.	87 N	
Highway No.	Log Sta.	1-89	
		Surv. Sta.	
1-89 NB OVER VT.104			
87N FRAMING PLAN DETAILS			
Designed By M.LOZIER	Drawn By K.CHISHOLM		
Checked By G.ROY	Date 10 / 99	Bridge Design Supervisor R.R.WHITCOMB	Date 11 / 99
PROJECT FAIRFAX-FAIRFIELD- ST. ALBANS	PROJECT NO. 1 M 089 - 3 (27)		
I.G.C. Info. 94/106/Structures/sj106fr.dgn	sq056fr3j		
Bridge Sheet No. BR209	Sheet 87 of 370		