


**ABUTMENT NO. 4 PLAN**

SCALE: 3/8" = 1'-0"

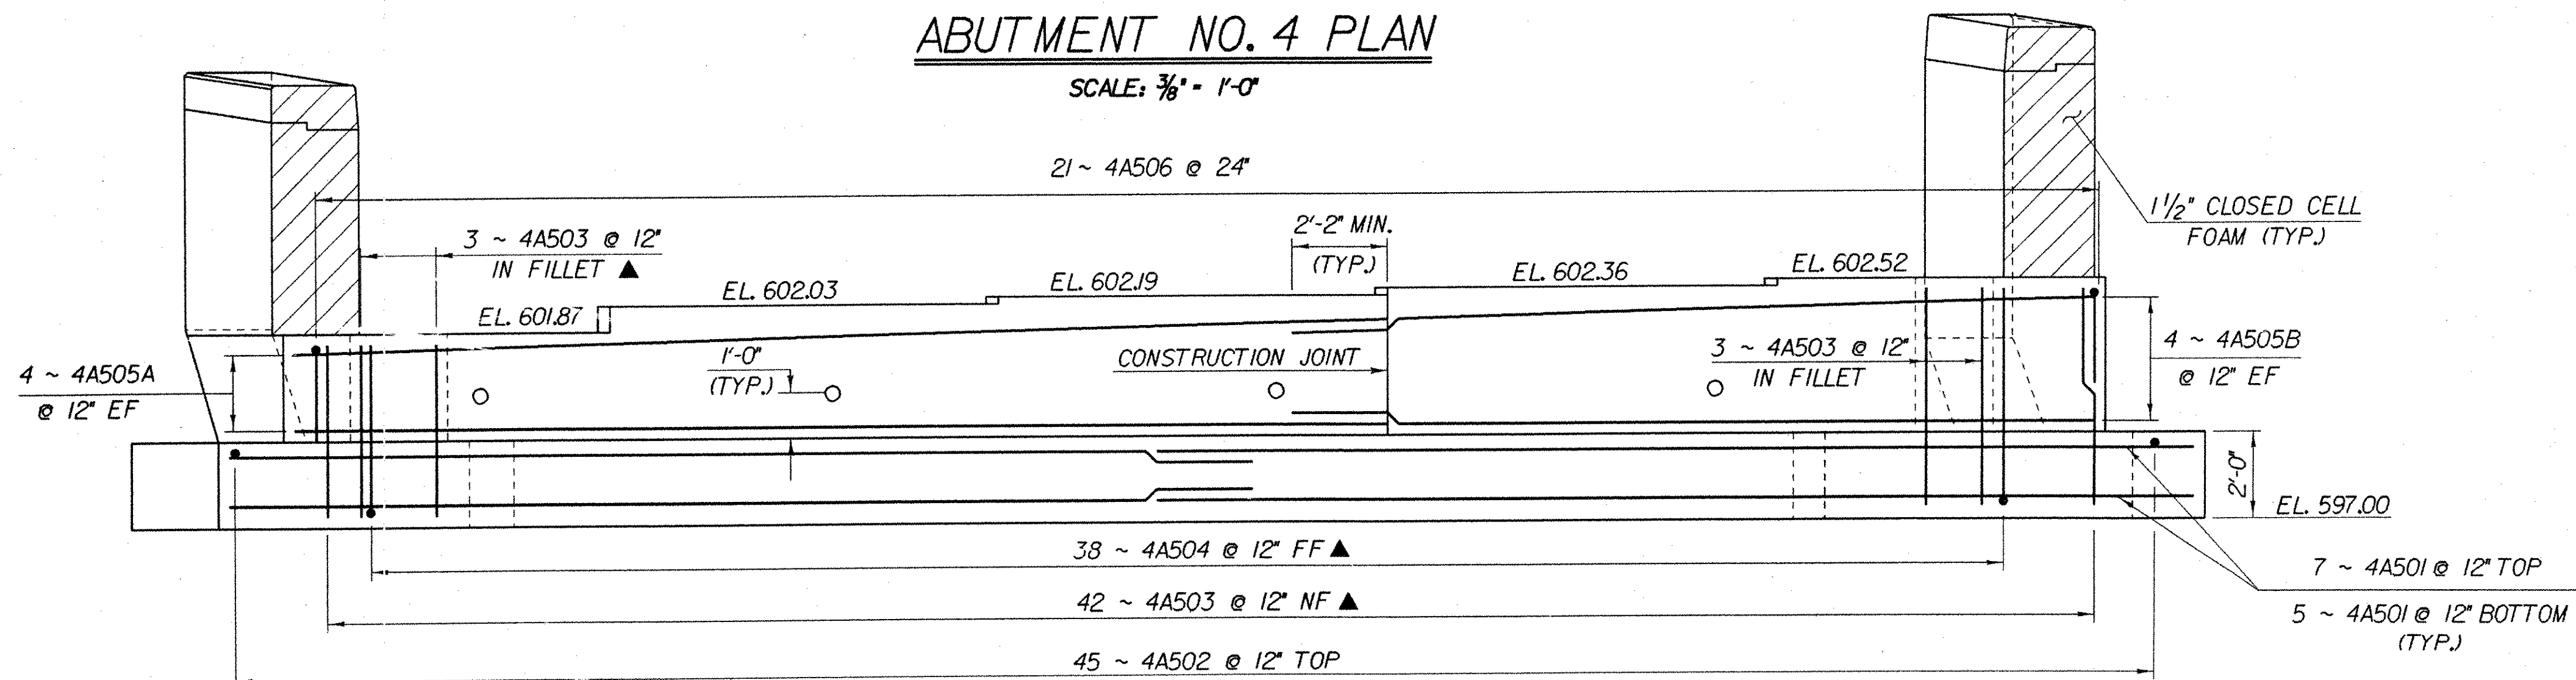

**ABUTMENT NO. 4 ELEVATION**

SCALE: 3/8" = 1'-0"

**NOTE:**

- NF = NEAR FACE
- FF = FAR FACE
- EF = EACH FACE
- ▲ = CUT TO FIT IN FIELD
- 3" CLR. UNLESS OTHERWISE SPECIFIED ON THE PLANS.

**IMPORTANT NOTE: BRIDGE FINISHED GRADES ARE CENTERLINE GRADES.**

**STATE OF VERMONT  
AGENCY OF TRANSPORTATION**

Town Of <b>FAIRFAX-FAIRFIELD-ST. ALBANS</b>	Bridge No. 87N
Highway No. 1-89	Log Sta. Surv. Sta.

**1-89 OVER VT 104**

**ABUTMENT NO. 4 DETAILS**

Designed By M. LOZIER	Drawn By K. CHISHOLM
Checked By GROY	Bridge Design Supervisor R.R. WHITCOMB
Date 10/99	Date 11/99

PROJECT <b>FAIRFAX-FAIRFIELD-ST. ALBANS</b>	PROJECT NO. <b>1M 089 - 3 (27)</b>
I.G.C. Info. 94\106\Structures\106abdgn	sa056ab4j

Bridge Sheet No. BR225 Sheet 103 of 370