




11+25

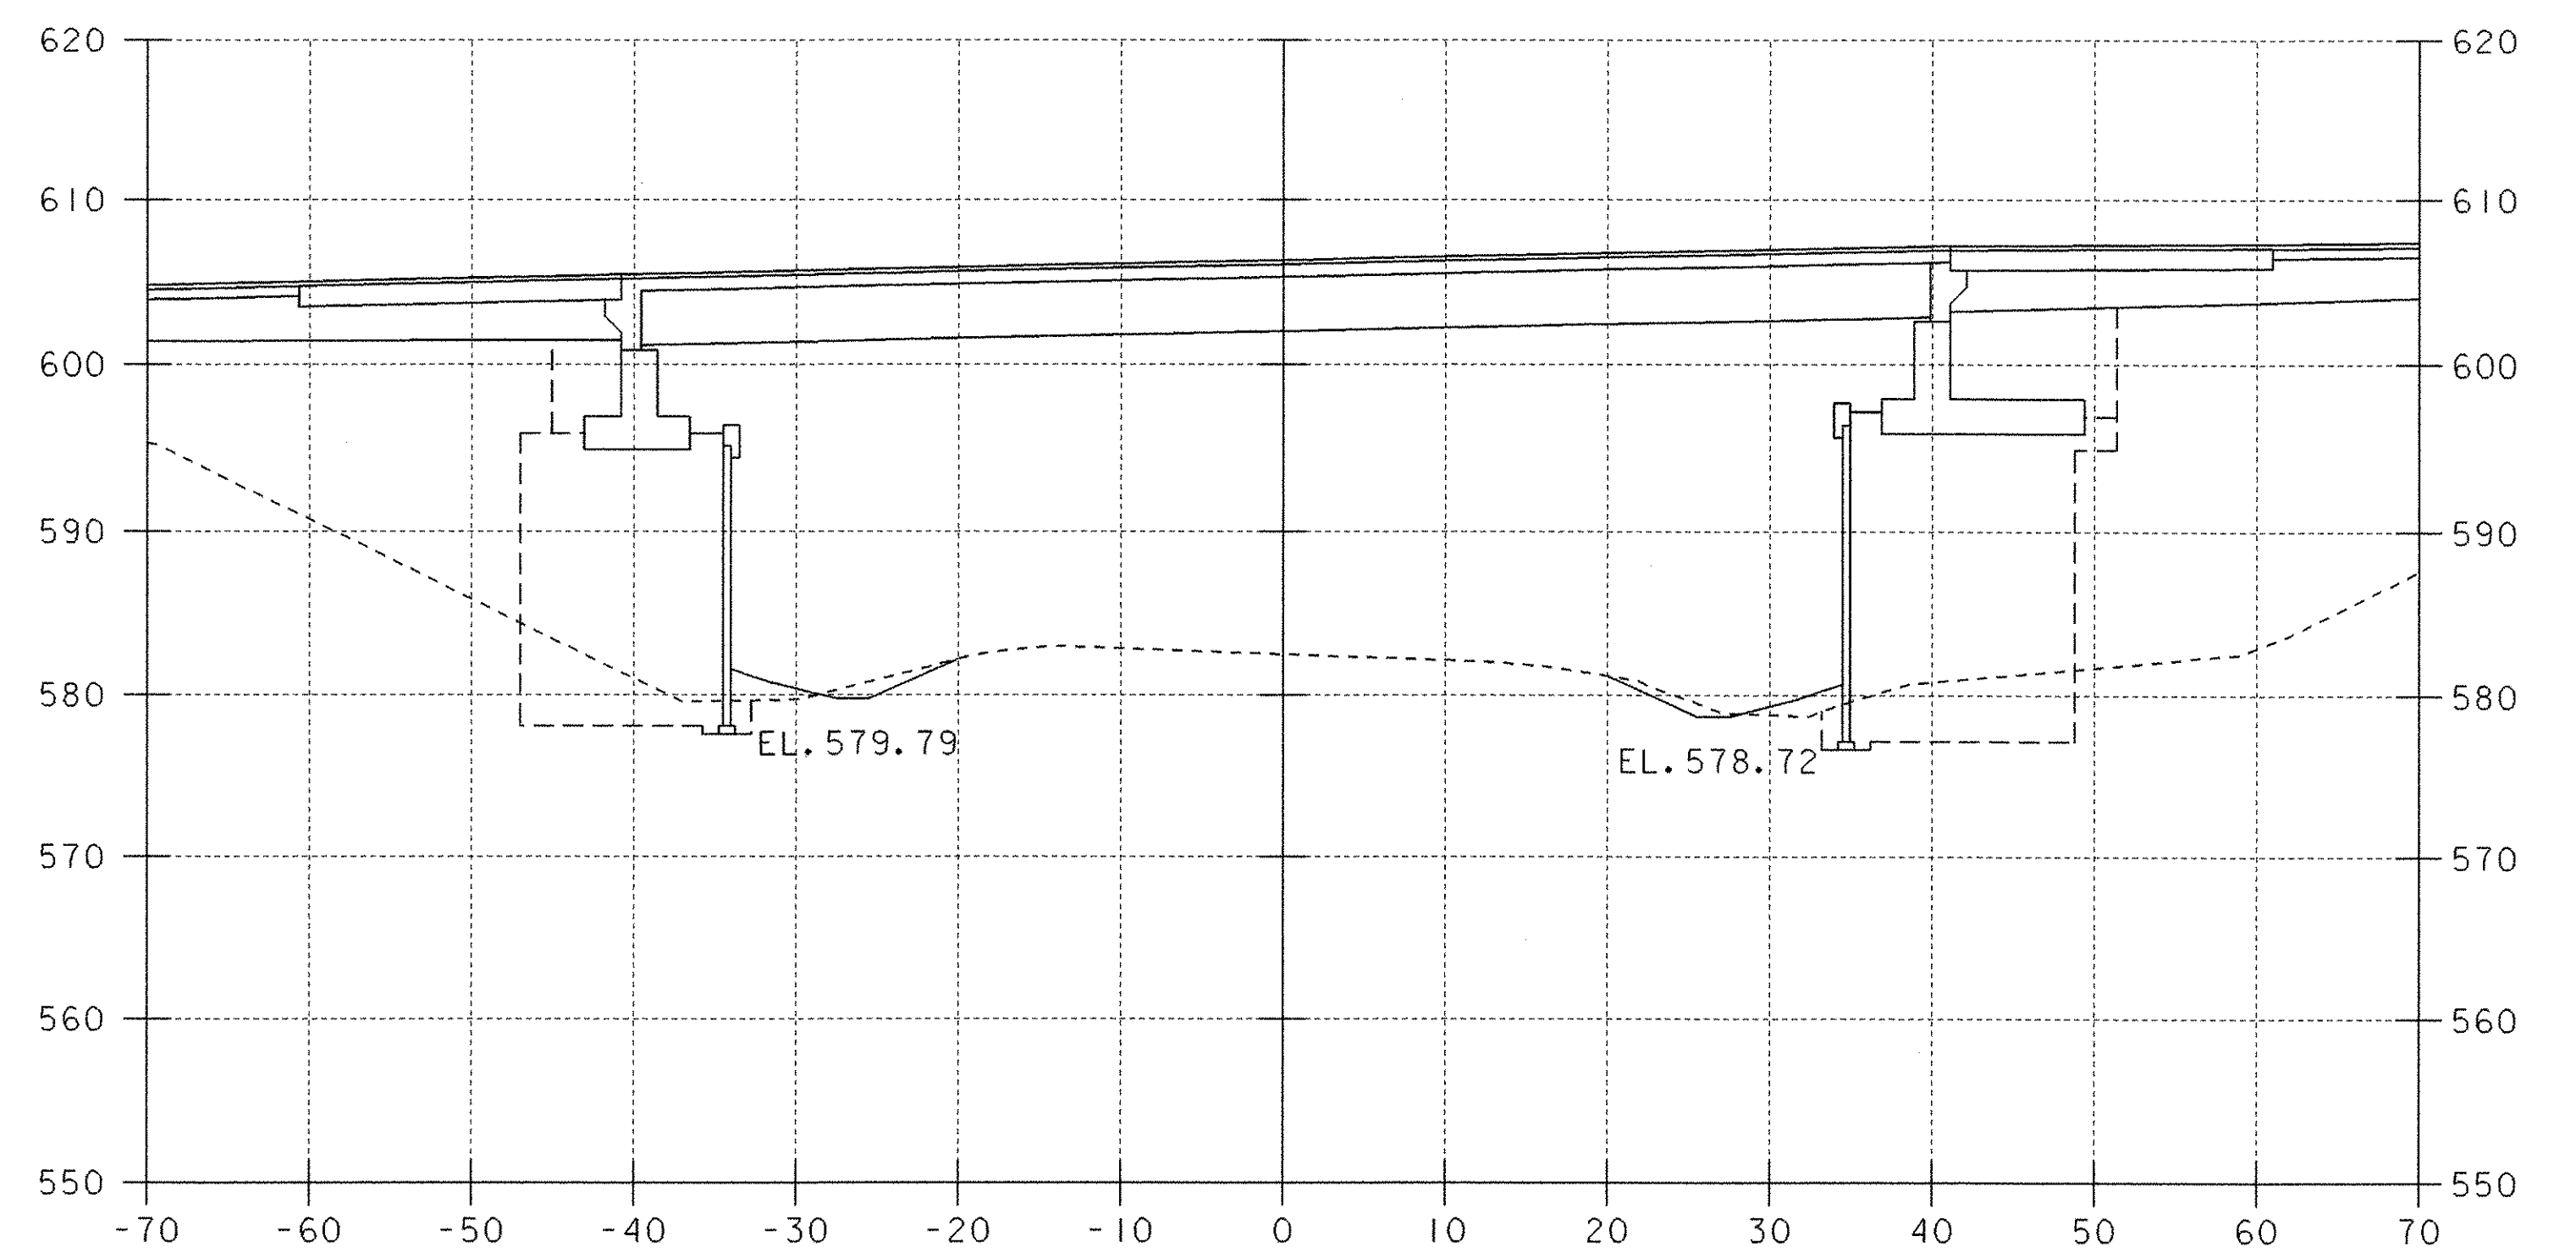

11+75

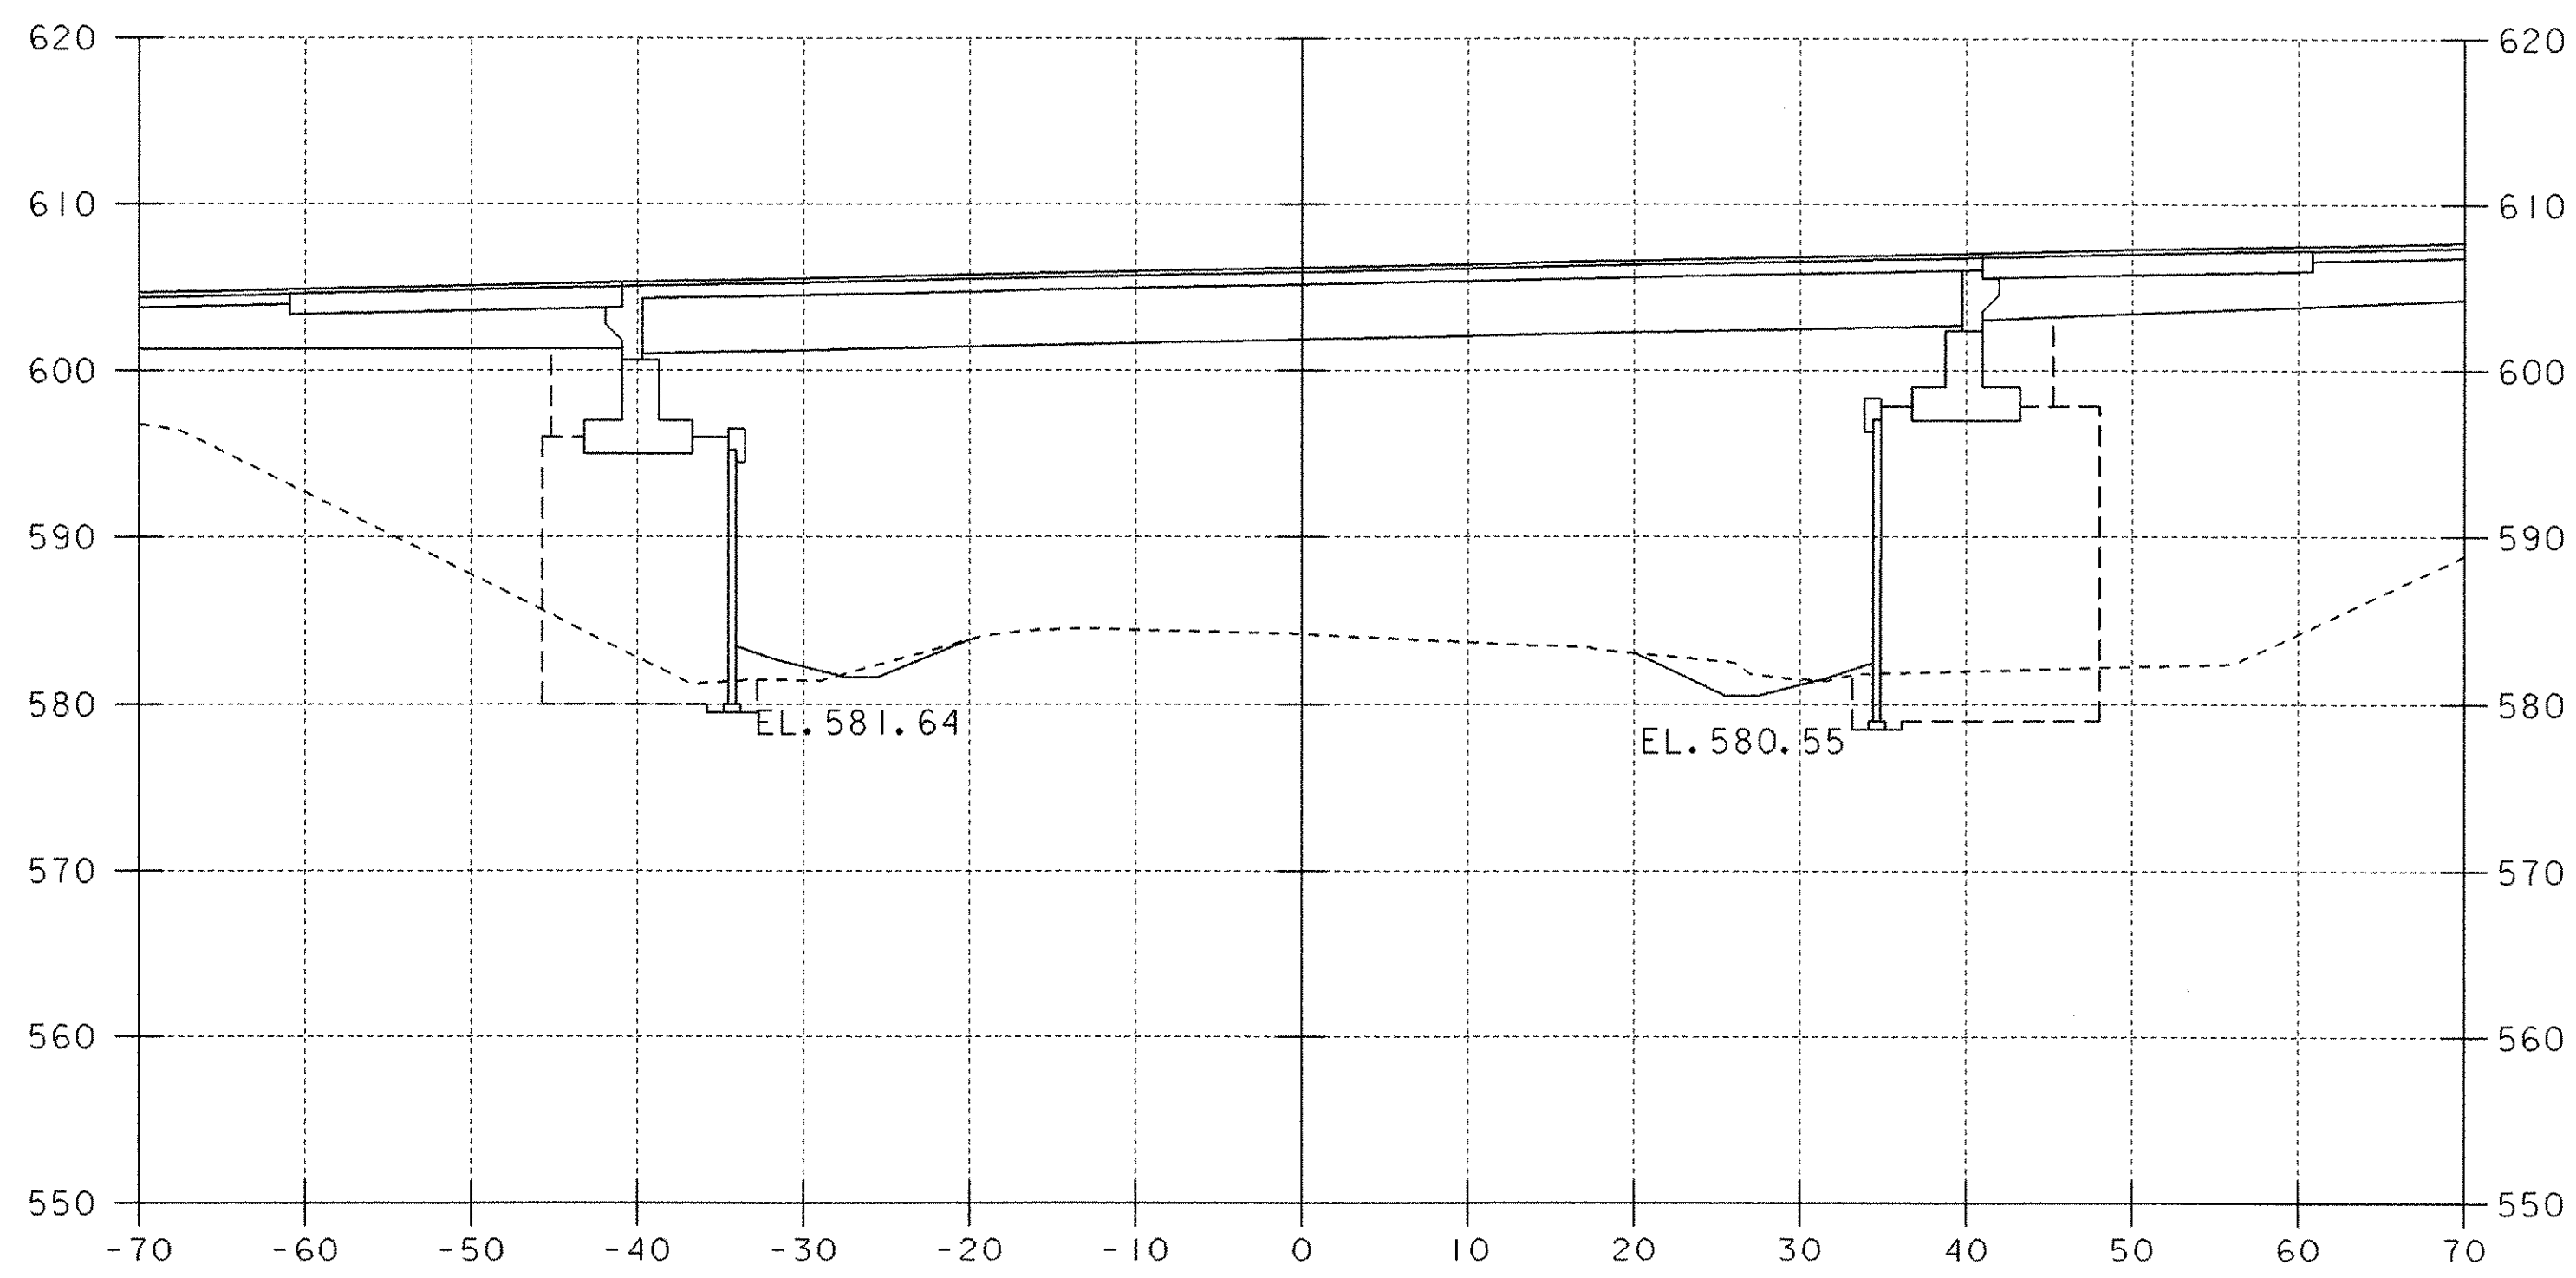

11+00

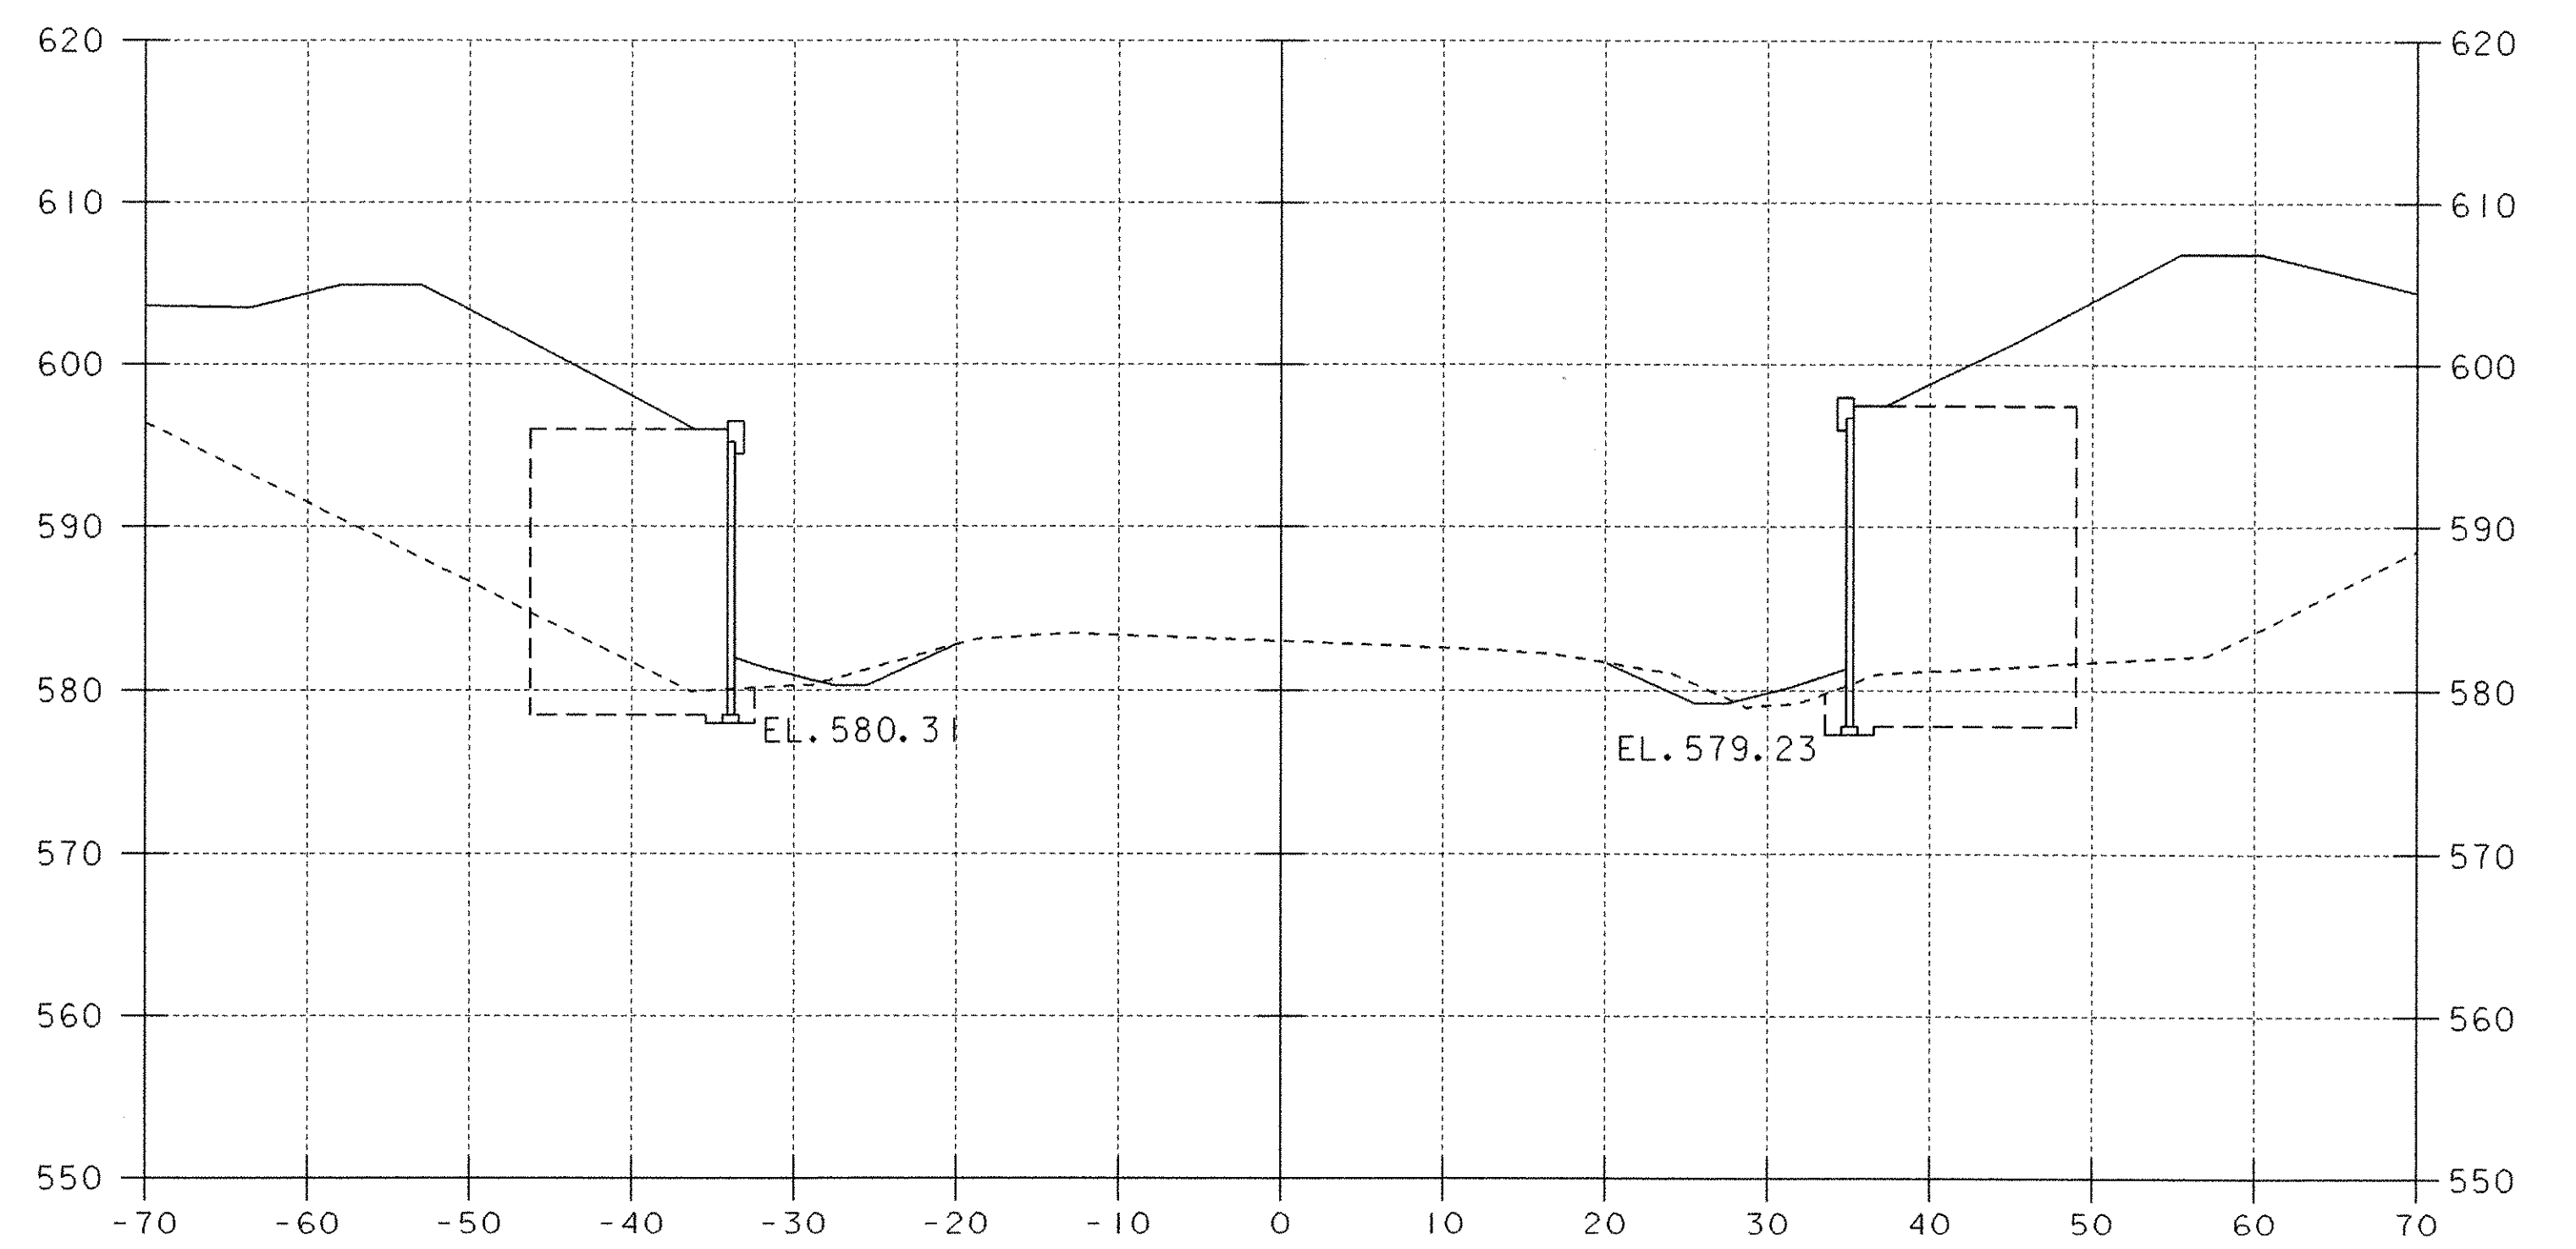

11+50

DATUM
 VERTICAL _____
 HORIZONTAL _____

SCALE 1" = 10'-0"

PROJECT: FAIRFAX-FAIRFIELD-ST. ALBANS	PROJECT NO.: IM 089-3 (27)
DESIGN FILE NAME: \96a056\Structures\sa056xsl.dgn	PLOT DATE: 21-SEP-2000
IPARM FILE NAME: sa056c02.i	BRIDGE SHEET BR237
VT 104 CROSS SECTIONS	SHEET: 115 OF 370
STA. 11+00 TO STA. 11+75	