



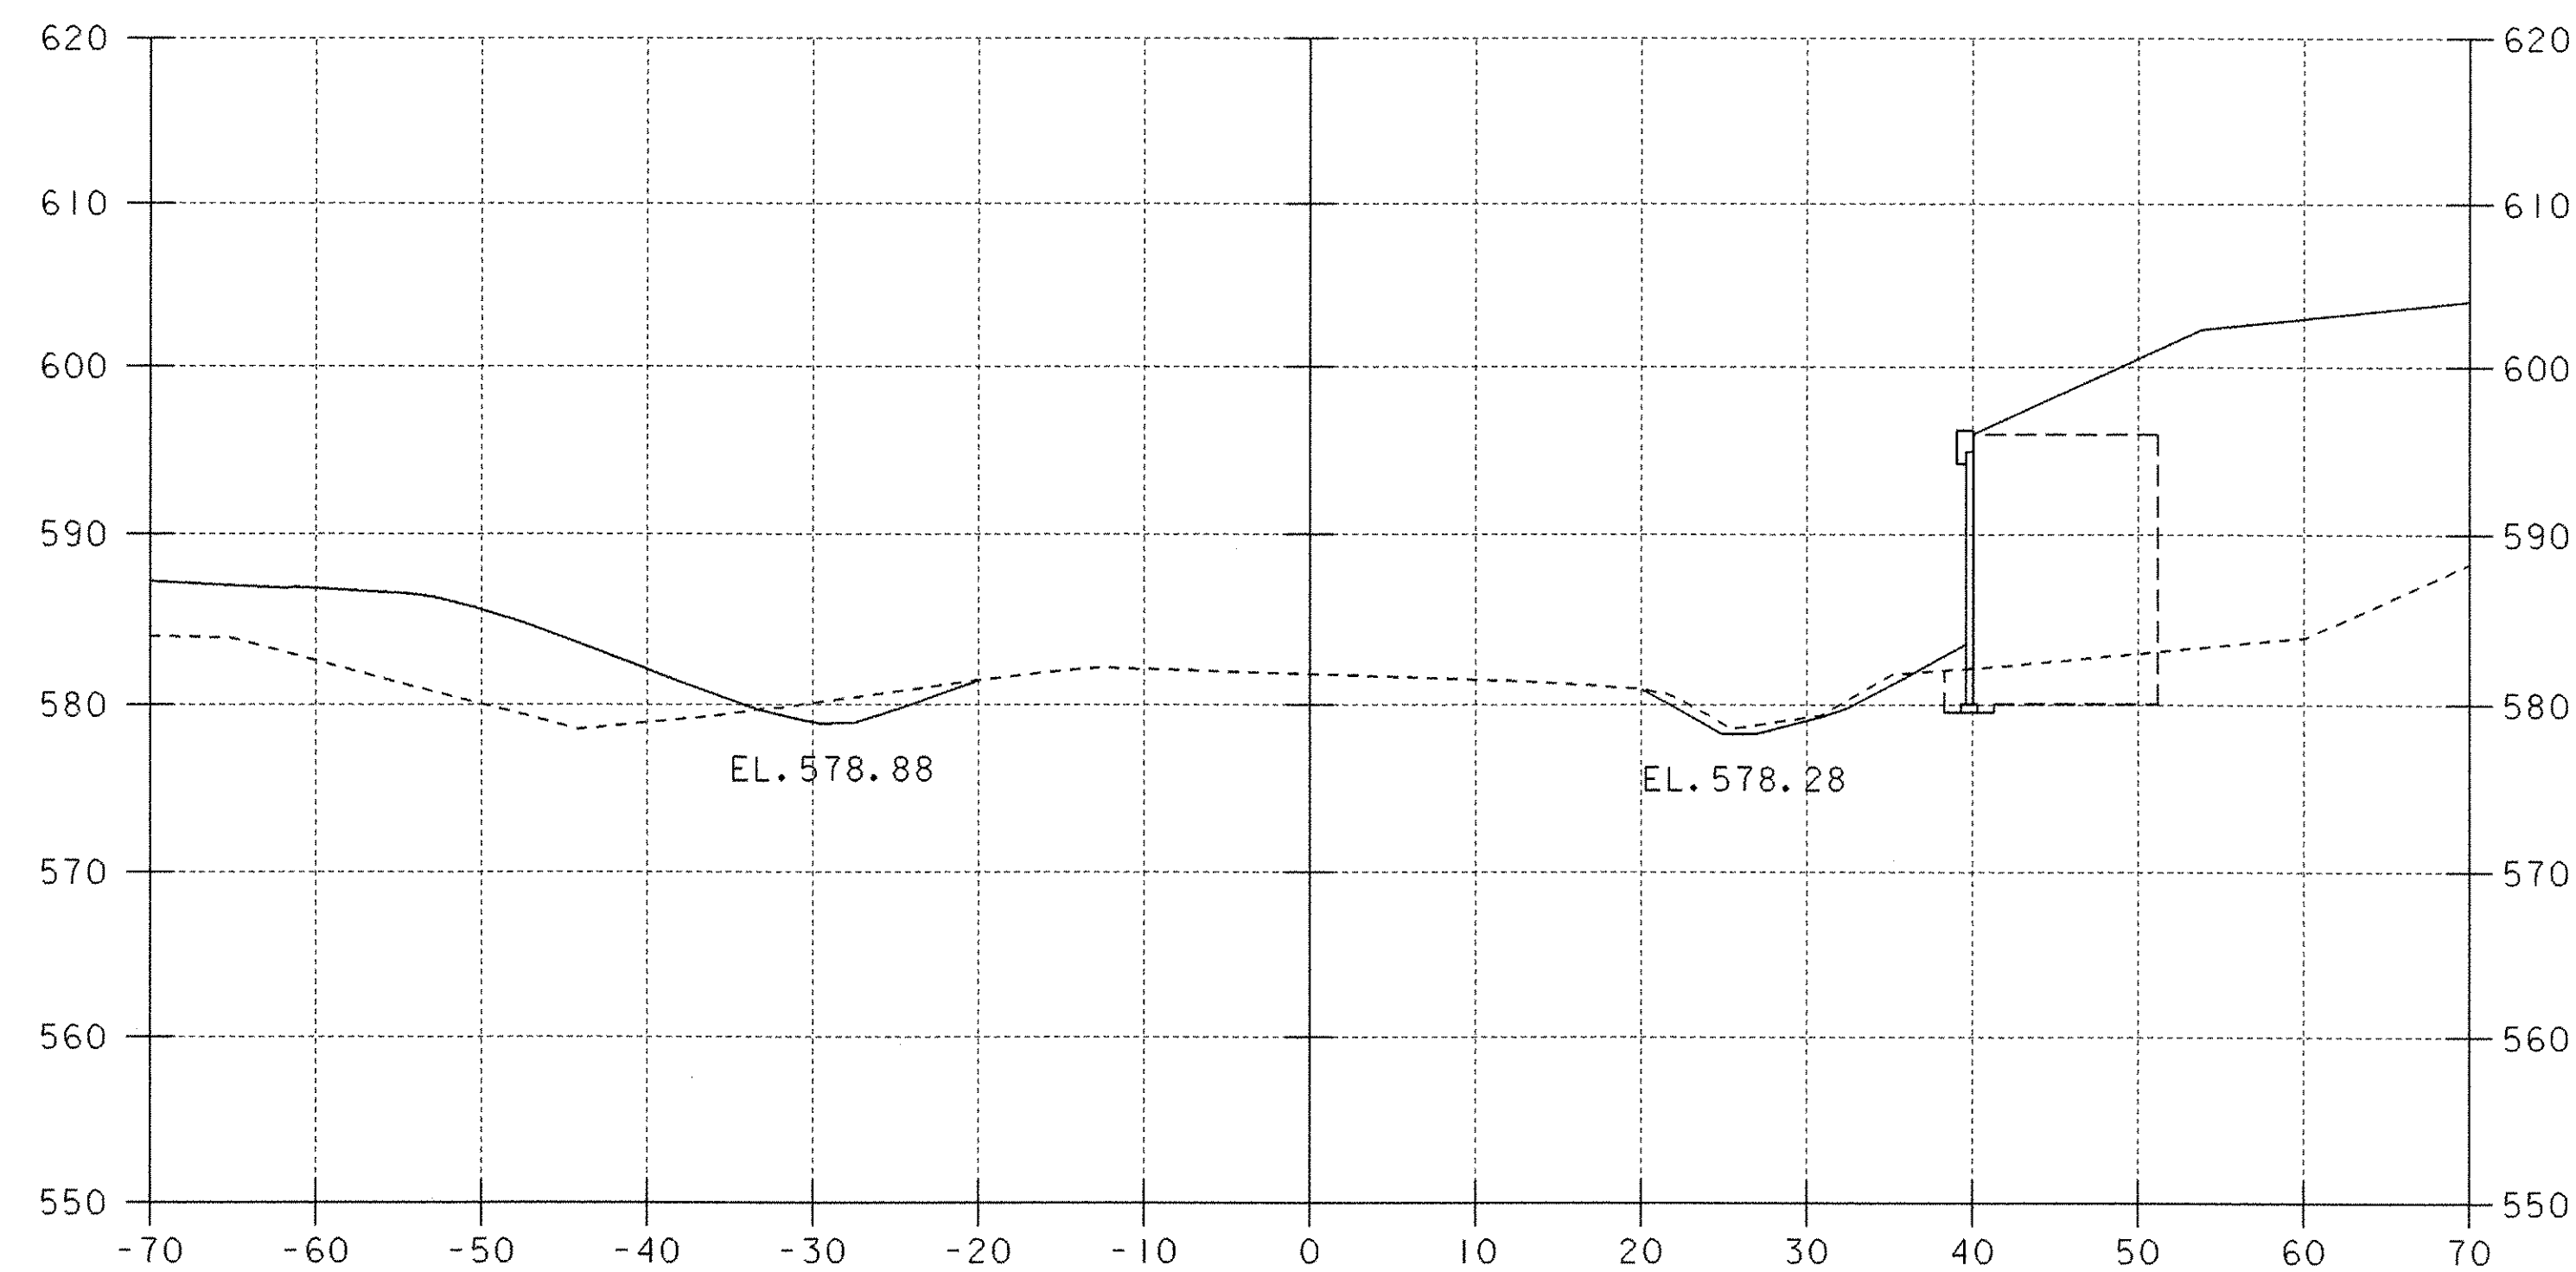

VT 104 STA. 12+23 LT.
END STRUCTURE EXCAVATION
SELECTED BACKFILL FOR MSE WALL
VT 104 STA. 12+04 LT.
END GRAN. BACKFILL FOR STRUCT.

12+25


VT 104 STA. 12+18 RT.
END GRAN. BACKFILL FOR STRUCT.

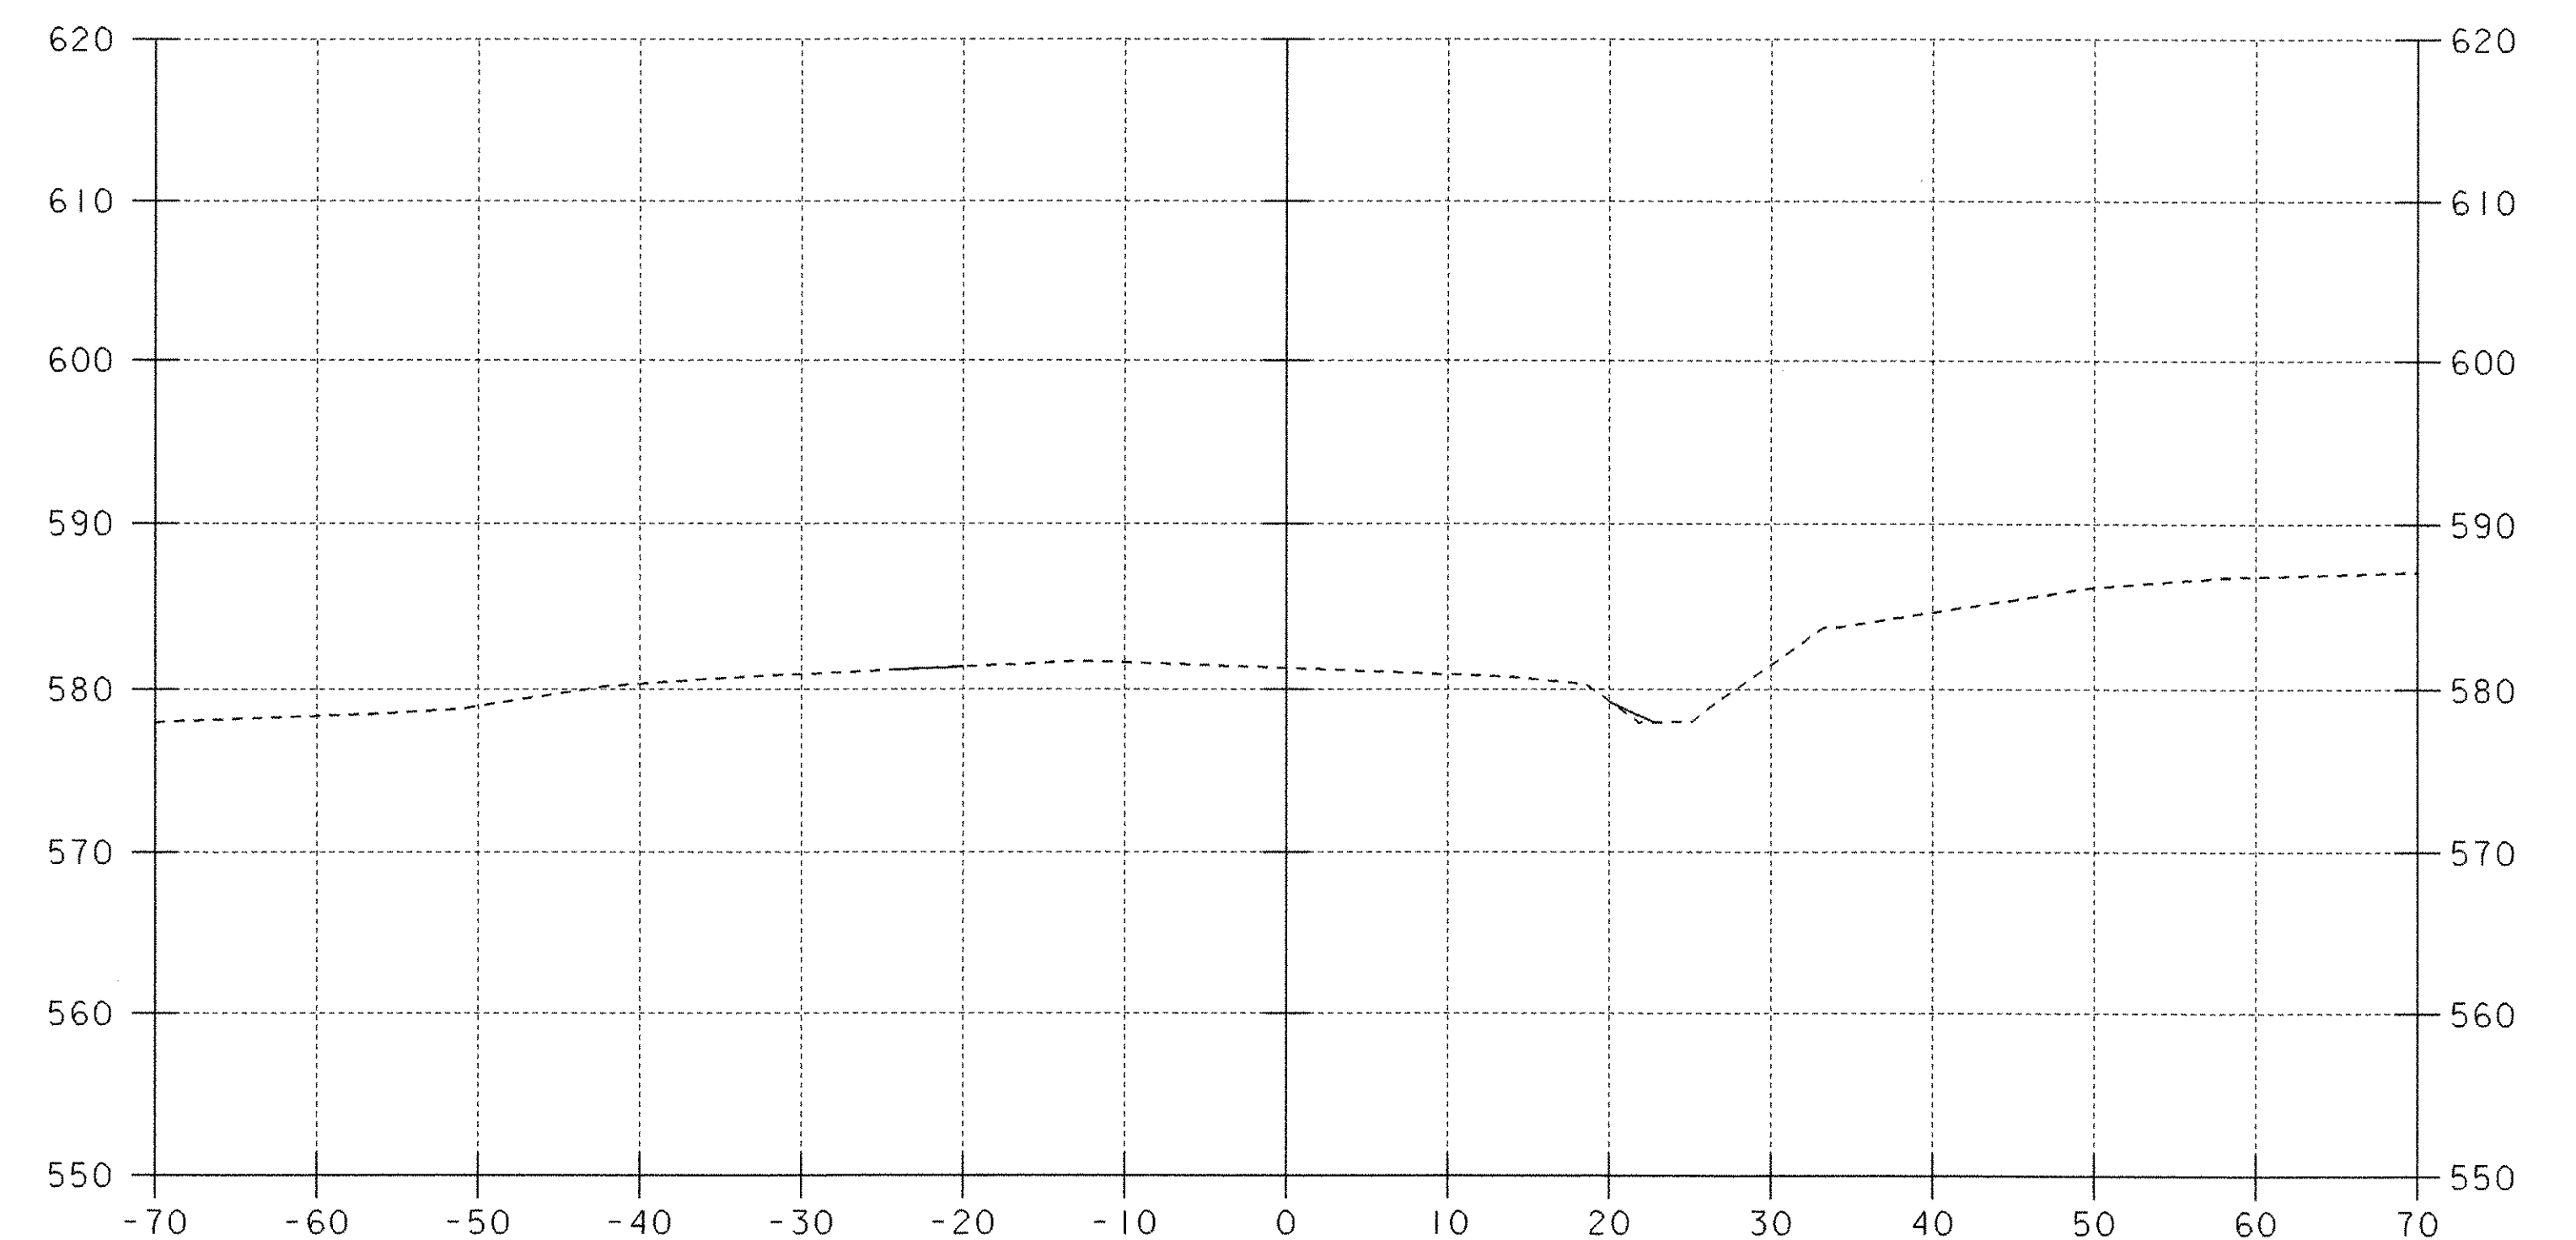

VT 104 STA. 12+75 LT.
END TRENCH EXCAVATION

12+75


VT 104 STA. 12+75 RT.
END TRENCH EXCAVATION

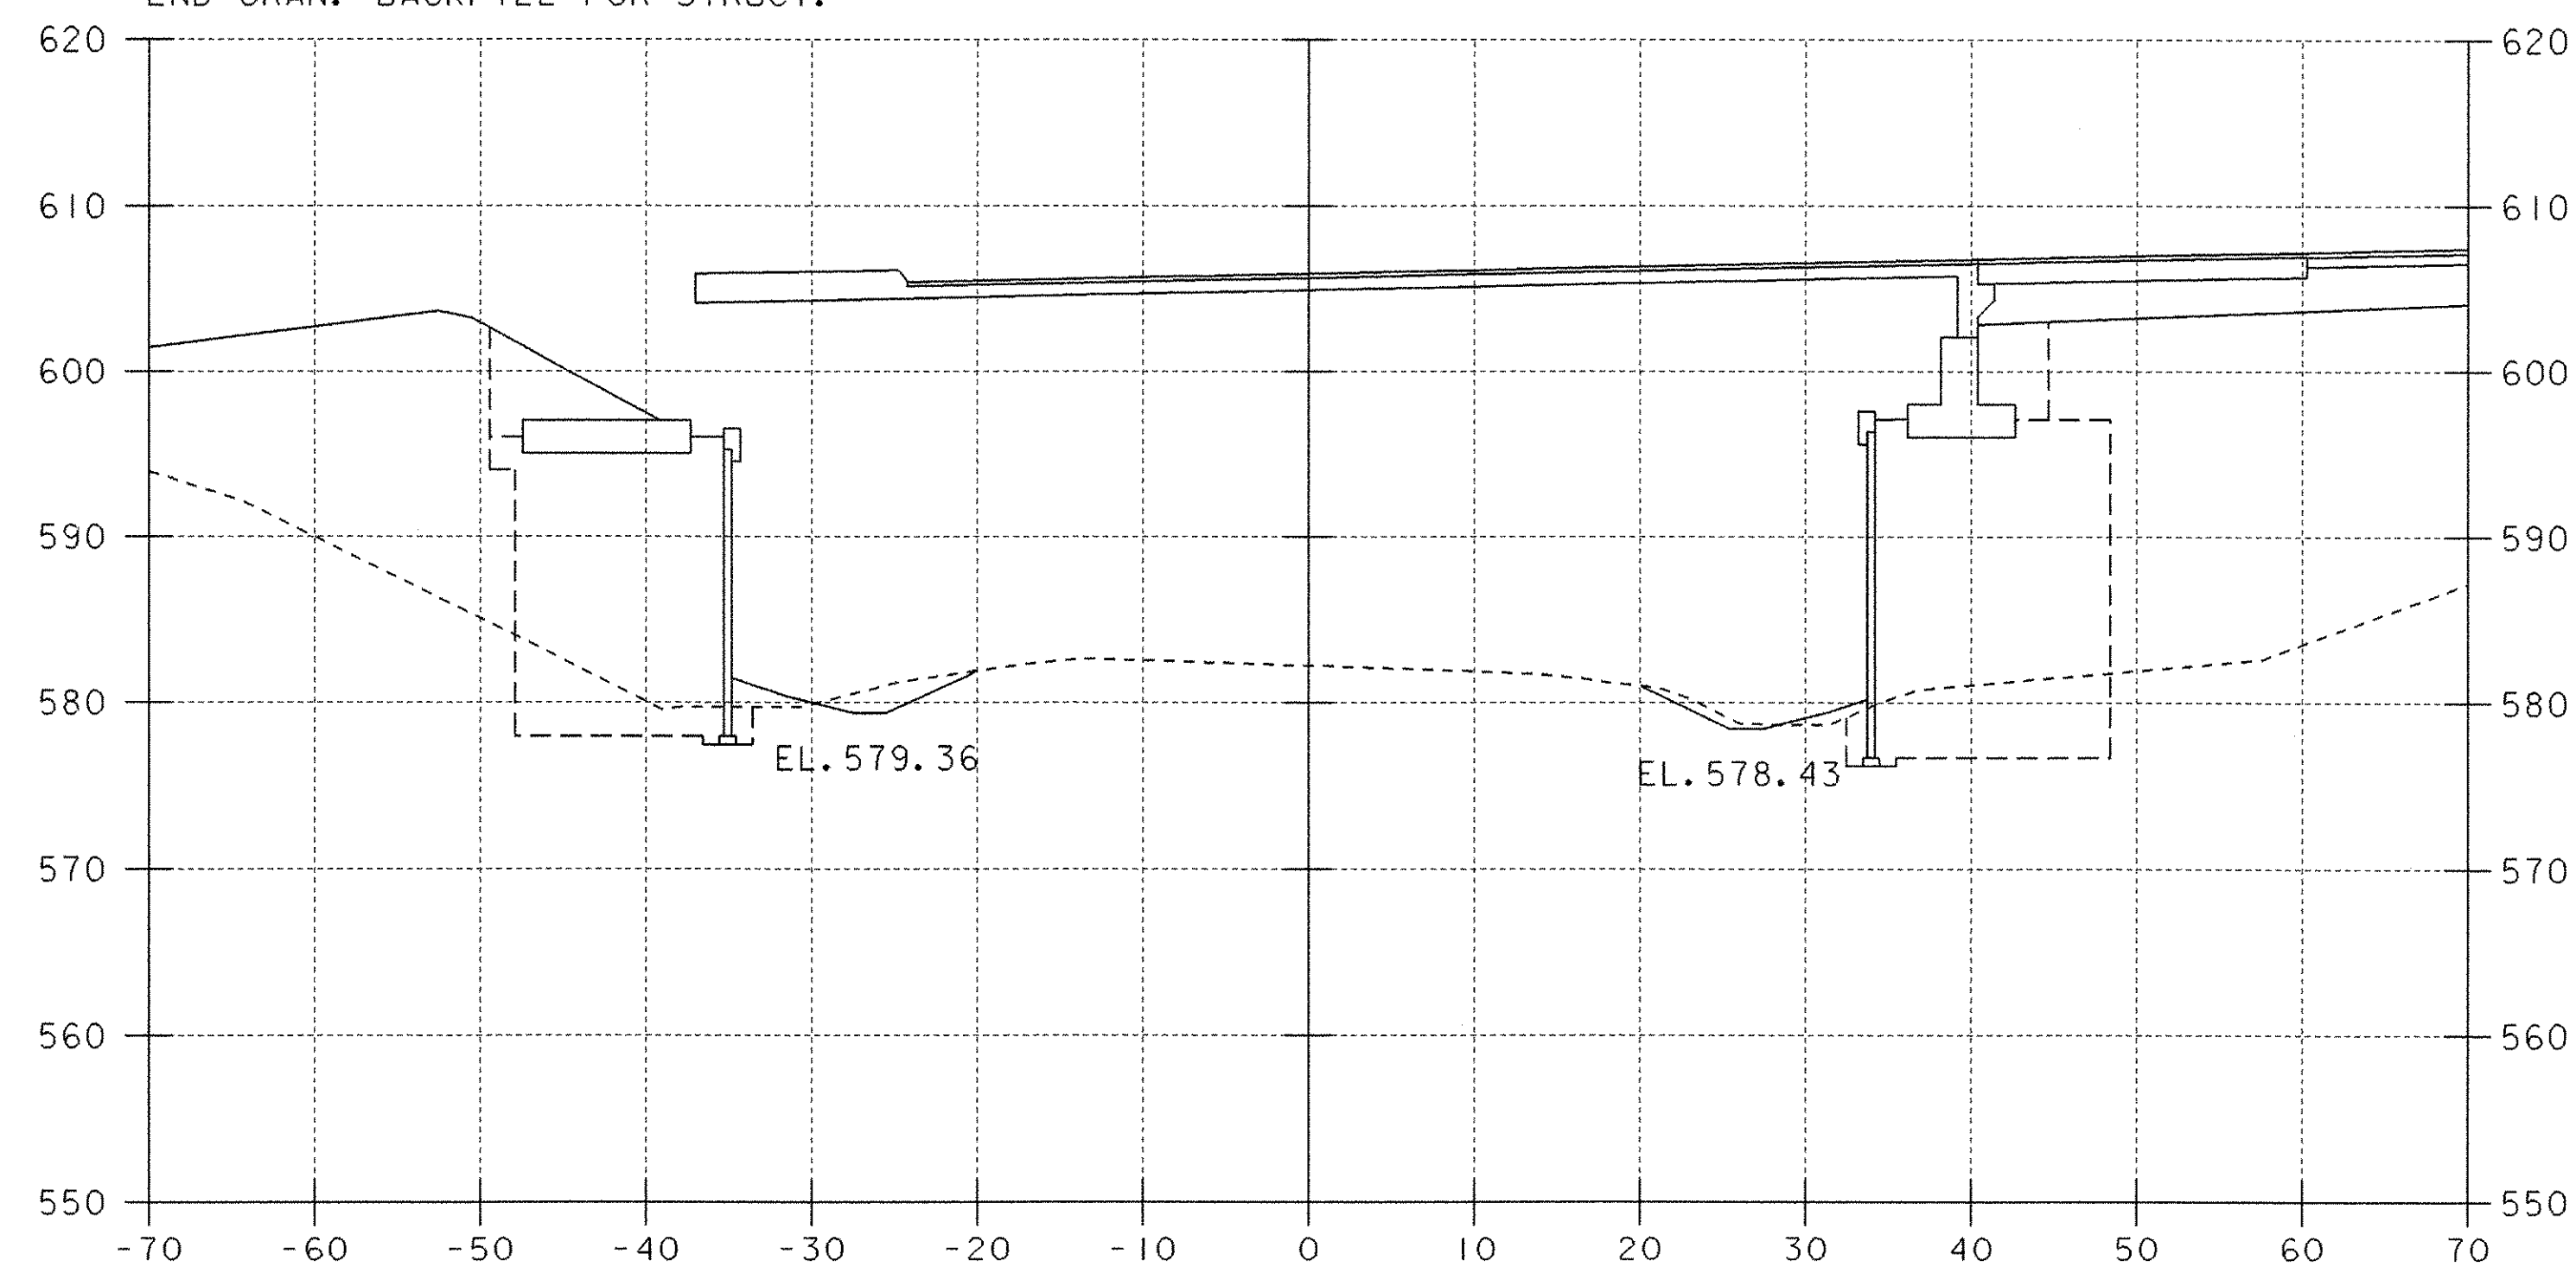

EL. 579.36

EL. 578.43

12+00

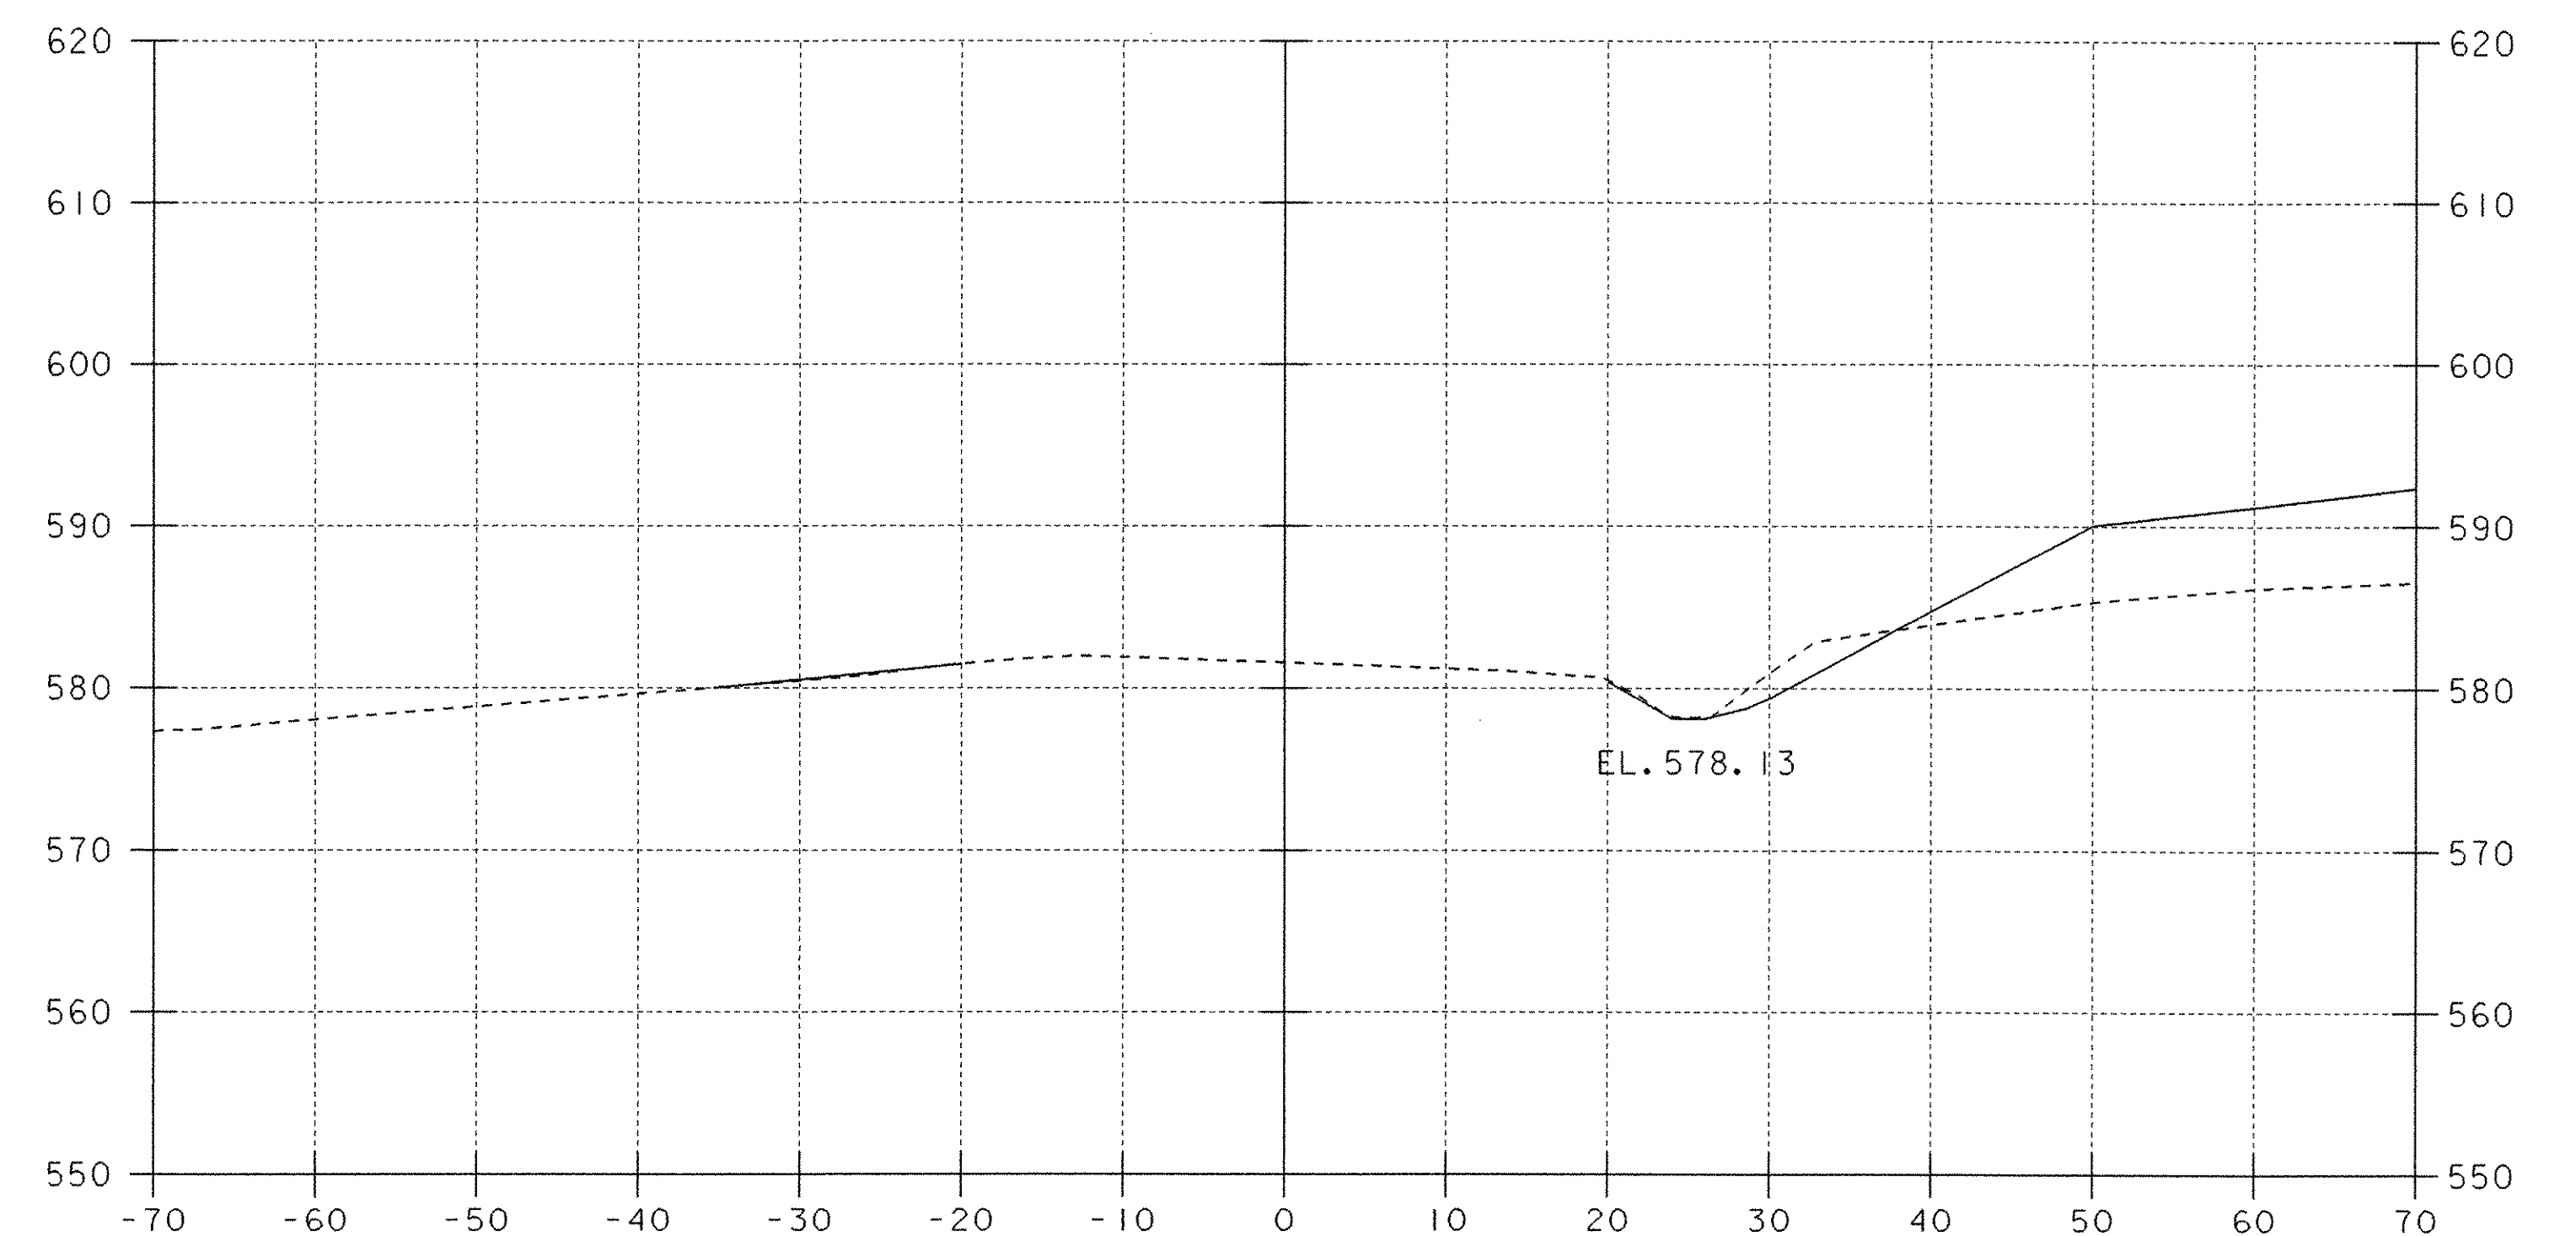

EL. 578.13

12+50

VT 104 STA. 12+50 RT.
END STRUCTURE EXCAVATION
SELECTED BACKFILL FOR MSE WALL

DATUM
VERTICAL _____
HORIZONTAL _____

SCALE 1" = 10'-0"
10 0 10

PROJECT: FAIRFAX-FAIRFIELD-ST. ALBANS	PROJECT NO.: IM 089-3 (27)
DESIGN FILE NAME: \96a056\Structures\sa056xsl.dgn	PLOT DATE: 21-SEP-2000
IPARM FILE NAME: sa056c03.i	VT 104 CROSS SECTIONS
STA. 12+00 TO STA. 12+75	BRIDGE SHEET BR238
	SHEET: 116 OF 370