



PLAN

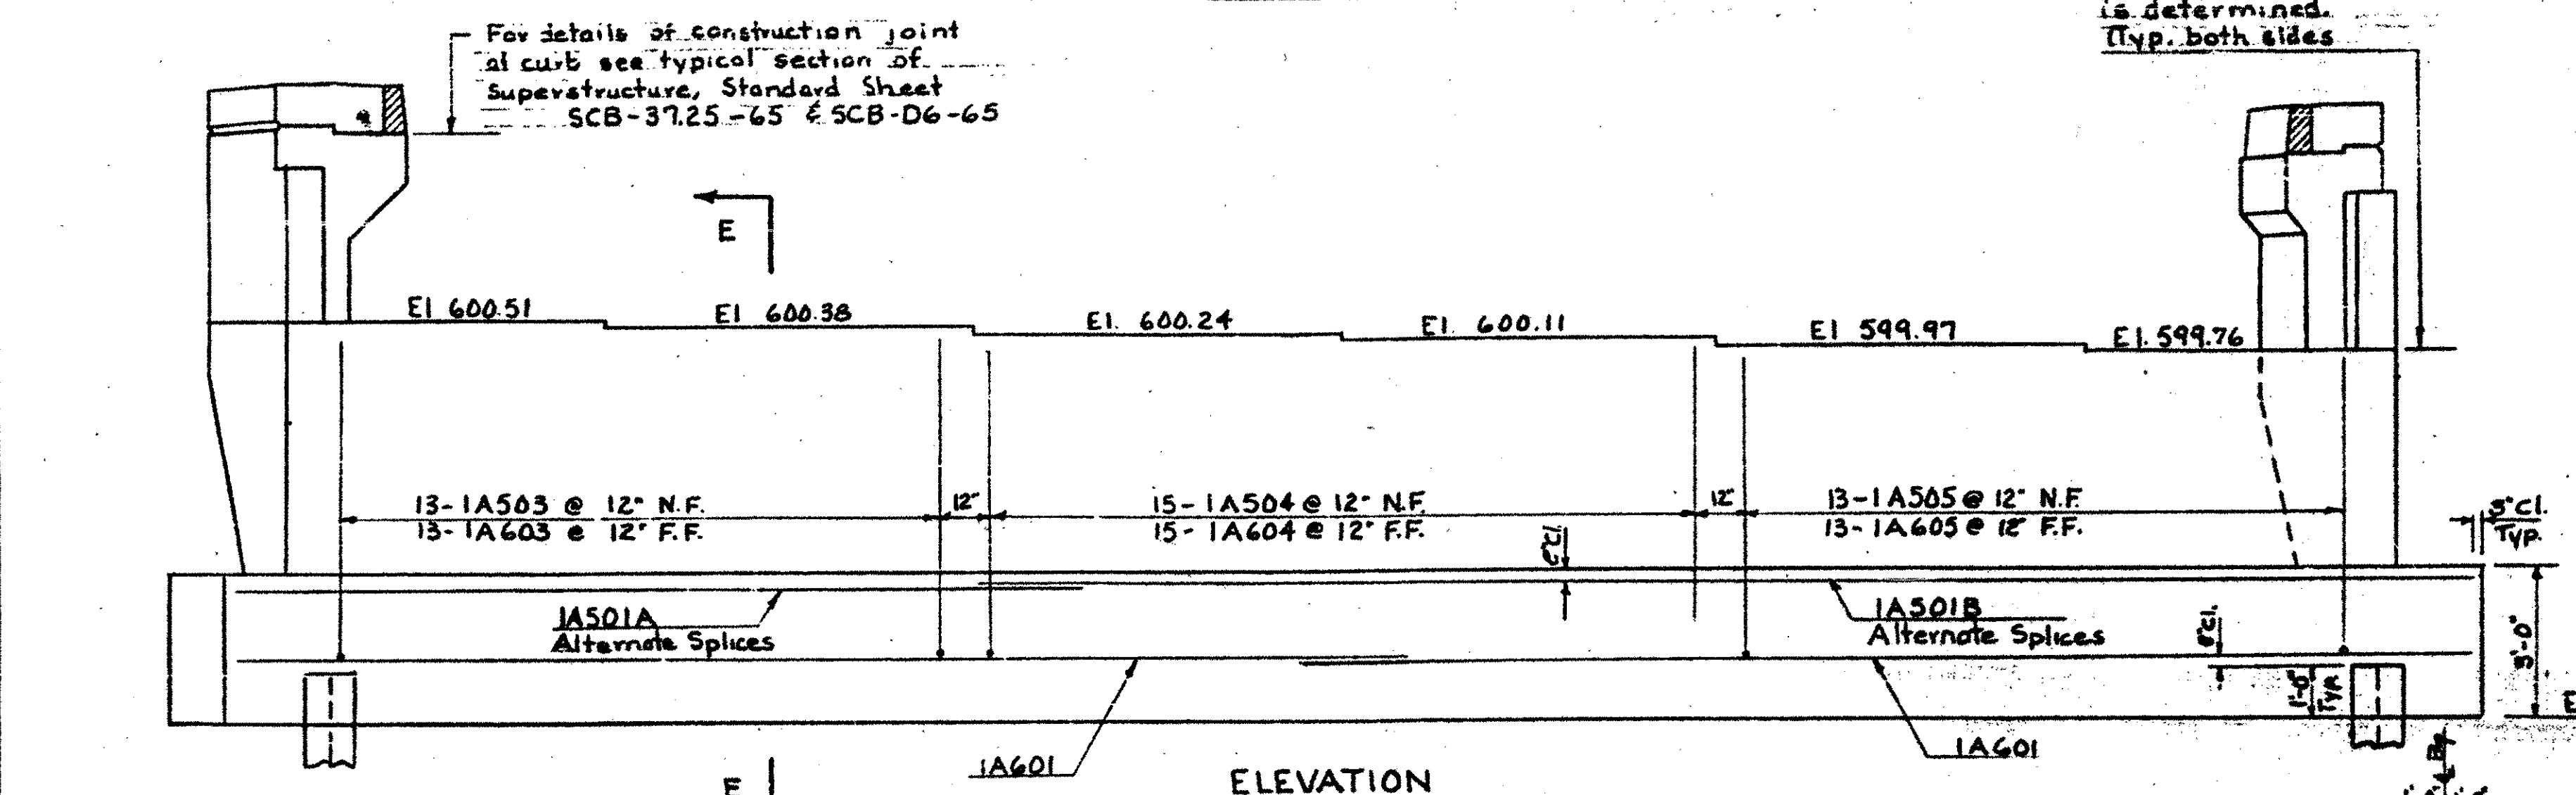


ELEVATION

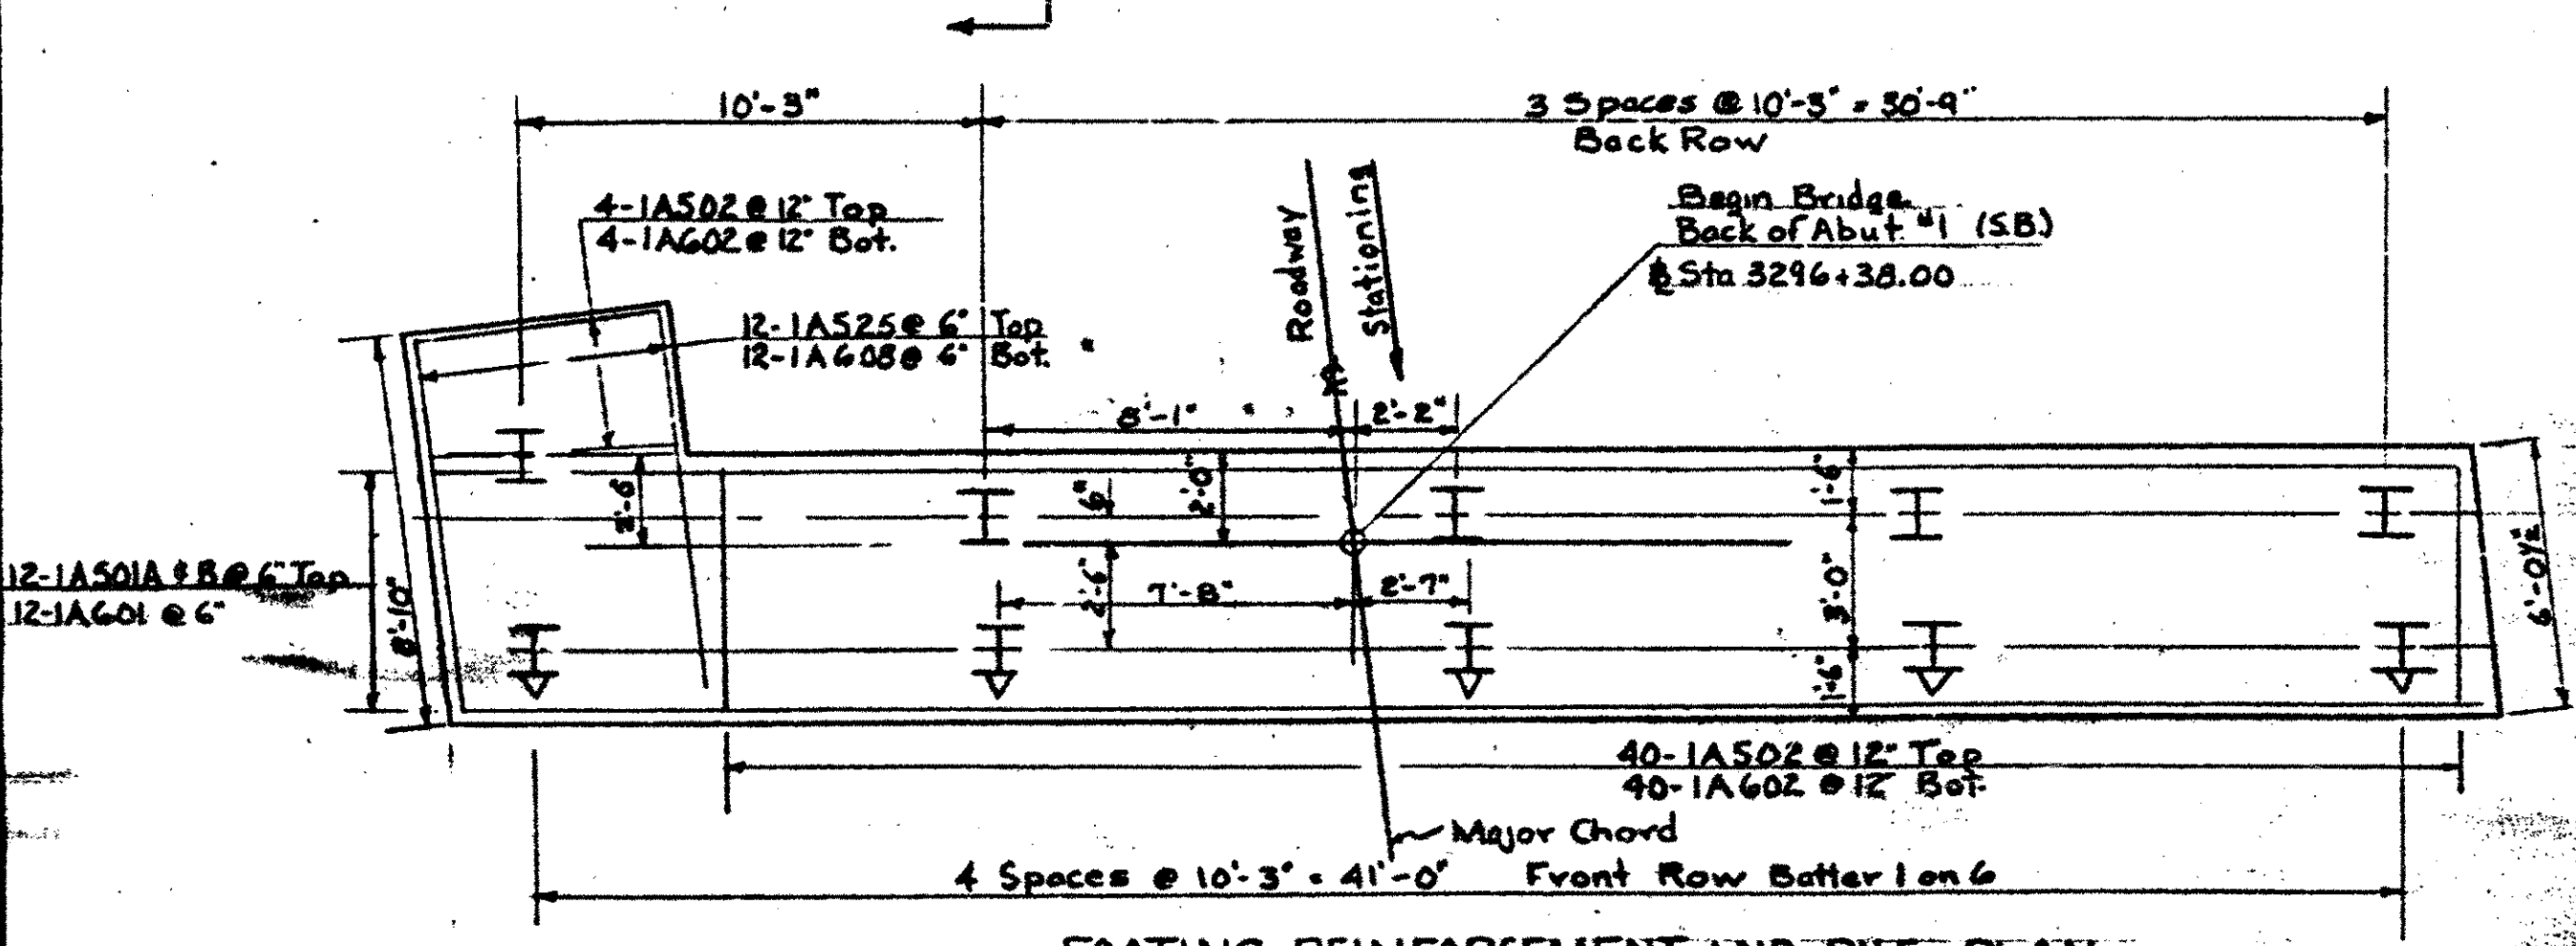


FOOTING REINFORCEMENT AND PILE PLAN

Scale: 1/4" = 1'-0"

Item 372-C Type A
Fordetails see
Std. Sht. SB-AS-65
Curb Joint Detail

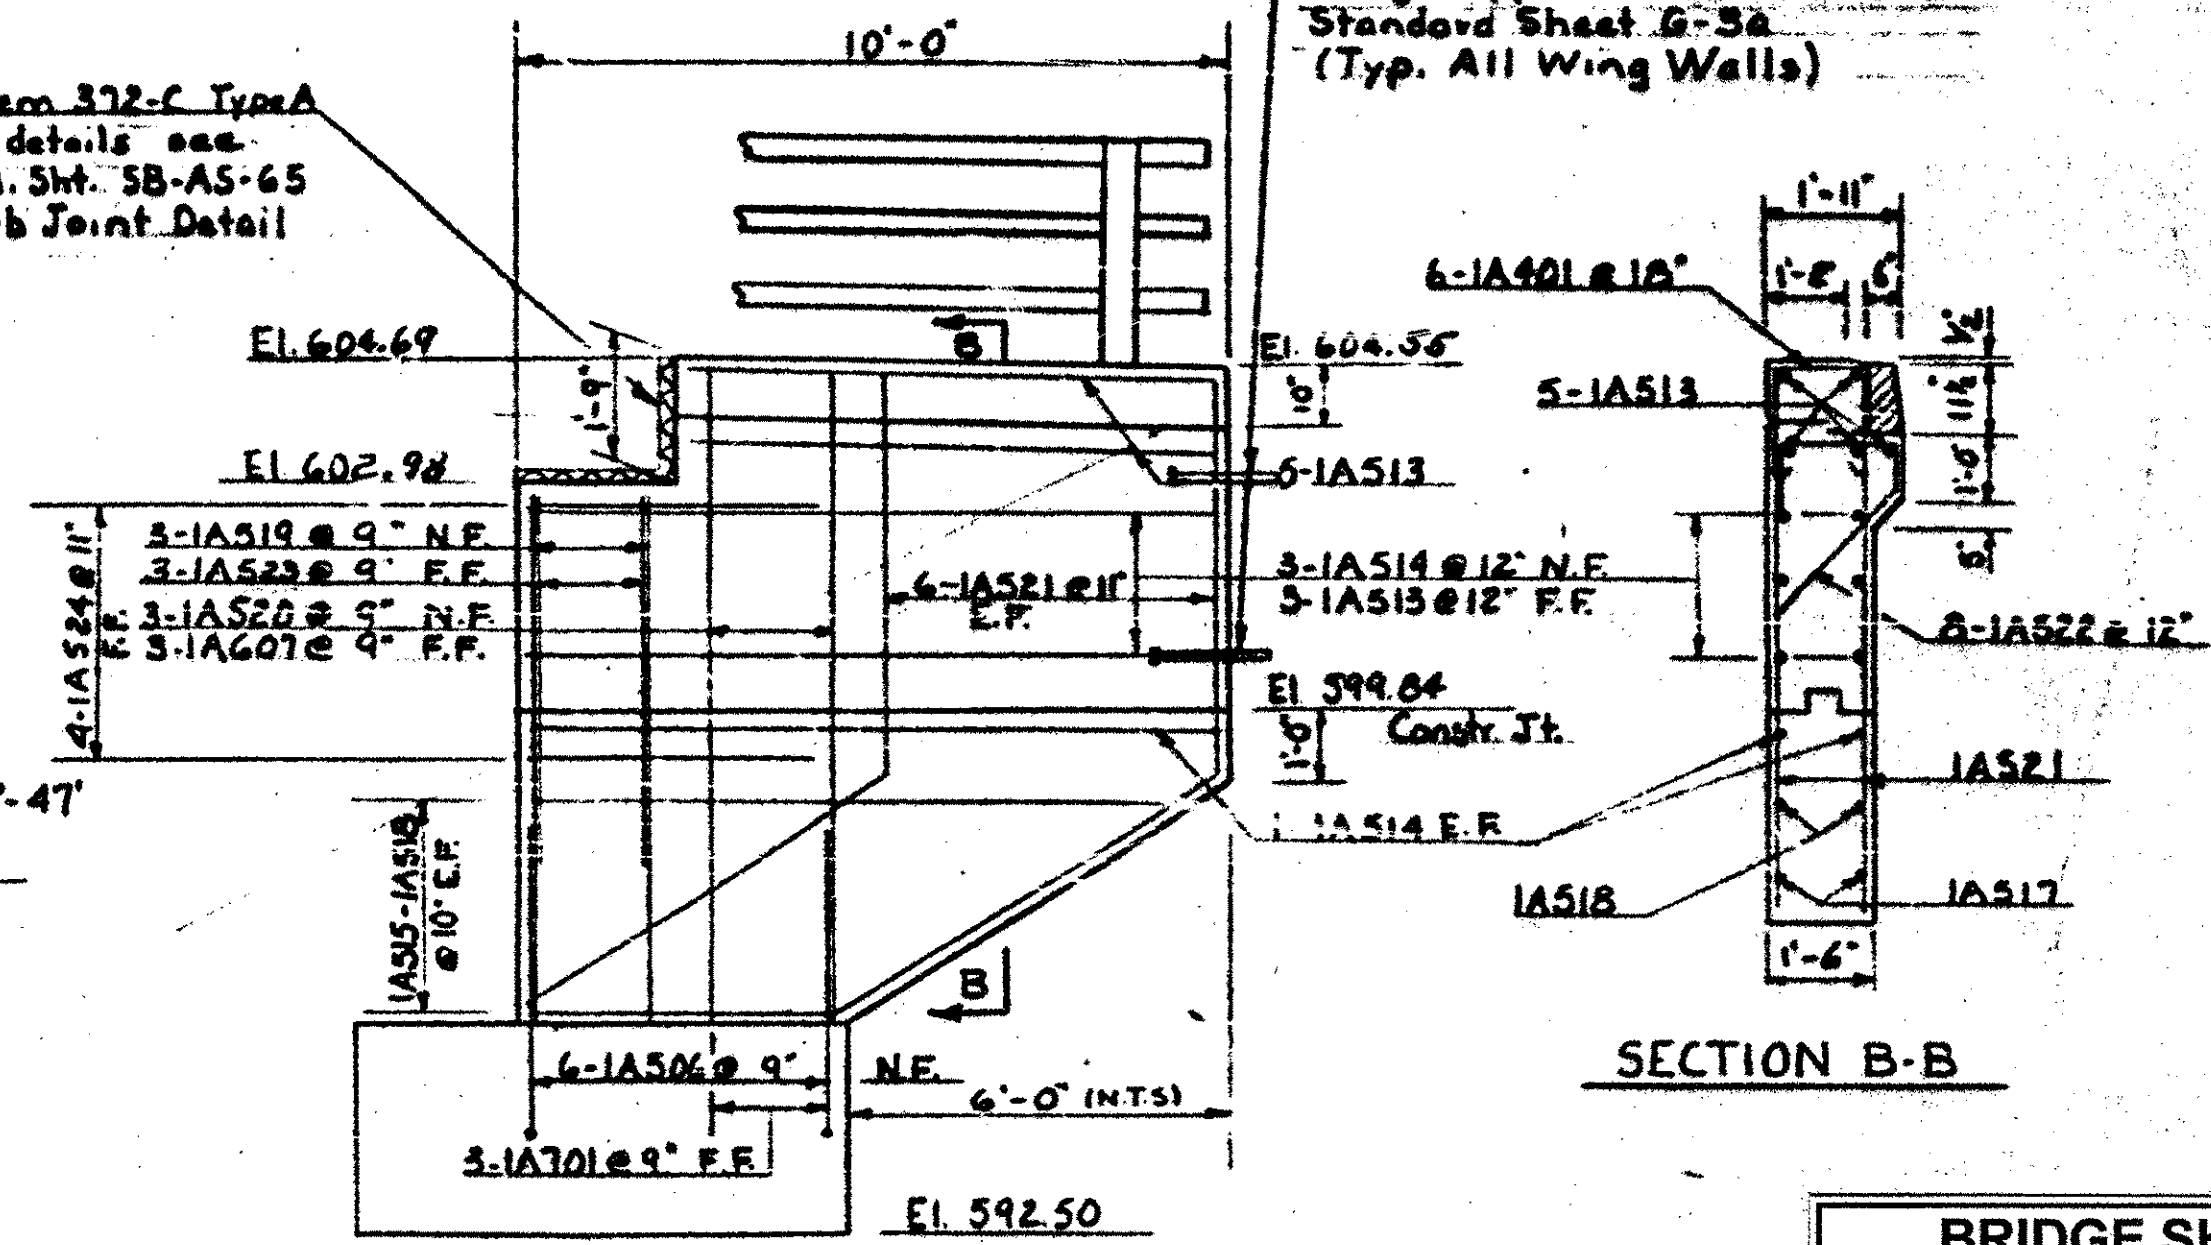

VIEW A-A

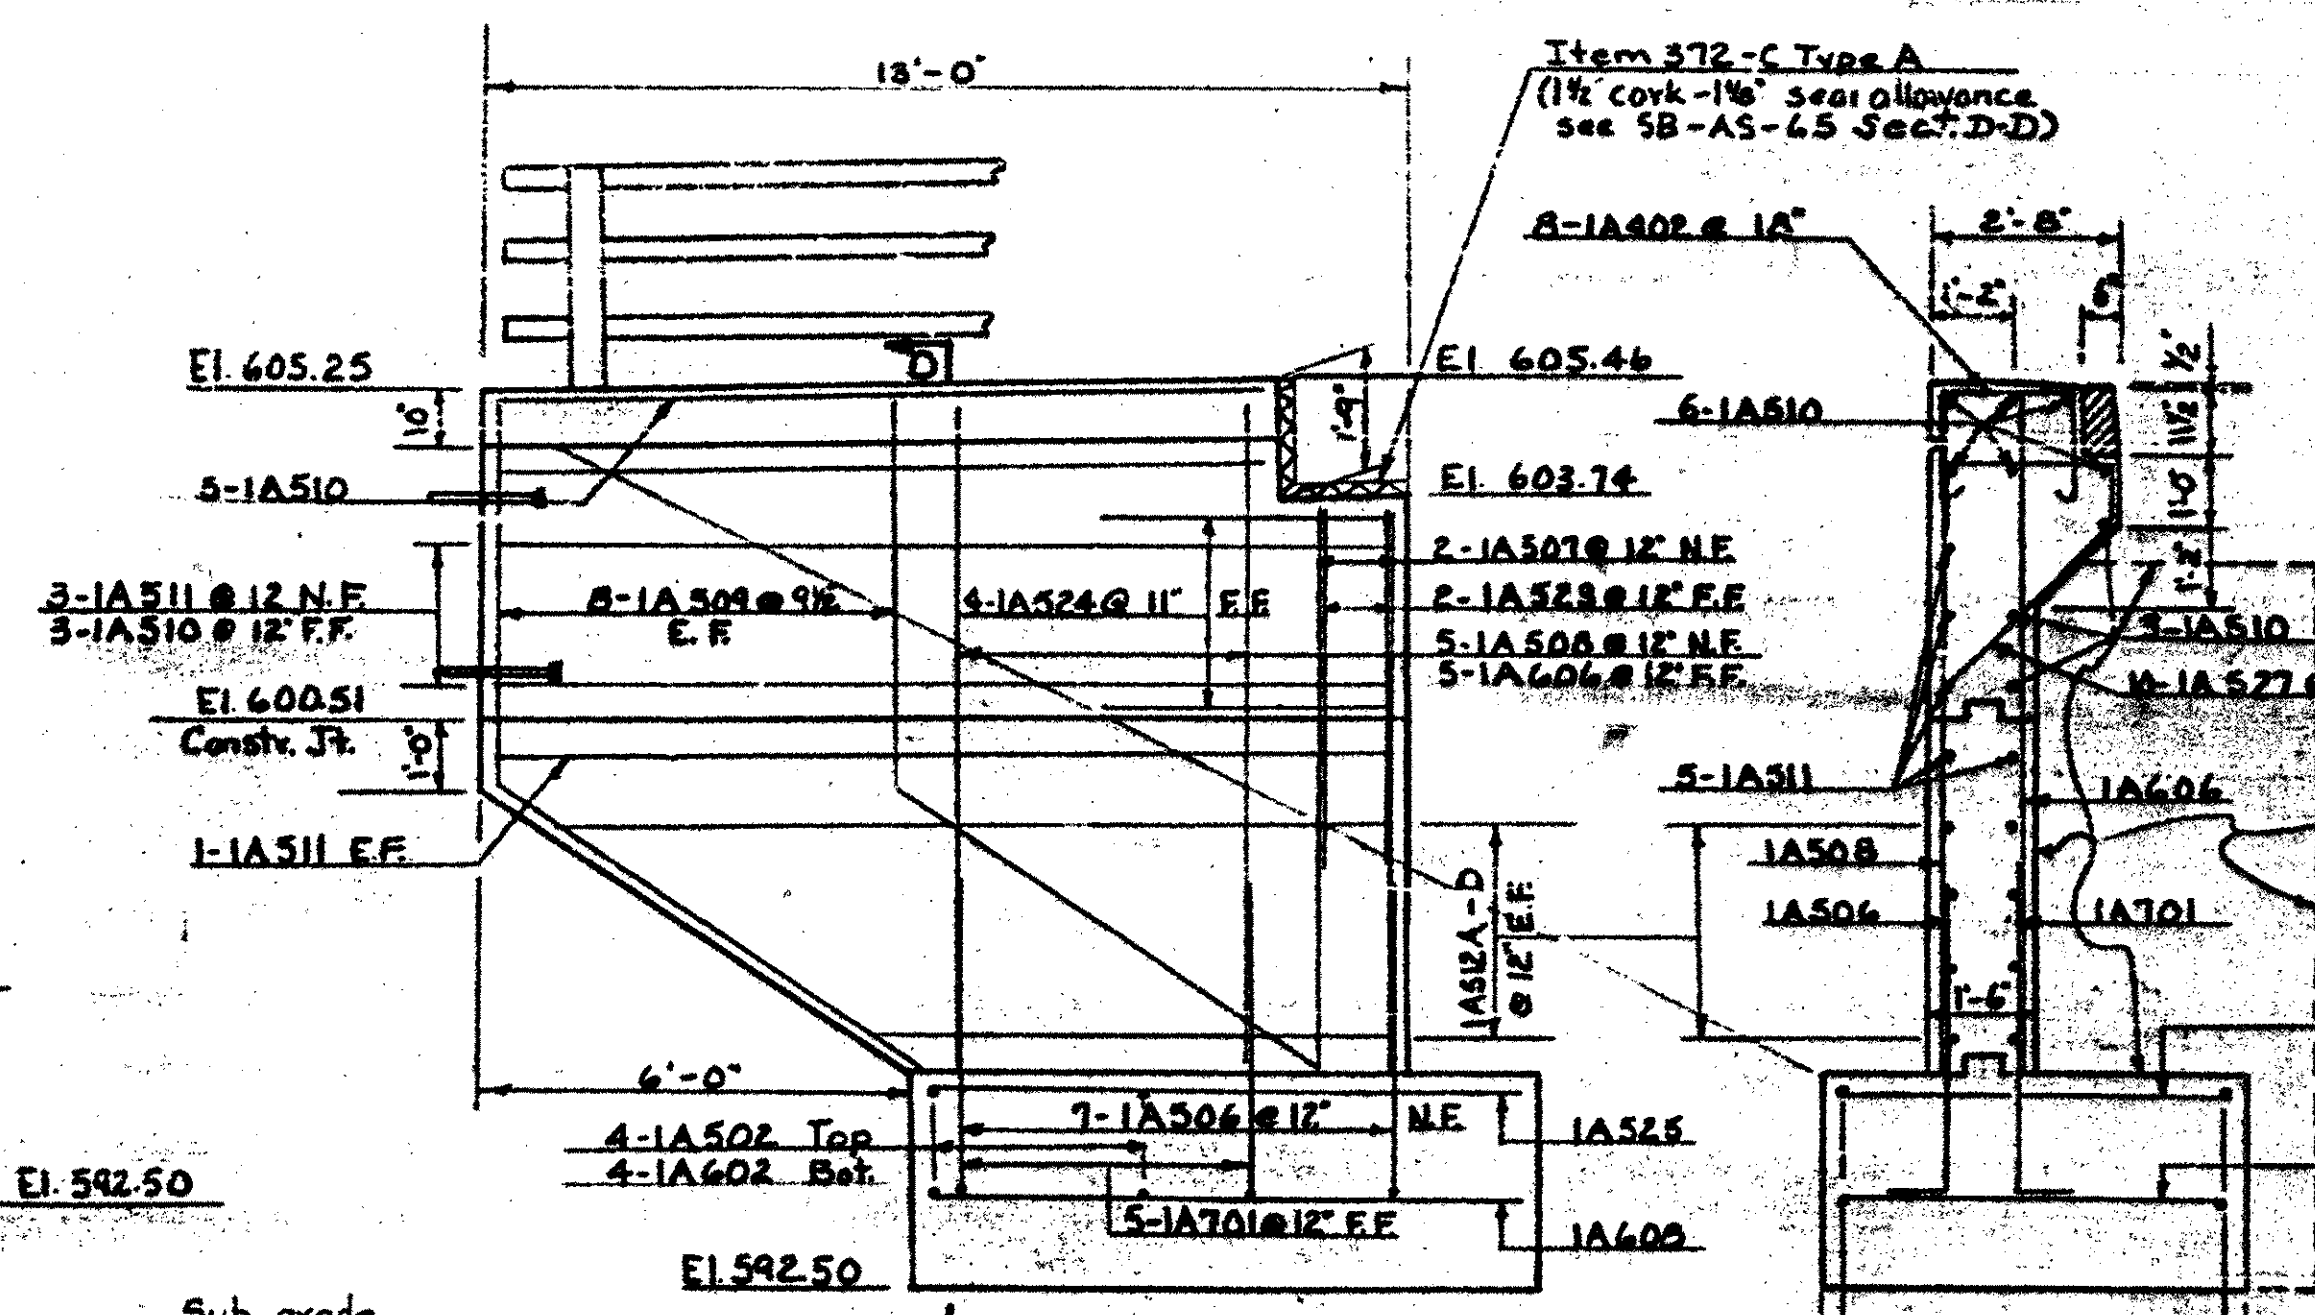

VIEW C-C

NOTES

1. For general notes see Sheet BR-100.
2. Fill to be made 6" above bottom of footing elevation before piles are driven.
3. All piles shall be driven to a minimum bearing capacity of 45 tons and to a minimum penetration of 10' into original ground.

No. Piles	Size	Est. Length of Piles	Splices Allowed for Piles not exceeding Plan Length (to be paid for only if used)	Splices Estimated for Piles exceeding Plan Length (to be paid for only if used)
10	12BP53	35		2

SECTION E-E

For Dead End Anchorage of Bridge Approach details see Standard Sheet G-38 (Typ. All Wing Walls)

SECTION B-B

BRIDGE SHEET BR241
REFERENCE SHEET 3 OF 9
SHEET 119 OF 370

Stage 1 Construction
SECTION D-D
CONTRACT 2

STATE OF VERMONT
DEPARTMENT OF HIGHWAYS

TOWN OF Georgia - Fairfax - Fairfield
St. Albans
ROUTE NO. 189 - LOG STA
Abutment # 1 S.B.
T-89 Over Vt. 104
Scale 3/8" = 1'-0" or as Noted
SURVEYED BY
DRAWN BY R.A.G. CHECKED BY W.M.S.
PROJECT NO. 189-345 Cont. 2
SHEET 170 OF 167

BR 875

BR 109