
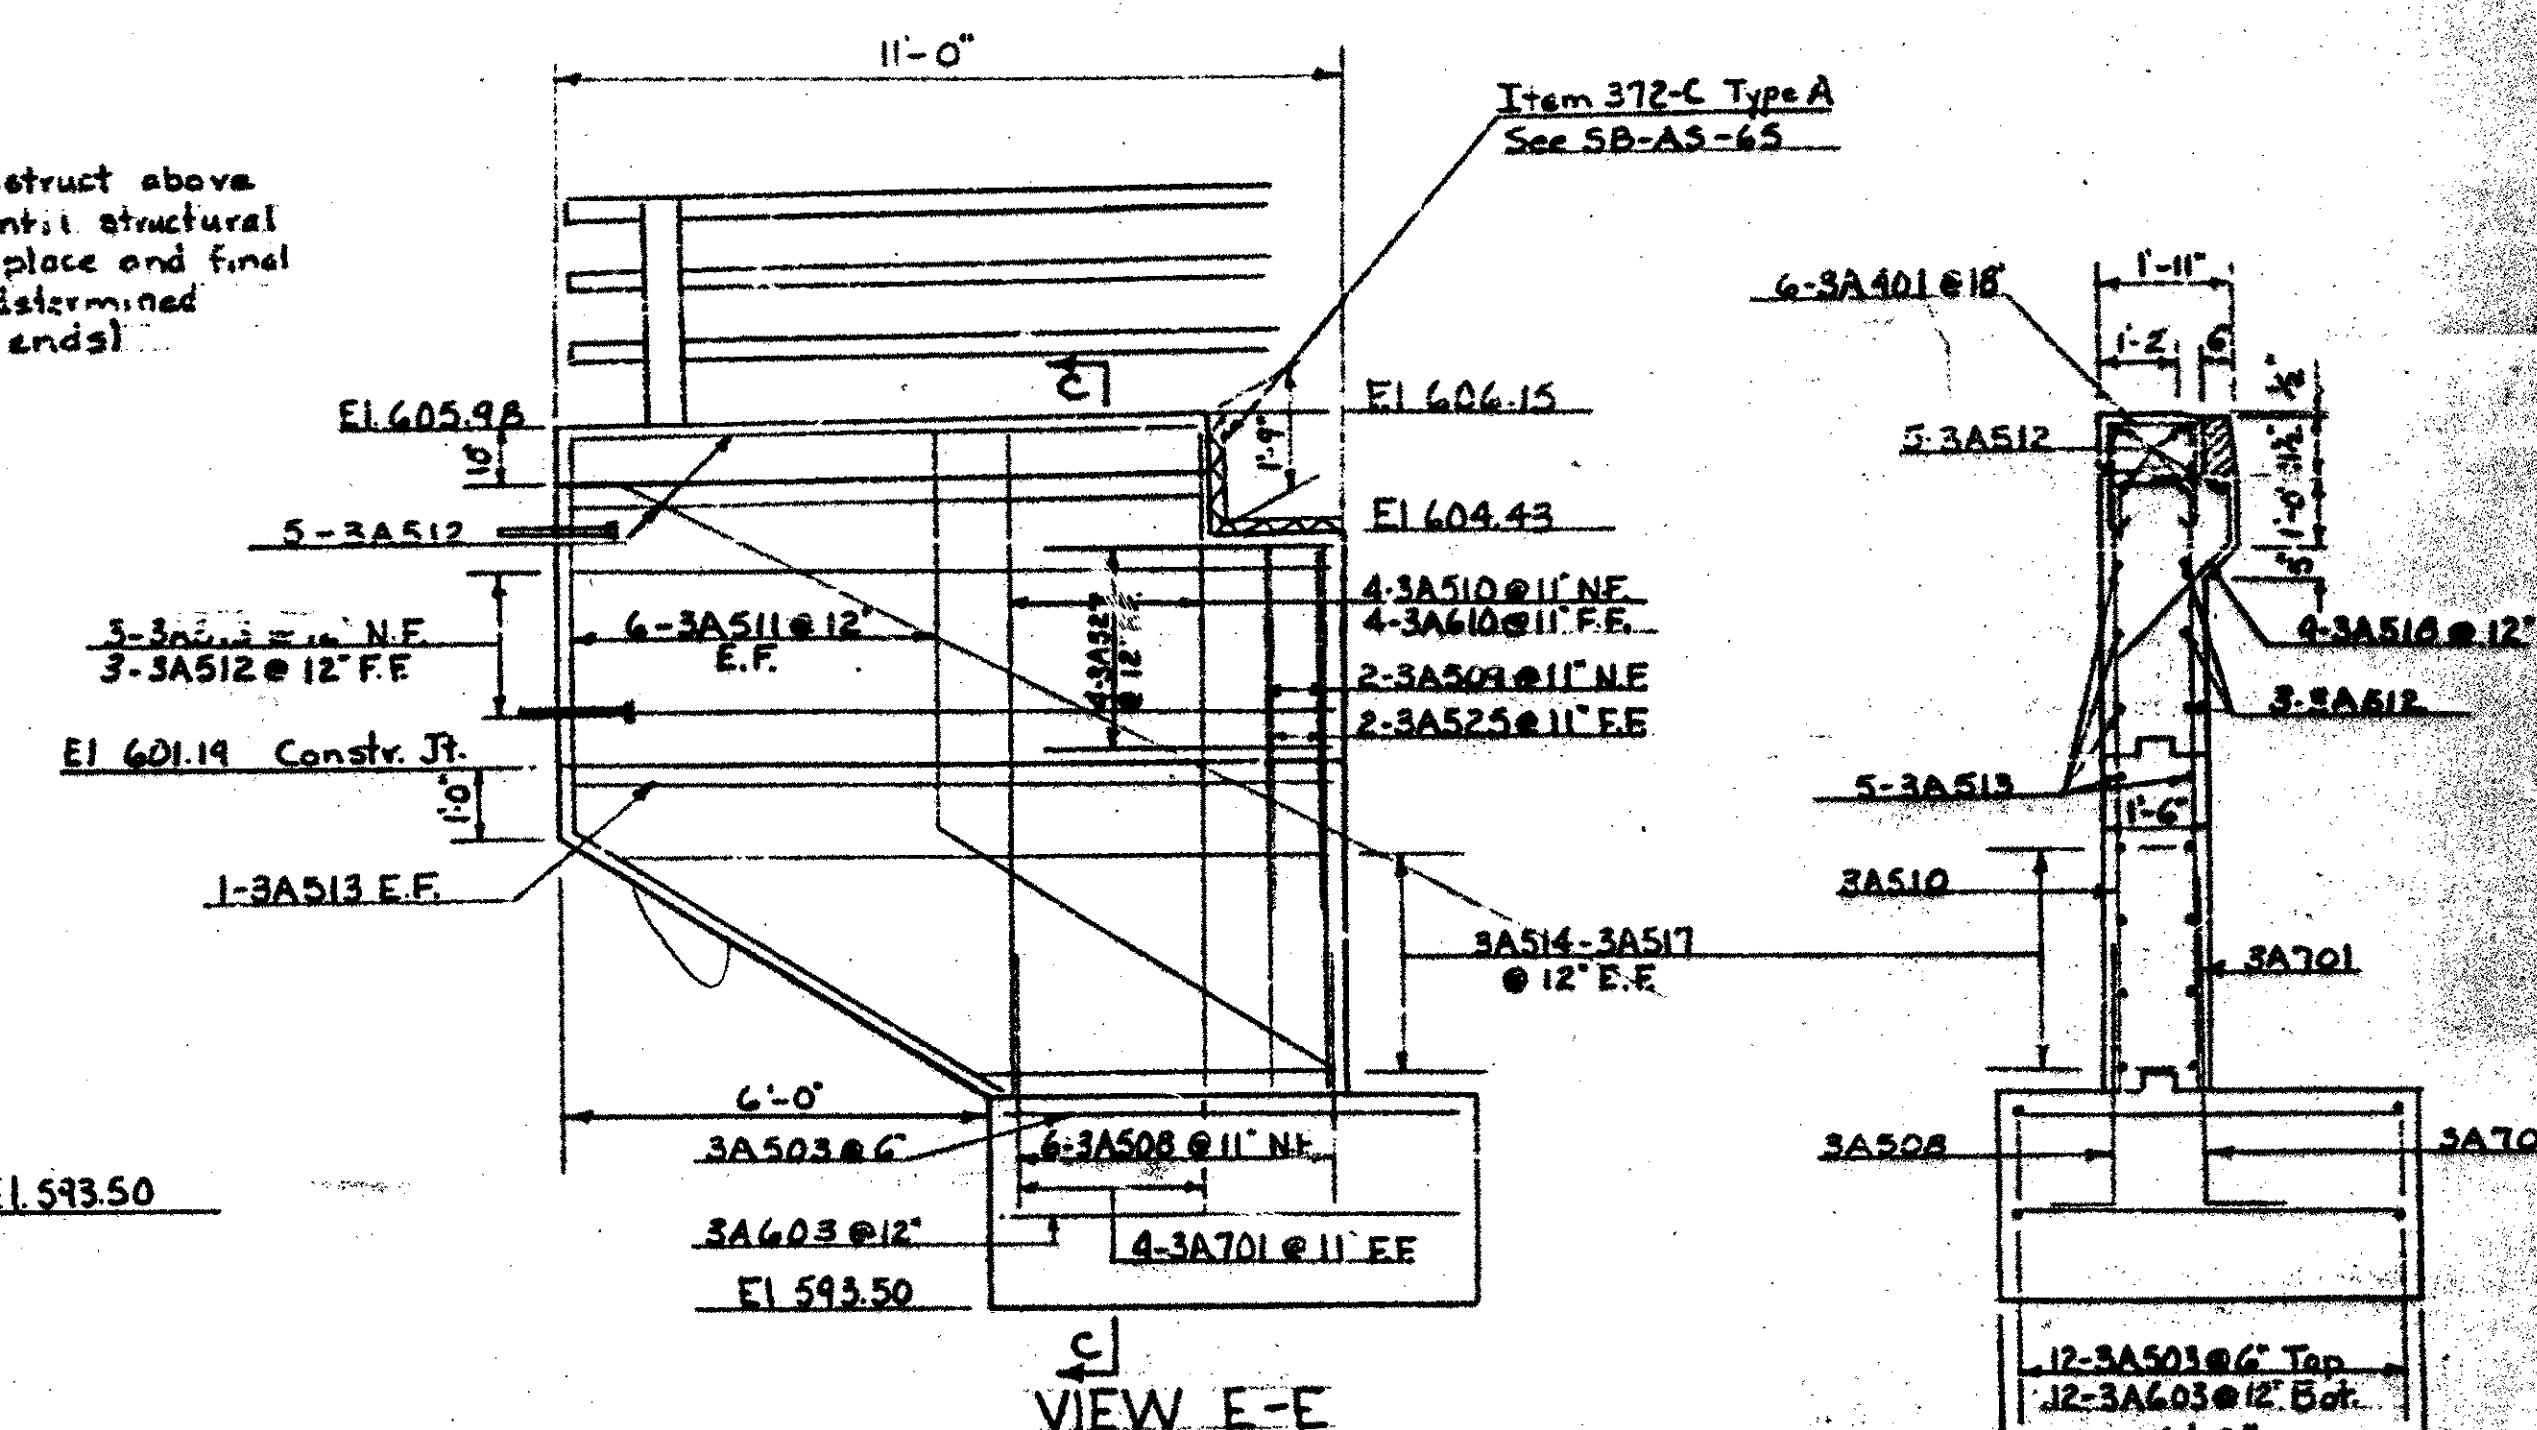
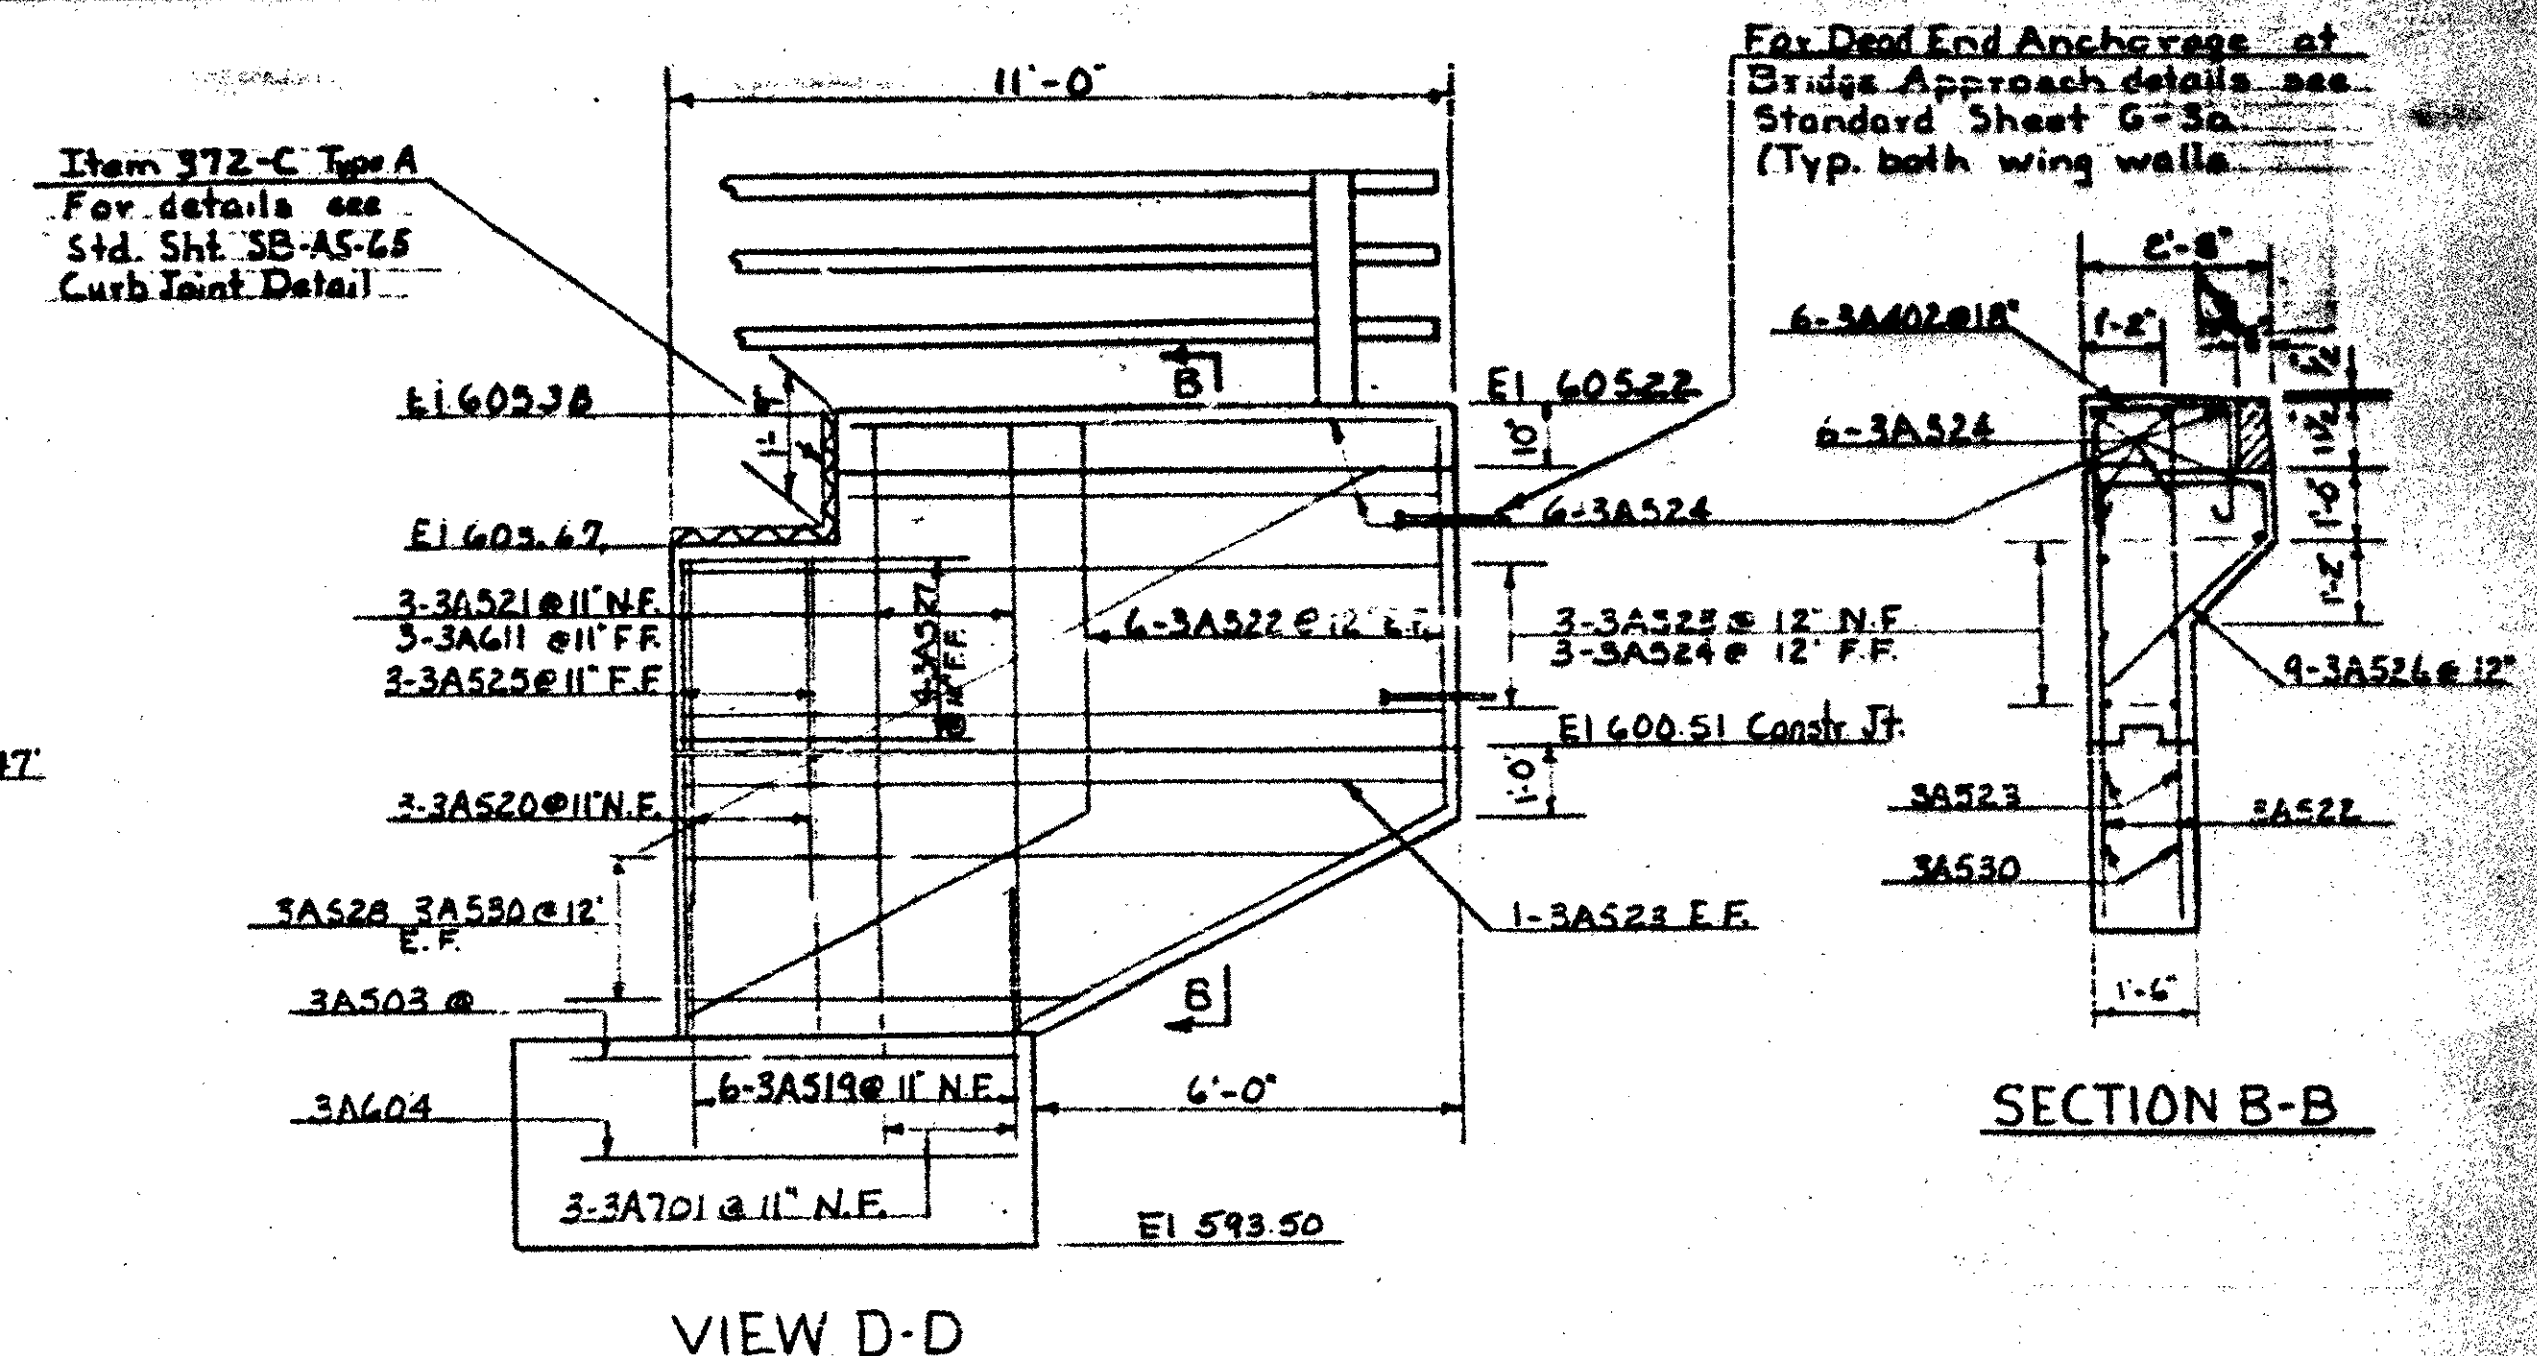
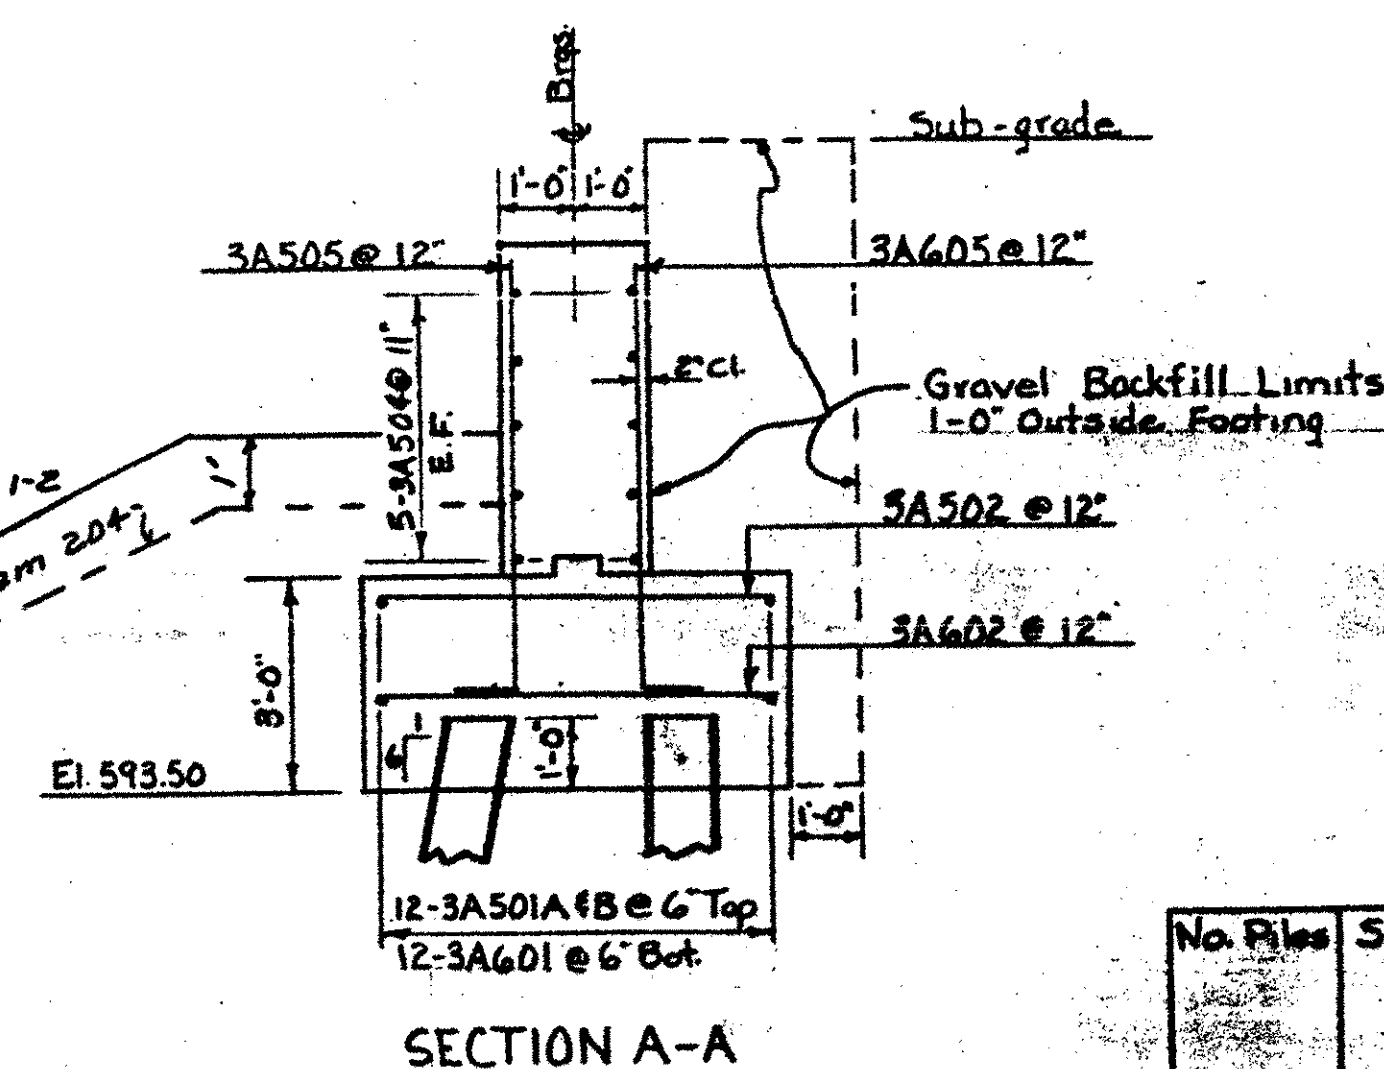
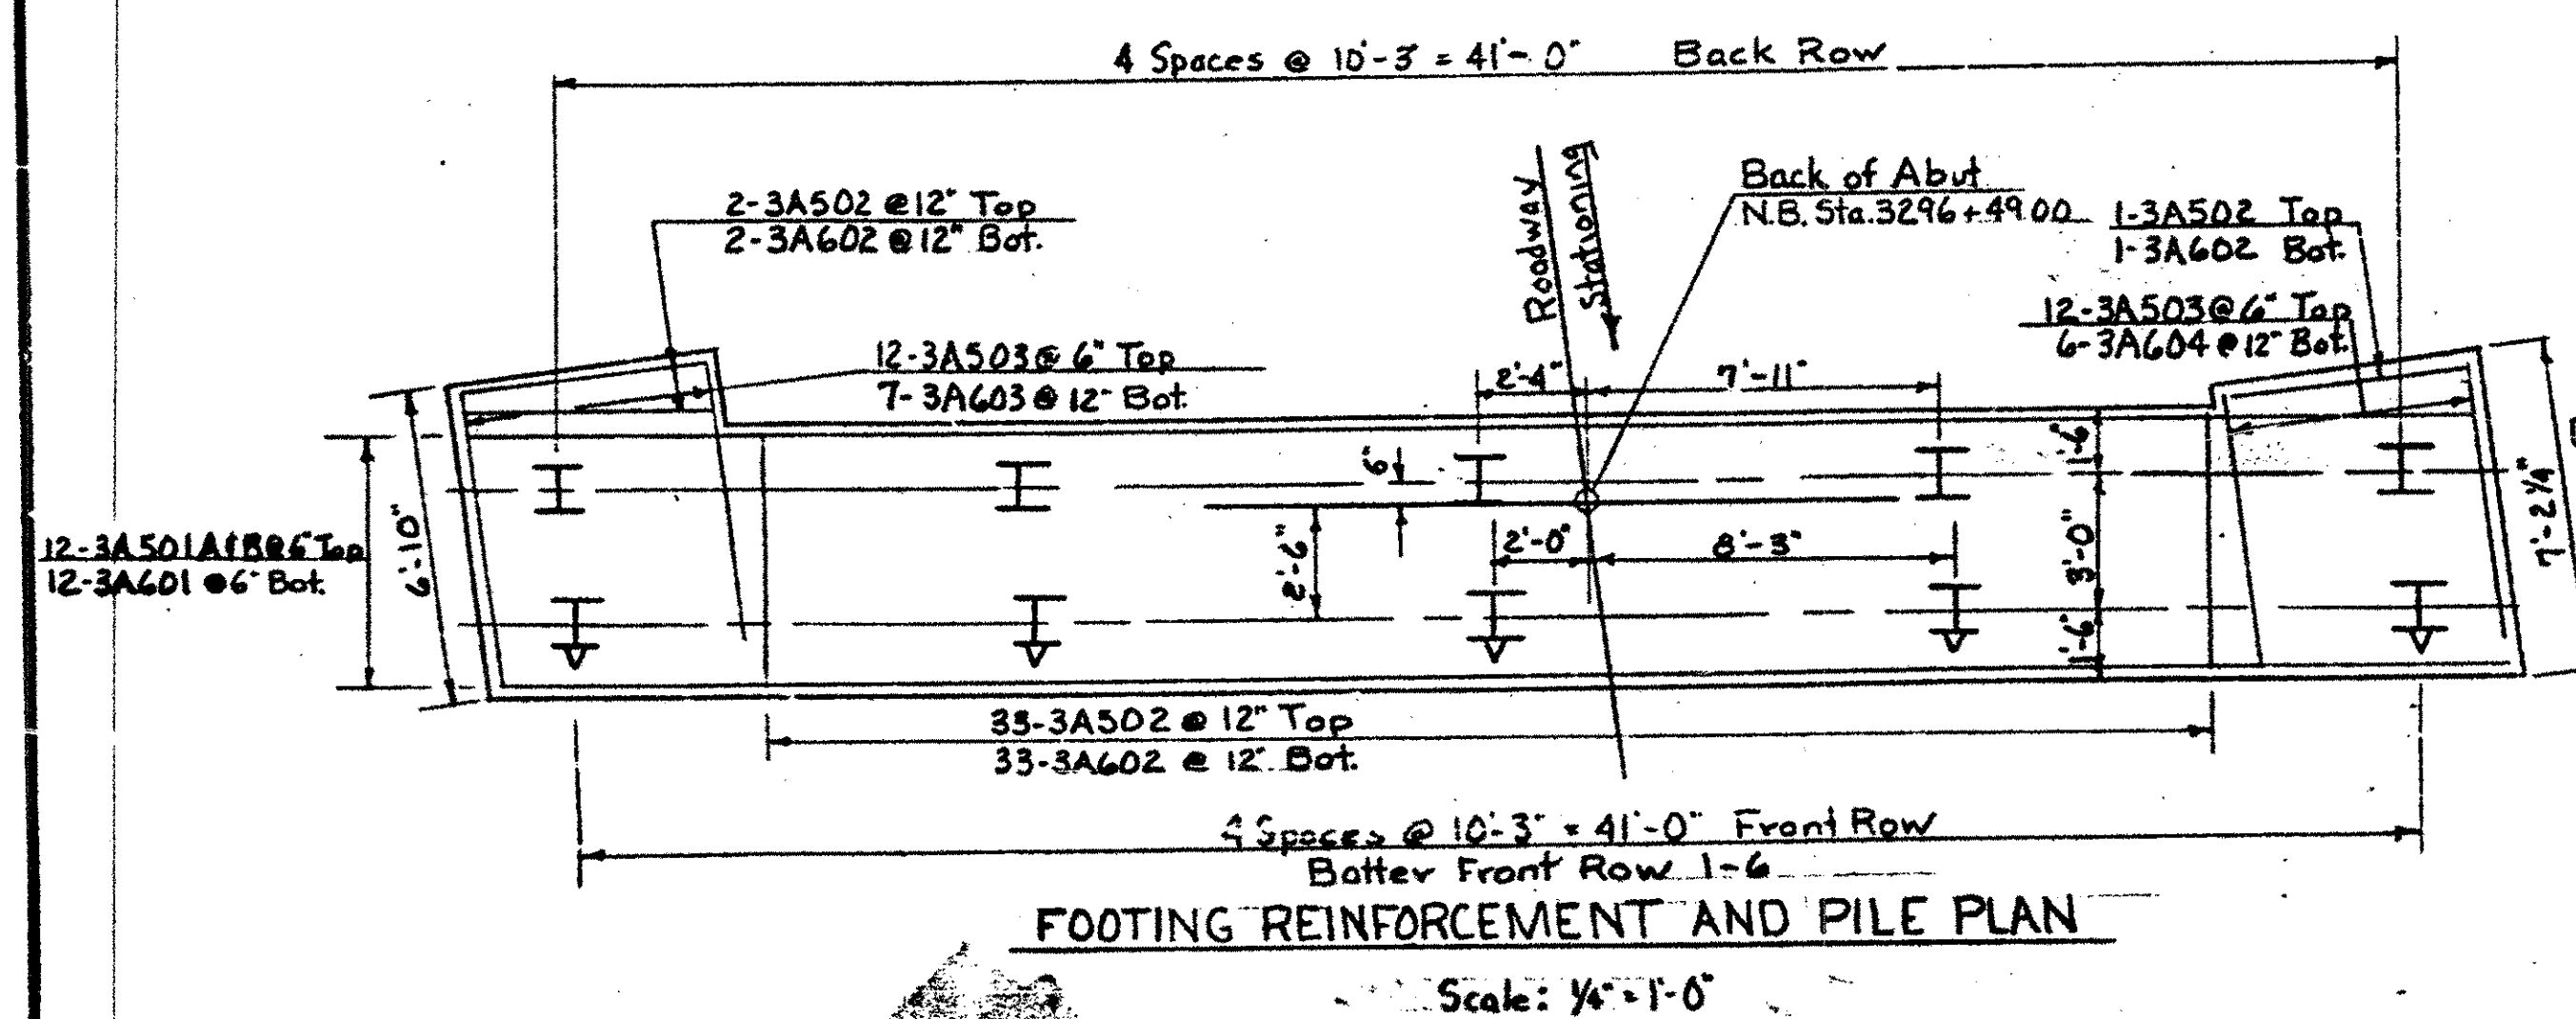
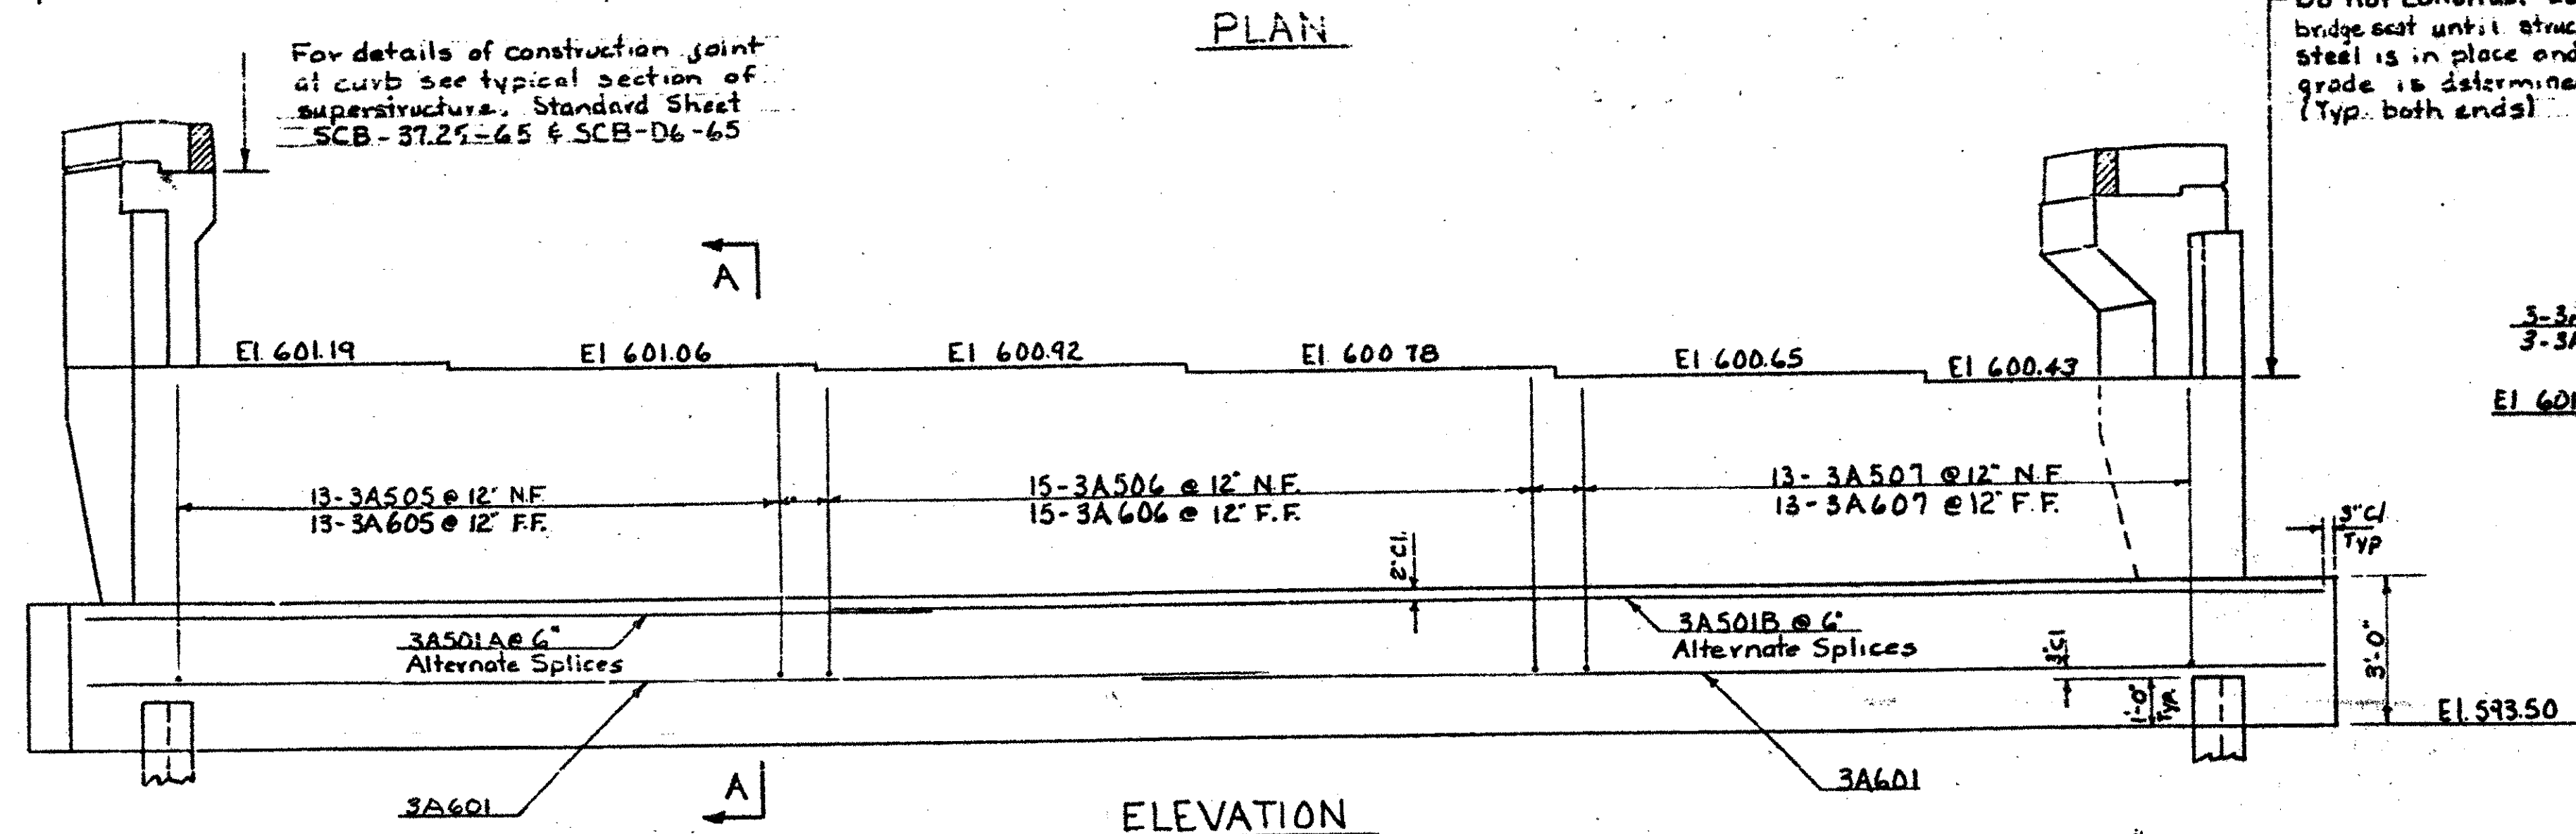


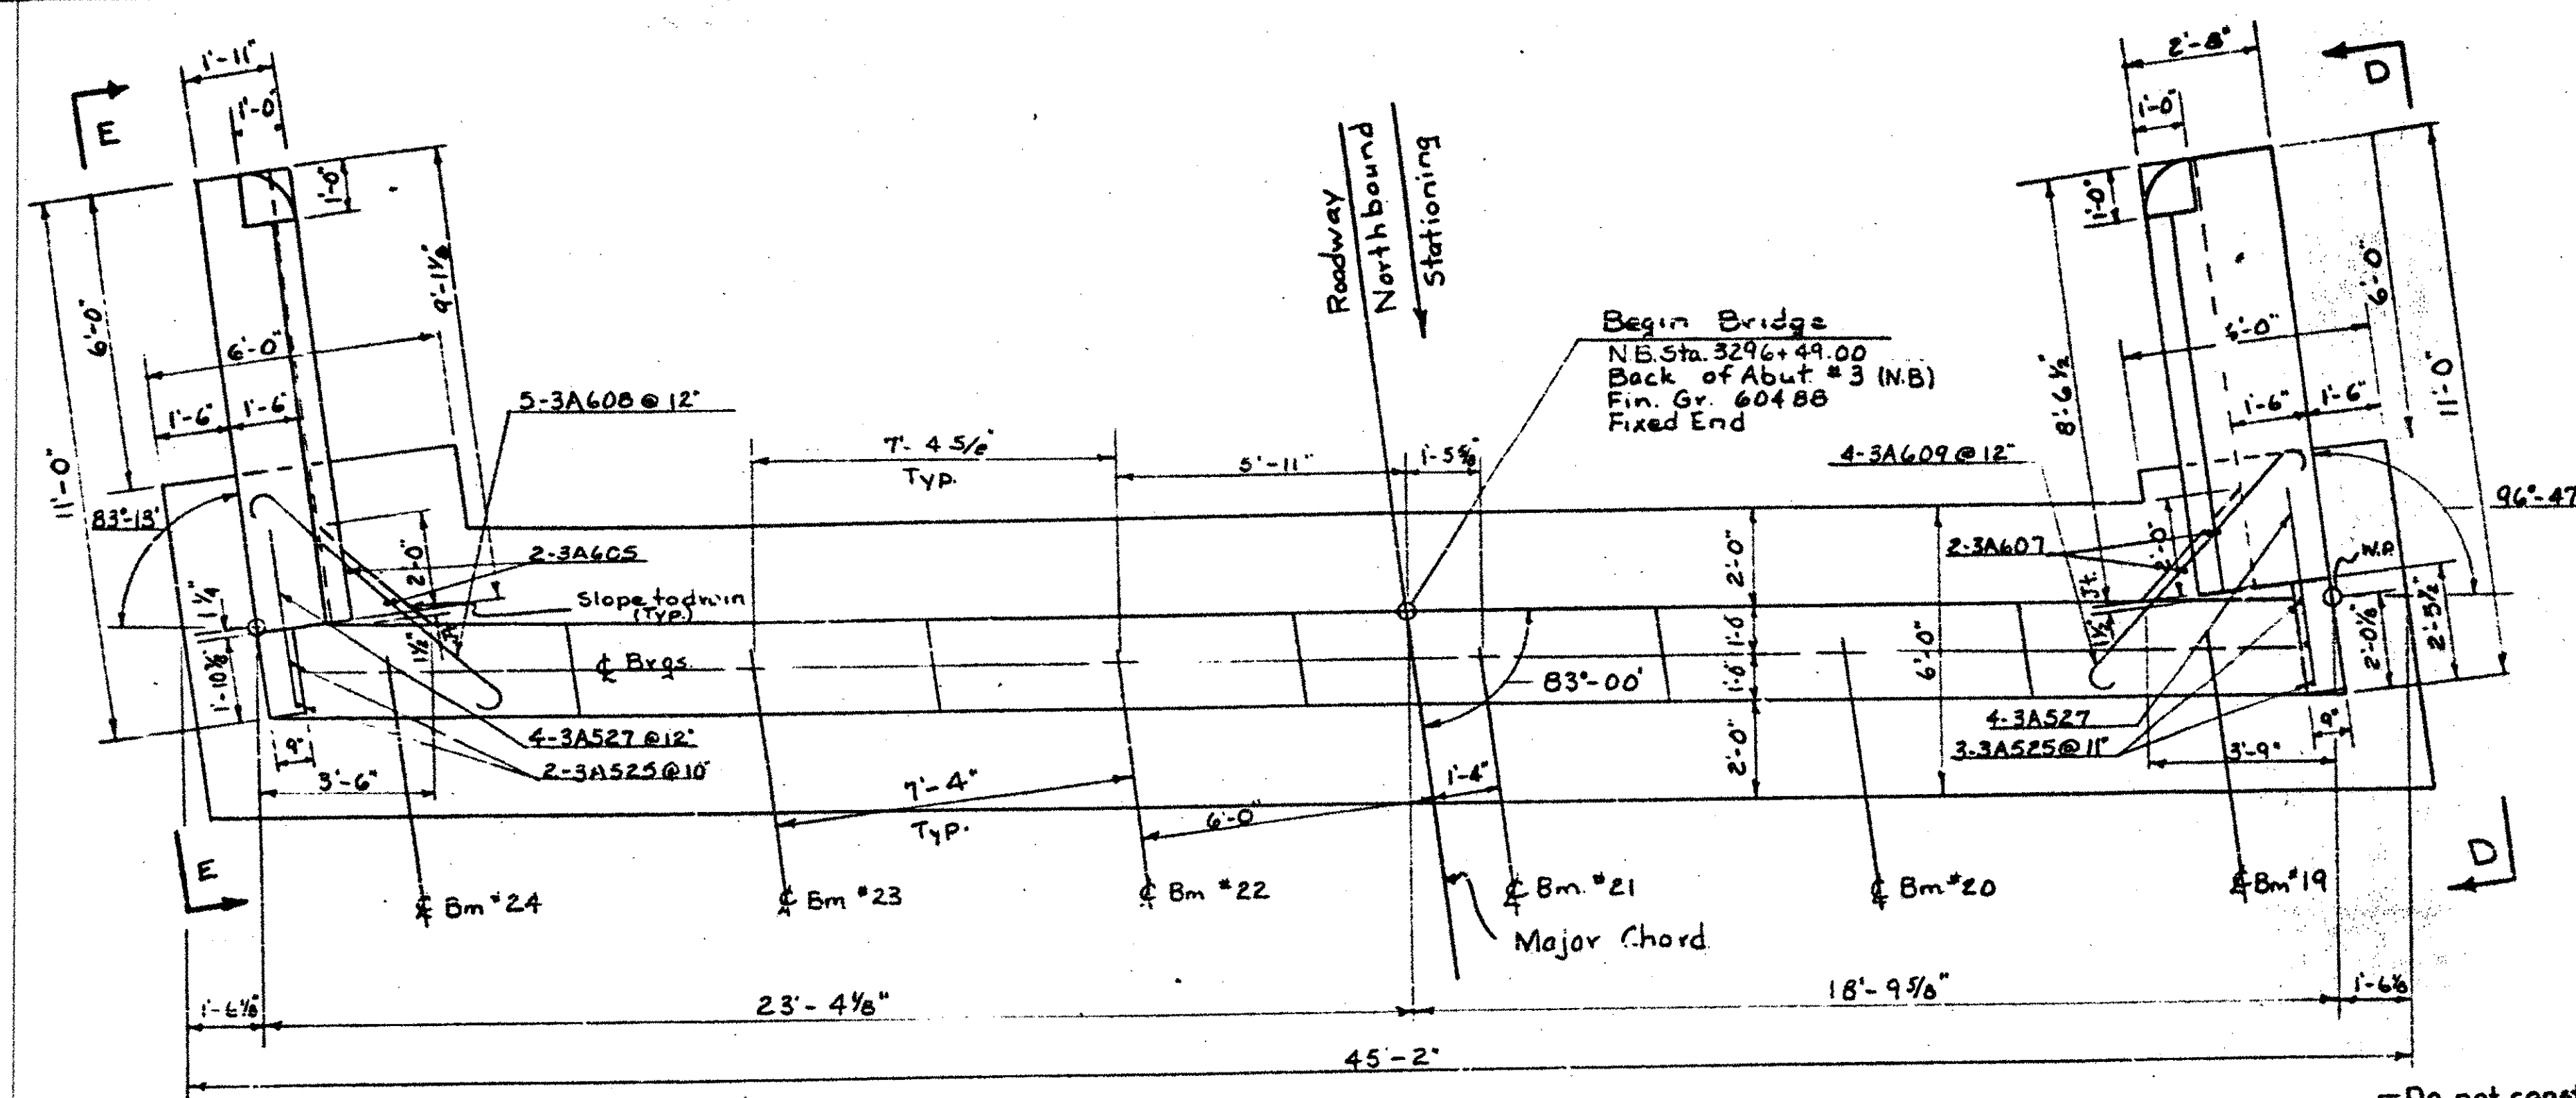

- ### NOTES
1. For general notes see Sheet BR-100.
 2. Fill to be made 6" above bottom of footing elevation before piles are driven.
 3. All piles shall be driven to a minimum bearing capacity of 45 tons and to a minimum penetration of 10' into original ground.

No. Piles	Size	Est. Length of Piles	Splices Allowed for Piles not exceeding Plan Length (to be paid for only if used)	Splices Estimated for Piles exceeding Plan Length (to be paid for only if used)
10	12BP53	35'		2

CONTRACT 2
BRIDGE SHEET BR243
REFERENCE SHEET 5 OF 9
SHEET 121 OF 370

TOWN OF Georgia-Earfax-Earfield
- St Albans
ROUTE No I 89 LOG STA
Abutment # 3 N.B
I 89 Over Vt 104
SCALE 3/4" = 1'-0" or 92' Noted
SURVEYED BY
DRAWN BY RAO CHECKED BY WJS-ET
PROJECT No I 89-3/99 Cont # 2
SHEET 172 OF 167

BR III