



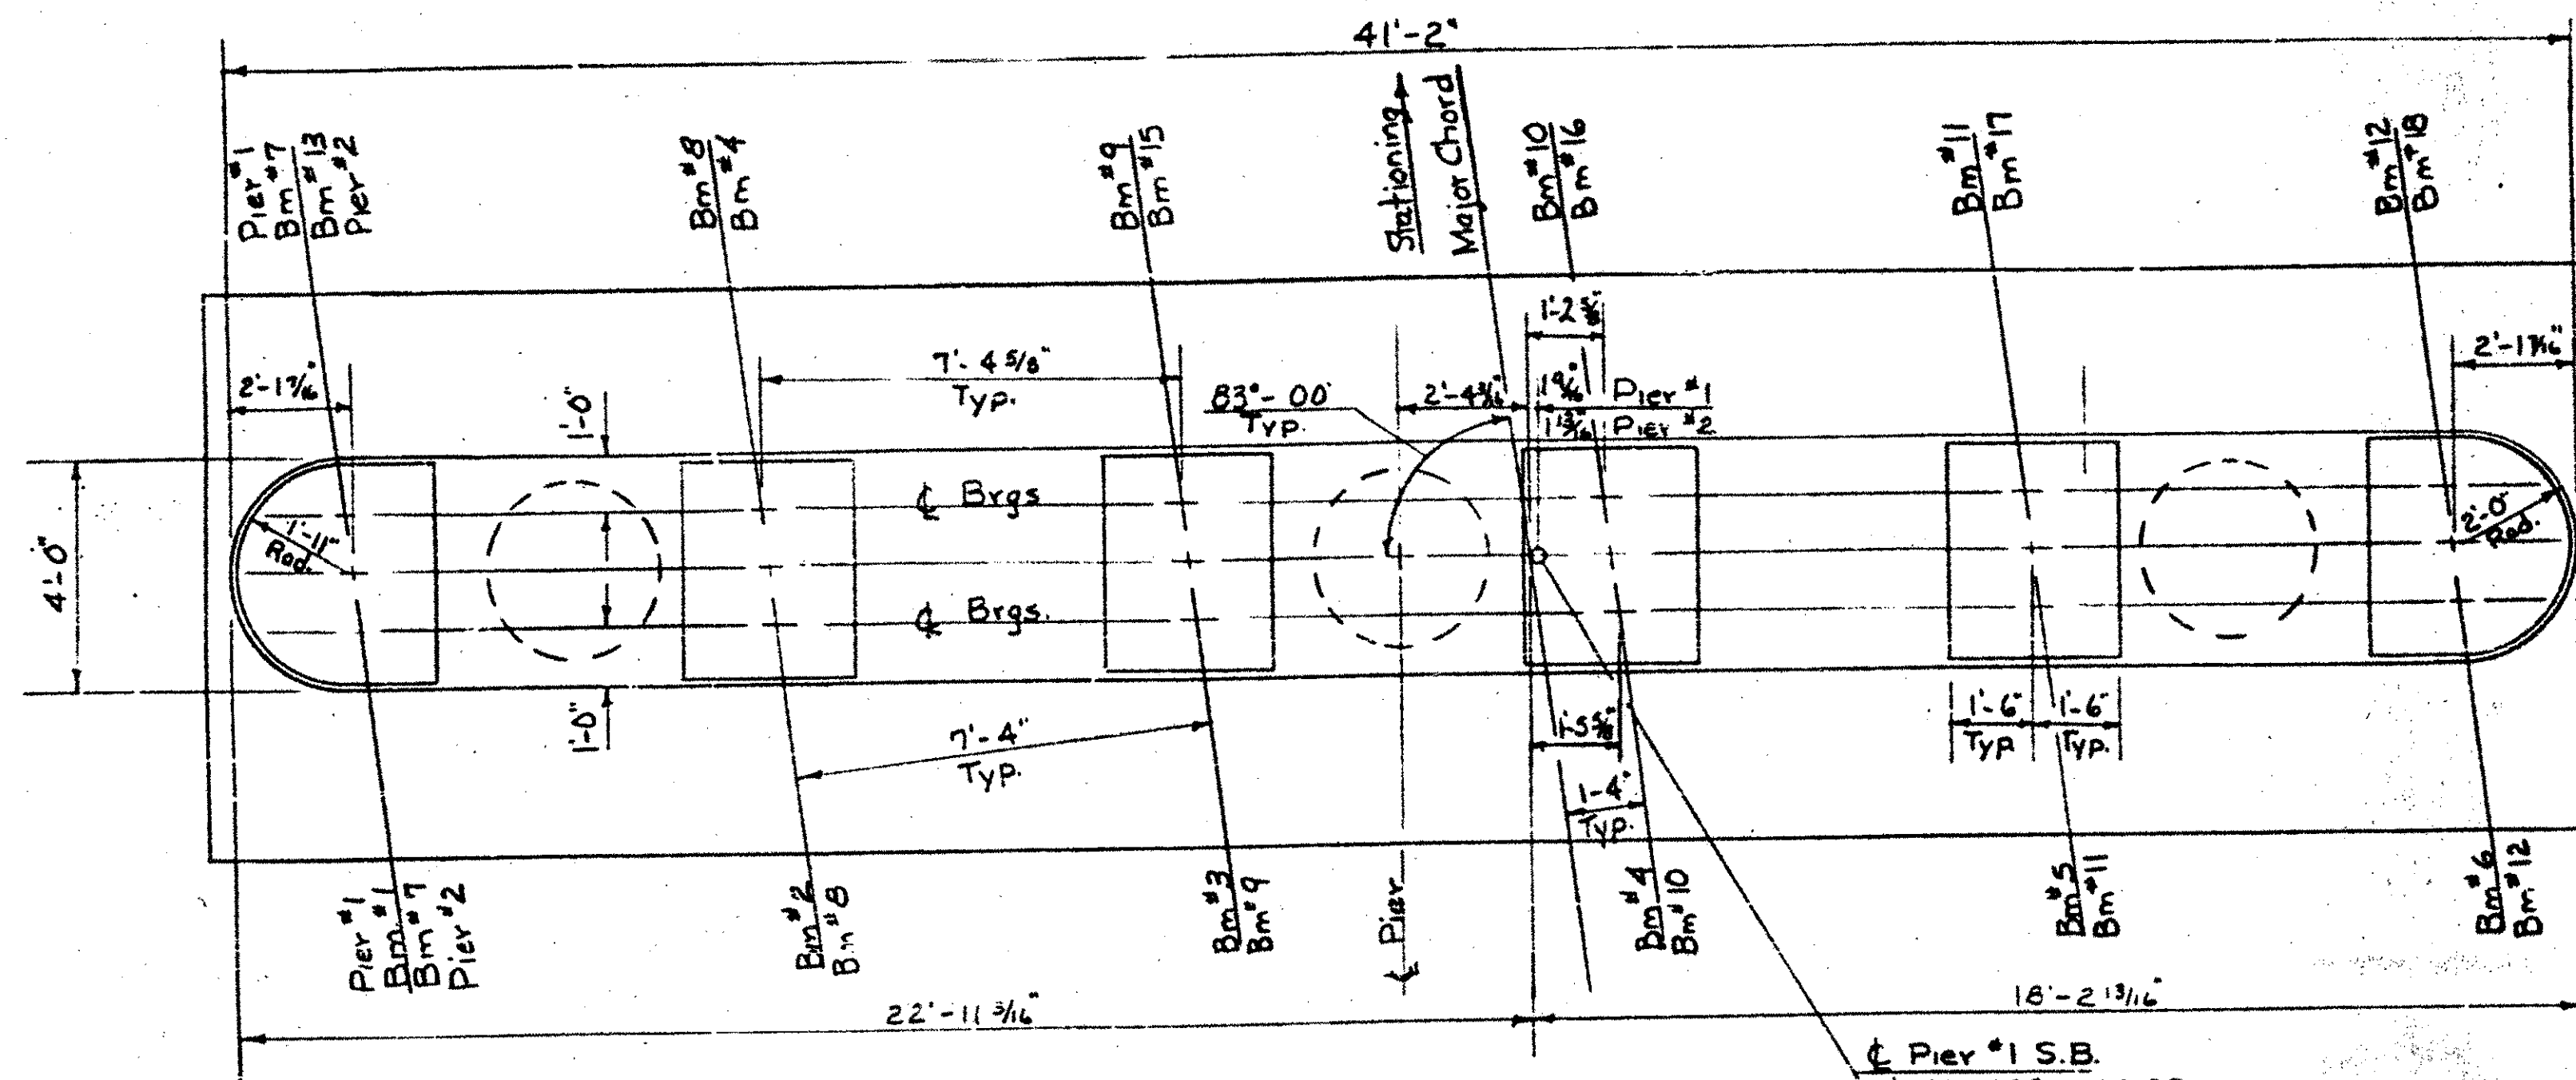


Pier	Elev A	Elev B	Elev C	Elev D	Elev E	Elev F
#1 Span1	600.55	600.76	600.90	601.03	601.17	601.30
#1 Span2	600.42	600.64	600.77	600.91	601.05	601.18
#2 Span2	601.65	601.86	602.00	602.14	602.27	602.41
#2 Span3	601.93	602.14	602.28	602.41	602.55	602.68

BRIDGE SEAT ELEVATIONS

NOTES

1. Spiral reinforcement for all columns on all piers shall conform to A.A.S.H.O. Desig. M 32-60, Cold Drawn Steel Wire. Where spiral splicing is necessary lap is to be 1 1/2 turns. The furnishing and installation of cold spiral reinforcement shall be paid for under Item No. 402.
2. For details of drain trough and downspout at piers see Std. Sheet 5C2-D3-65.
3. All concrete in Pier Caps and Pier Columns shall be Class A-A and Pier Footings shall be Class B.
4. The furnishing and installation of drainage system with downspout shall be paid for under Item No. 404-A.
5. Pier Footings are designed for allowable earth bearing pressure of 2.5 tons per sq. ft.

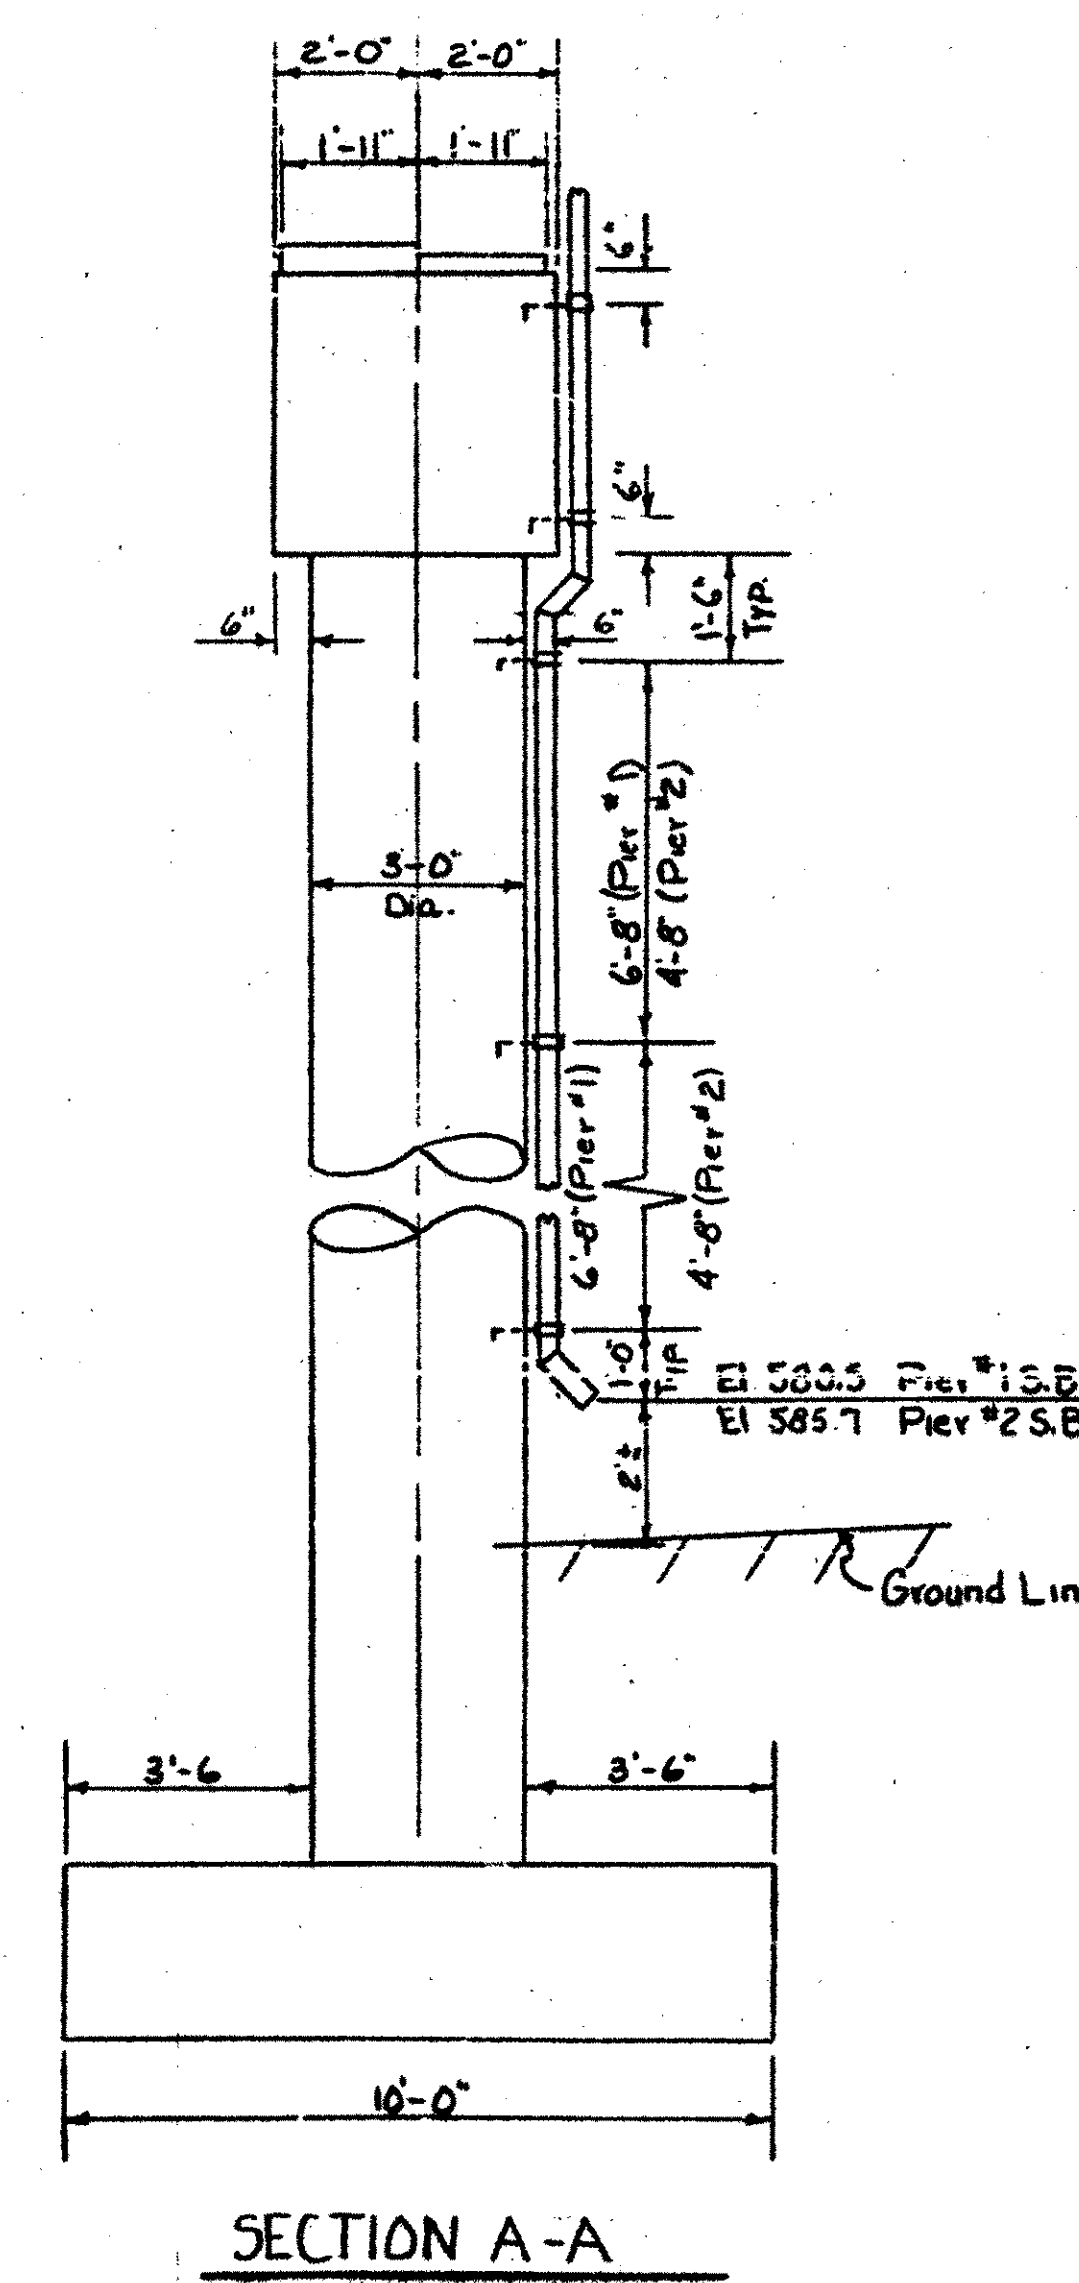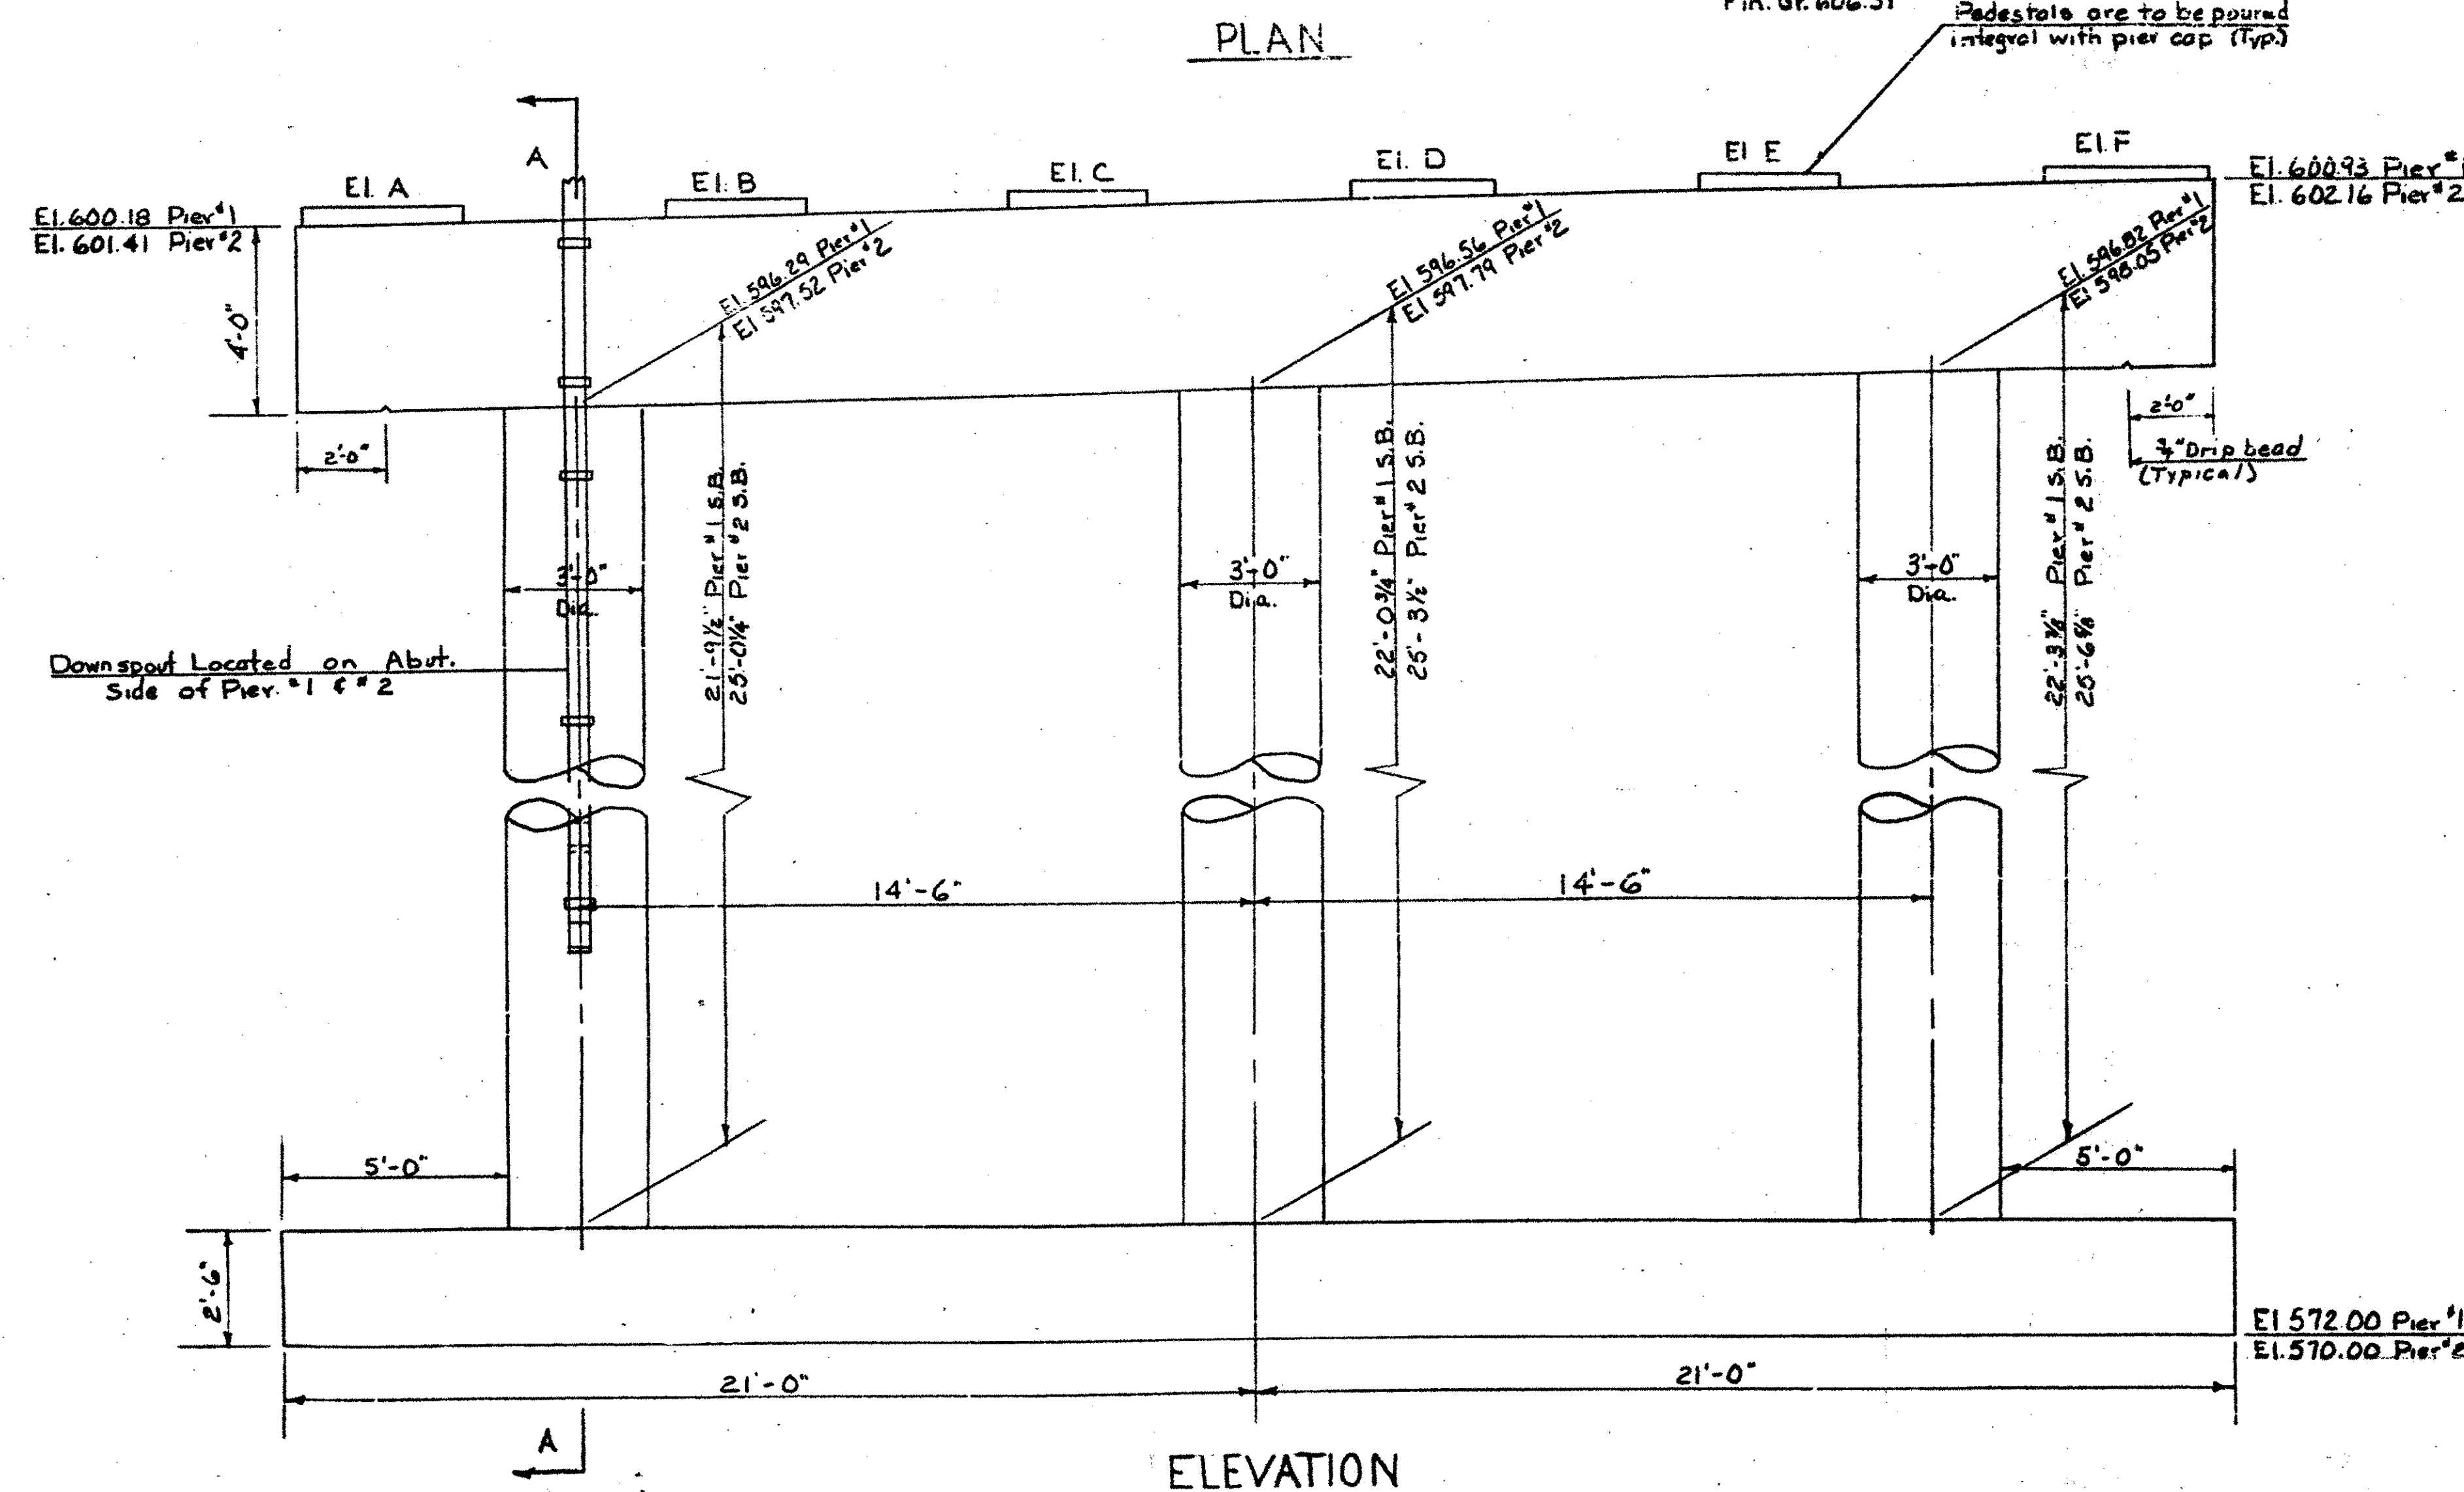

Stage 1 Construction

CONTRACT 2

BRIDGE SHEET BR245
REFERENCE SHEET 7 OF 9
SHEET 123 OF 370

TOWN OF Georgia - Fairfax - Fairfield
ROUTE No. 189 - Log STA.
Pier #1 & #2 S.B. Layout Details
189 over Vt. 104
SCALE: 3/8" = 1'-0"
SURVEYED BY: _____
DRAWN BY: B.A.D. CHECKED BY: WMS-EI
PROJECT NO. 189-3(35) Cont. #2
SHEET 123 OF 462

BR-113 BR 875