

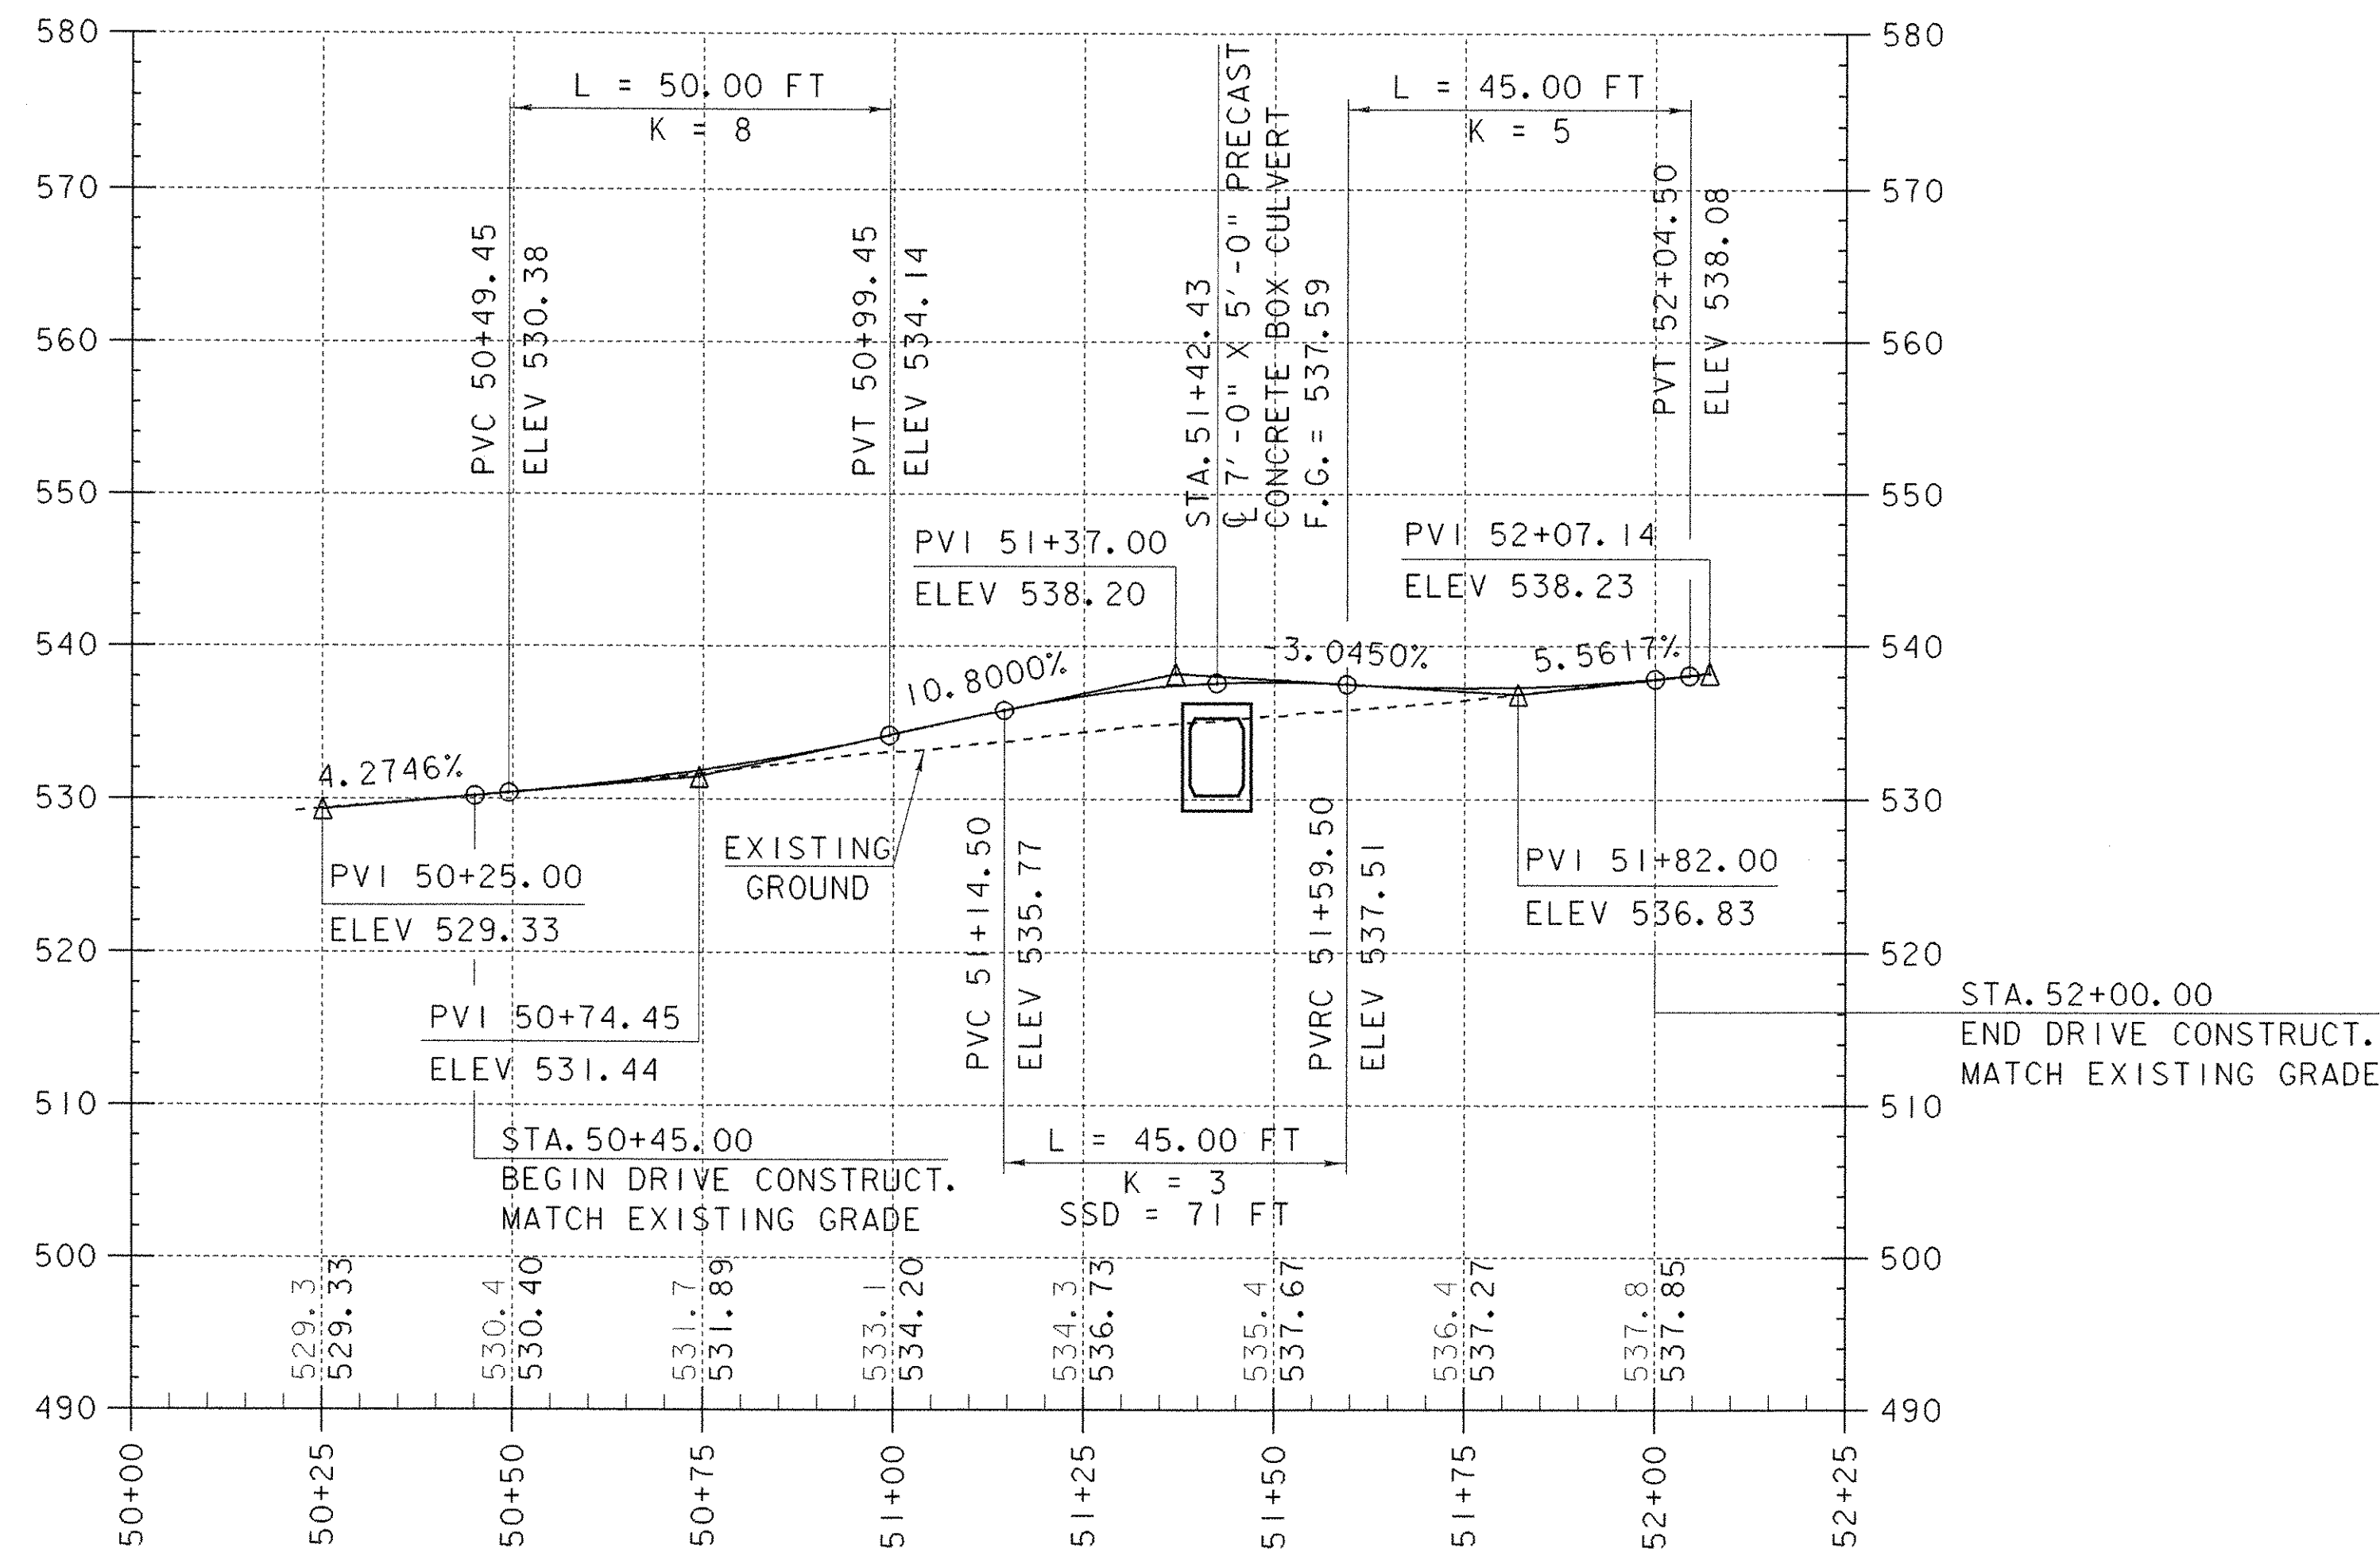


DRIVE PROFILE

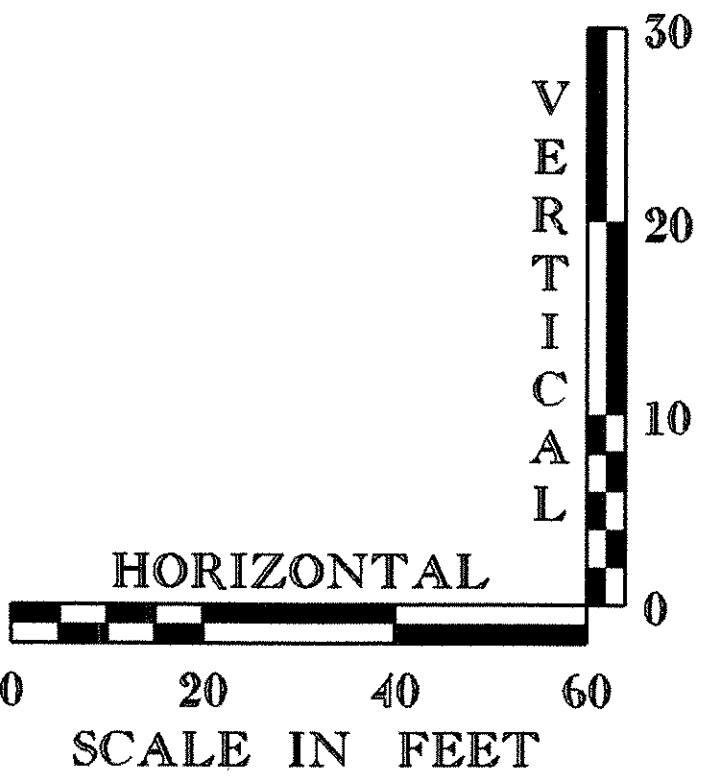

NOTE:
GRADES TO THE NEAREST TENTH ARE
EXISTING GROUND ALONG CENTERLINE.
GRADES TO THE NEAREST HUNDREDTH
ARE FINISH GRADES ALONG CENTERLINE.

CHANNEL PROFILE

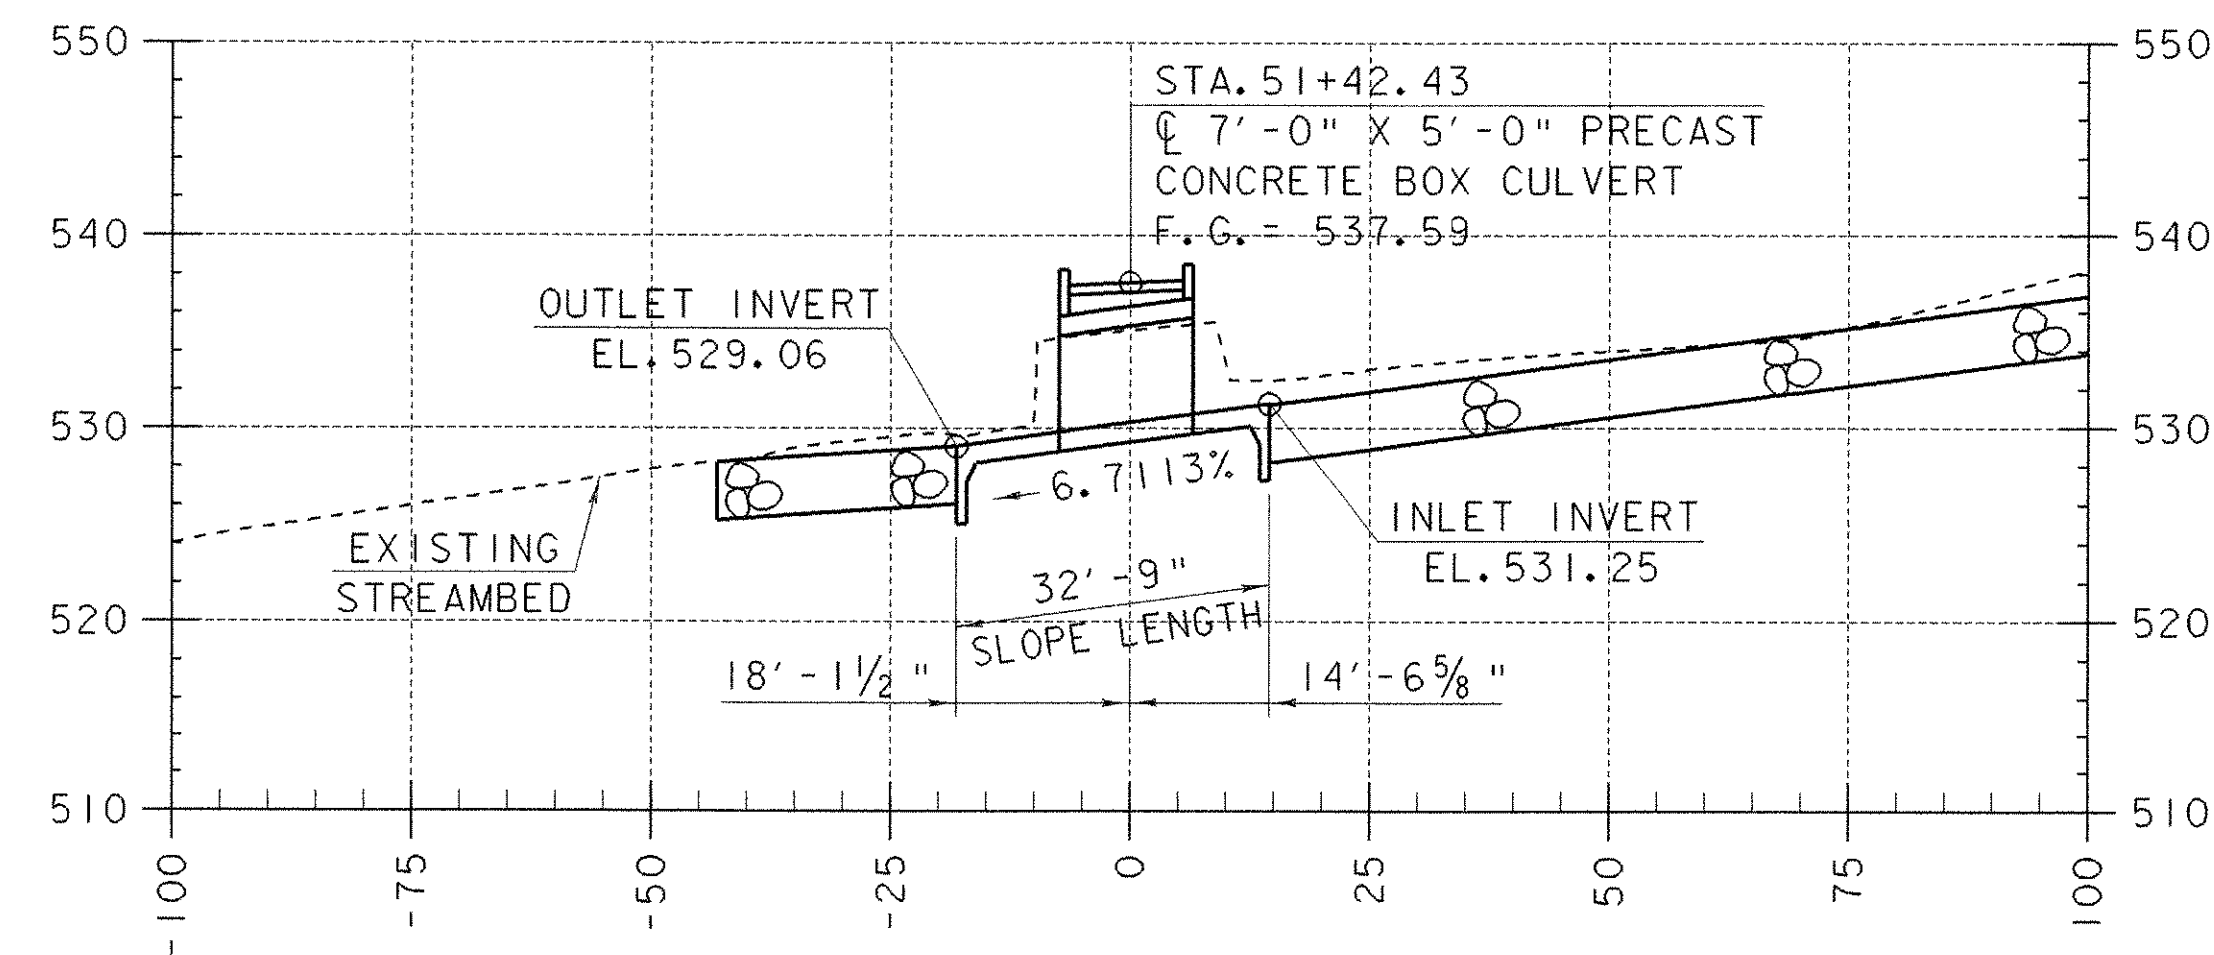

STATE OF VERMONT
AGENCY OF TRANSPORTATION

Town Of FAIRFAX-FAIRFIELD-ST. ALBANS	Bridge No. 87-3 N&S
Highway No. 1-89	Log Sta. Surv. Sta.
1-89 OVER THE RUGG BROOK	
DRIVE PROFILE AND CHANNEL PROFILE	
Designed By G.ROY	Drawn By G.ROY
Checked By M.LOZIER	Bridge Design Supervisor R.R.WHITCOMB
Date 06/00	Date 06/00
PROJECT FAIRFAX-FAIRFIELD-ST. ALBANS	PROJECT NO. 1M 089 - 3 (27)
L.G.C. Info. 96a056\structures\so056\sa4.dgn	so056p02.i
Bridge Sheet No. BR308	Sheet 134 of 370