
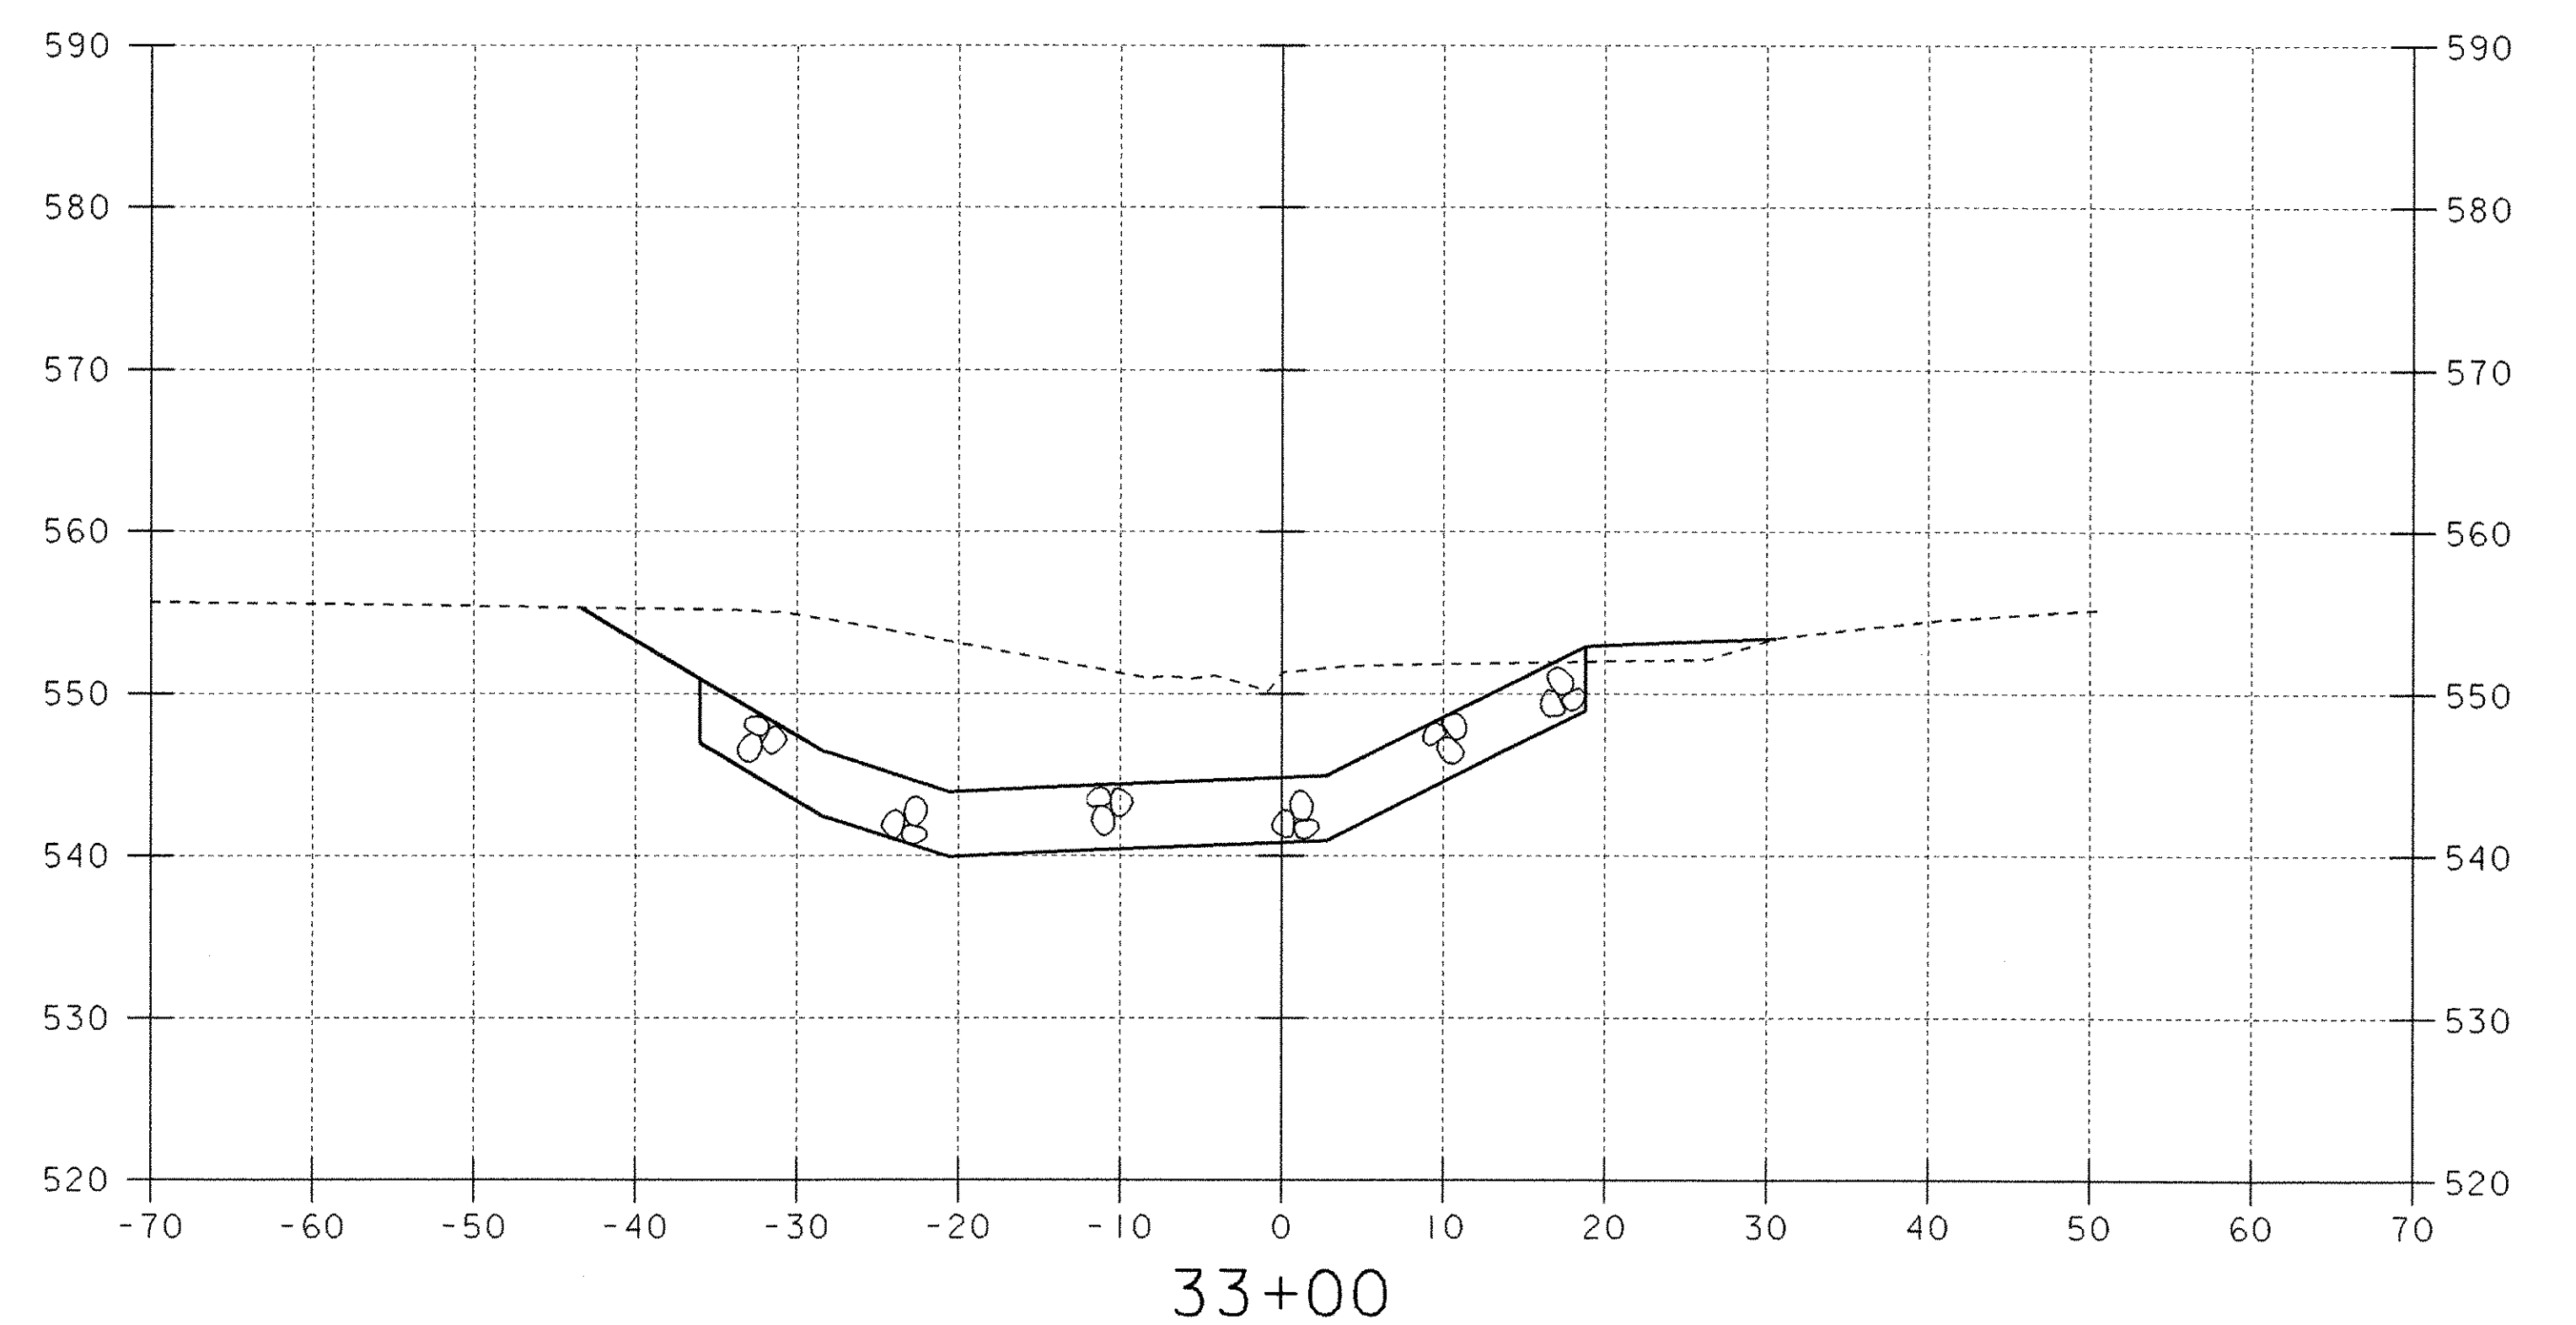
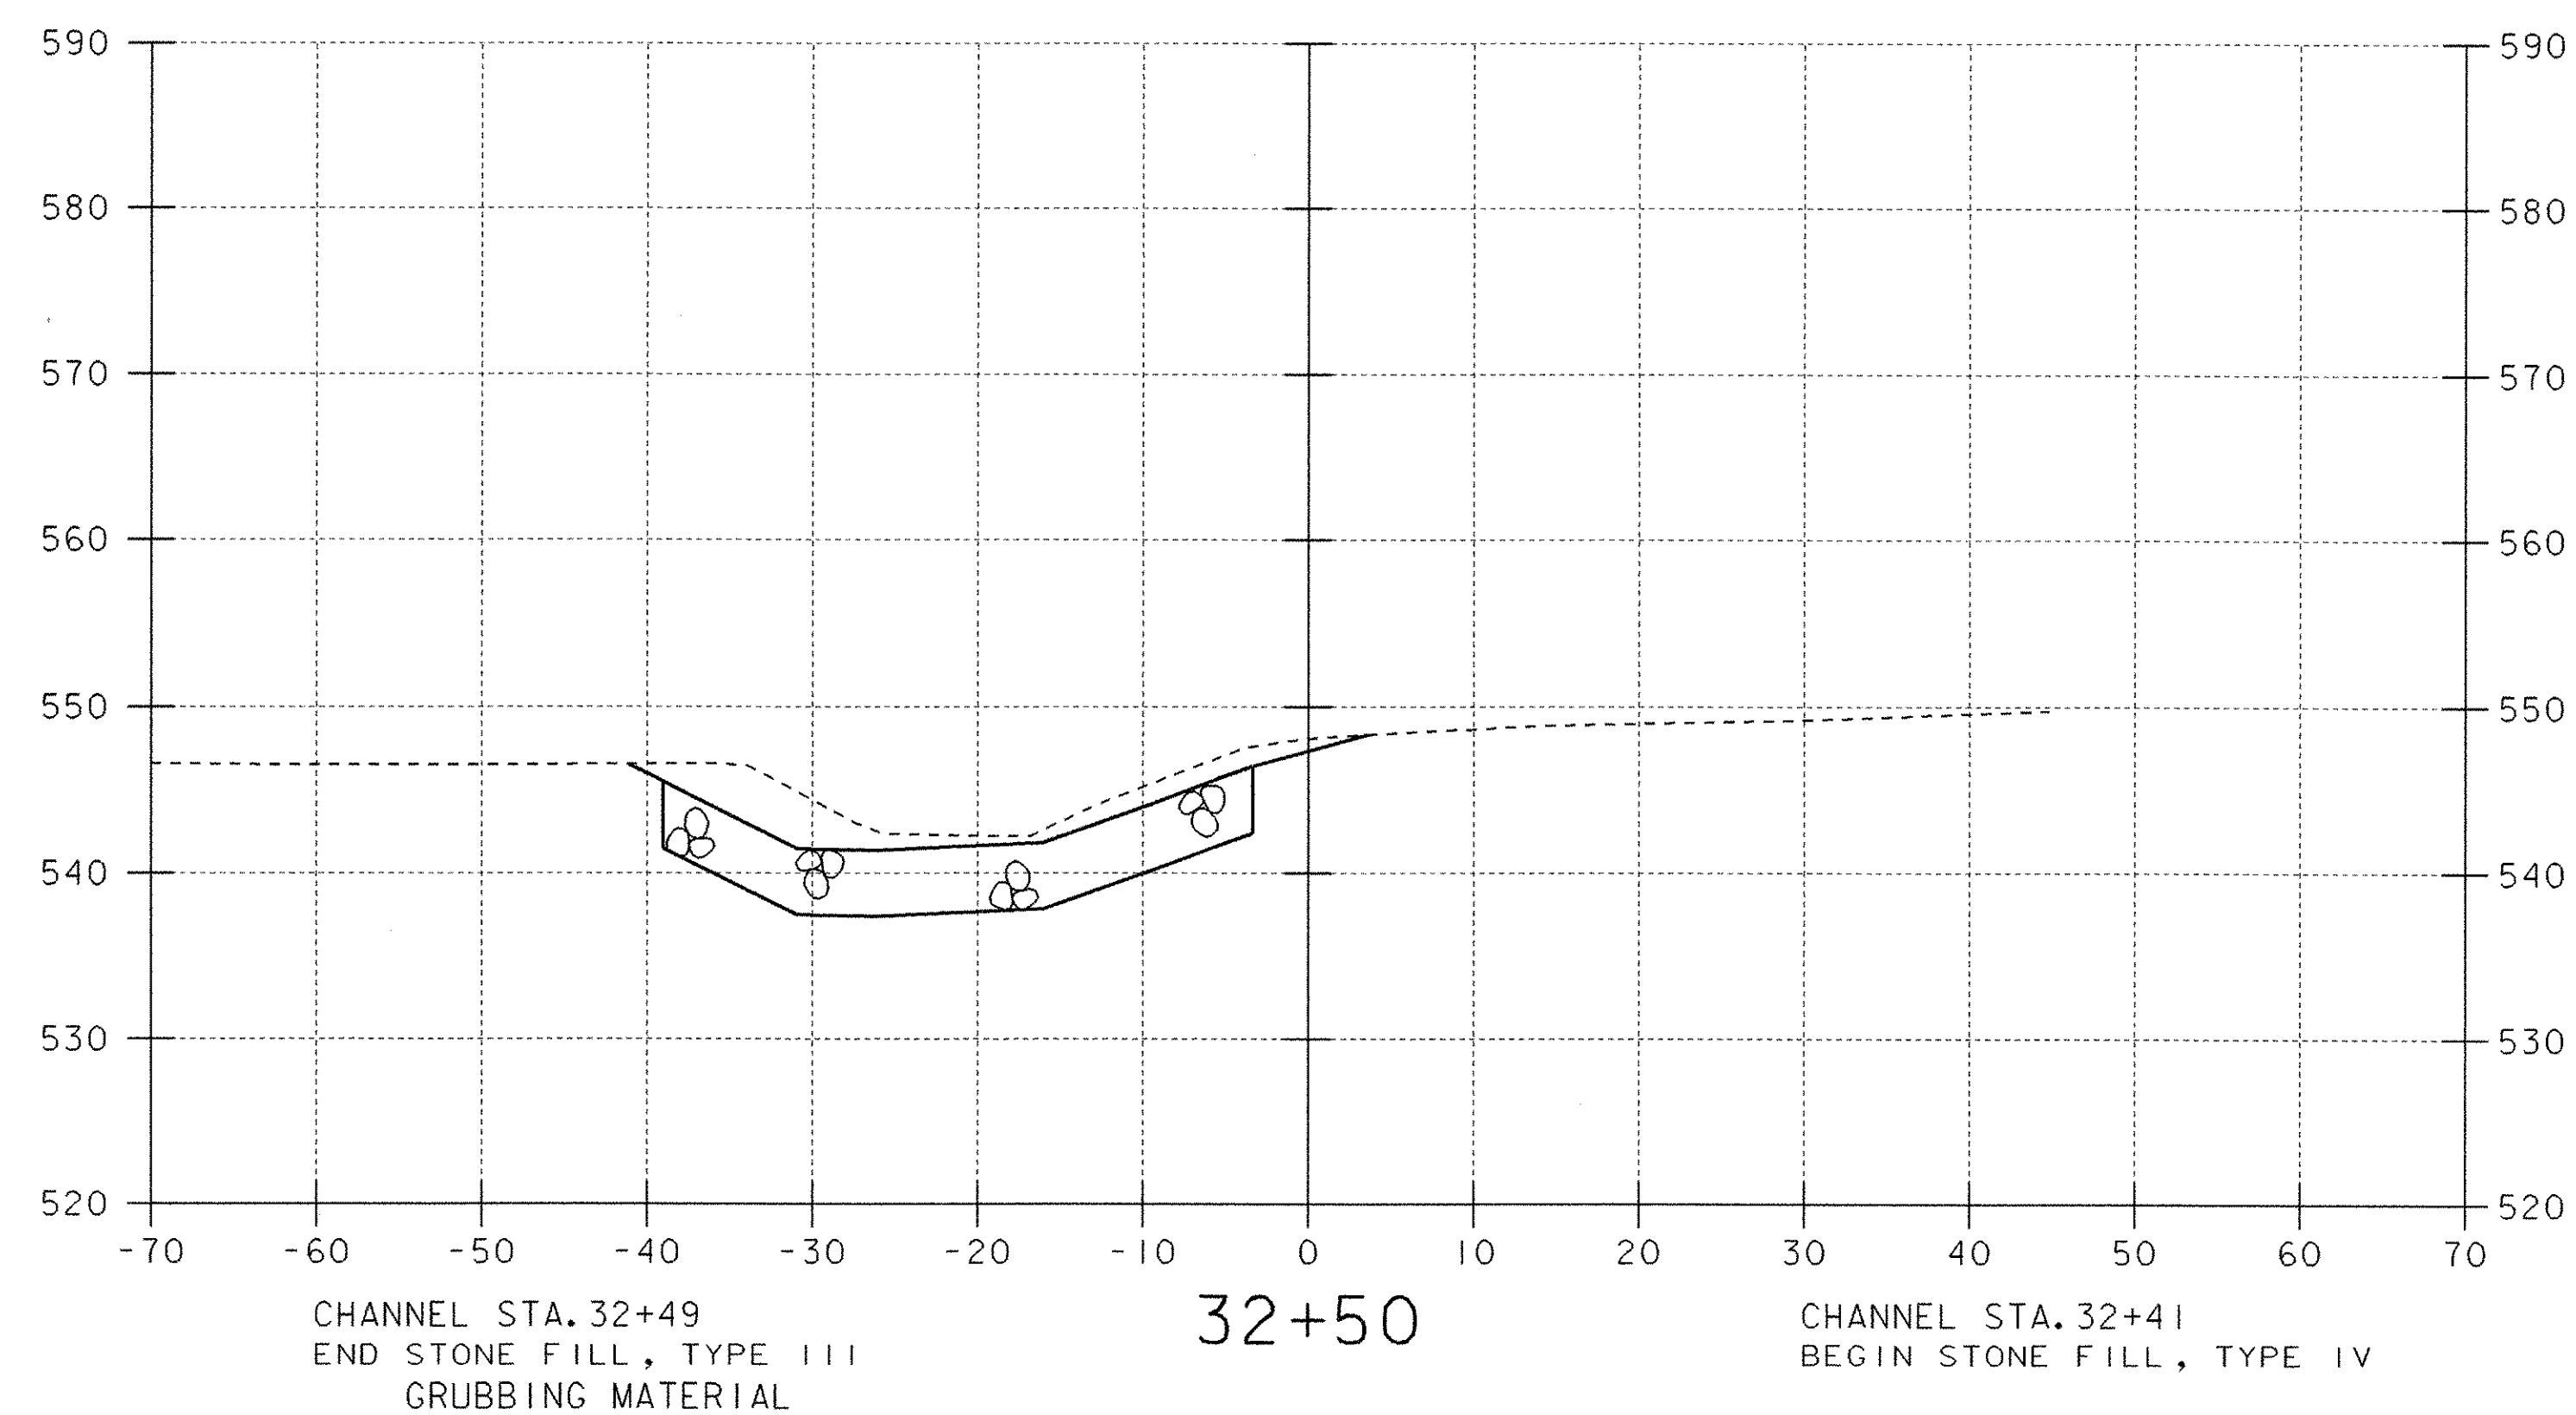
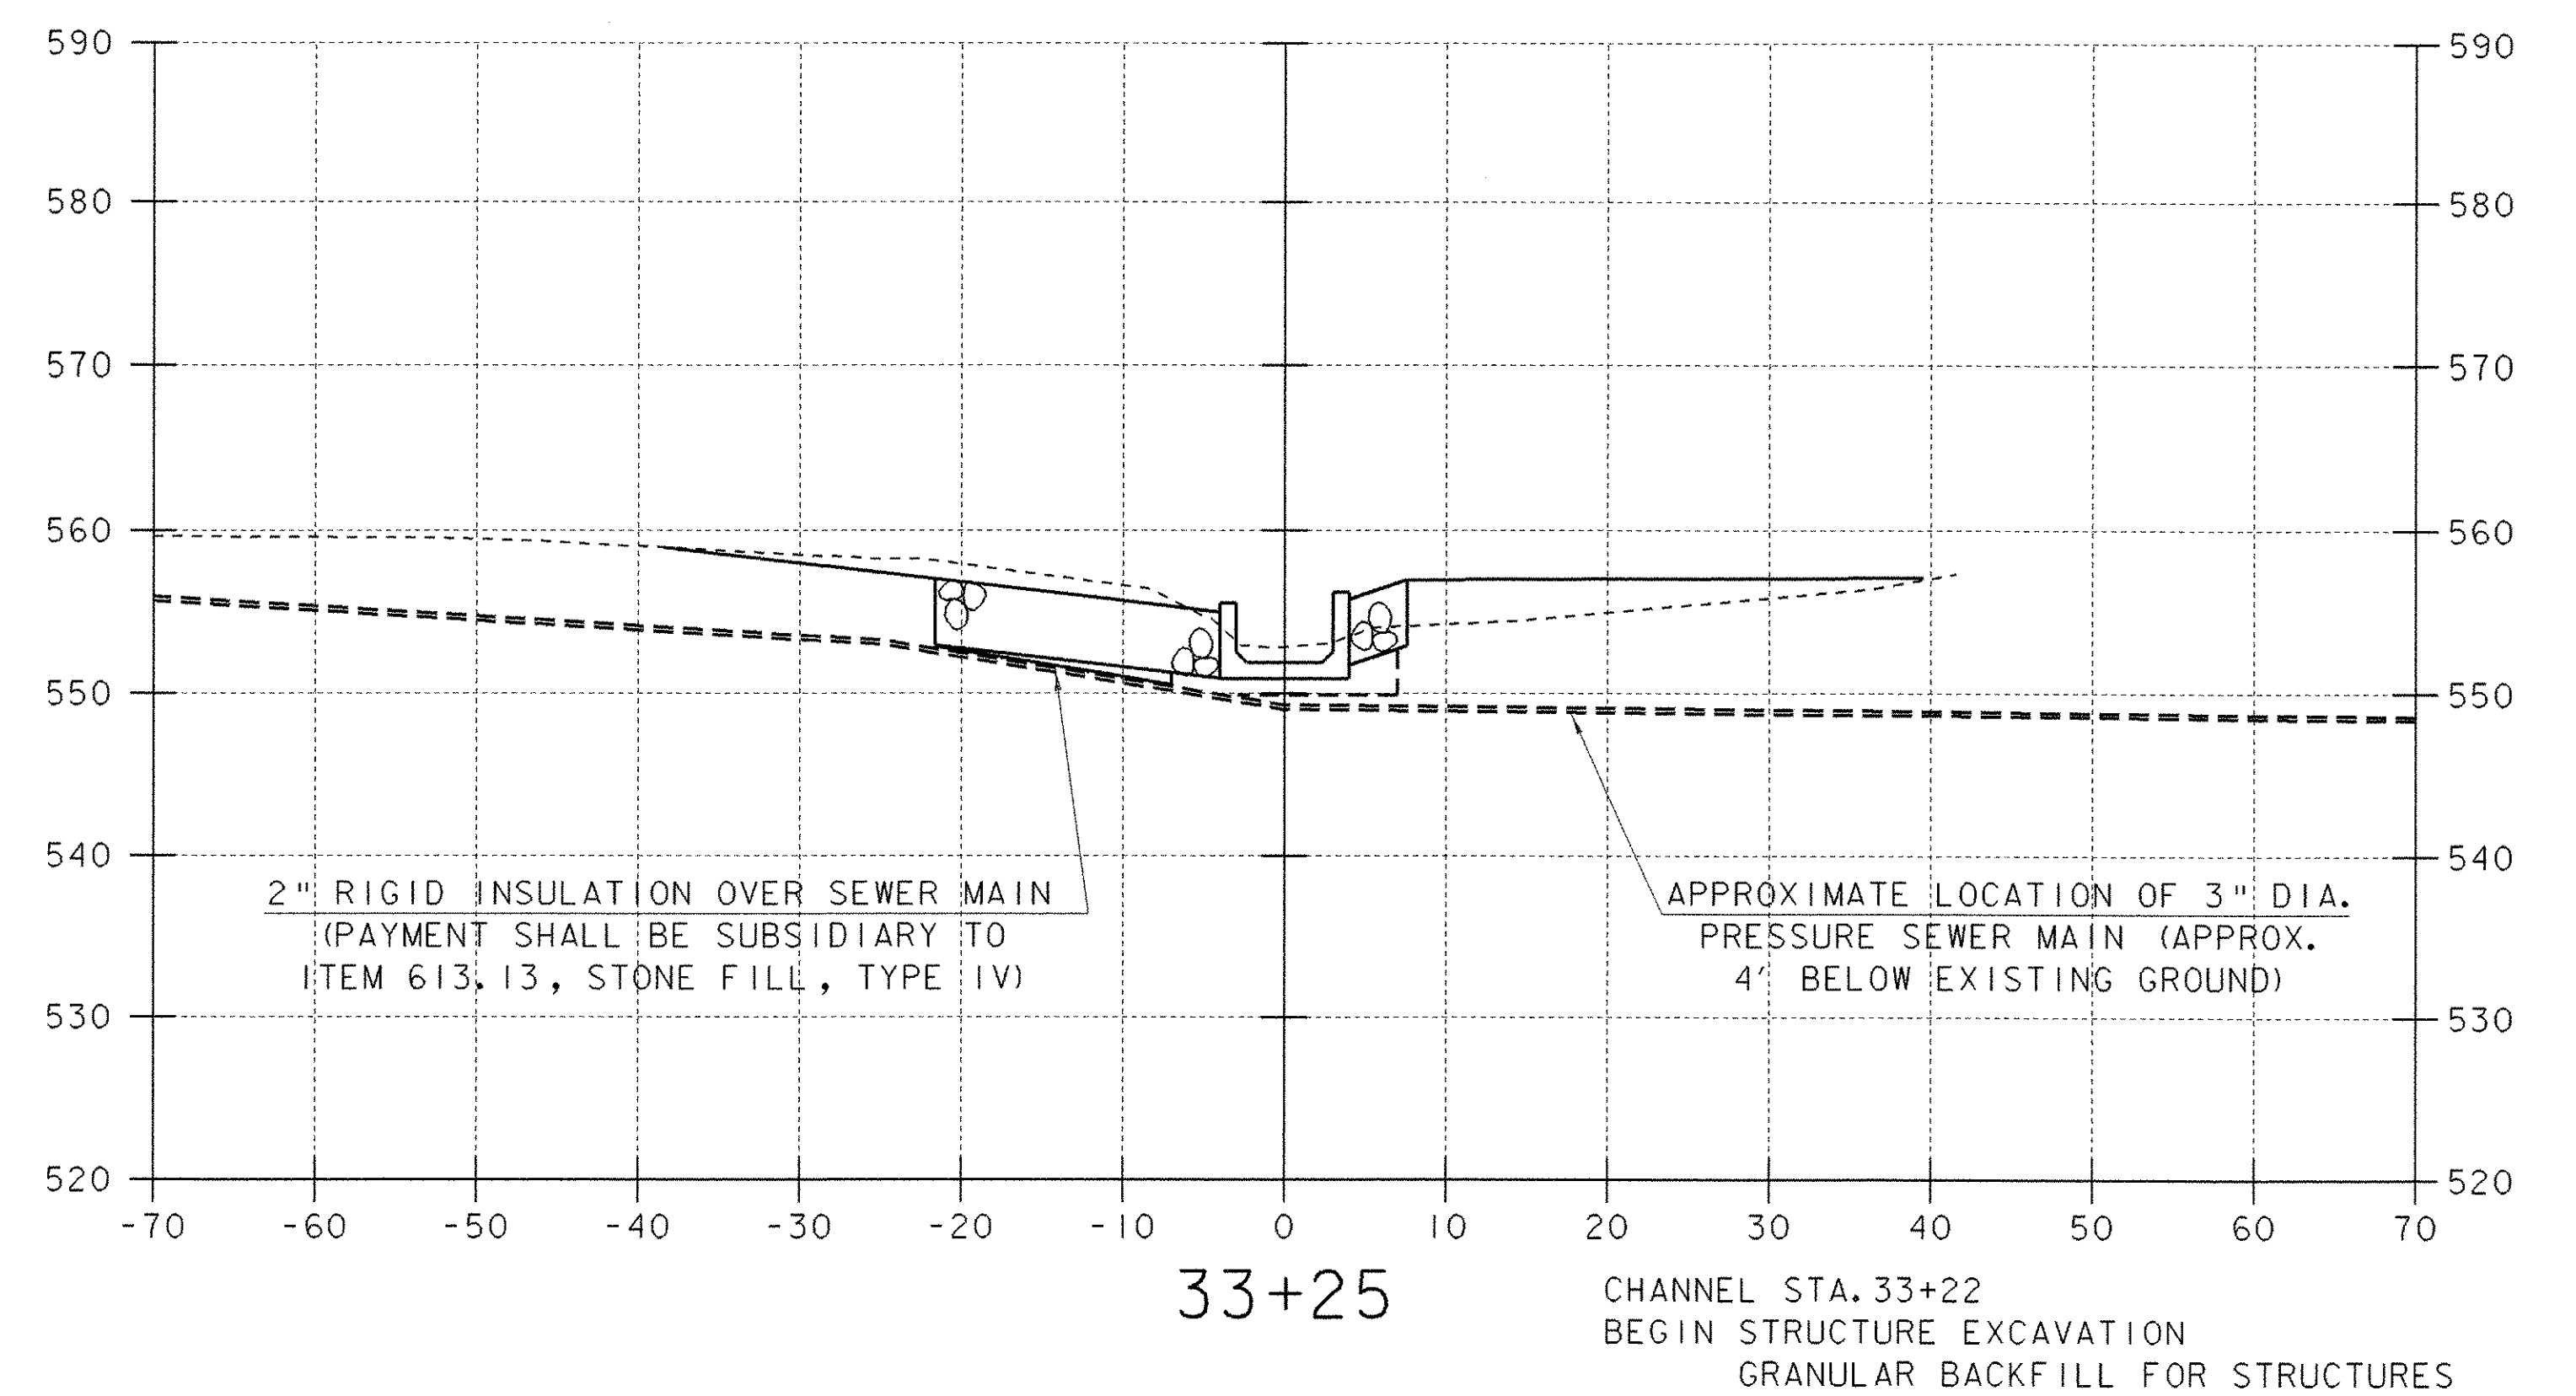


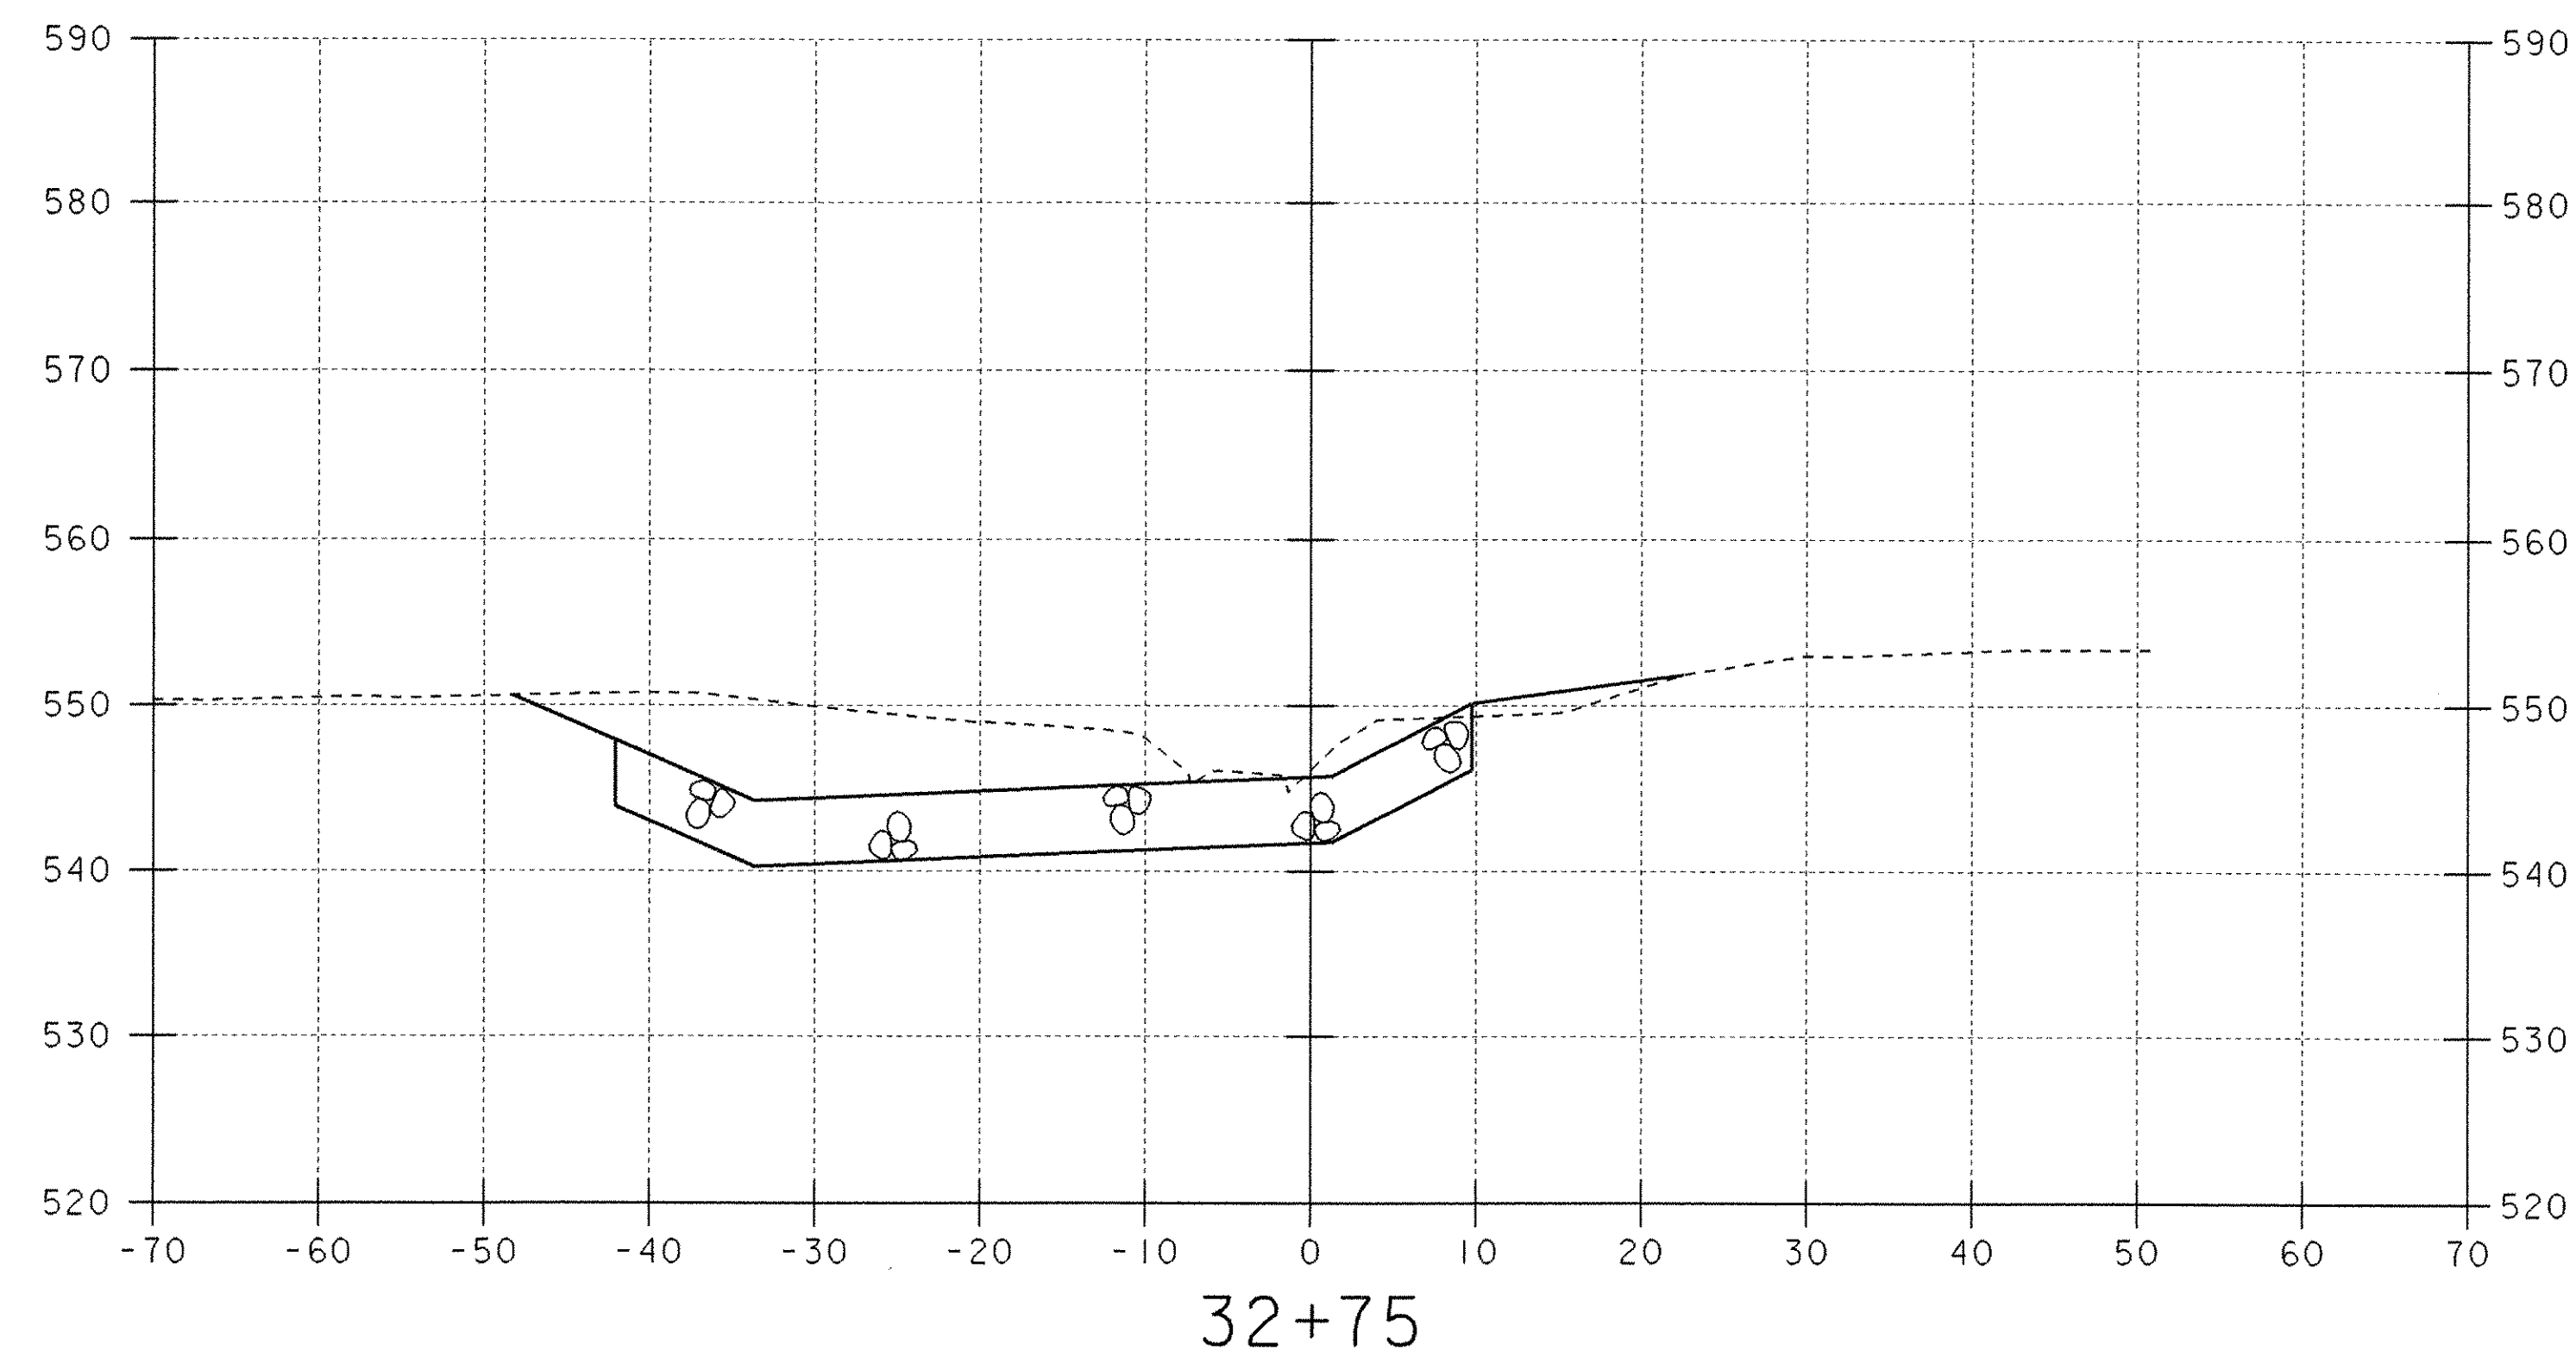

DATUM
VERTICAL _____
HORIZONTAL _____

SCALE 1" = 10'-0"
10 0 10

PROJECT: FAIRFAX-FAIRFIELD-ST. ALBANS	PROJECT NO.: IM 089-3 (27)
DESIGN FILE NAME: \96a056\Structures\sa056xs4.dgn	PLOT DATE: 21-SEP-2000
IPARM FILE NAME: sa056c04.i	BRIDGE SHEET BR319
CHANNEL CROSS SECTIONS (3)	SHEET: 145 OF 370
STA. 32+50 TO STA. 33+25	