

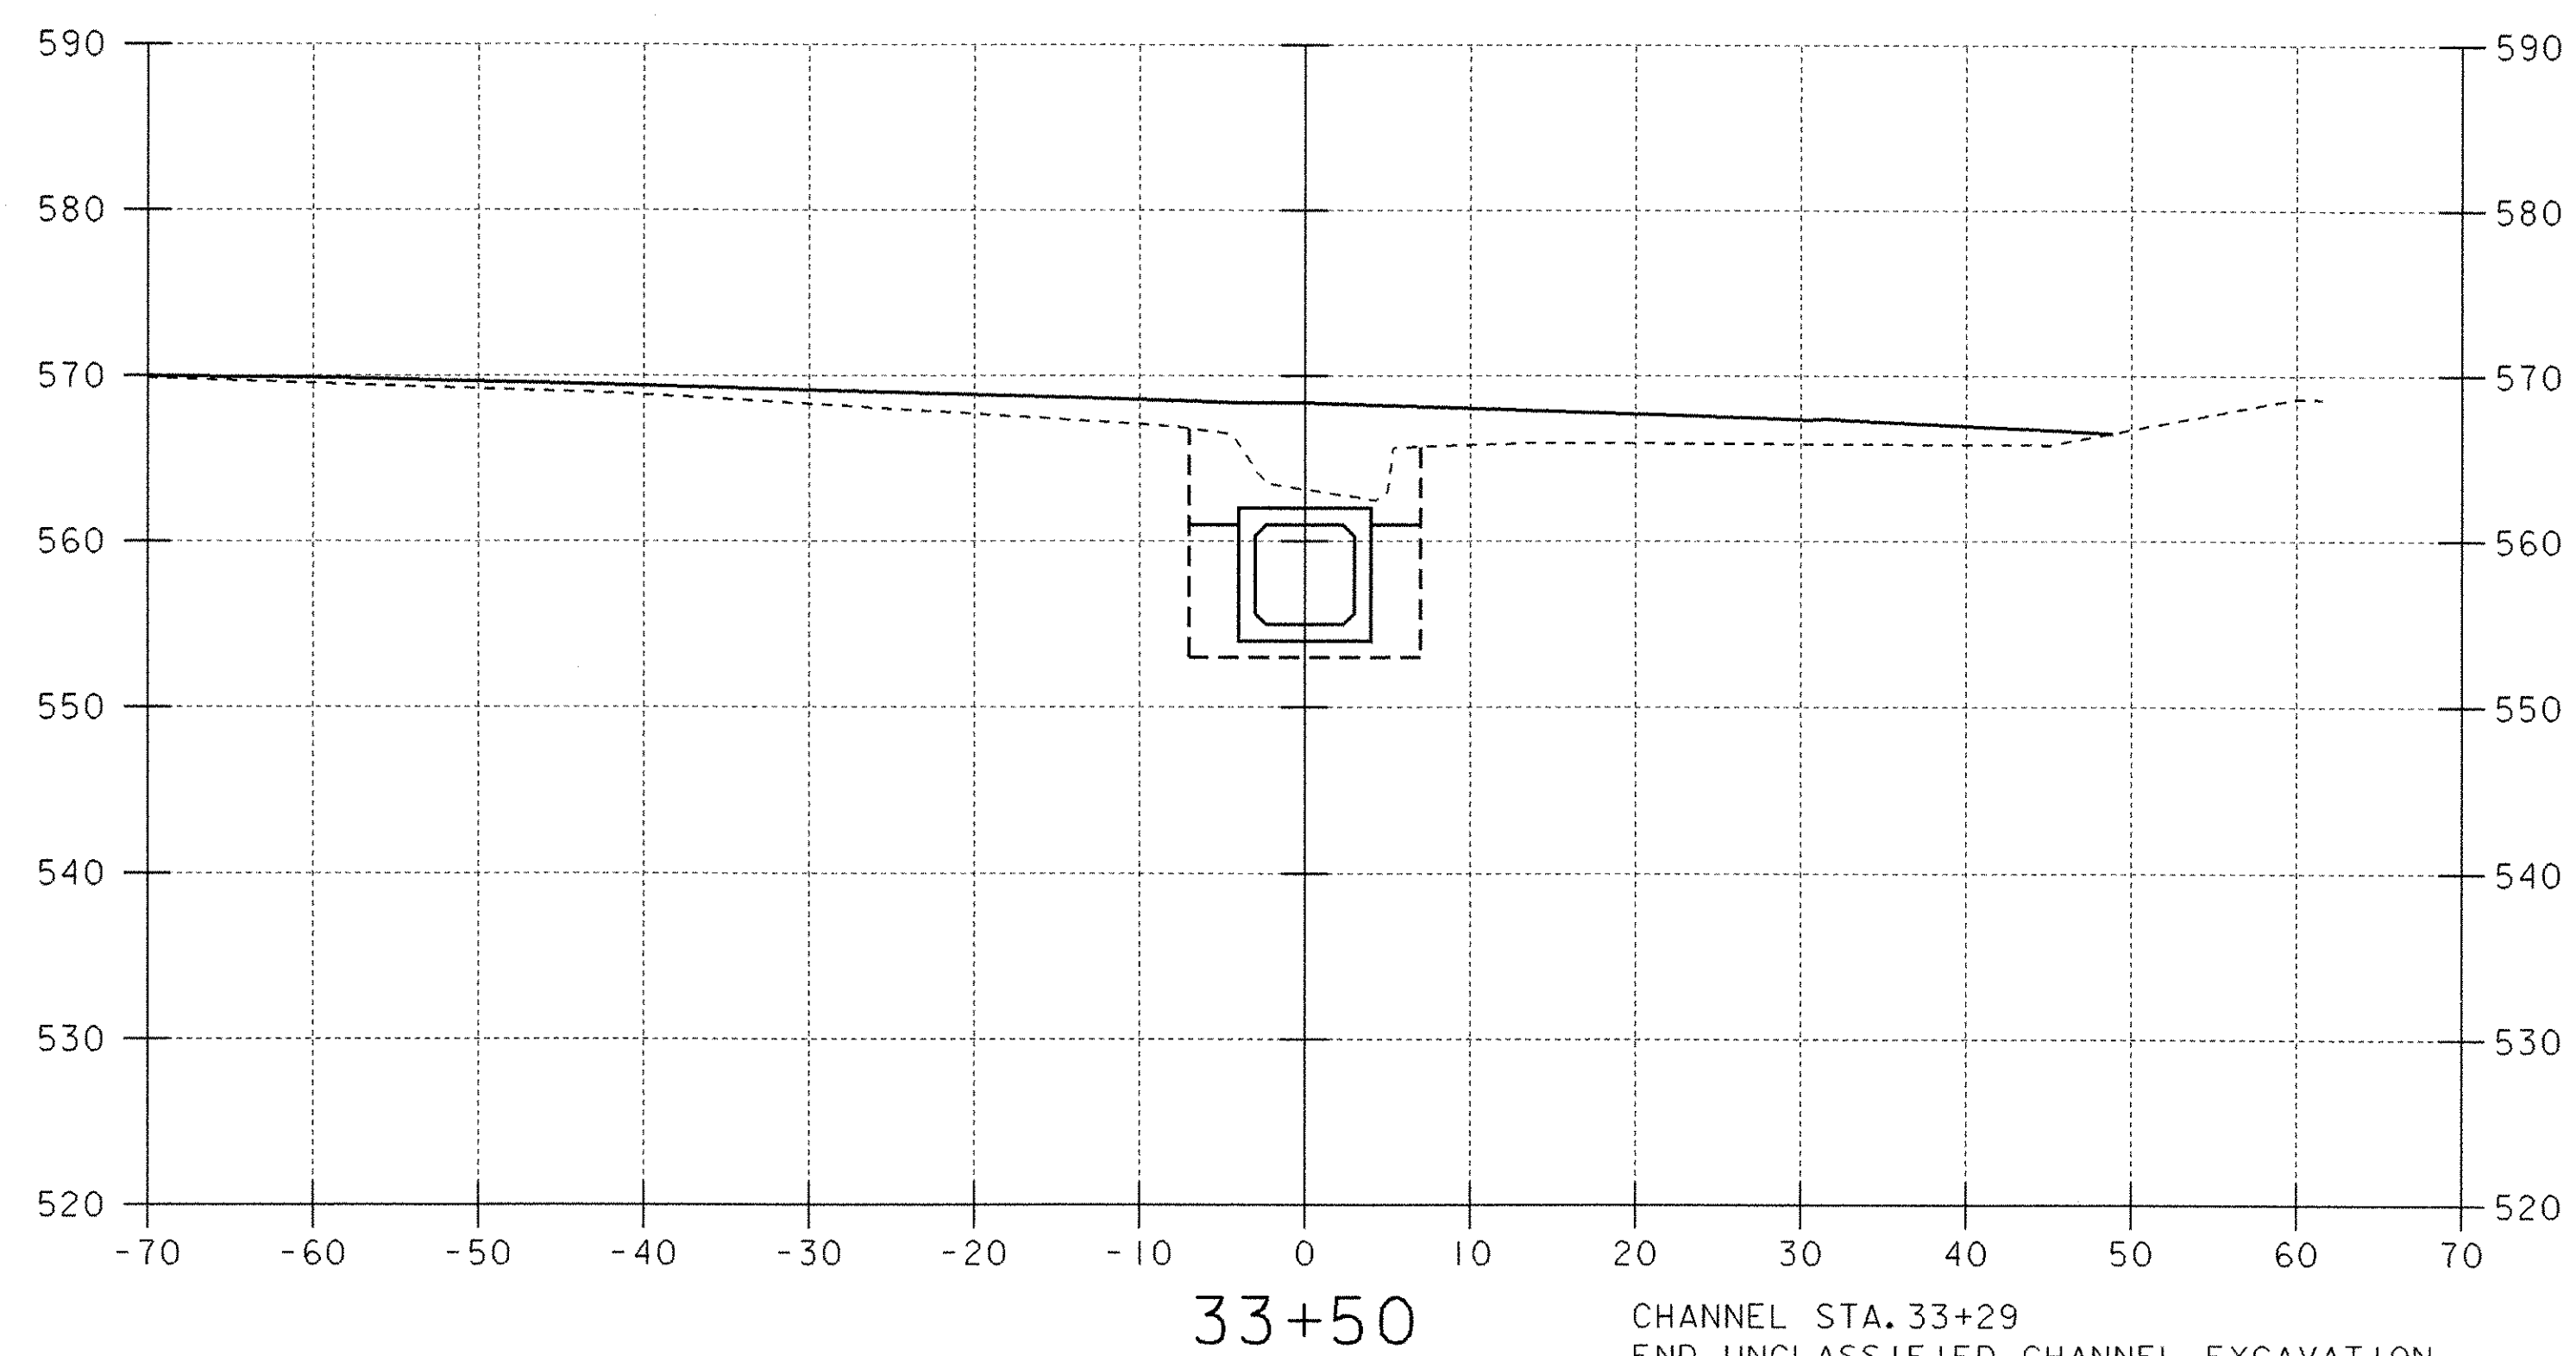
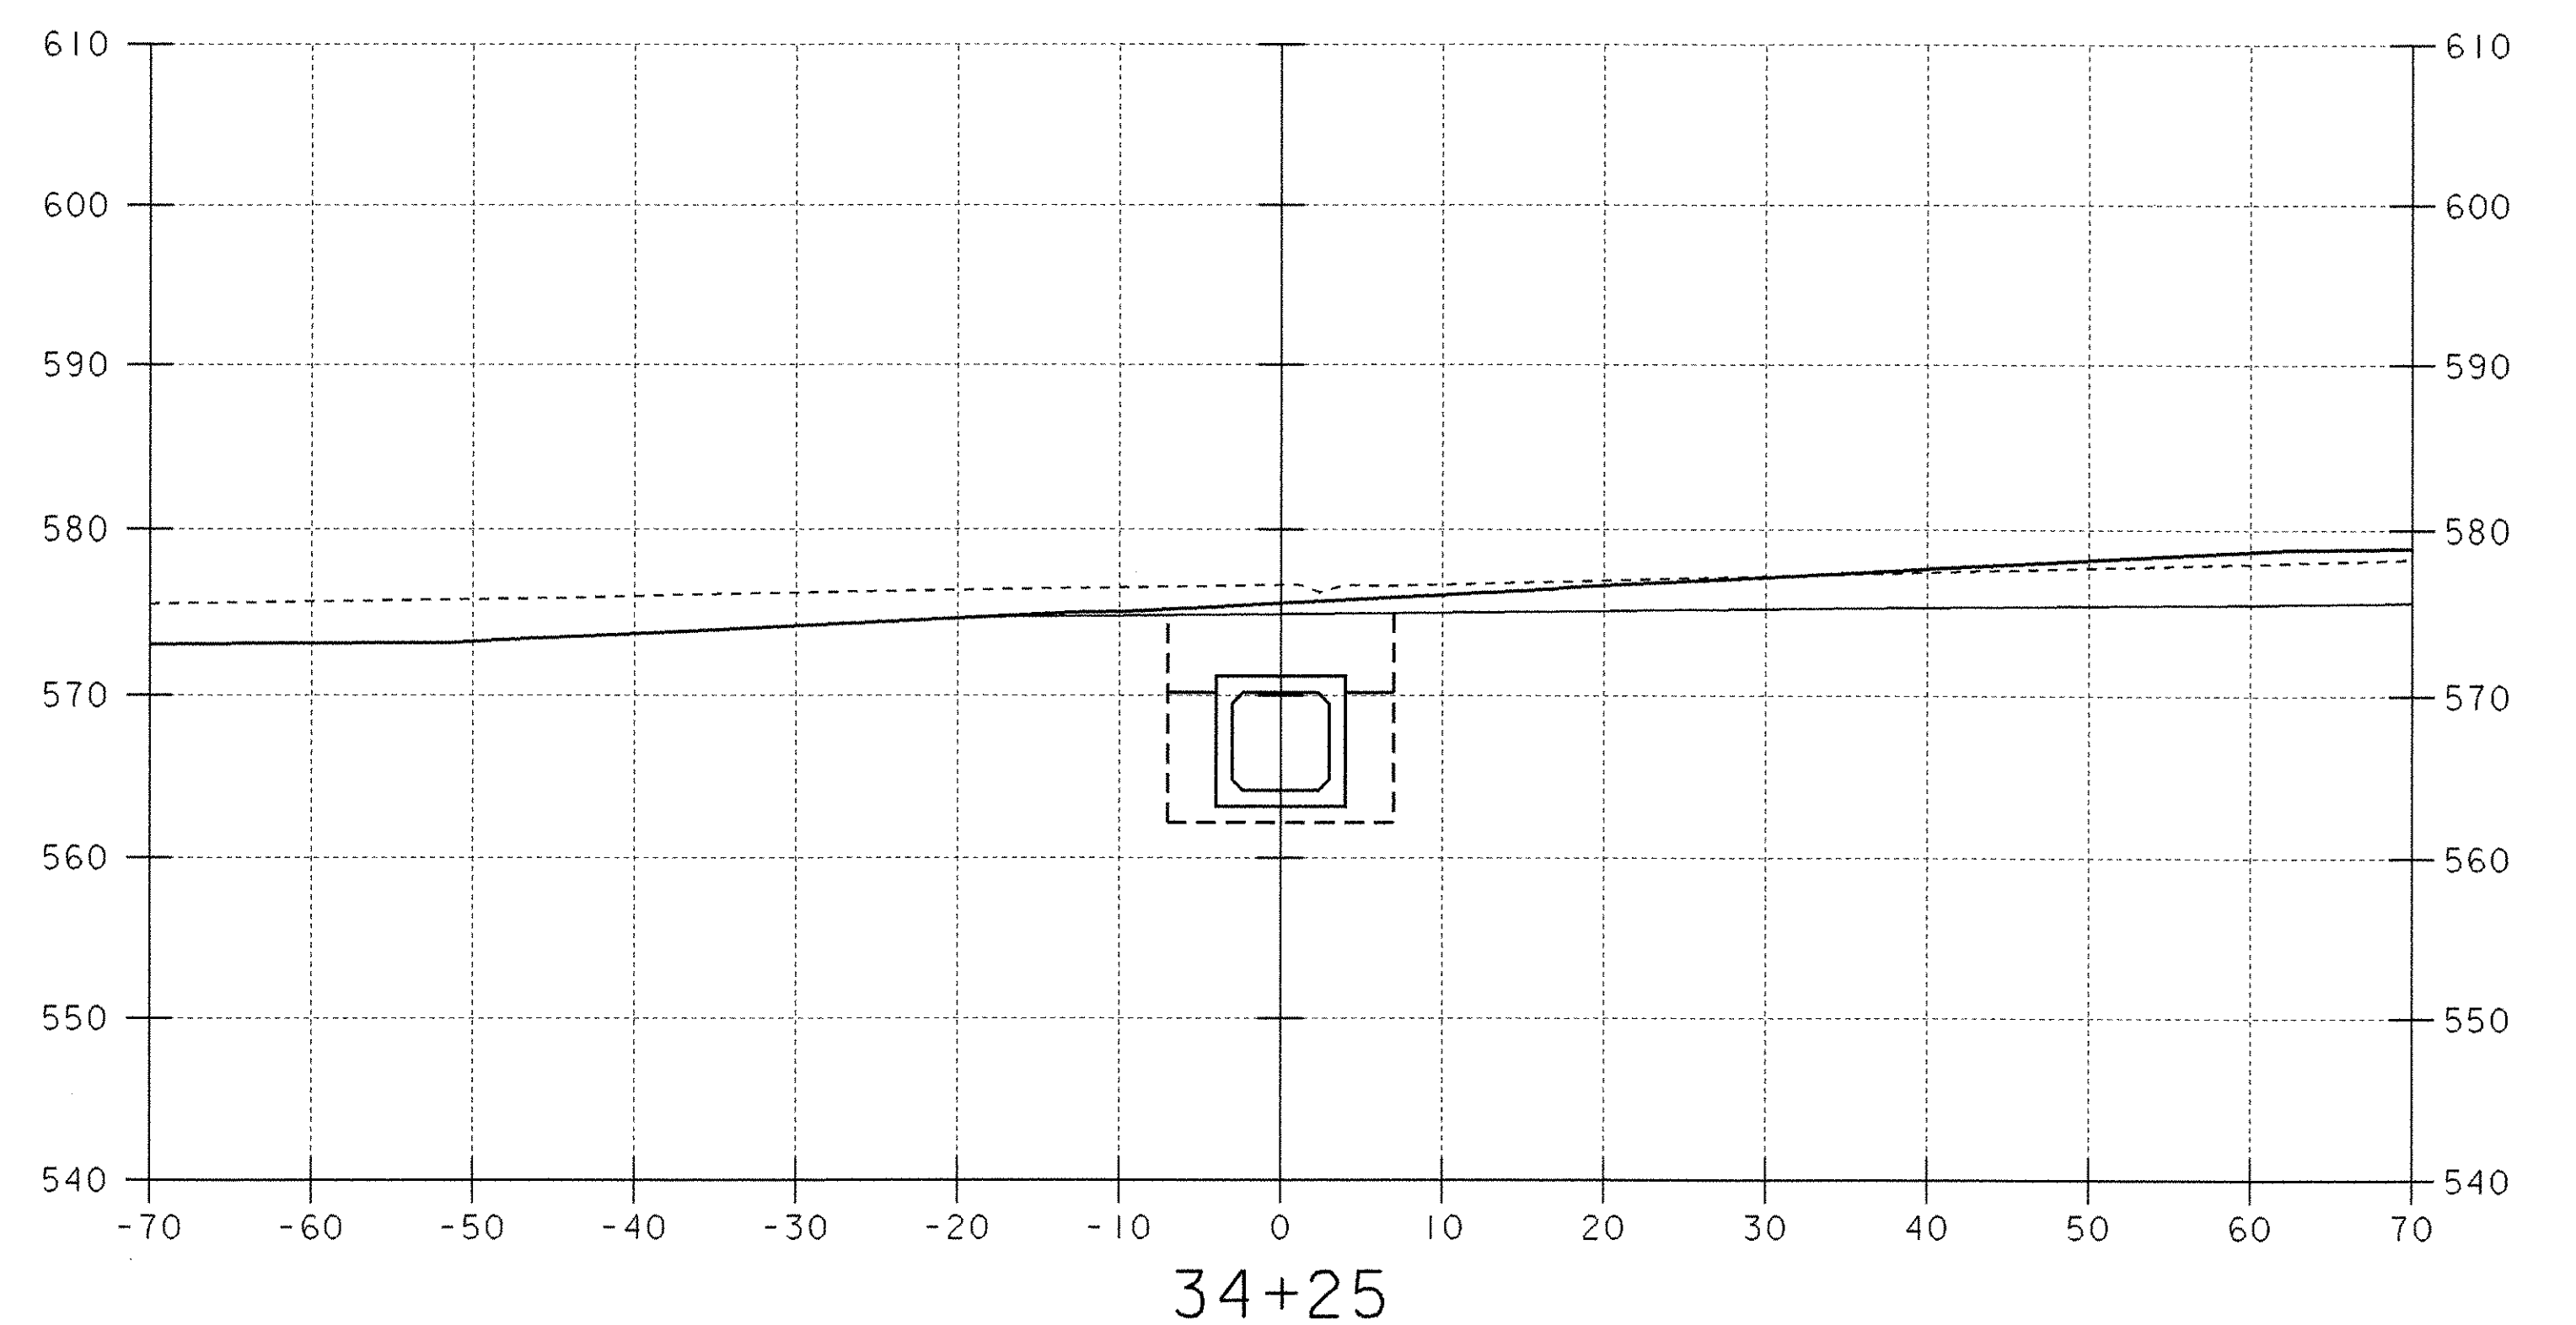


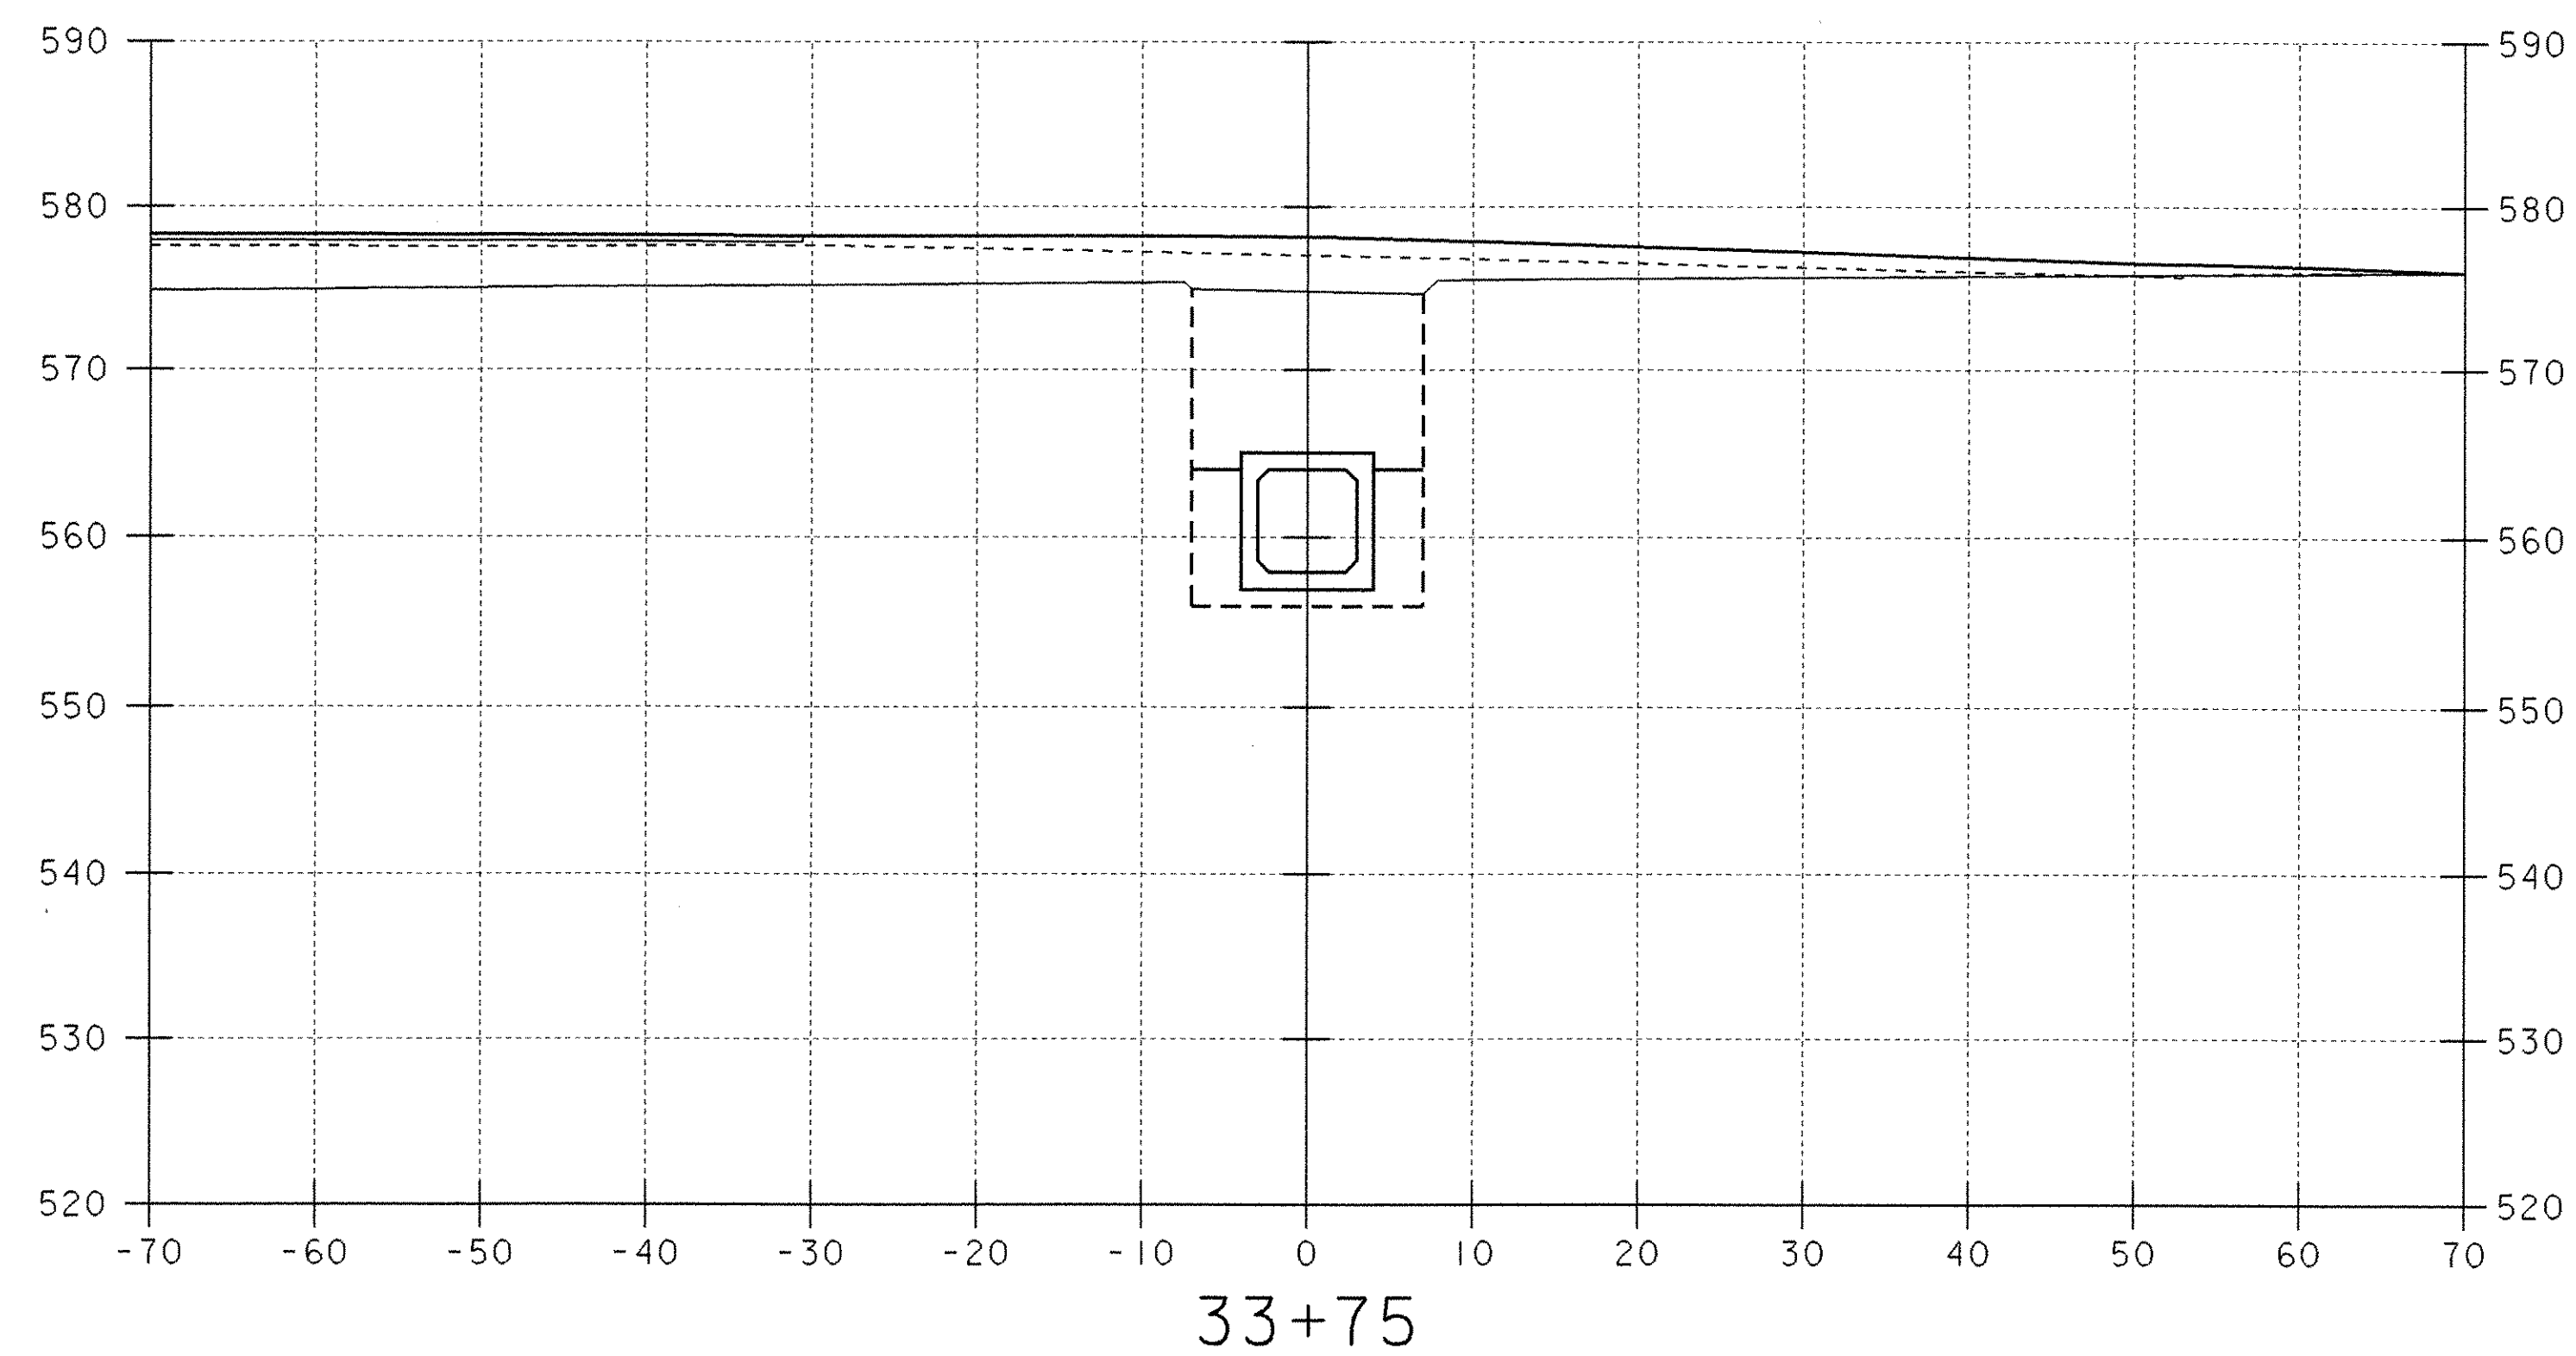

CHANNEL STA. 33+29
END UNCLASSIFIED CHANNEL EXCAVATION
GEOTEXTILE UNDER STONE FILL
STONE FILL, TYPE IV

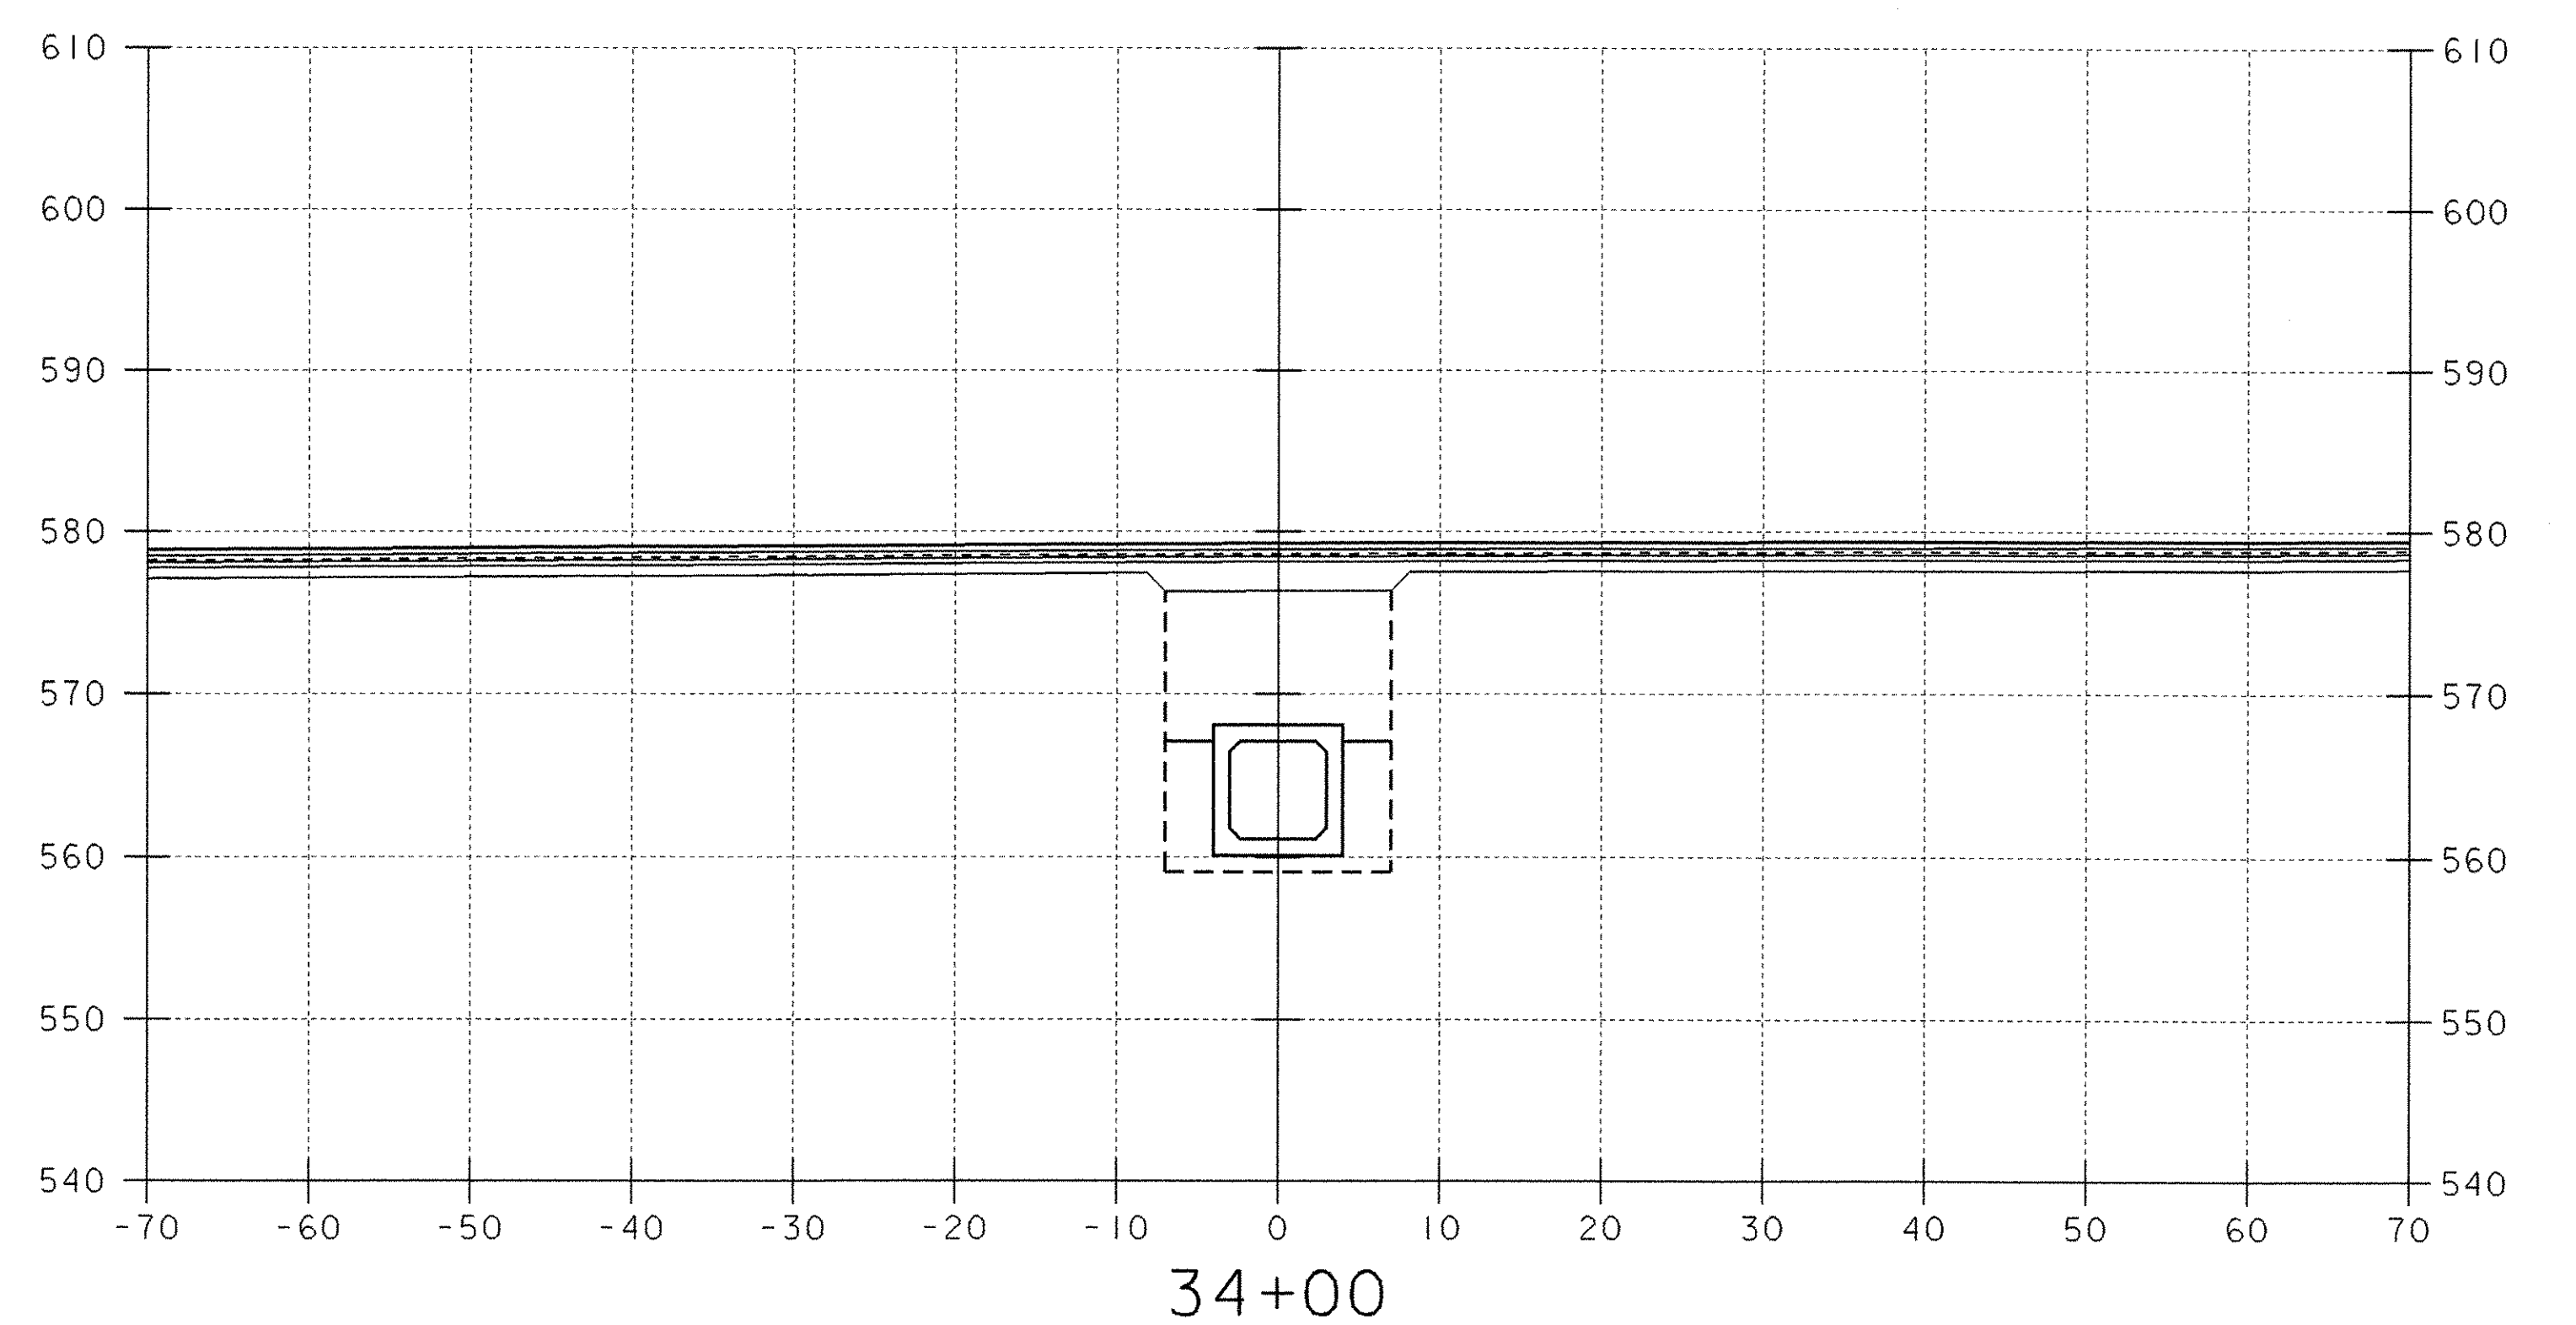

DATUM
VERTICAL _____
HORIZONTAL _____

SCALE 1" = 10'-0"
10 0 10

PROJECT: FAIRFAX-FAIRFIELD-ST. ALBANS	PROJECT NO.: IM 089-3 (27)
DESIGN FILE NAME: \96a056\Structures\sa056xs4.dgn	PLOT DATE: 21-SEP-2000
IPARM FILE NAME: sa056c05.i	BRIDGE SHEET BR320
CHANNEL CROSS SECTIONS (4)	SHEET: 146 OF 370
STA. 33+50 TO STA. 34+25	