


CHANNEL STA. 36+53
 END UNCLASSIFIED CHANNEL EXCAVATION
 GEOTEXTILE UNDER STONE FILL
 STONE FILL, TYPE III
 GRUBBING MATERIAL

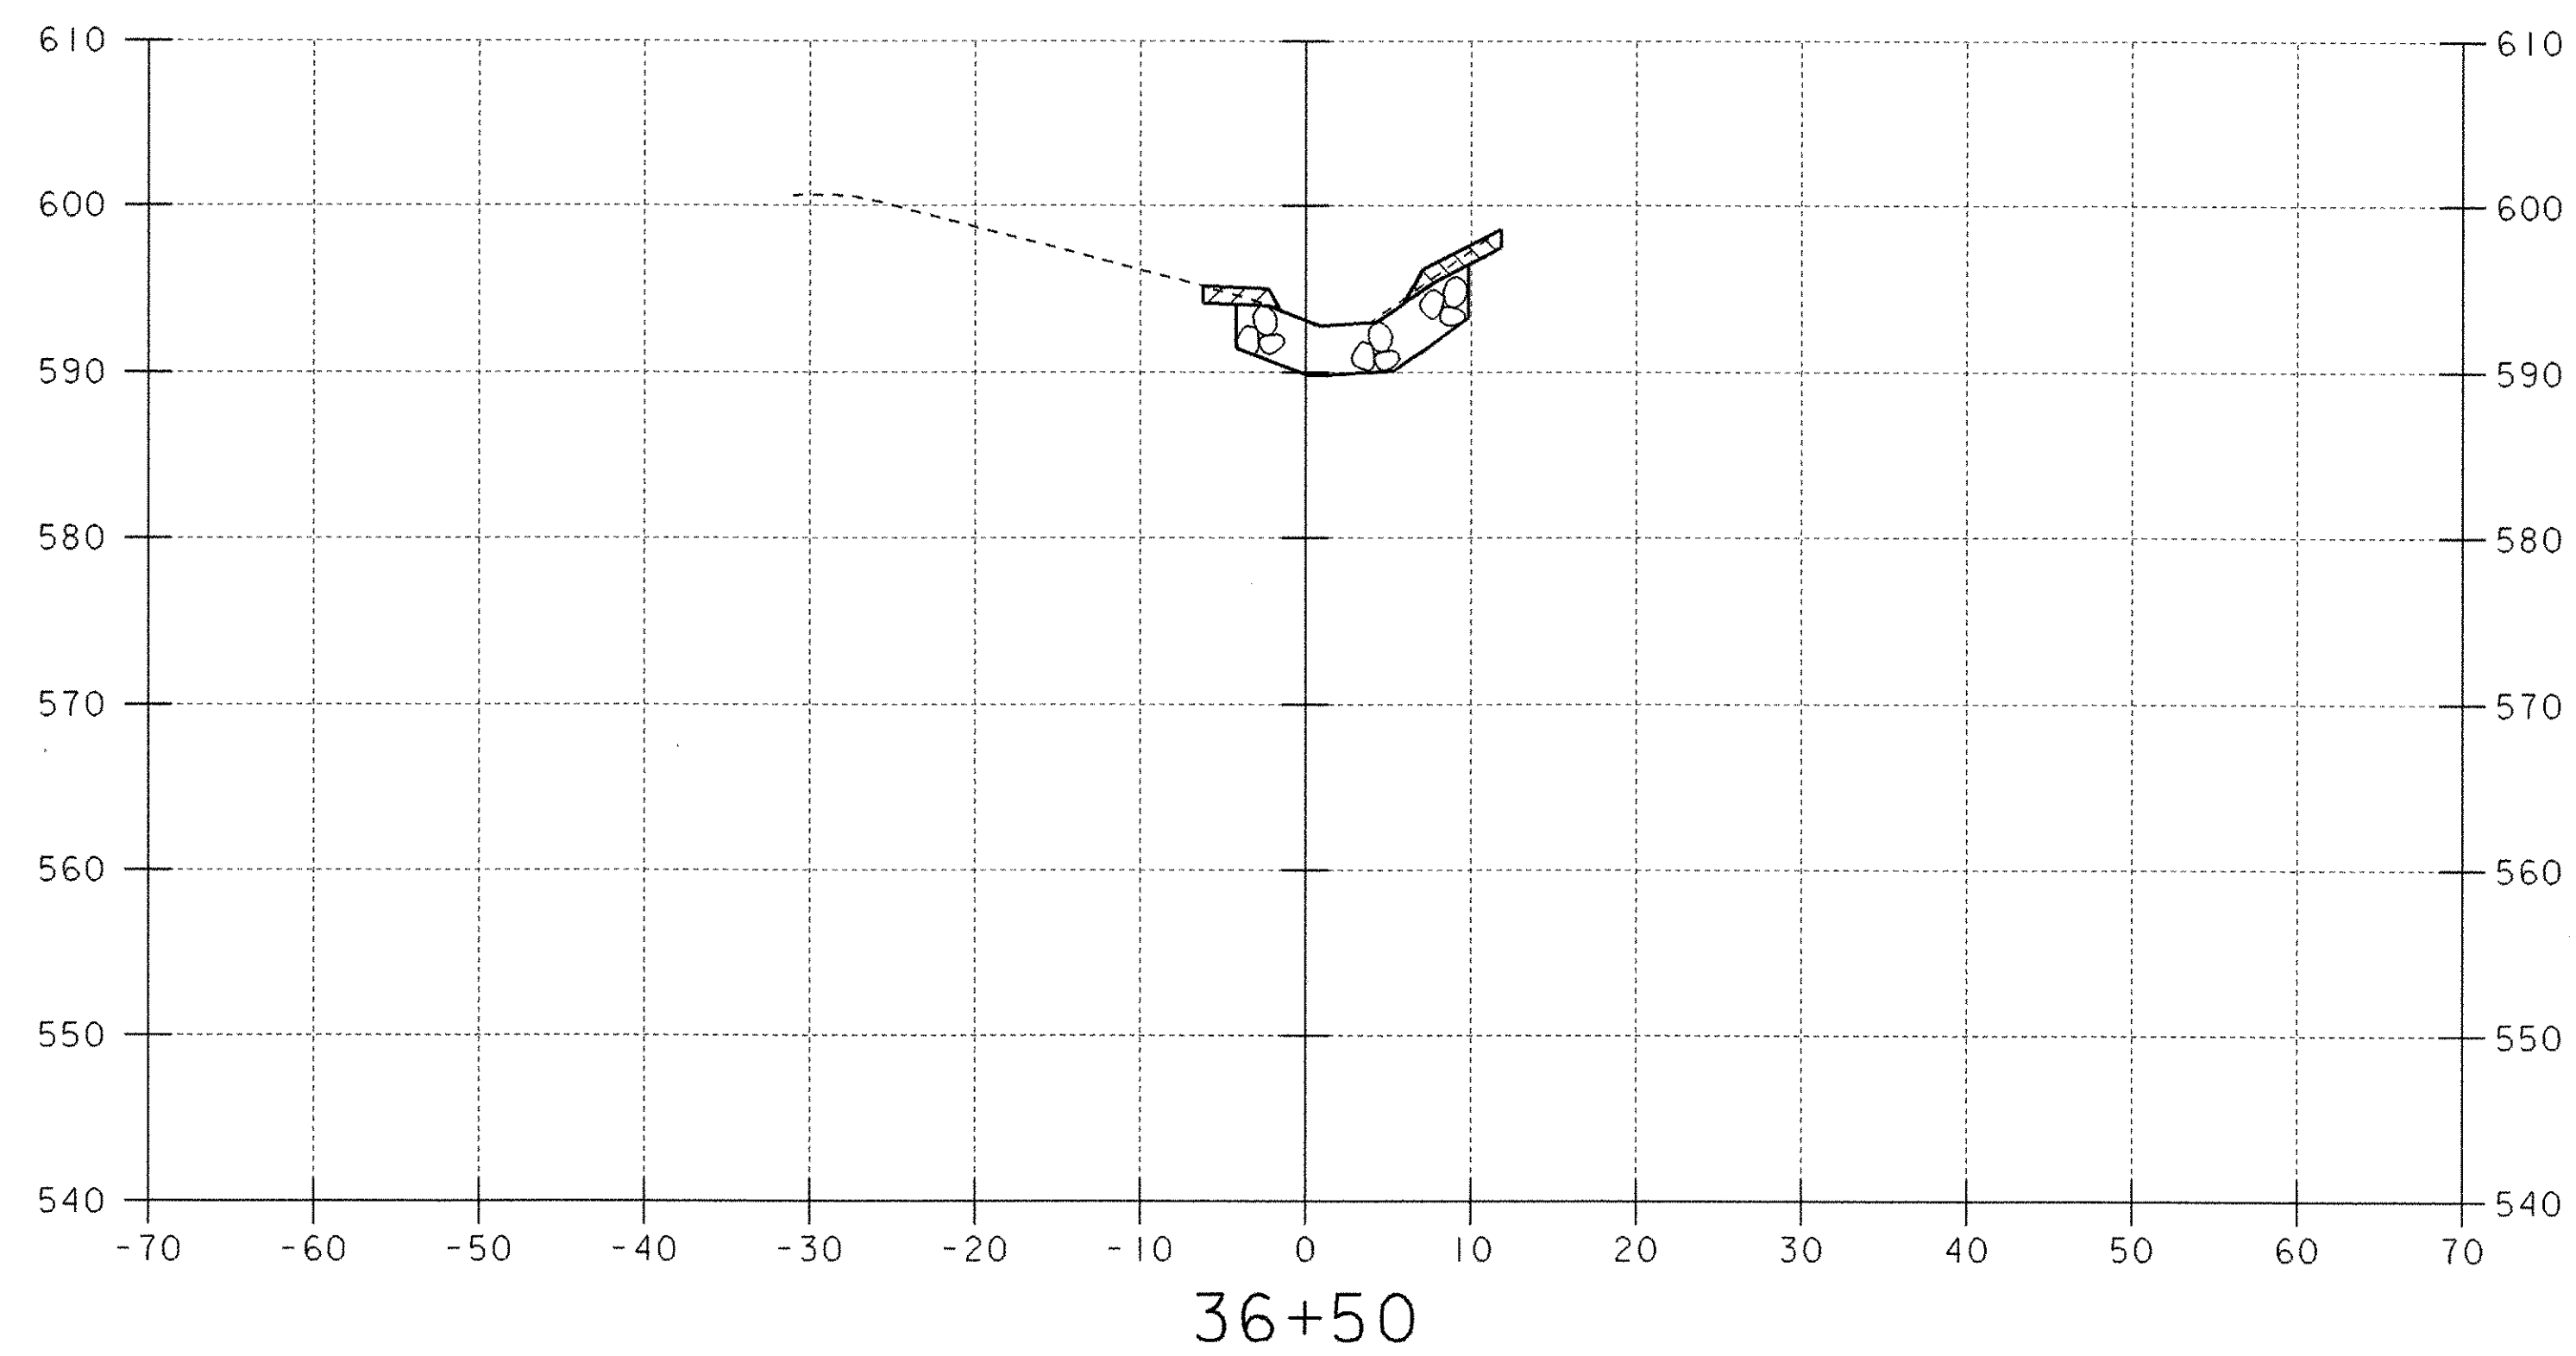

SCALE 1" = 10'-0"
 10 0 10

DATUM	
VERTICAL	_____
HORIZONTAL	_____

PROJECT: FAIRFAX-FAIRFIELD-ST. ALBANS	PROJECT NO.: IM 089-3 (27)
DESIGN FILE NAME: \96a056\Structures\sa056xs4.dgn	PLOT DATE: 21-SEP-2000
IPARM FILE NAME: sa056c08.i	BRIDGE SHEET BR323
CHANNEL CROSS SECTIONS (7)	SHEET: 149 OF 370
STA. 36+50	