




PIER DIAPHRAGM PLAN
SCALE 1" = 1'-0"

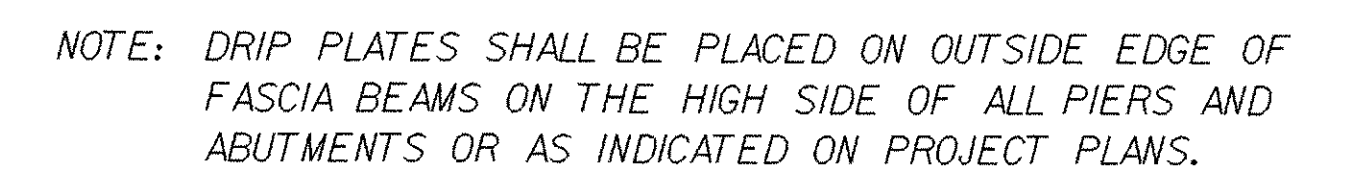

PLOTTED 21-SEP-2000