



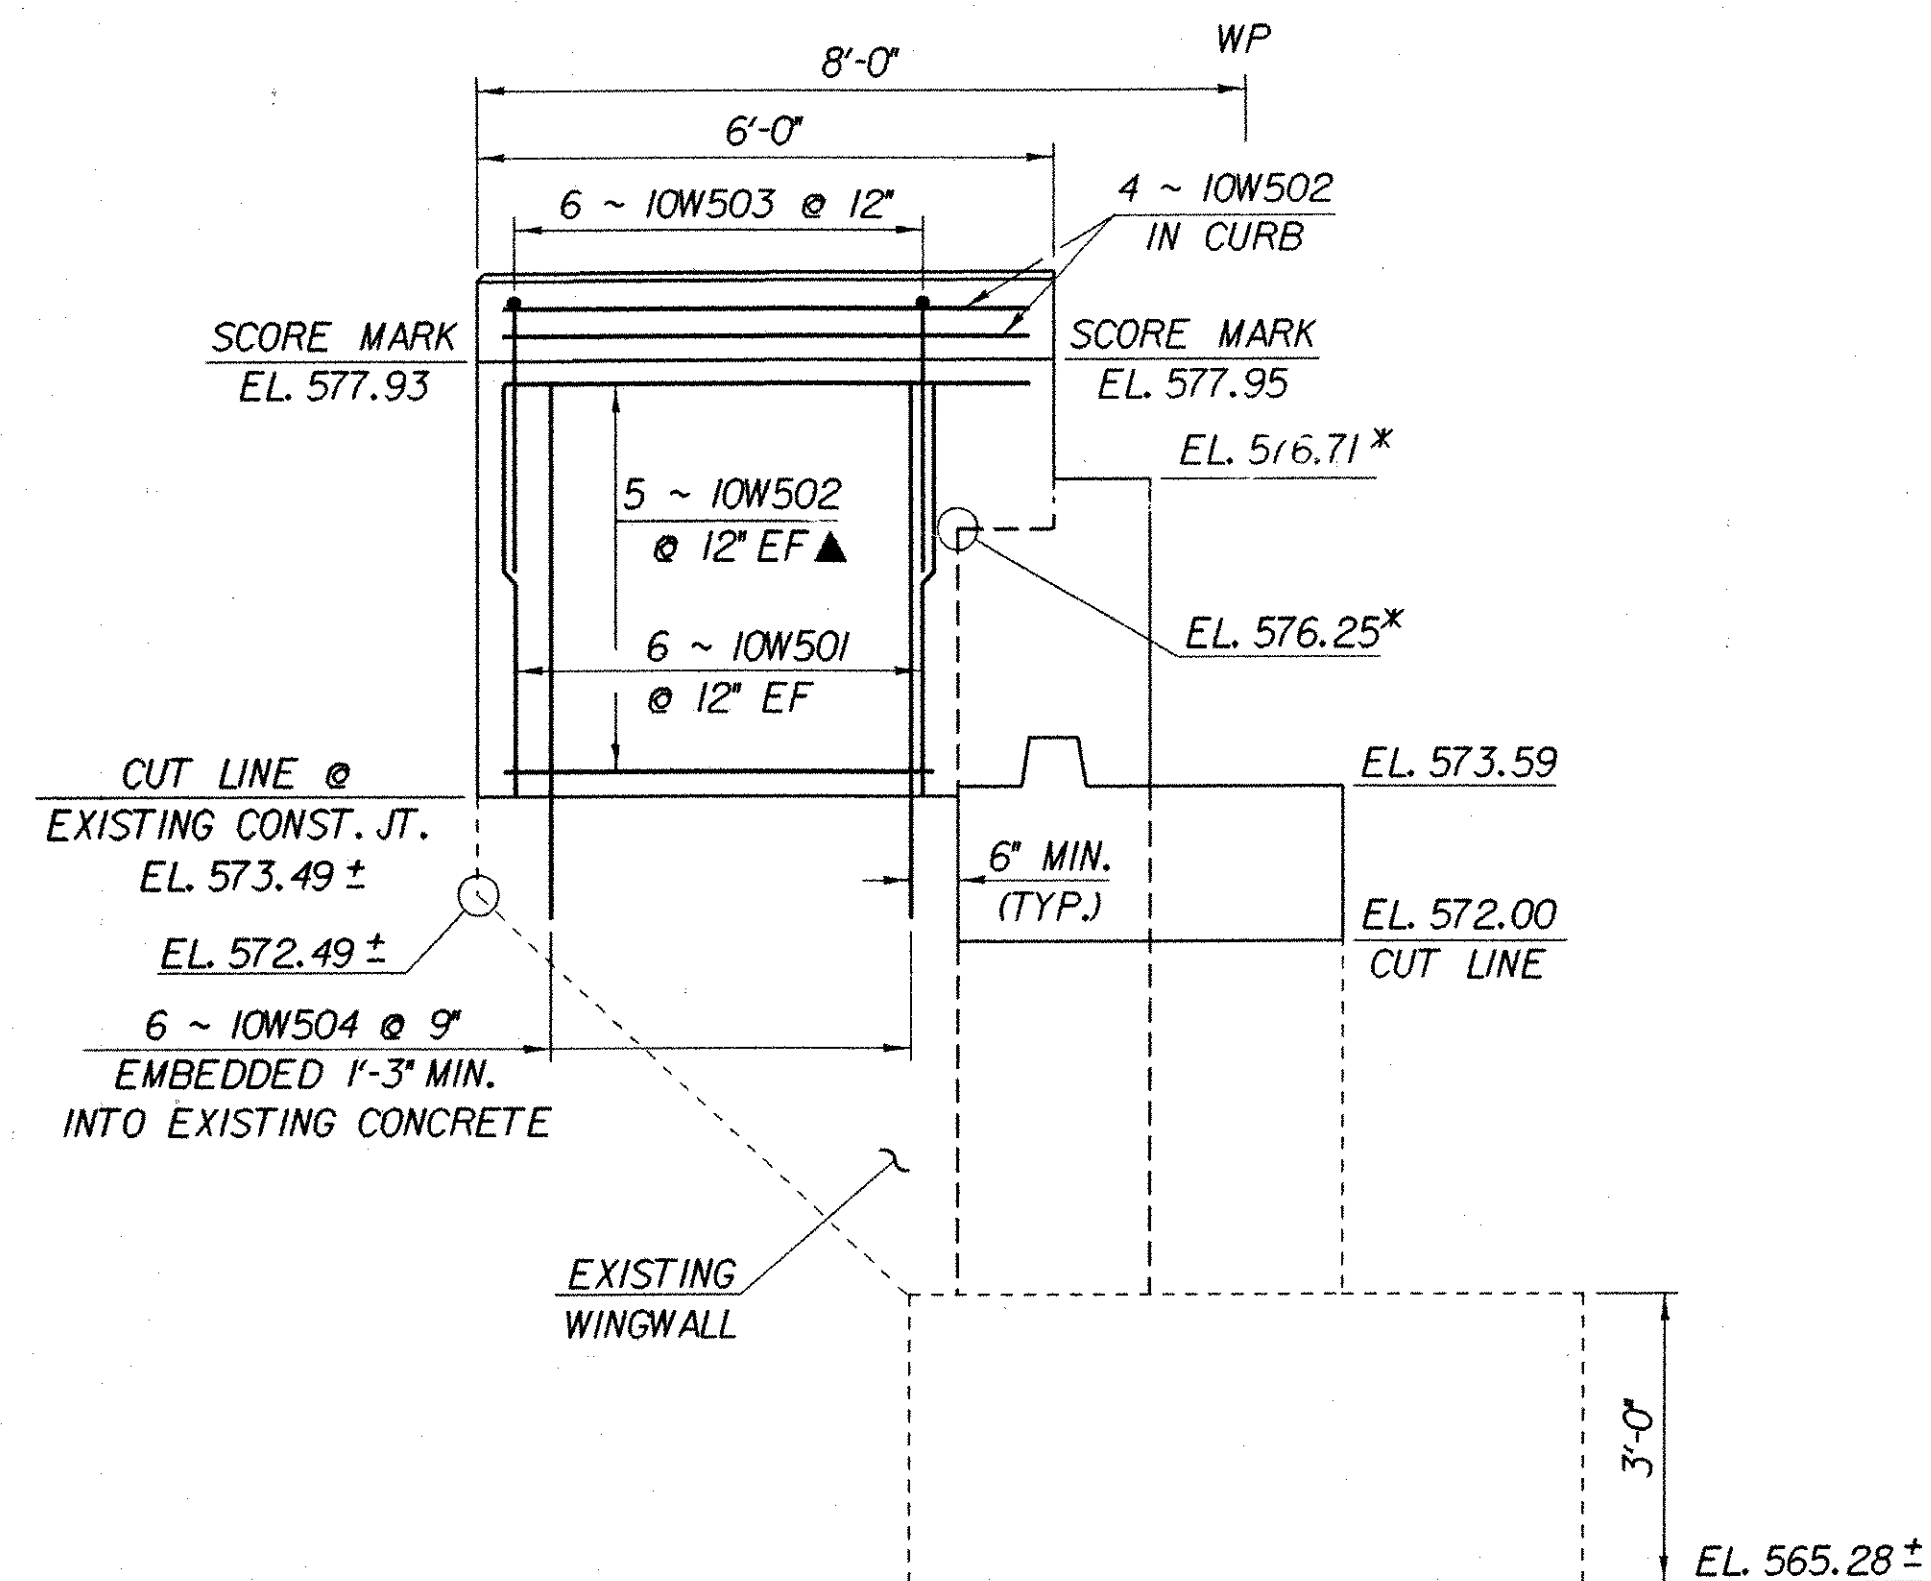

WINGWALL NO. 10 ELEVATION


SCALE: 1/2" = 1'-0"

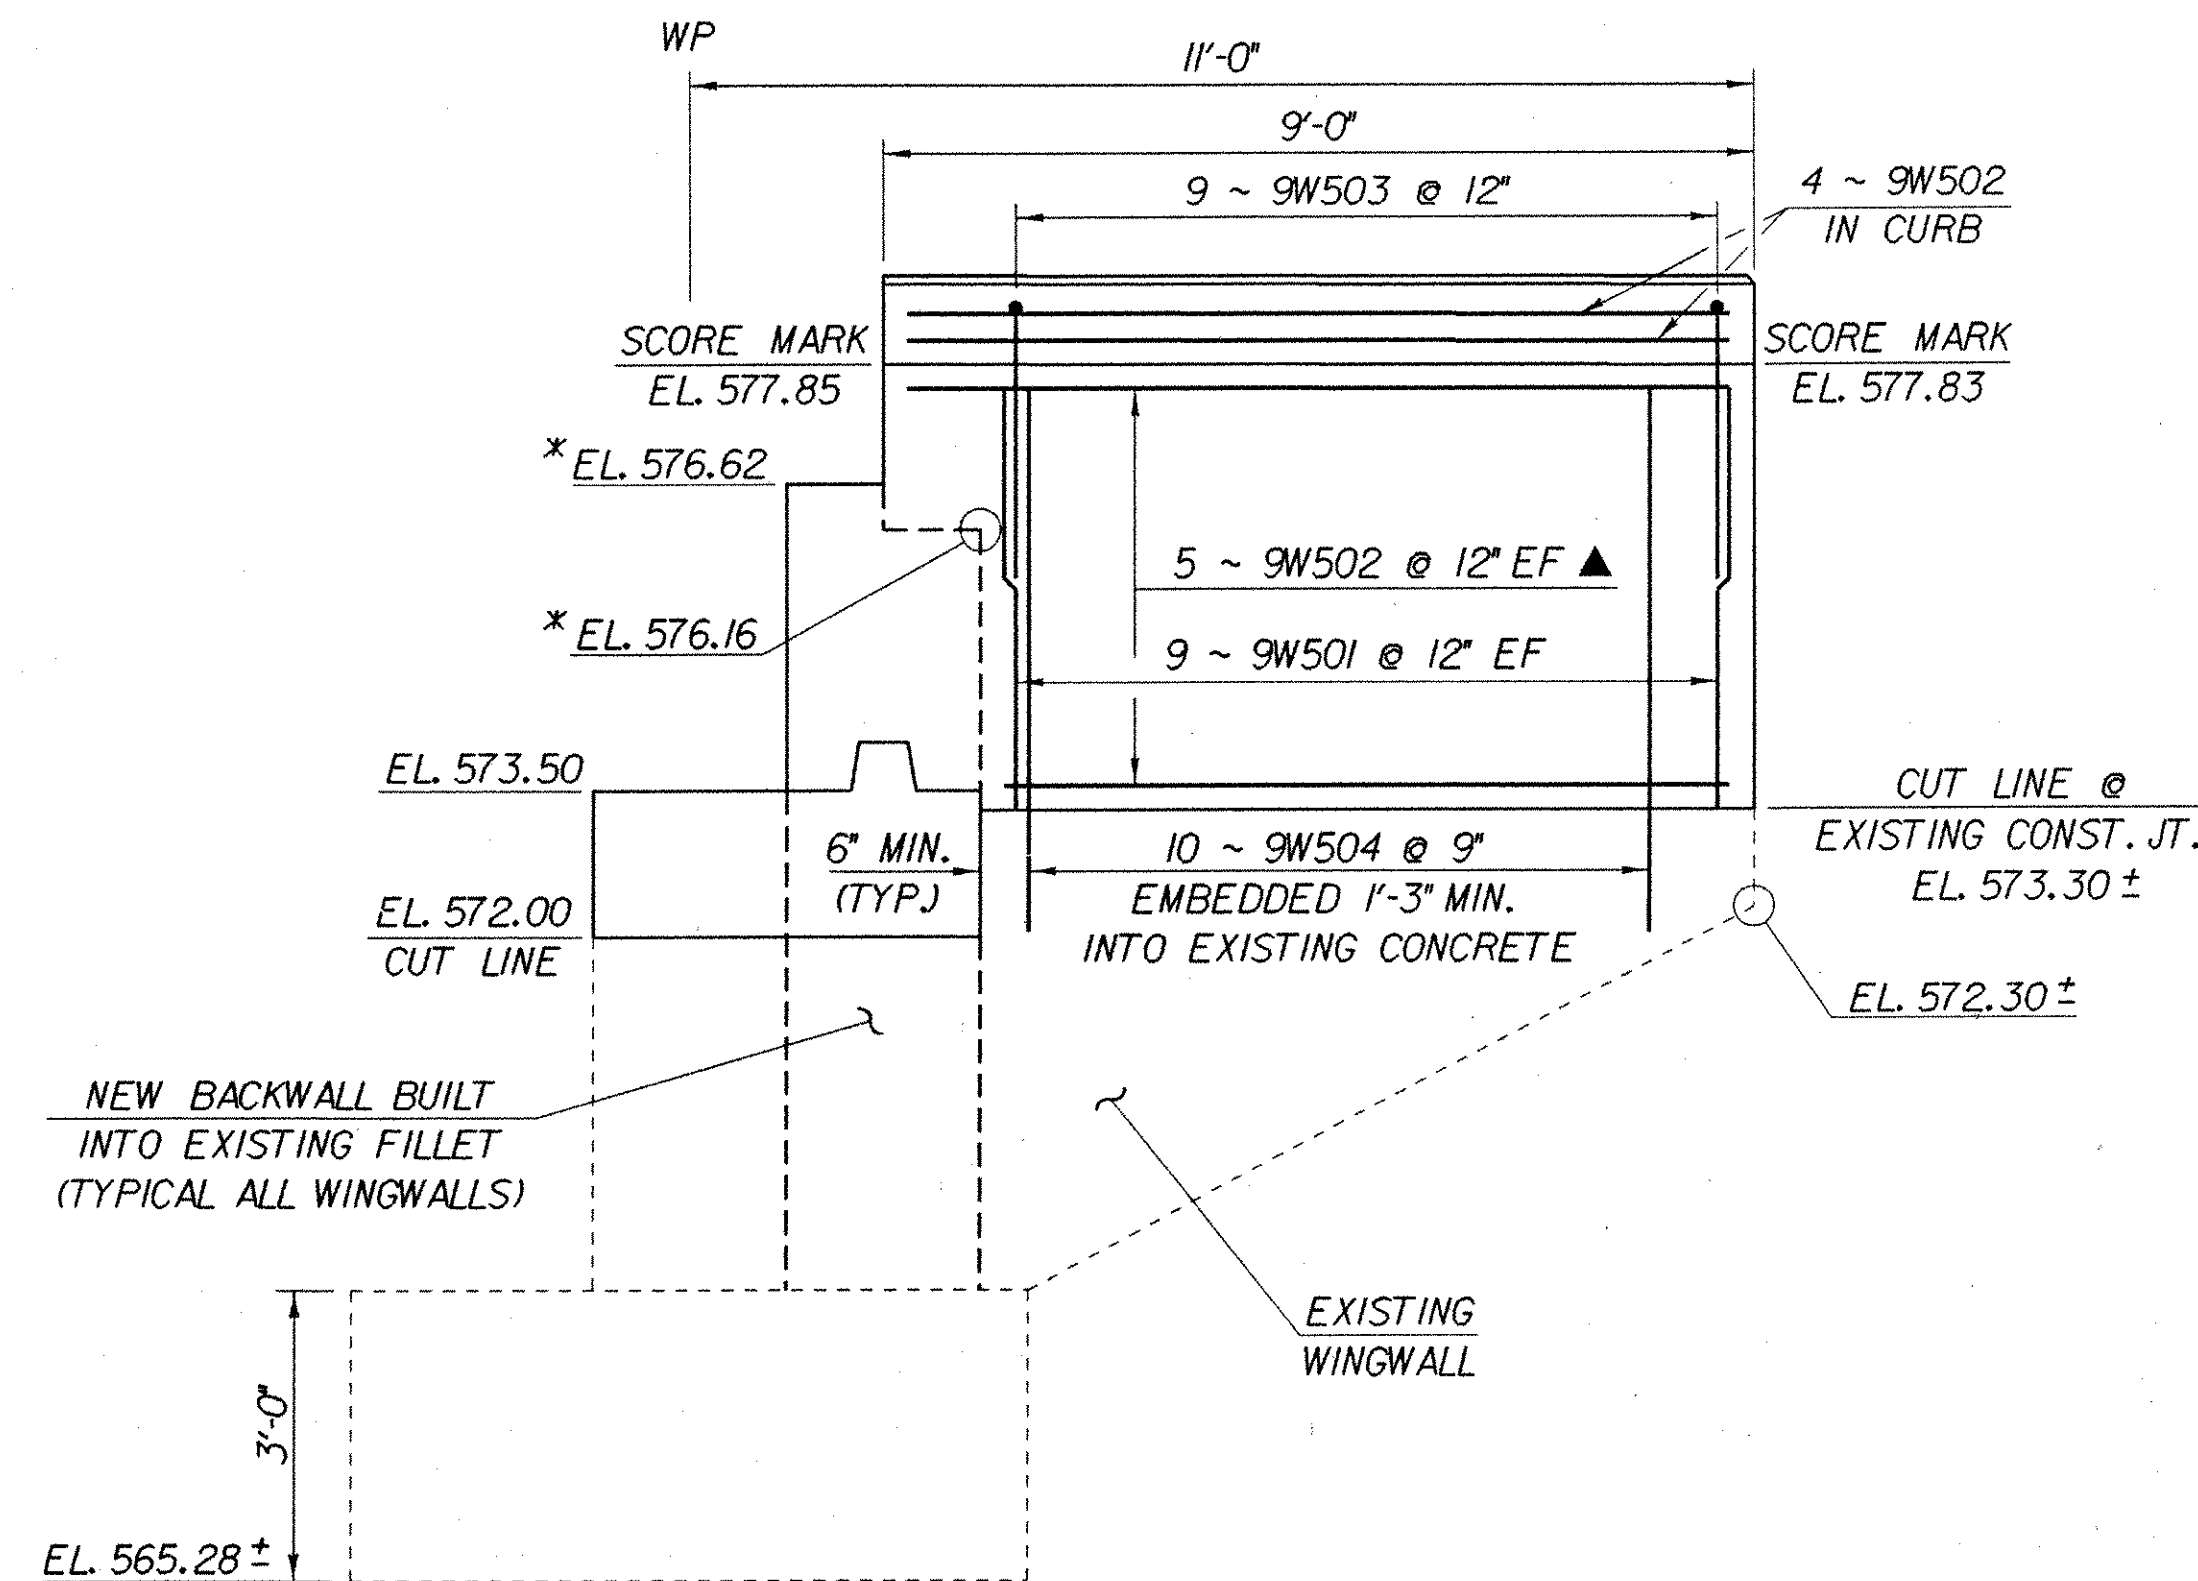

WINGWALL NO. 9 ELEVATION


SCALE: 1/2" = 1'-0"

IMPORTANT NOTE: BRIDGE FINISHED GRADES ARE CENTERLINE GRADES.

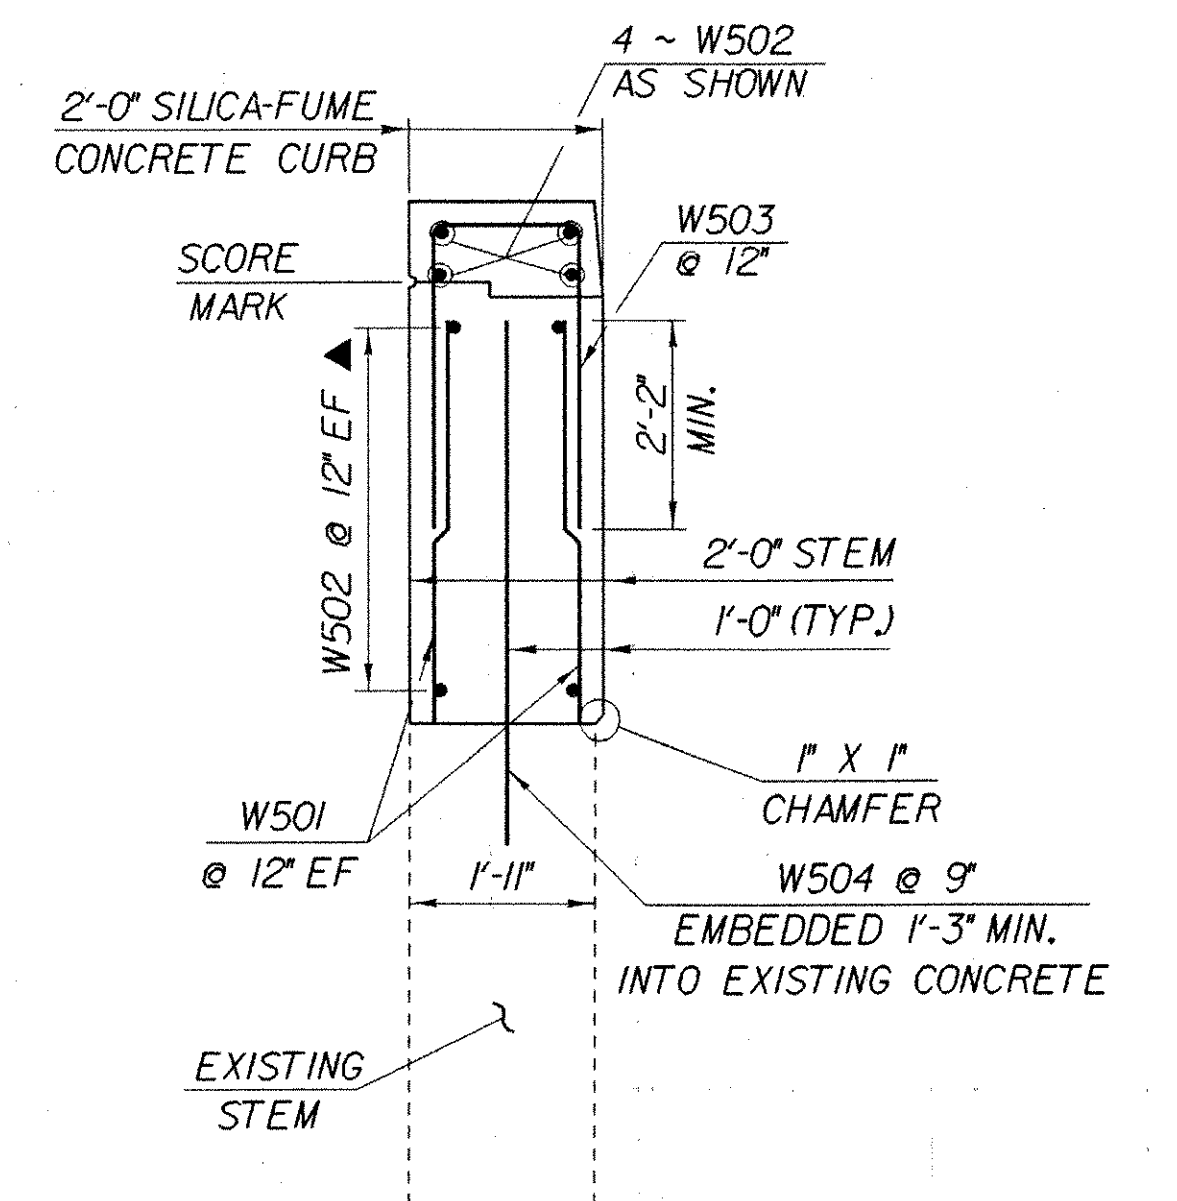

WINGWALL TYPICAL


SCALE: 1/2" = 1'-0"

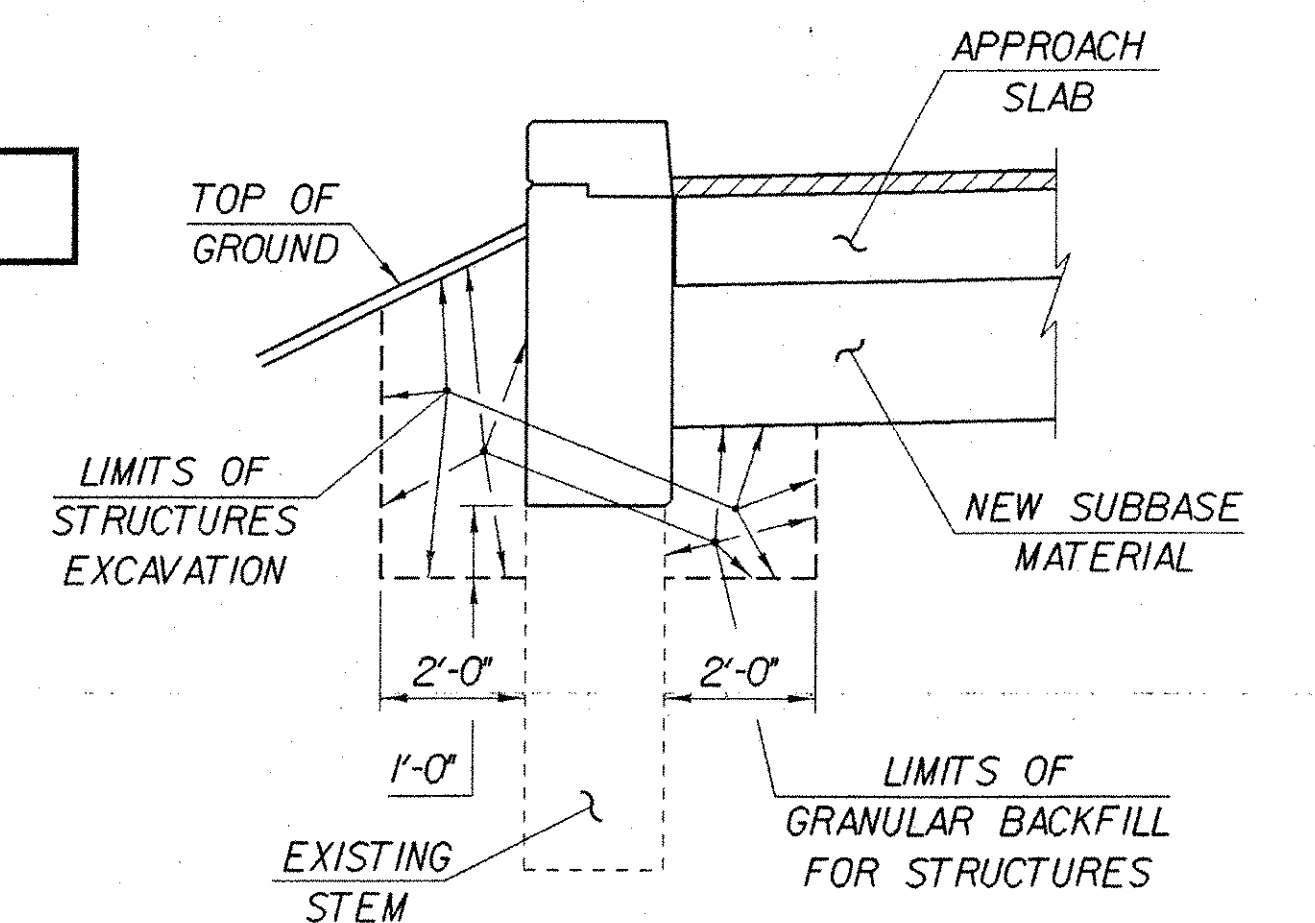

WINGWALL EARTHWORK TYPICAL


NOT TO SCALE

* NOTE:
ELEVATIONS AT TOP OF BACKWALL AND APPROACH SLAB BRACKET TO BE VERIFIED BY THE RESIDENT ENGINEER AFTER STRUCTURAL STEEL IS ERECTED.

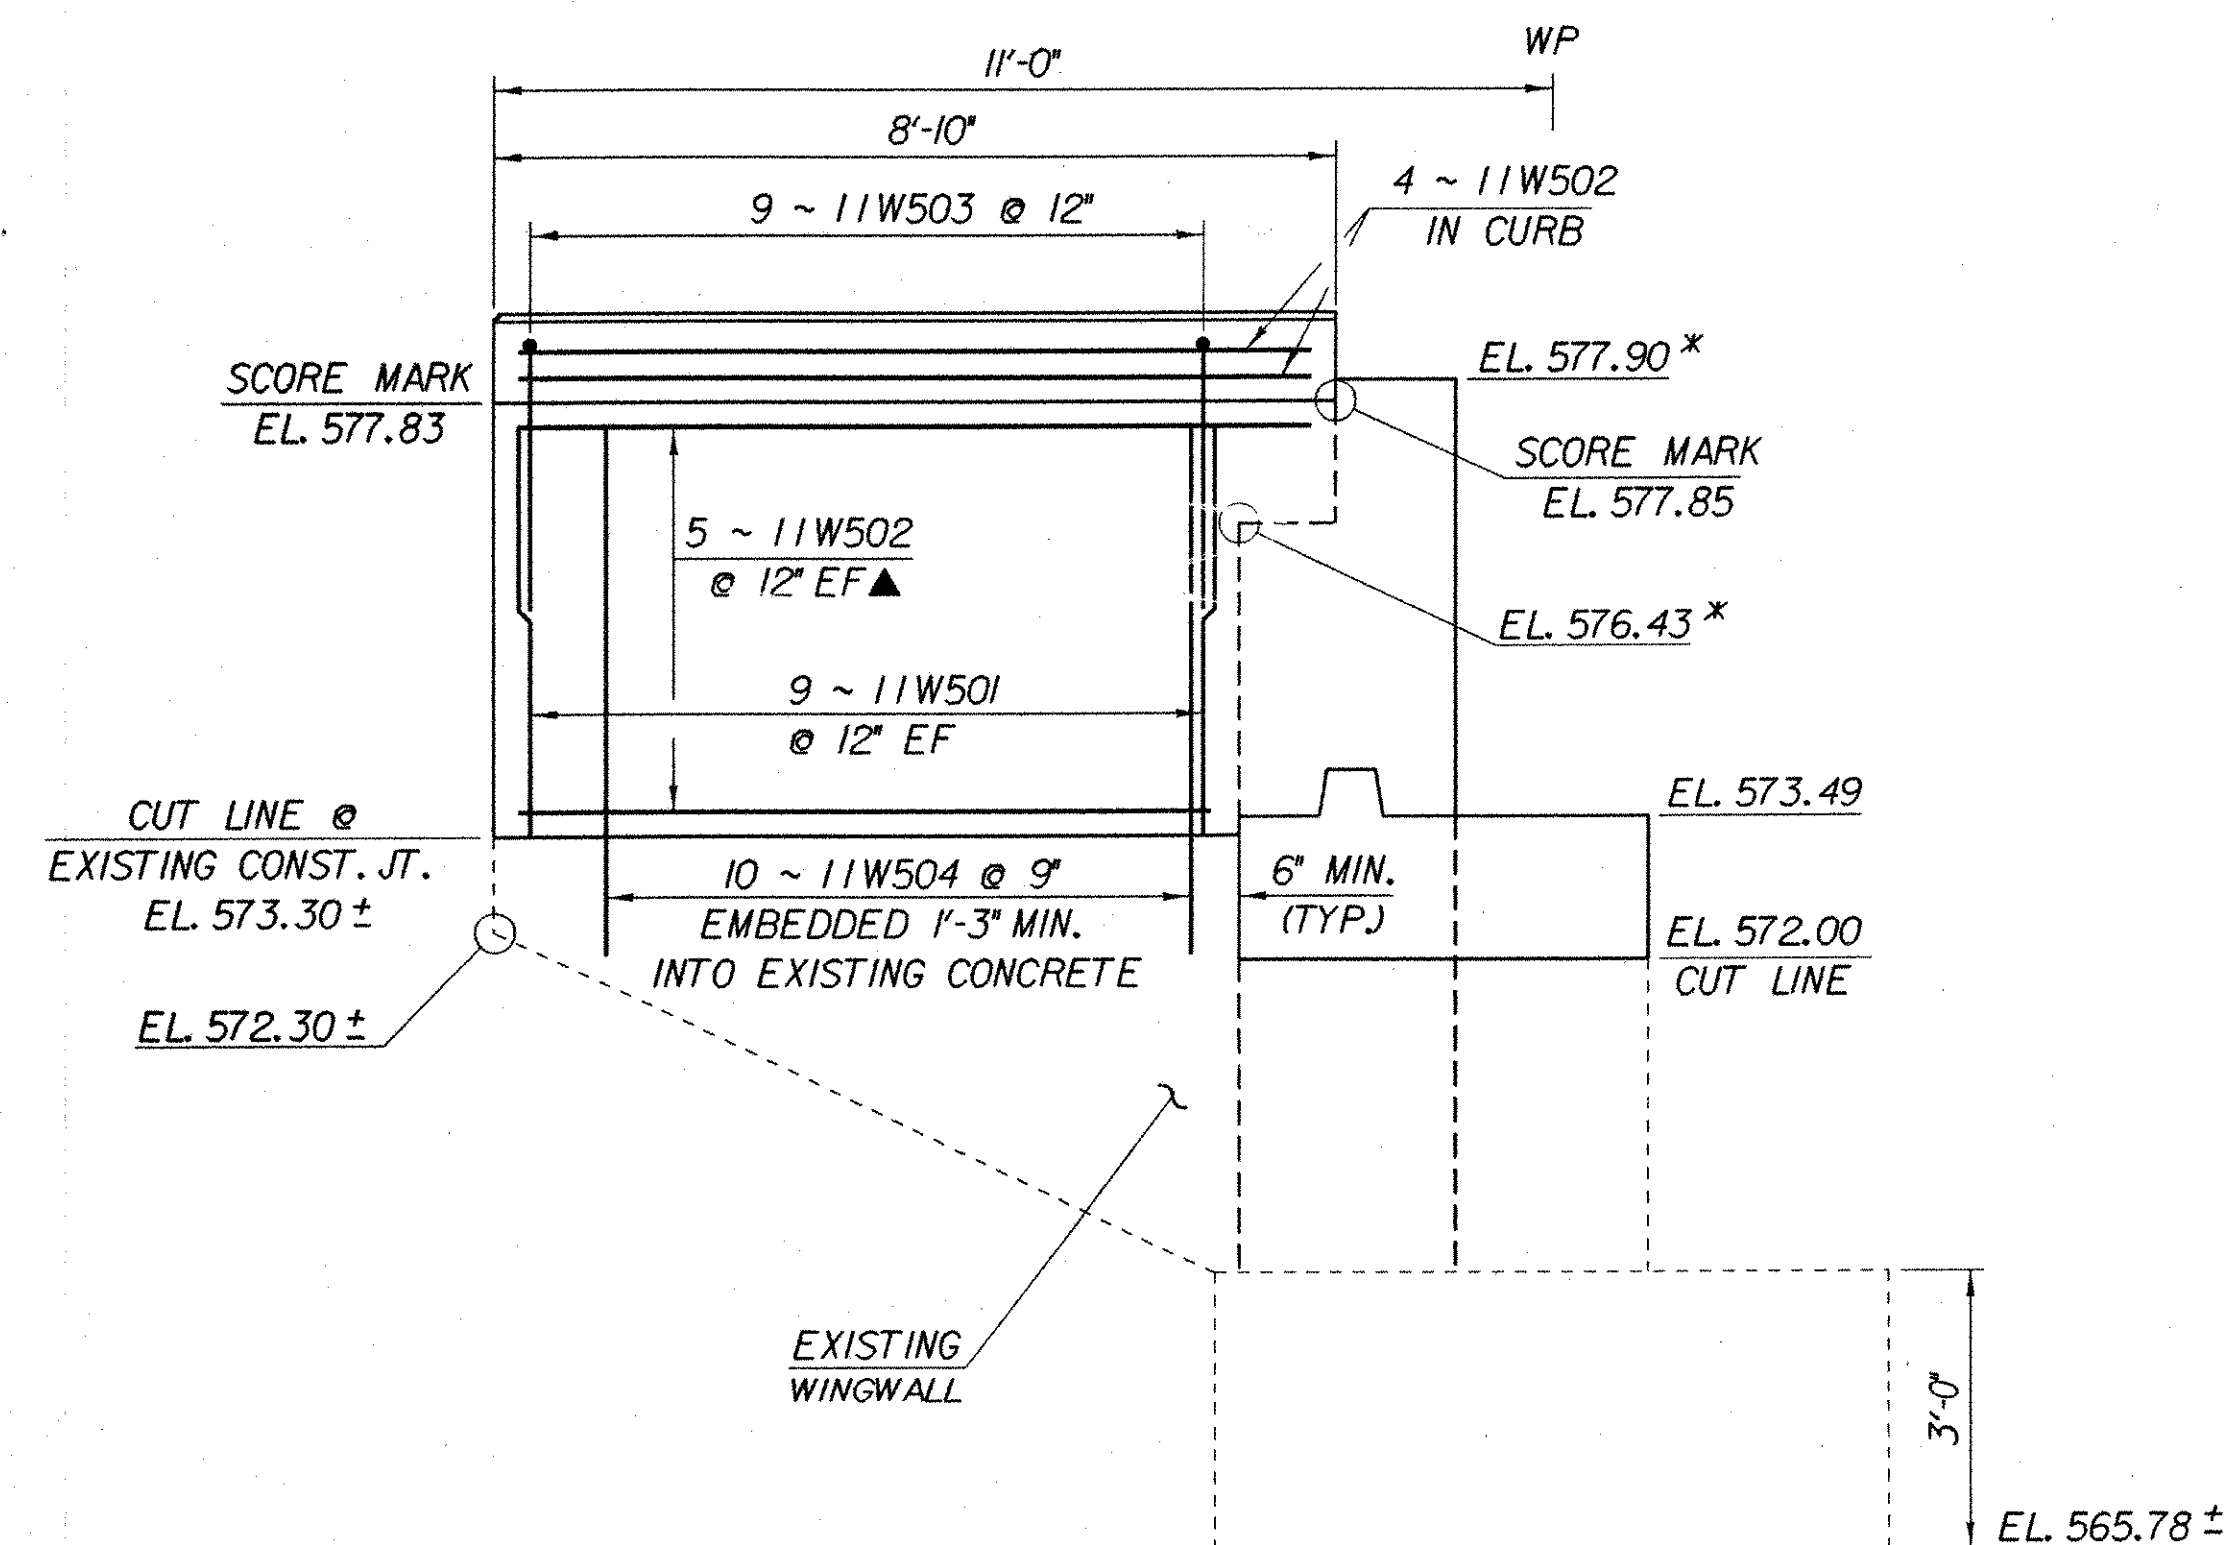

WINGWALL NO. 11 ELEVATION

SCALE: 1/2" = 1'-0"

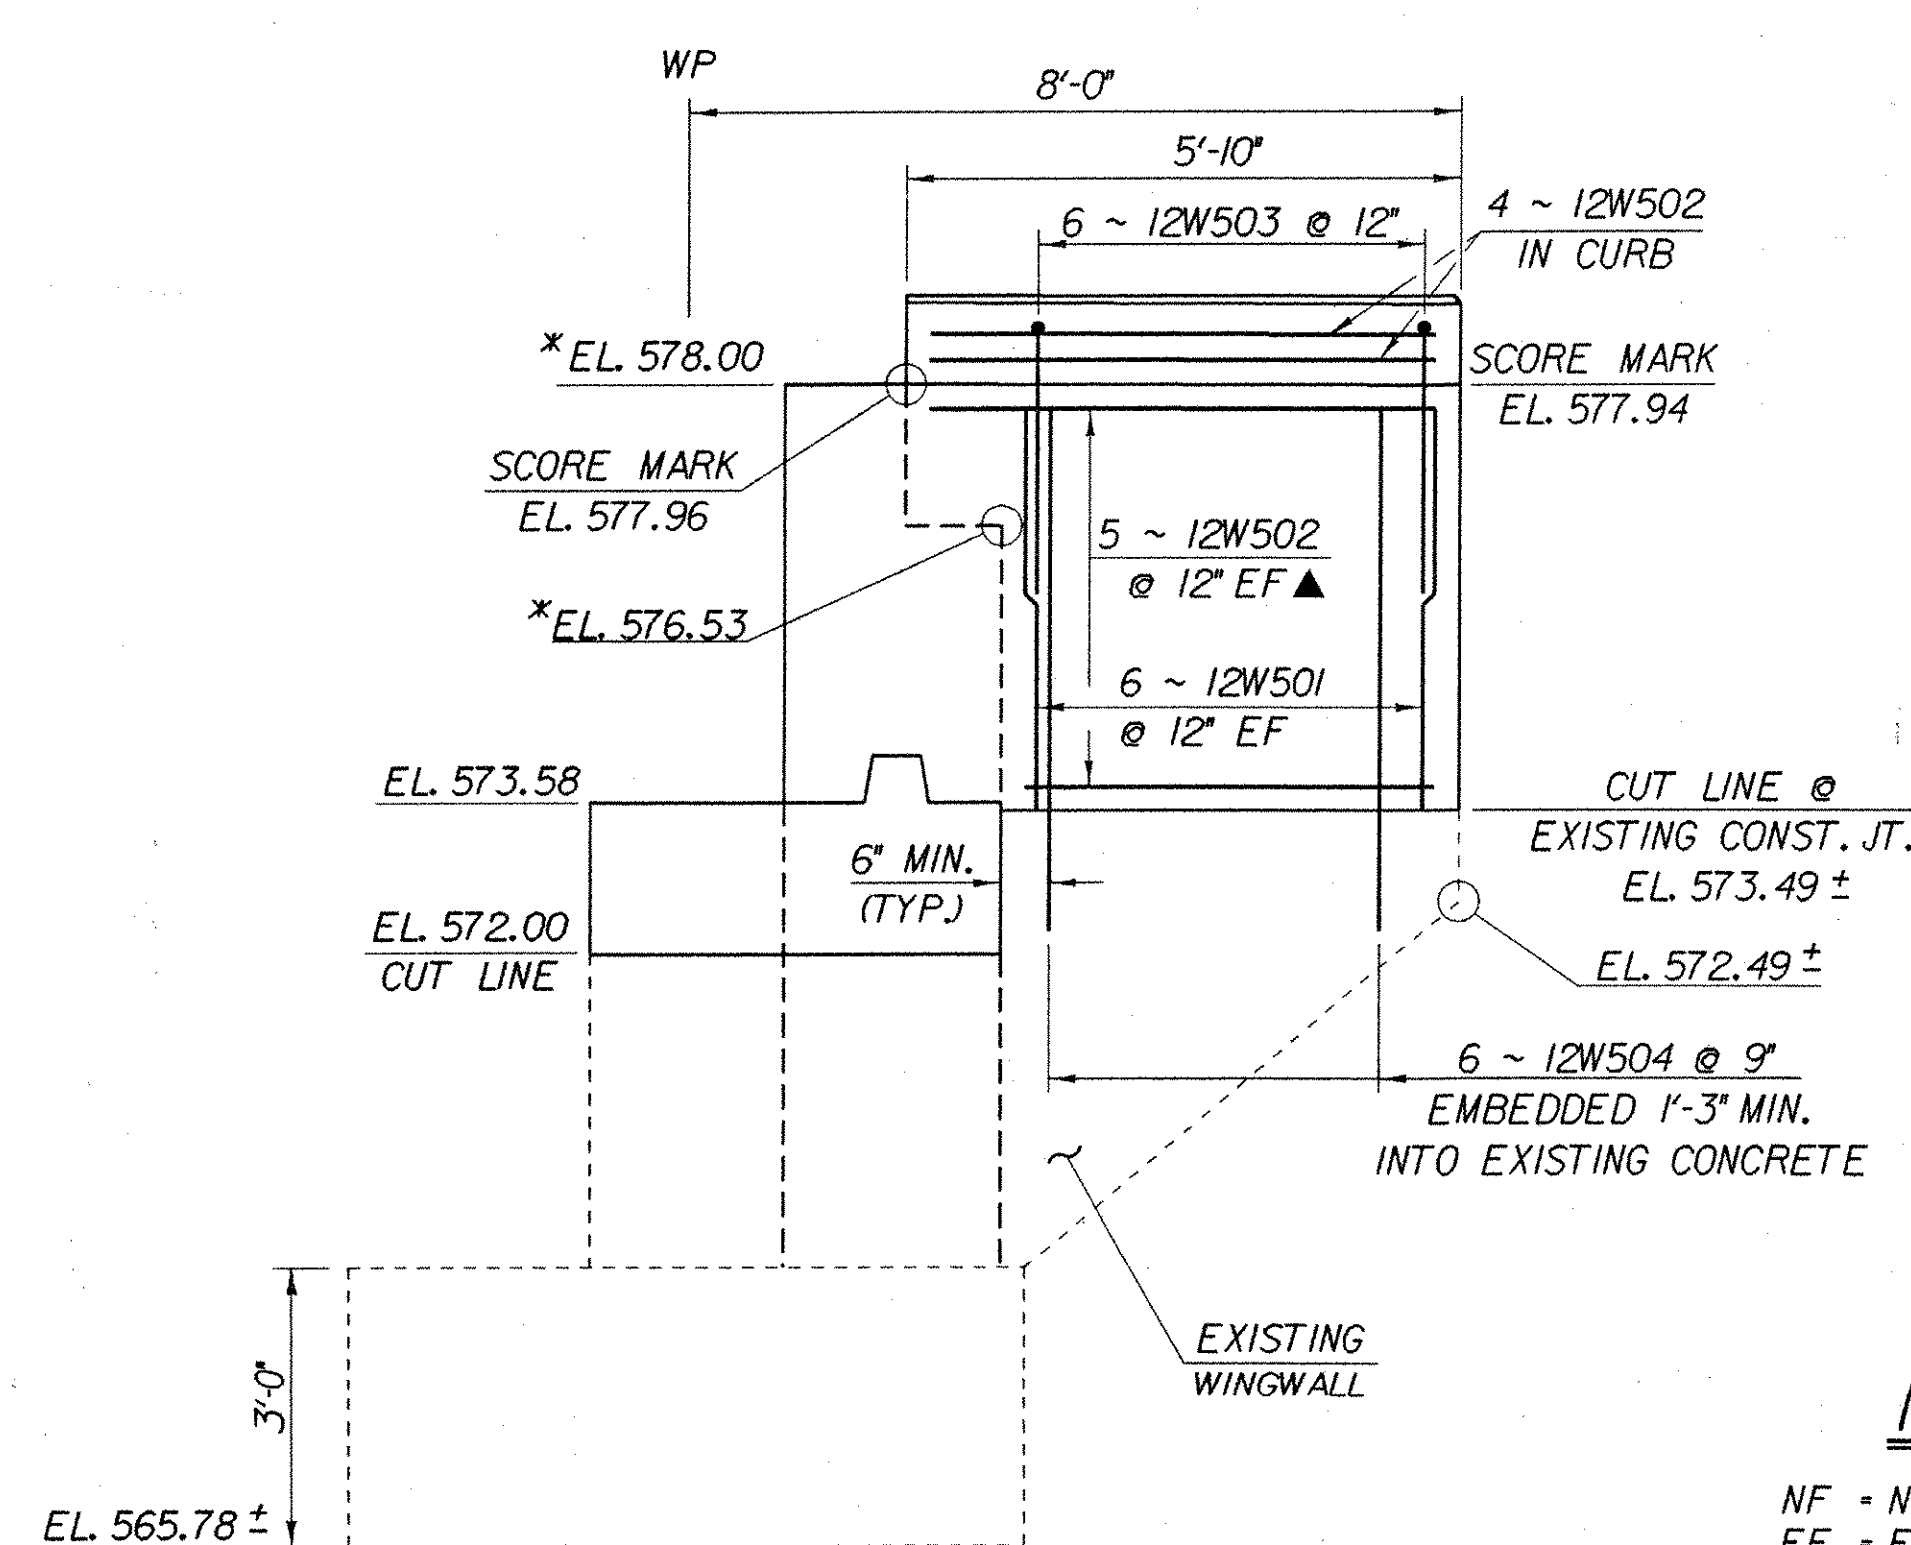

WINGWALL NO. 12 ELEVATION

SCALE: 1/2" = 1'-0"

NOTE:

NF - NEAR FACE
FF - FAR FACE
EF - EACH FACE
▲ - CUT TO FIT IN FIELD
3" CLR. UNLESS OTHERWISE SPECIFIED ON THE PLANS.

**STATE OF VERMONT
AGENCY OF TRANSPORTATION**

Town Of FAIRFAX-FAIRFIELD-ST. ALBANS	Bridge No. 885
Highway No. 1-89	Log Sta. Surv. Sta.
1-89 OVER ST. ALBANS SOUTH STATE HIGHWAY (EXIT 19)	
WINGWALL NOS. 9 - 12 ELEVATIONS	
Designed By M. LOZIER	Drawn By K. CHISHOLM
Checked By M. LOZIER	Bridge Design Supervisor R. R. WHITCOMB Date 2/00
PROJECT FAIRFAX-FAIRFIELD-ST. ALBANS	
PROJECT NO. 1 M 089 - 3 (27)	
I.G.C. Info. 96a056Structures\sa056ab2.dgn	sa056ww3J
Bridge Sheet No. BR441	Sheet 193 of 370