



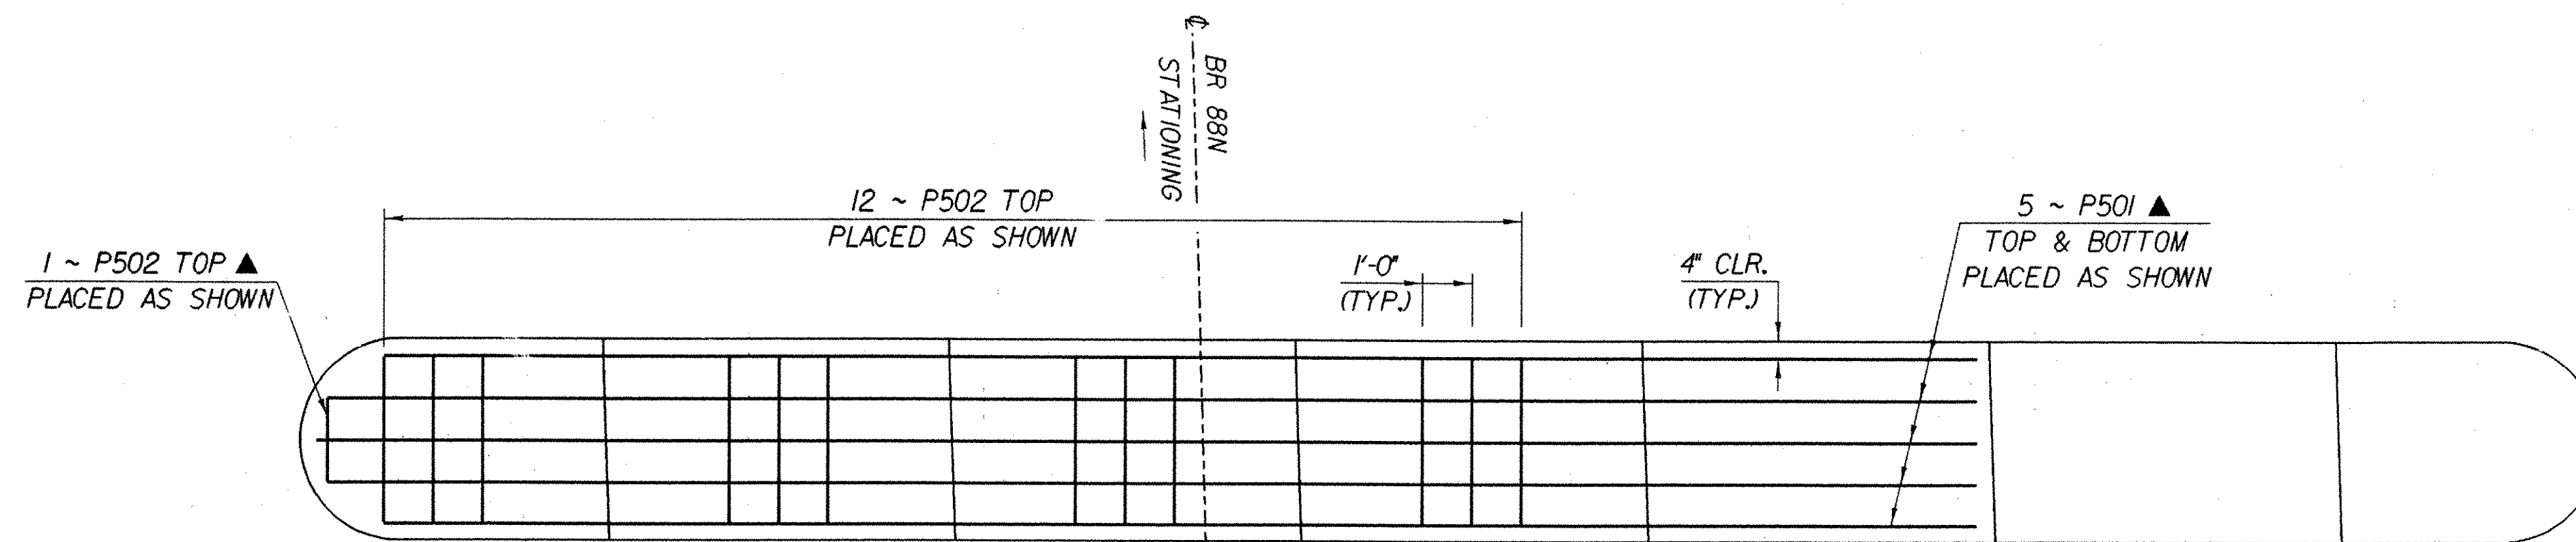


PIER CAP TOP REINFORCING PLAN

SCALE: $\frac{3}{8}$ " = 1'-0"

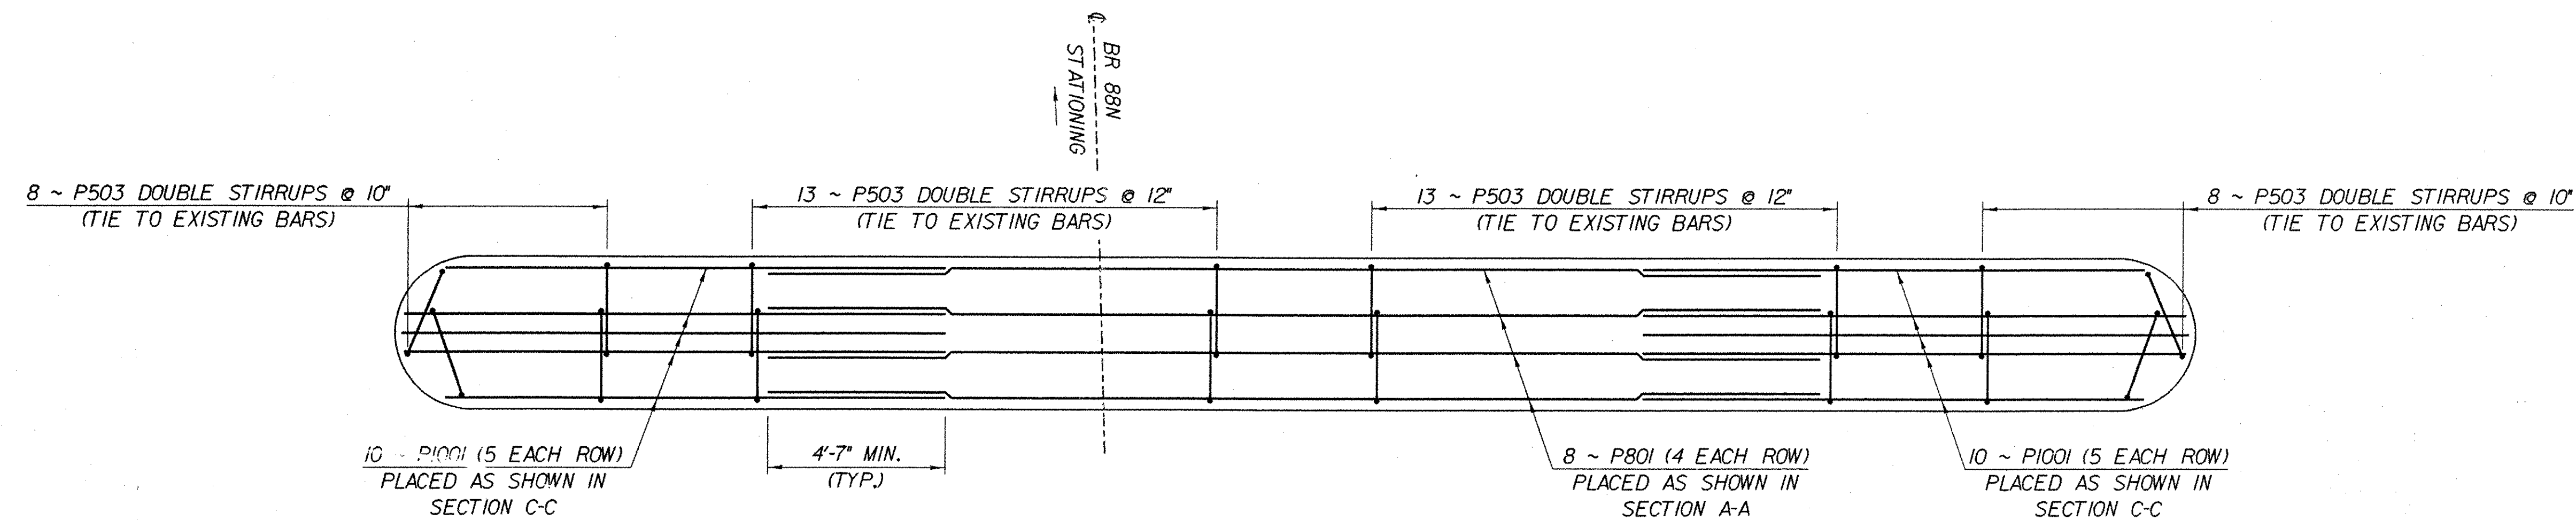


PIER CAP BOTTOM REINFORCING PLAN

SCALE: $\frac{3}{8}$ " = 1'-0"

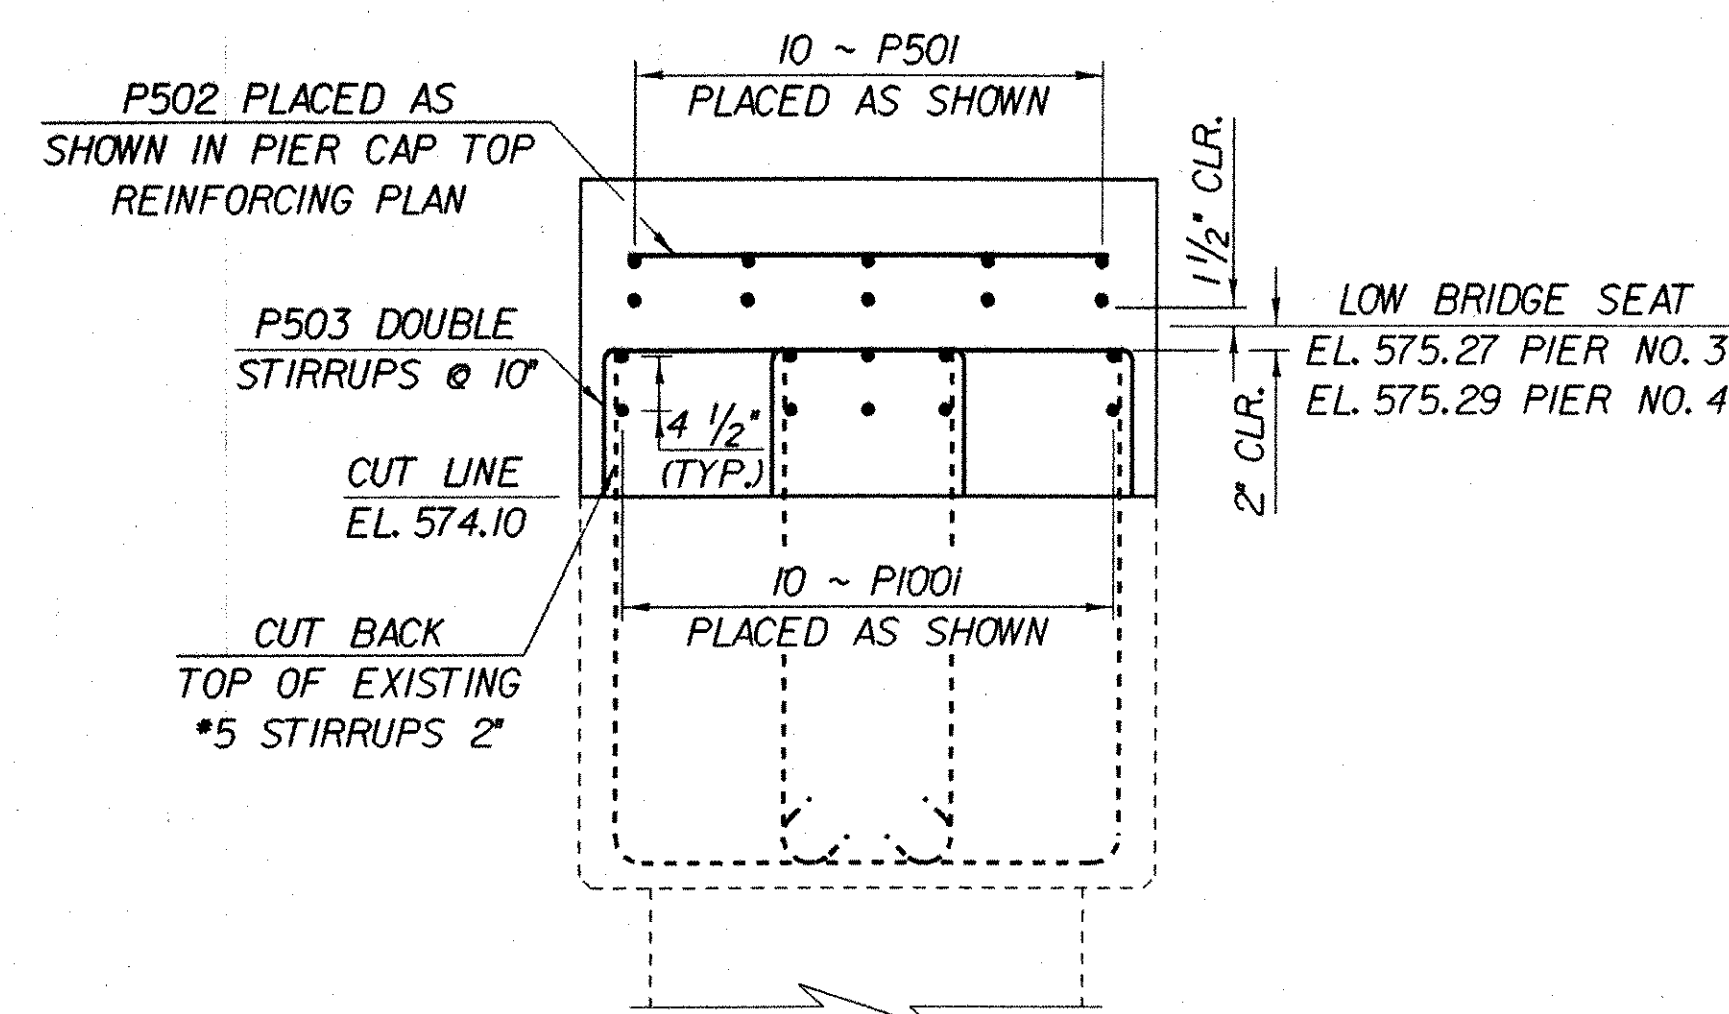


SECTION A-A

SCALE: $\frac{3}{4}$ " = 1'-0"

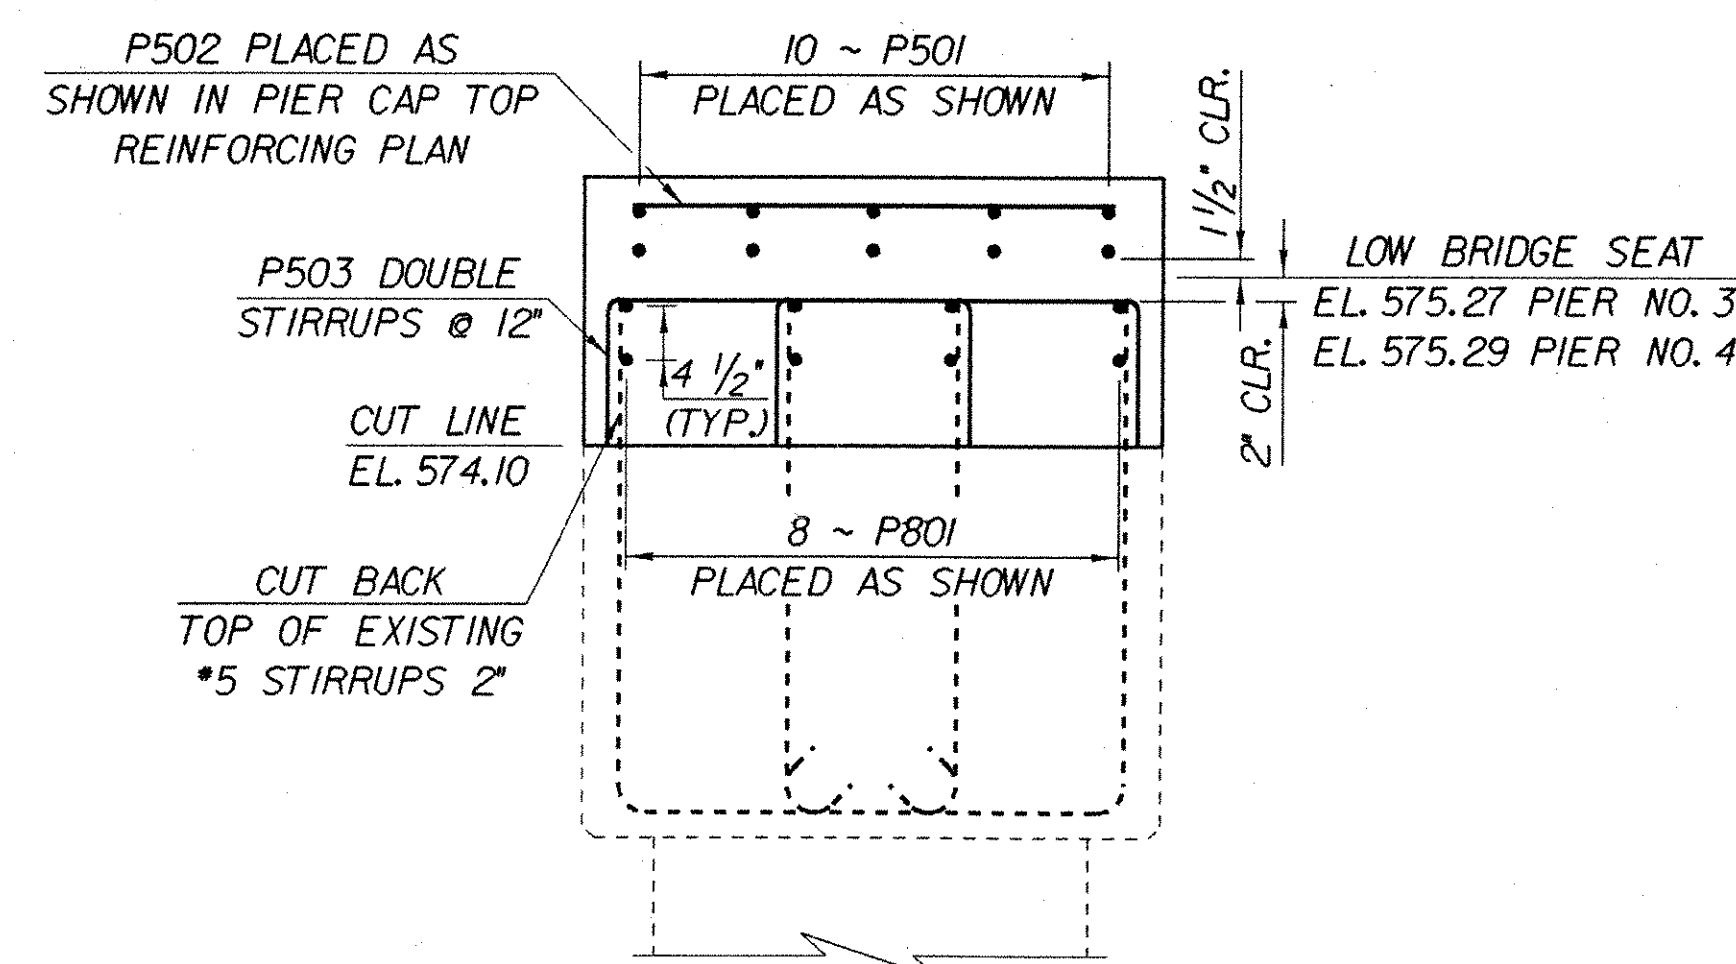

SECTION B-B

SCALE: $\frac{3}{4}$ " = 1'-0"

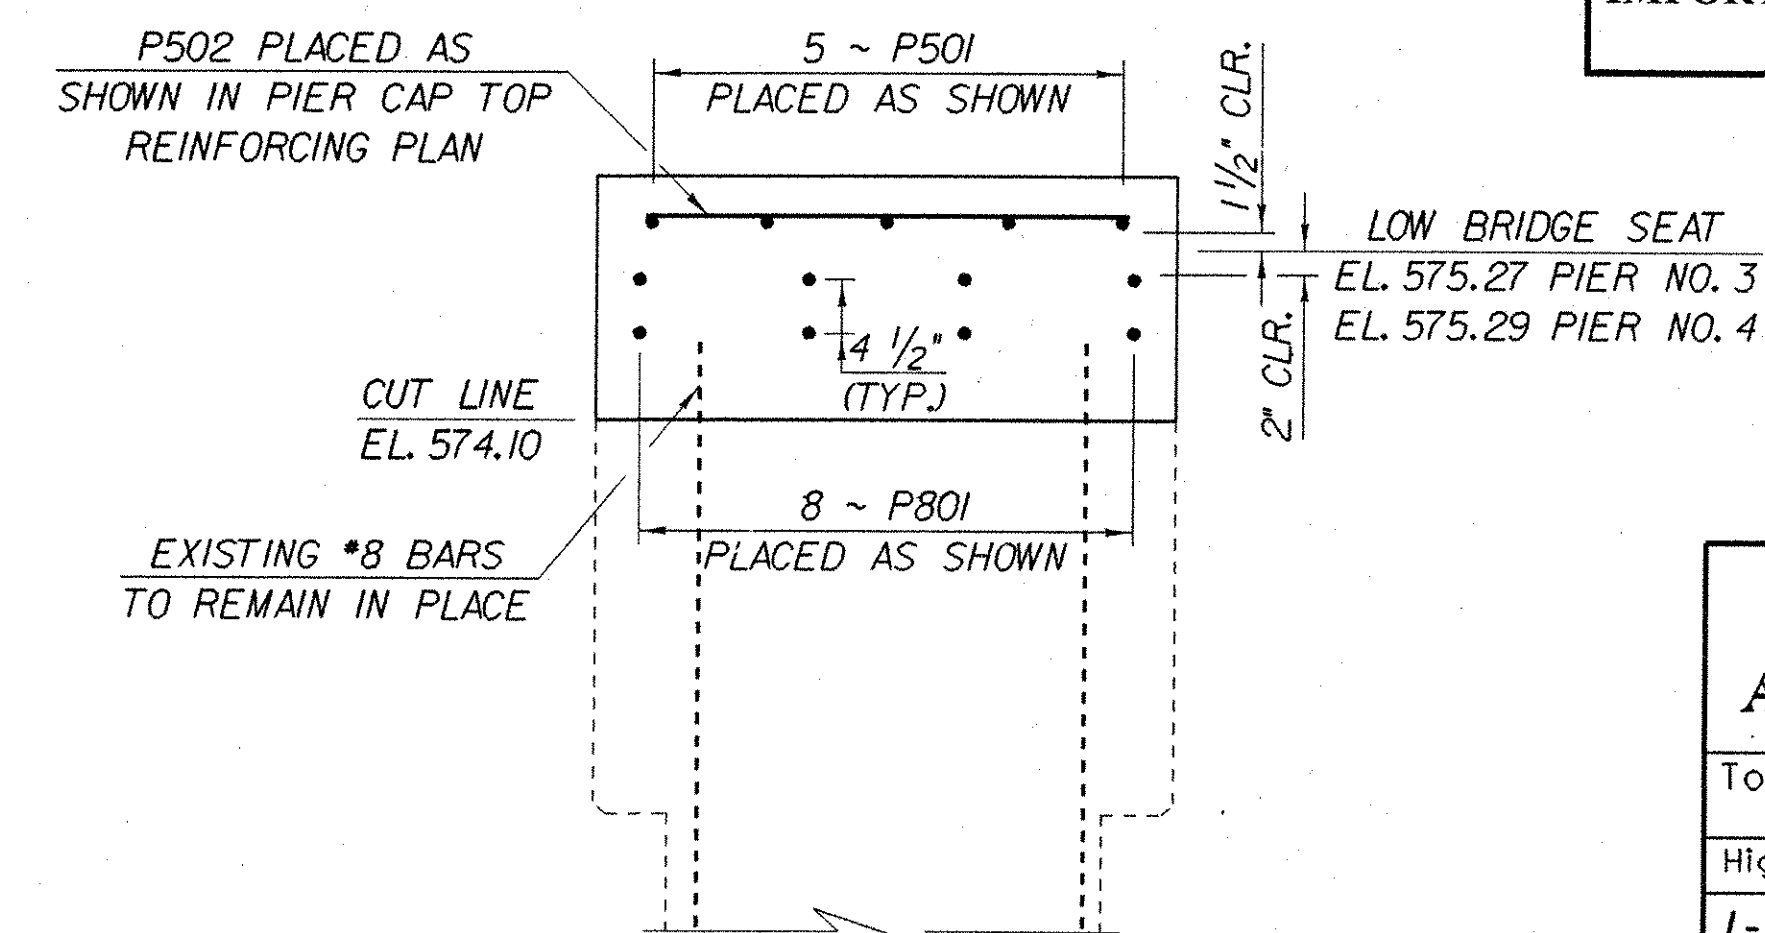

SECTION C-C

SCALE: $\frac{3}{4}$ " = 1'-0"

**IMPORTANT NOTE: BRIDGE FINISHED GRADES
ARE CENTERLINE GRADES.**

**STATE OF VERMONT
AGENCY OF TRANSPORTATION**

Town Of FAIRFAX-FAIRFIELD-ST. ALBANS	Bridge No. 88N
Highway No. 1-89	Log Sta. Surv. Sta.
1-89 OVER ST. ALBANS SOUTH STATE HIGHWAY (EXIT 19)	
PIER NOS. 3 & 4 CAP REINFORCING DETAILS	
Designed By P. PERRY	Drawn By K. CHISHOLM
Checked By M. LOZIER	Date 2/00
	Bridge Design Supervisor R. R. WHITCOMB Date 2/00
PROJECT FAIRFAX-FAIRFIELD-ST. ALBANS	PROJECT NO. 1M 089 - 3 (27)
I.G.C. Info. 96a056Structures\sa056ab3.dgn	sa056pr5J
Bridge Sheet No. BR452	Sheet 204 of 370