



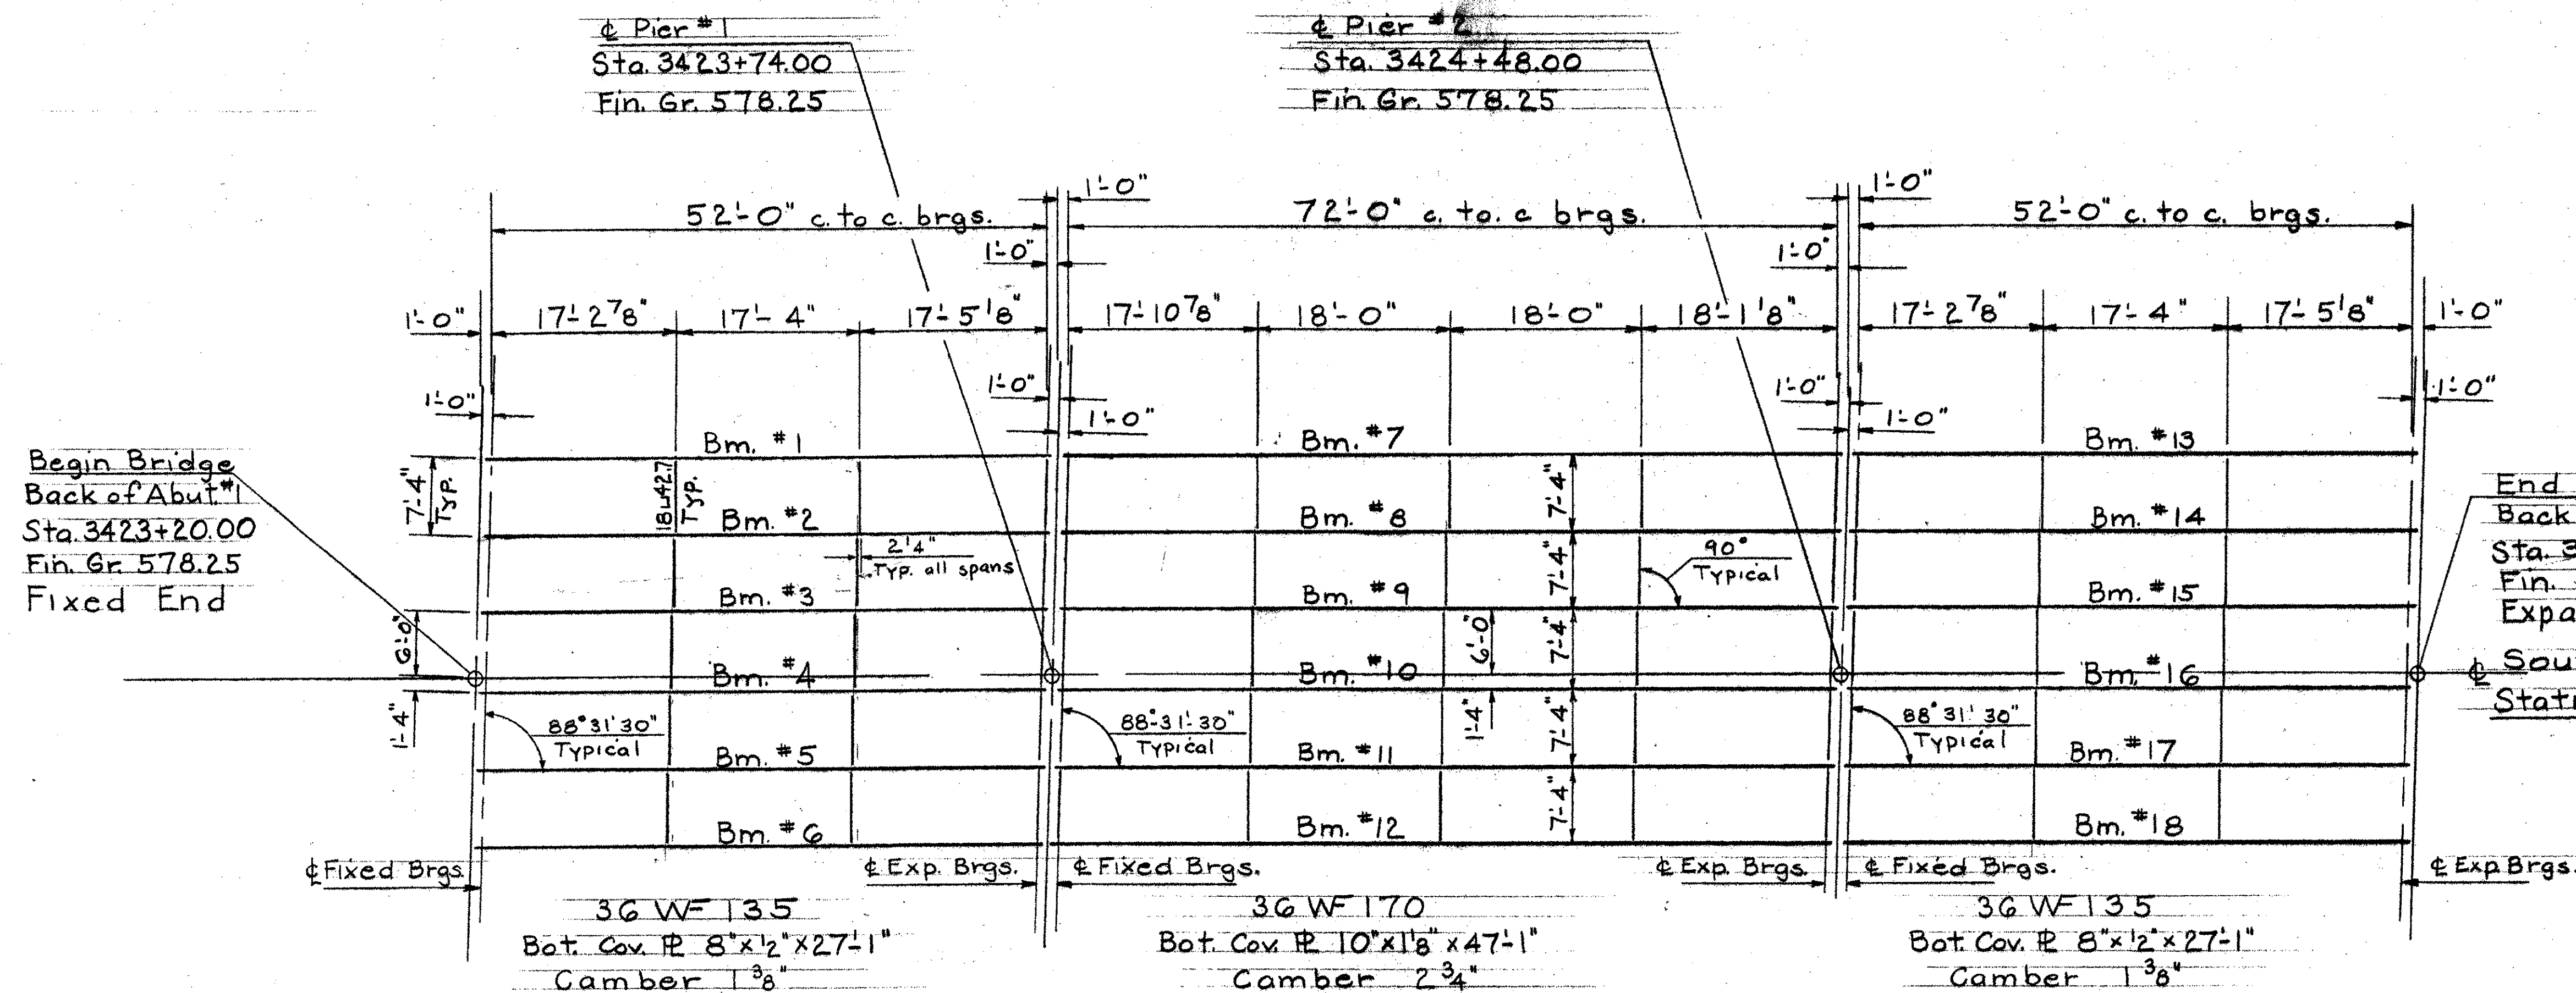

SOUTHBOUND FRAMING PLAN

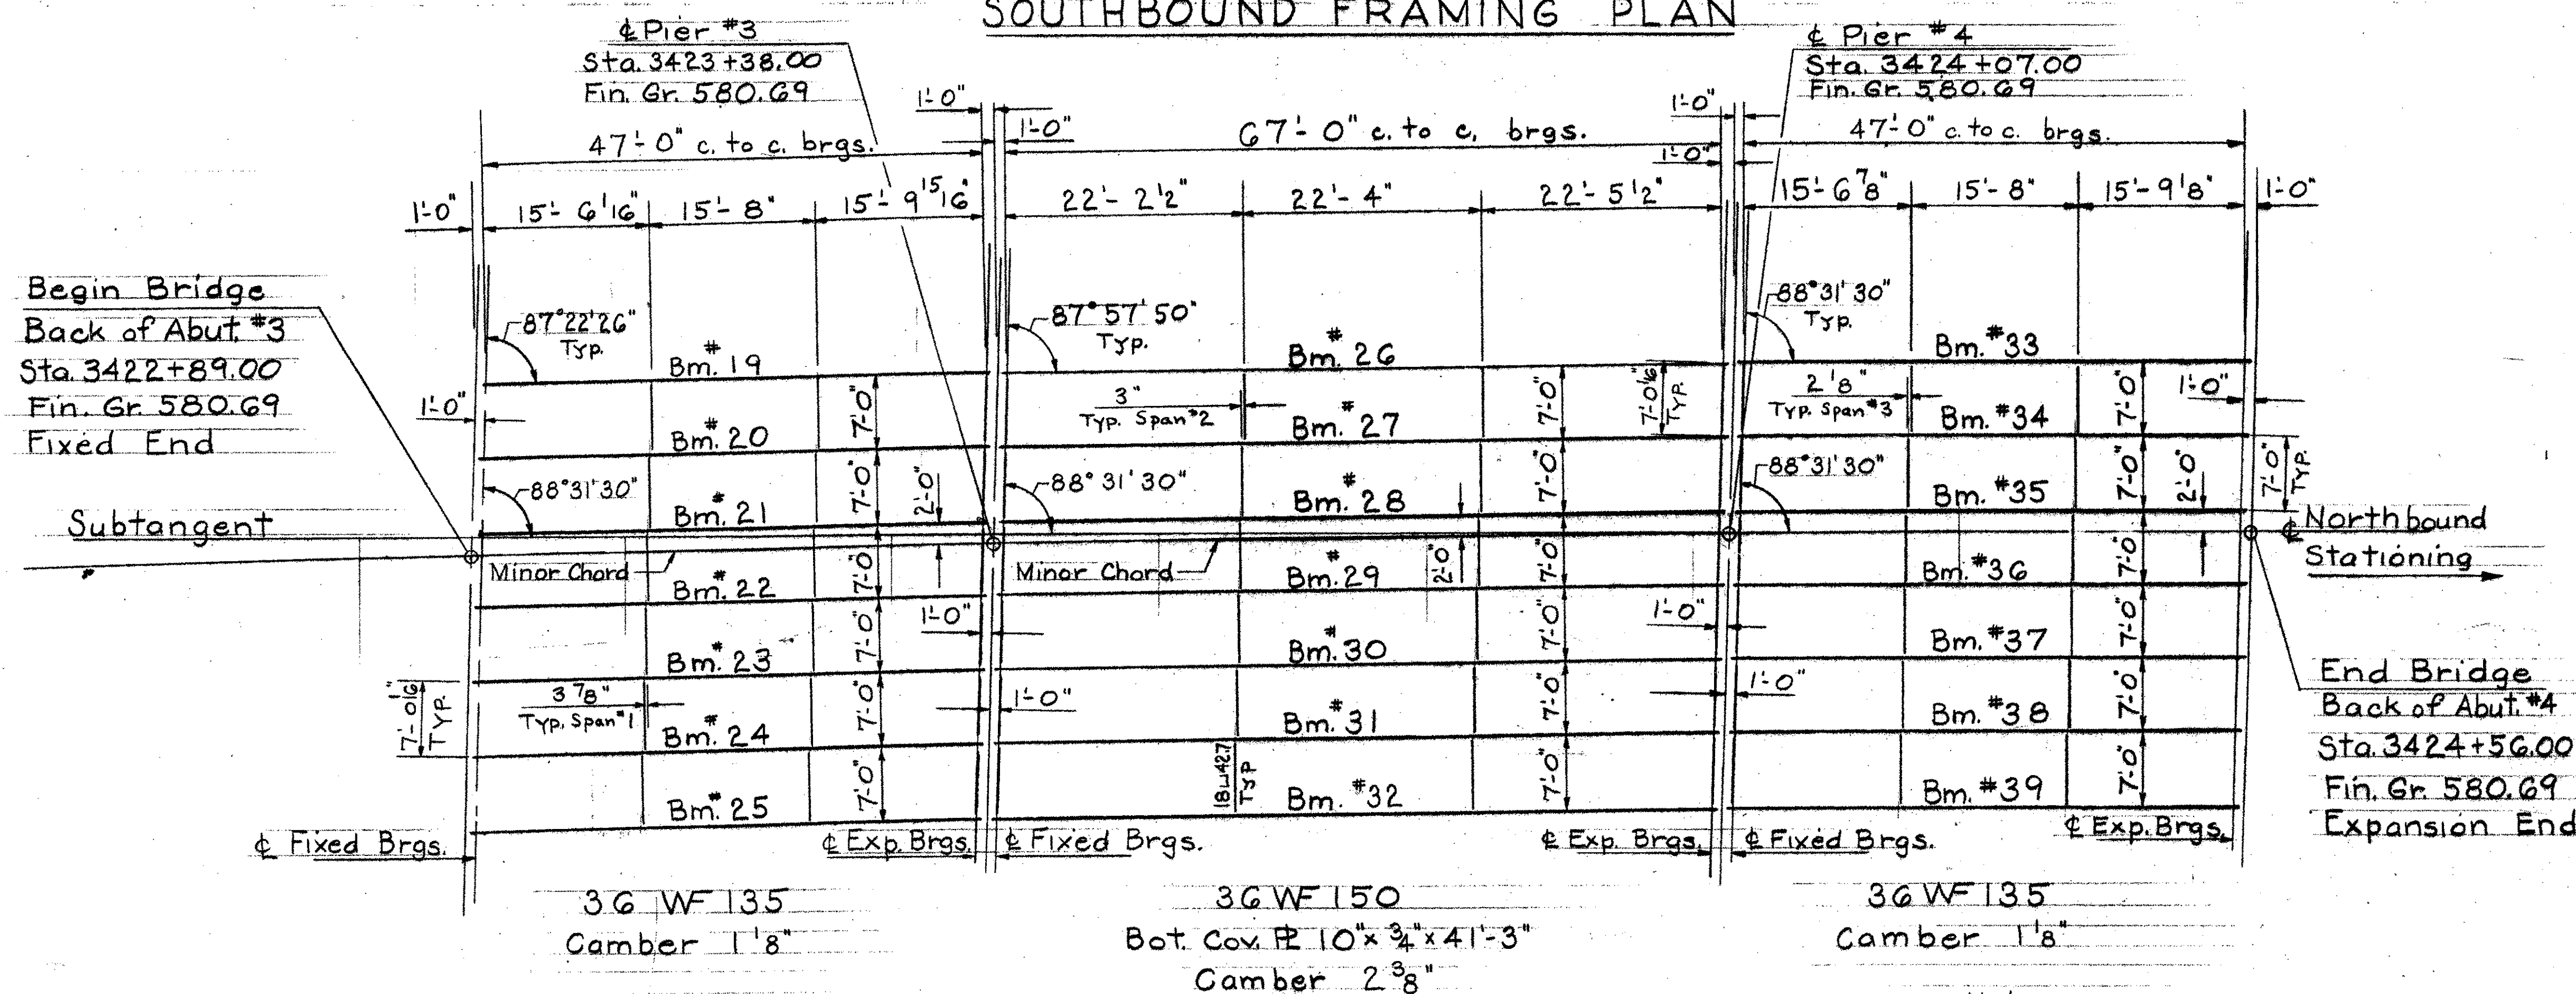

NORTHBOUND FRAMING PLAN