

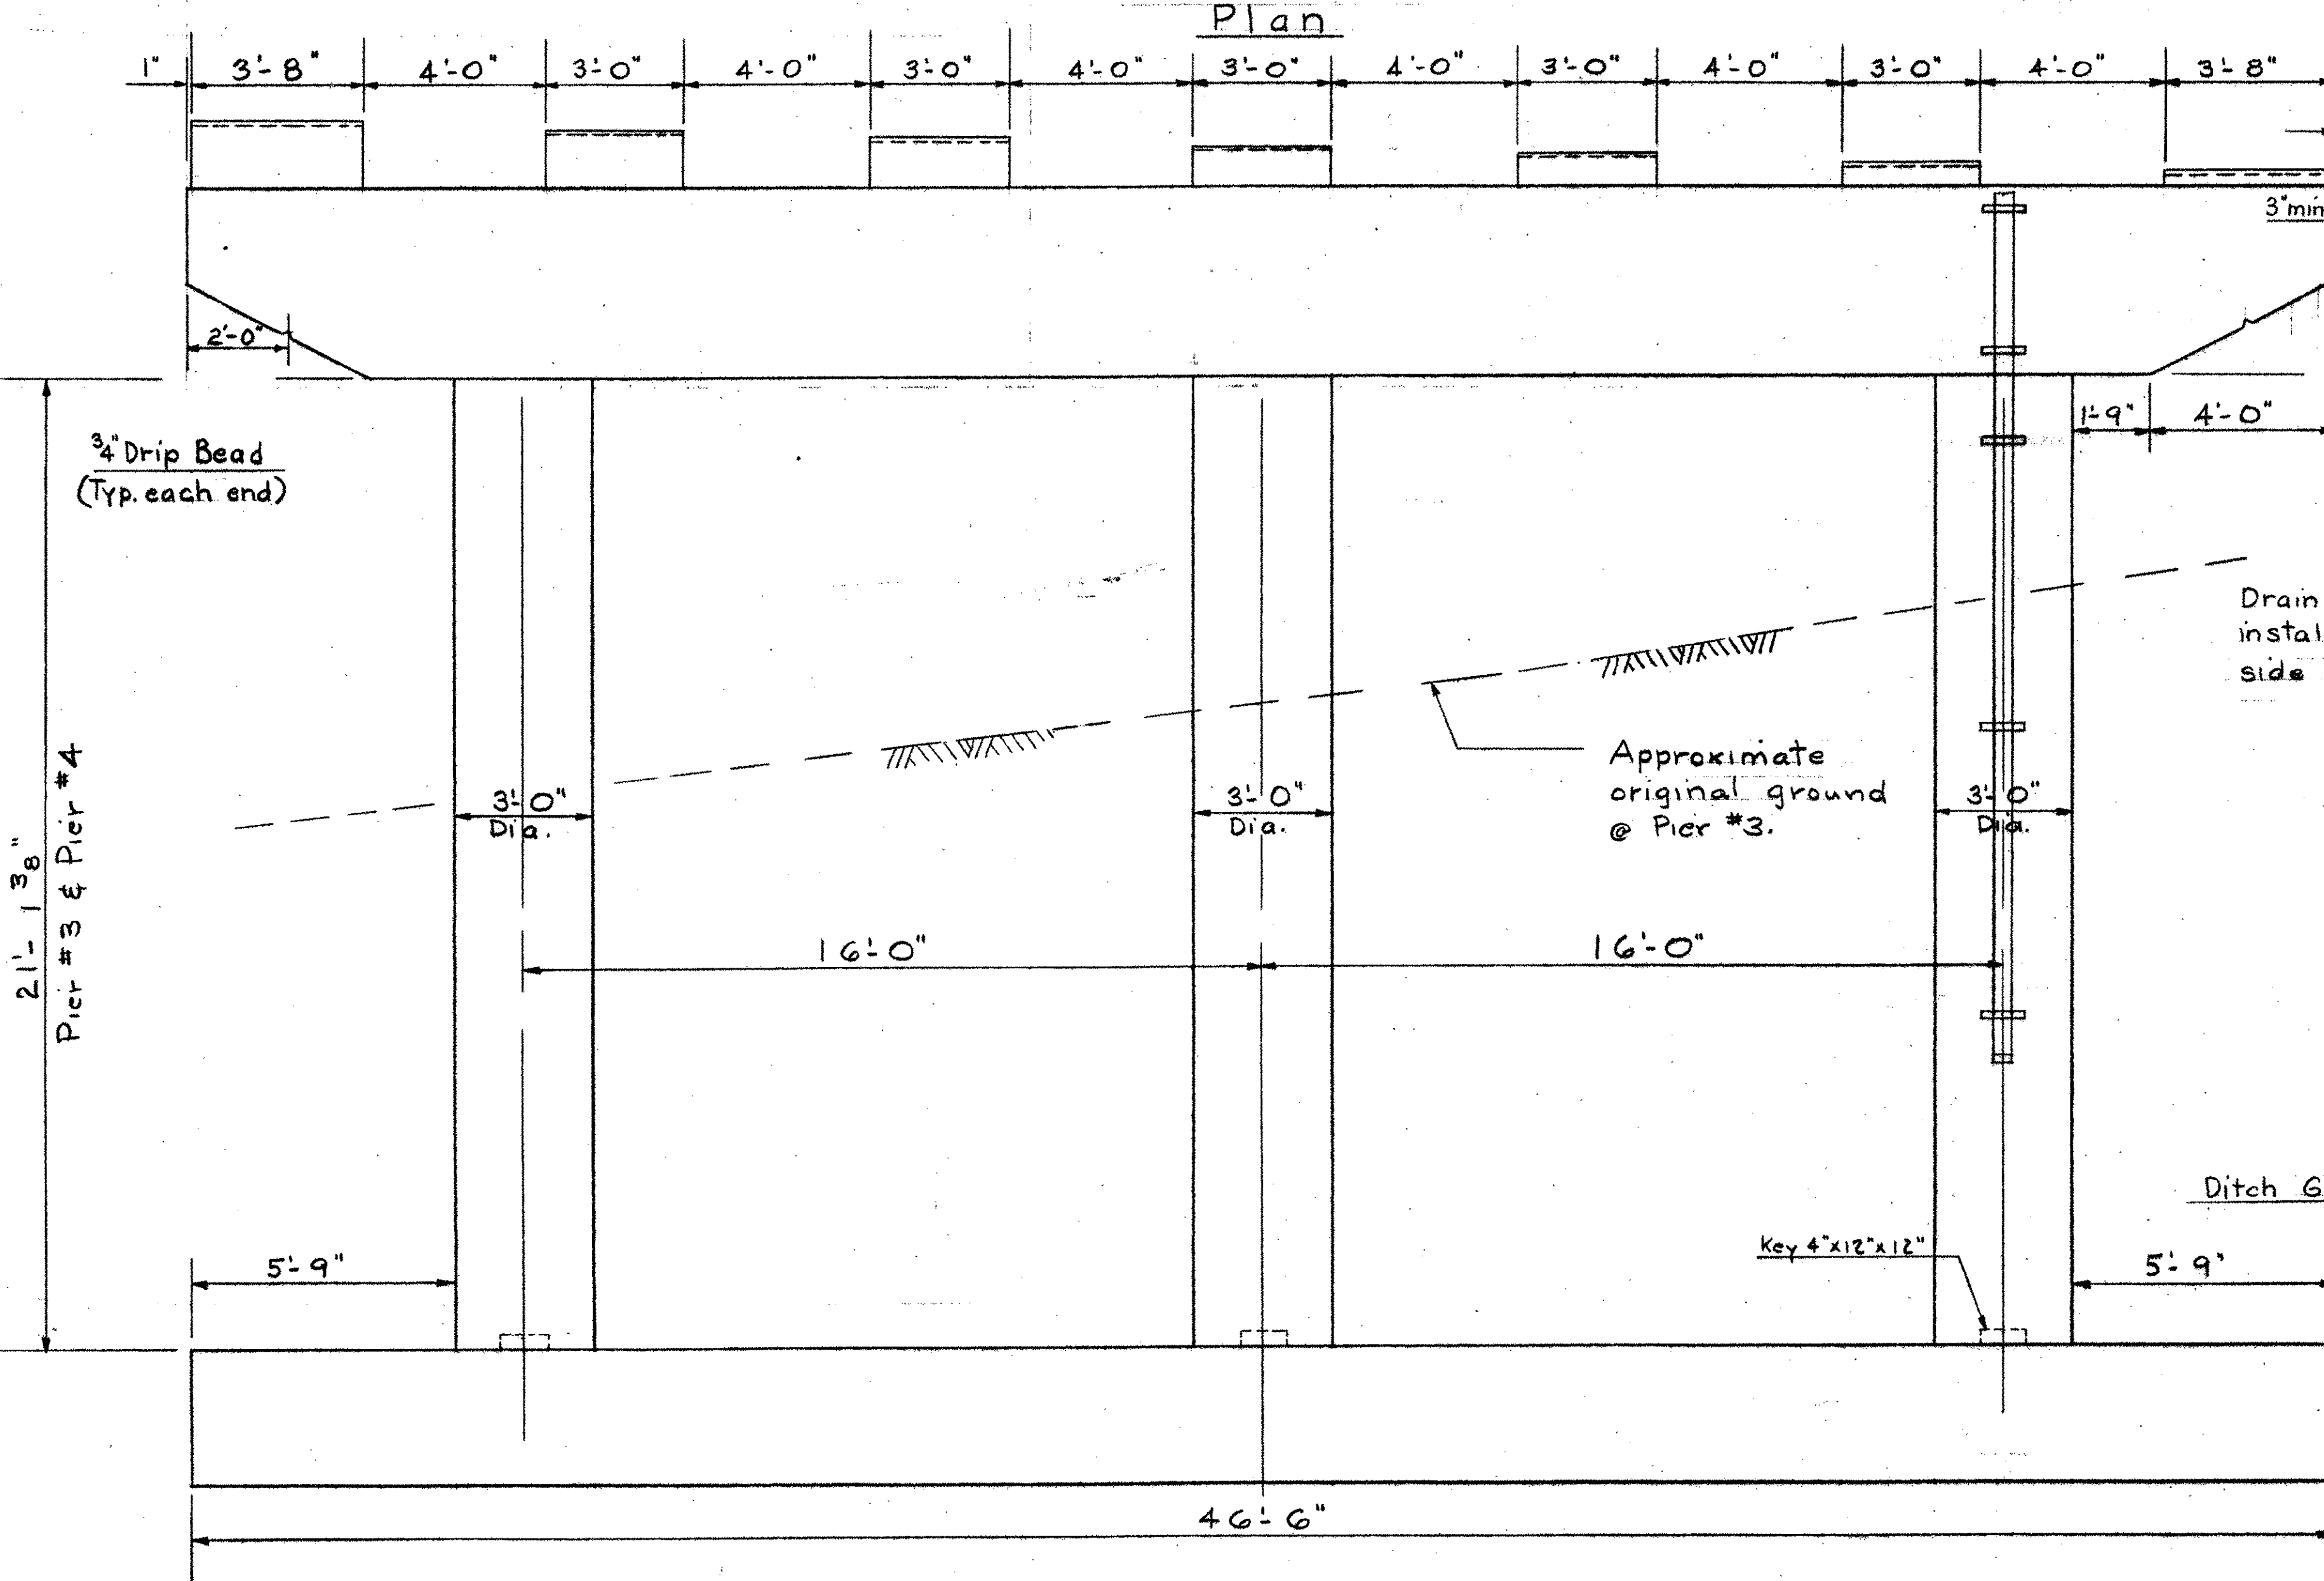


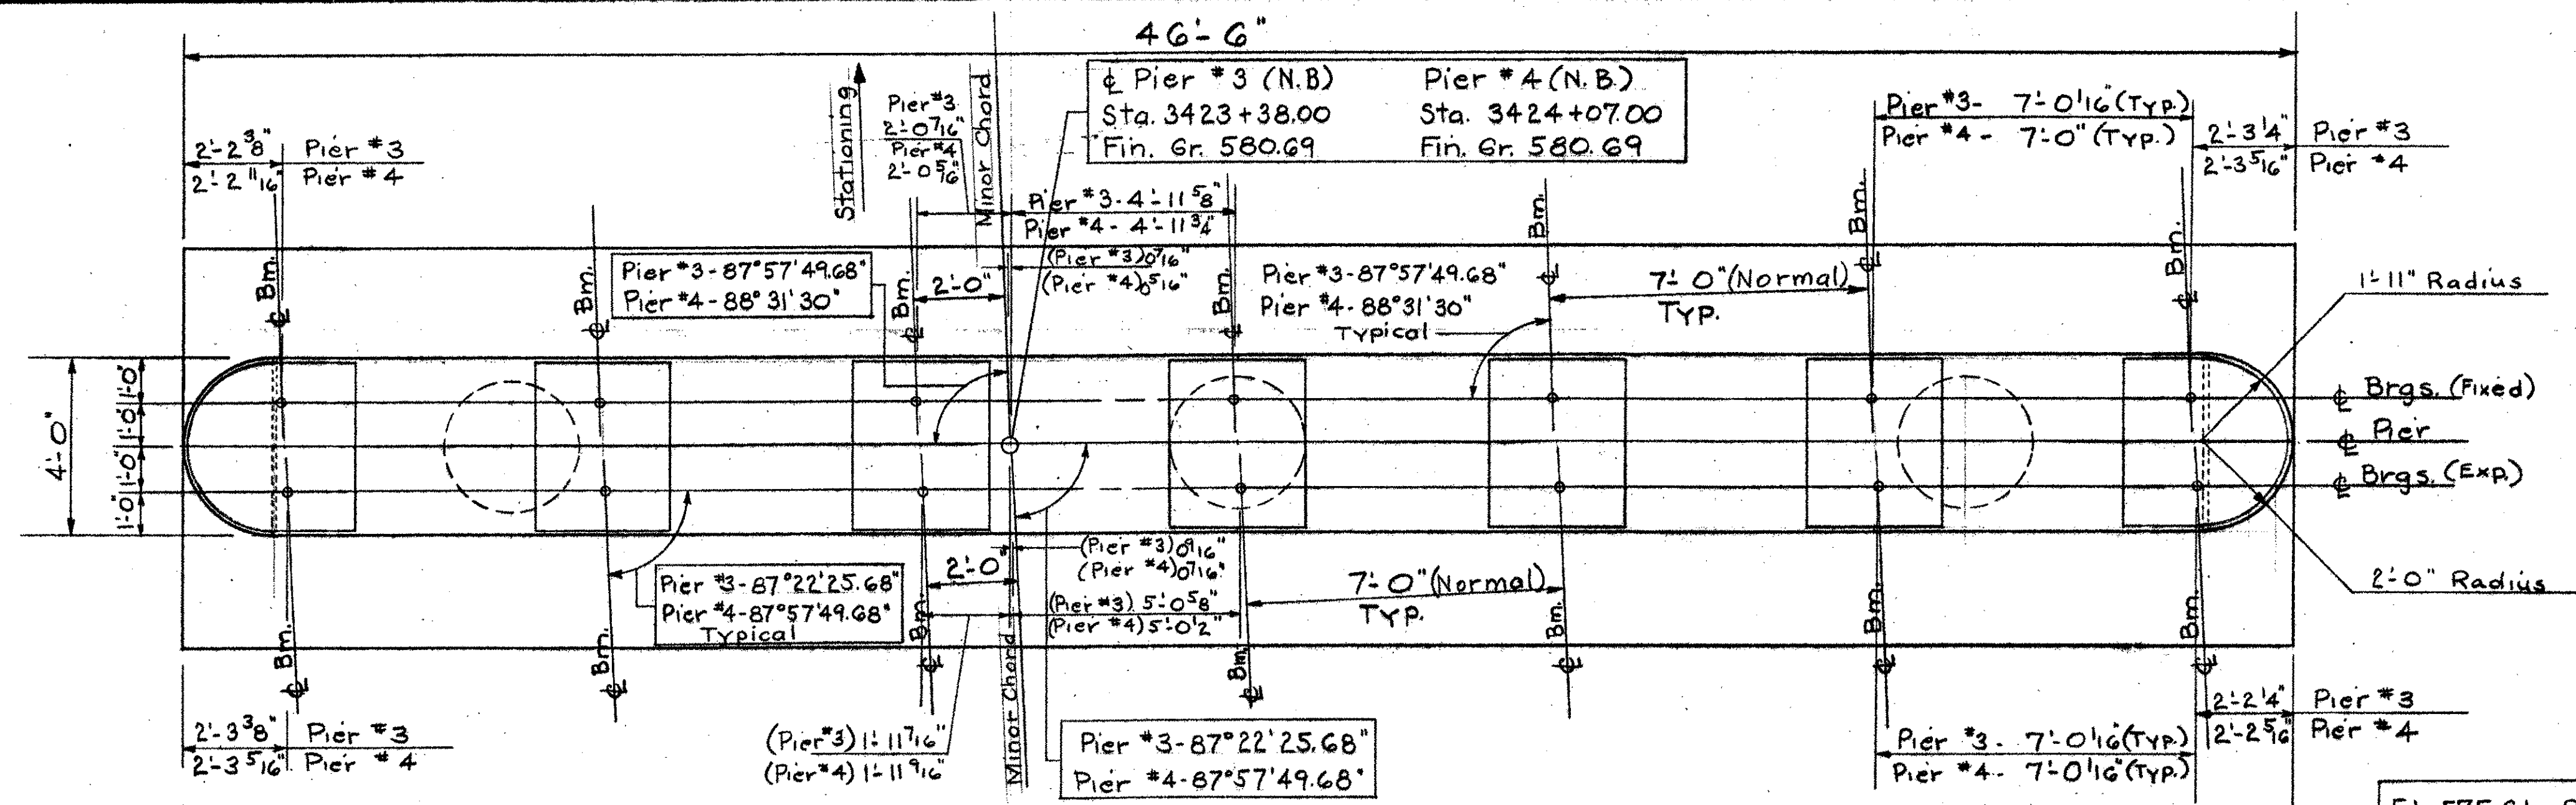

Elevation - Pier #3
Pier #4 same except as noted.

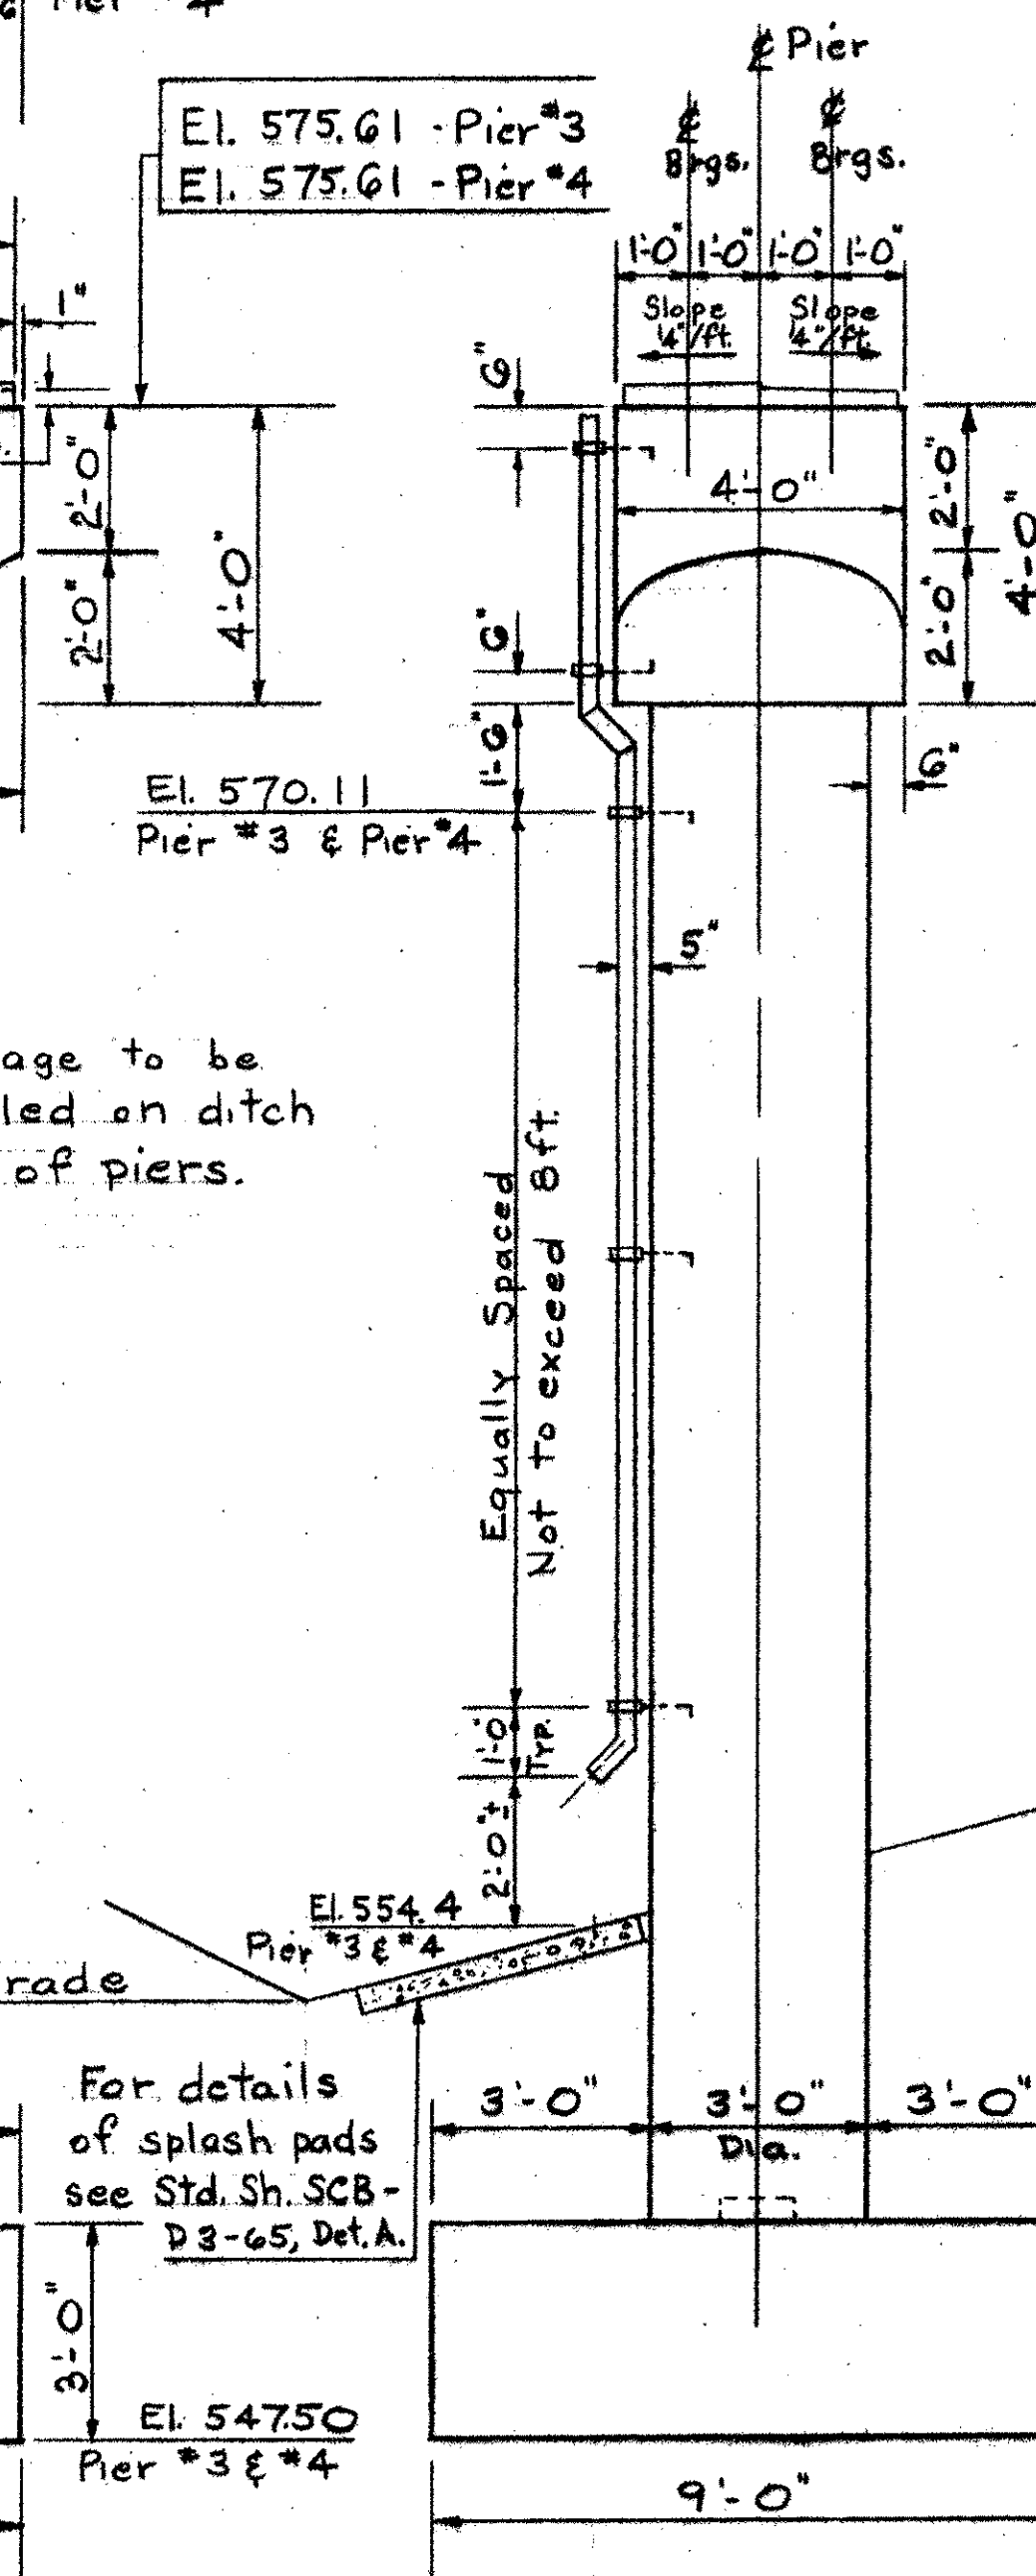

End Elevation

Bm.*19	El. 577.09	El. 577.00	Bm.*26	El. 577.00	El. 577.09	Bm.*33
Bm.*20	El. 576.91	El. 576.82	Bm.*27	El. 576.82	El. 576.91	Bm.*34
Bm.*21	El. 576.73	El. 576.64	Bm.*28	El. 576.64	El. 576.73	Bm.*35
Bm.*22	El. 576.55	El. 576.46	Bm.*29	El. 576.46	El. 576.55	Bm.*36
Bm.*23	El. 576.37	El. 576.28	Bm.*30	El. 576.28	El. 576.37	Bm.*37
Bm.*24	El. 576.18	El. 576.09	Bm.*31	El. 576.09	El. 576.18	Bm.*38
Bm.*25	El. 575.95	El. 575.86	Bm.*32	El. 575.86	El. 575.95	Bm.*39

Bridge Seat Elevations

Note:
For Pier Notes see Pier #1 & #2 Layout
Details sheet BR-214.

BRIDGE SHEET BR462
REFERENCE SHEET 8 OF 37
SHEET 214 OF 370

Stage 1 Construction
CONTRACT 2

STATE OF VERMONT
DEPARTMENT OF HIGHWAYS

Georgia - Fairfax -
TOWN OF Fairfield - St. Albans
ROUTE No. I 89 - LOG STA.
Pier #3 & #4 Layout Details
I 89 over Approach Road
SCALE - 3/8" = 1'-0"

DRAWN BY A.J.C. CHECKED BY J.J.C.
PROJECT No. I 89-3(35) Cont. #2
SHEET 203 OF 467