


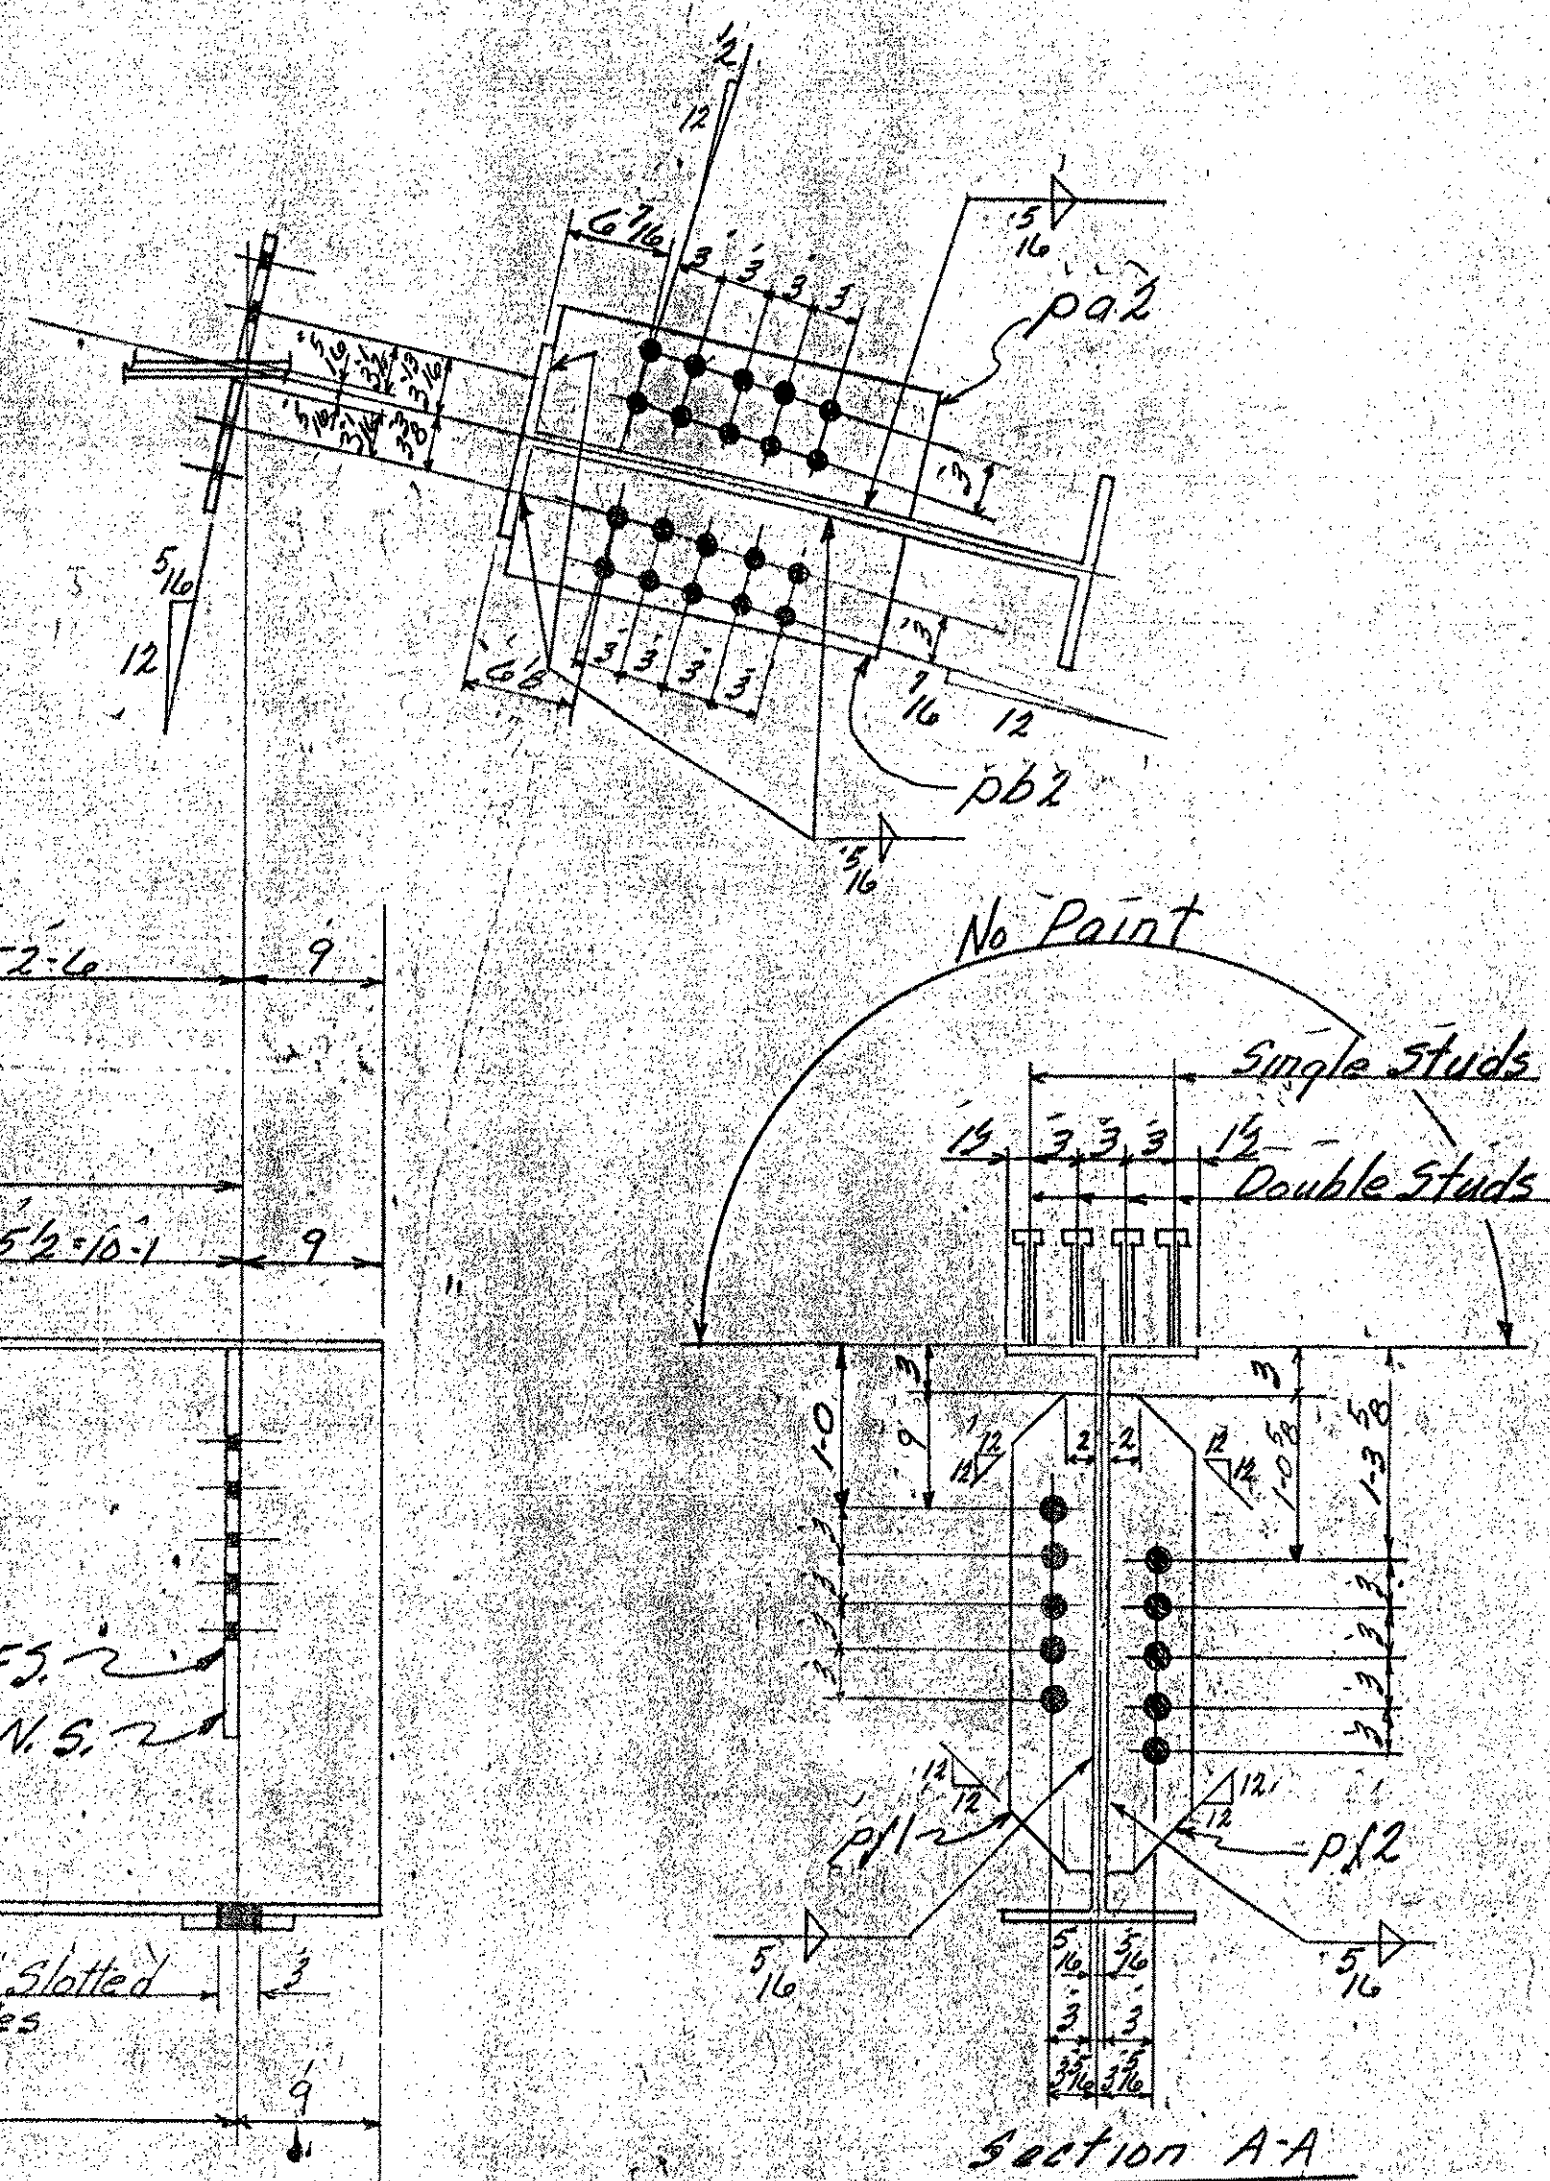

BRIDGE SHEET BR466
REFERENCE SHEET 12 OF 37
SHEET 218 OF 370

[illegible]

JOB NO.		SHEET NO.			
ASTM-A36		BILL OF MATERIAL			
		(17)			
NO. PIECES	MARK	DESCRIPTION	LENGTH		WEIGHT
			FT.	IN.	
		Beam			
1	BB2	36 WF 135	53	3	ord BB66B2 7189
1	pal	Bar 3 x 3	27	1	ord BB6679 3684
1	pal	Bar 7 x 1	1	1	RES @ 20-0
1	pal	do	1	1	
1	pal	Bar 4 x 4	1	7	RES 4 x 4 10-0 13
1	pal	Bar 3 x 3	2	0	ord 10-0
1	pal	do	2	0	BB6679 54
2	pal	Bar 5 x 3	2	6	RES @ 20-0
2	pal	do	2	6	
		2" Weld	2	4	2
		5/16" Weld	24	9	31 121
					7784
		Cont. 46-1184-226			
366		3/4" Shear Studs	0	7	STK 368
					8162

VERMONT STRUCTURAL STEEL CORPORATION BURLINGTON, VT.				Proj No 107-3(35) *2	
DATE		PROJECT	PRINT RECORD		
DRAWN BY	LC 11-8-66	LOCATION	I-89 Over Approach Road Georgia Carfax Fairfield St. Hills		
OK'D BY	RLM 11-8-66	CUSTOMER	Lane Constr Co		
HOLES		ARCHITECT	NO.	APP	DATE
1/2" (As Noted)		State Of VT Dept Of High.	3	APP	11-29
BOLTS		JOB NO. 66-1184-200 SITE SHEET NO. 2	2	SHOR	11-29
PAINT		66-1184-220 Shear Studs	20	SLUP	12-5
Red Lead			2	STATE	12-8
As Specified			2	LANE	12-28