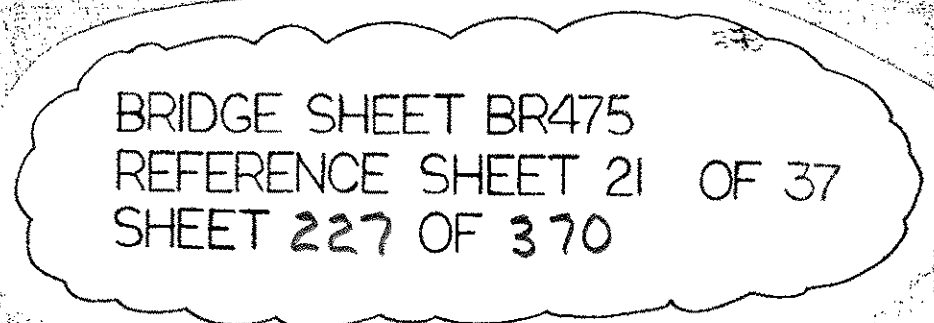
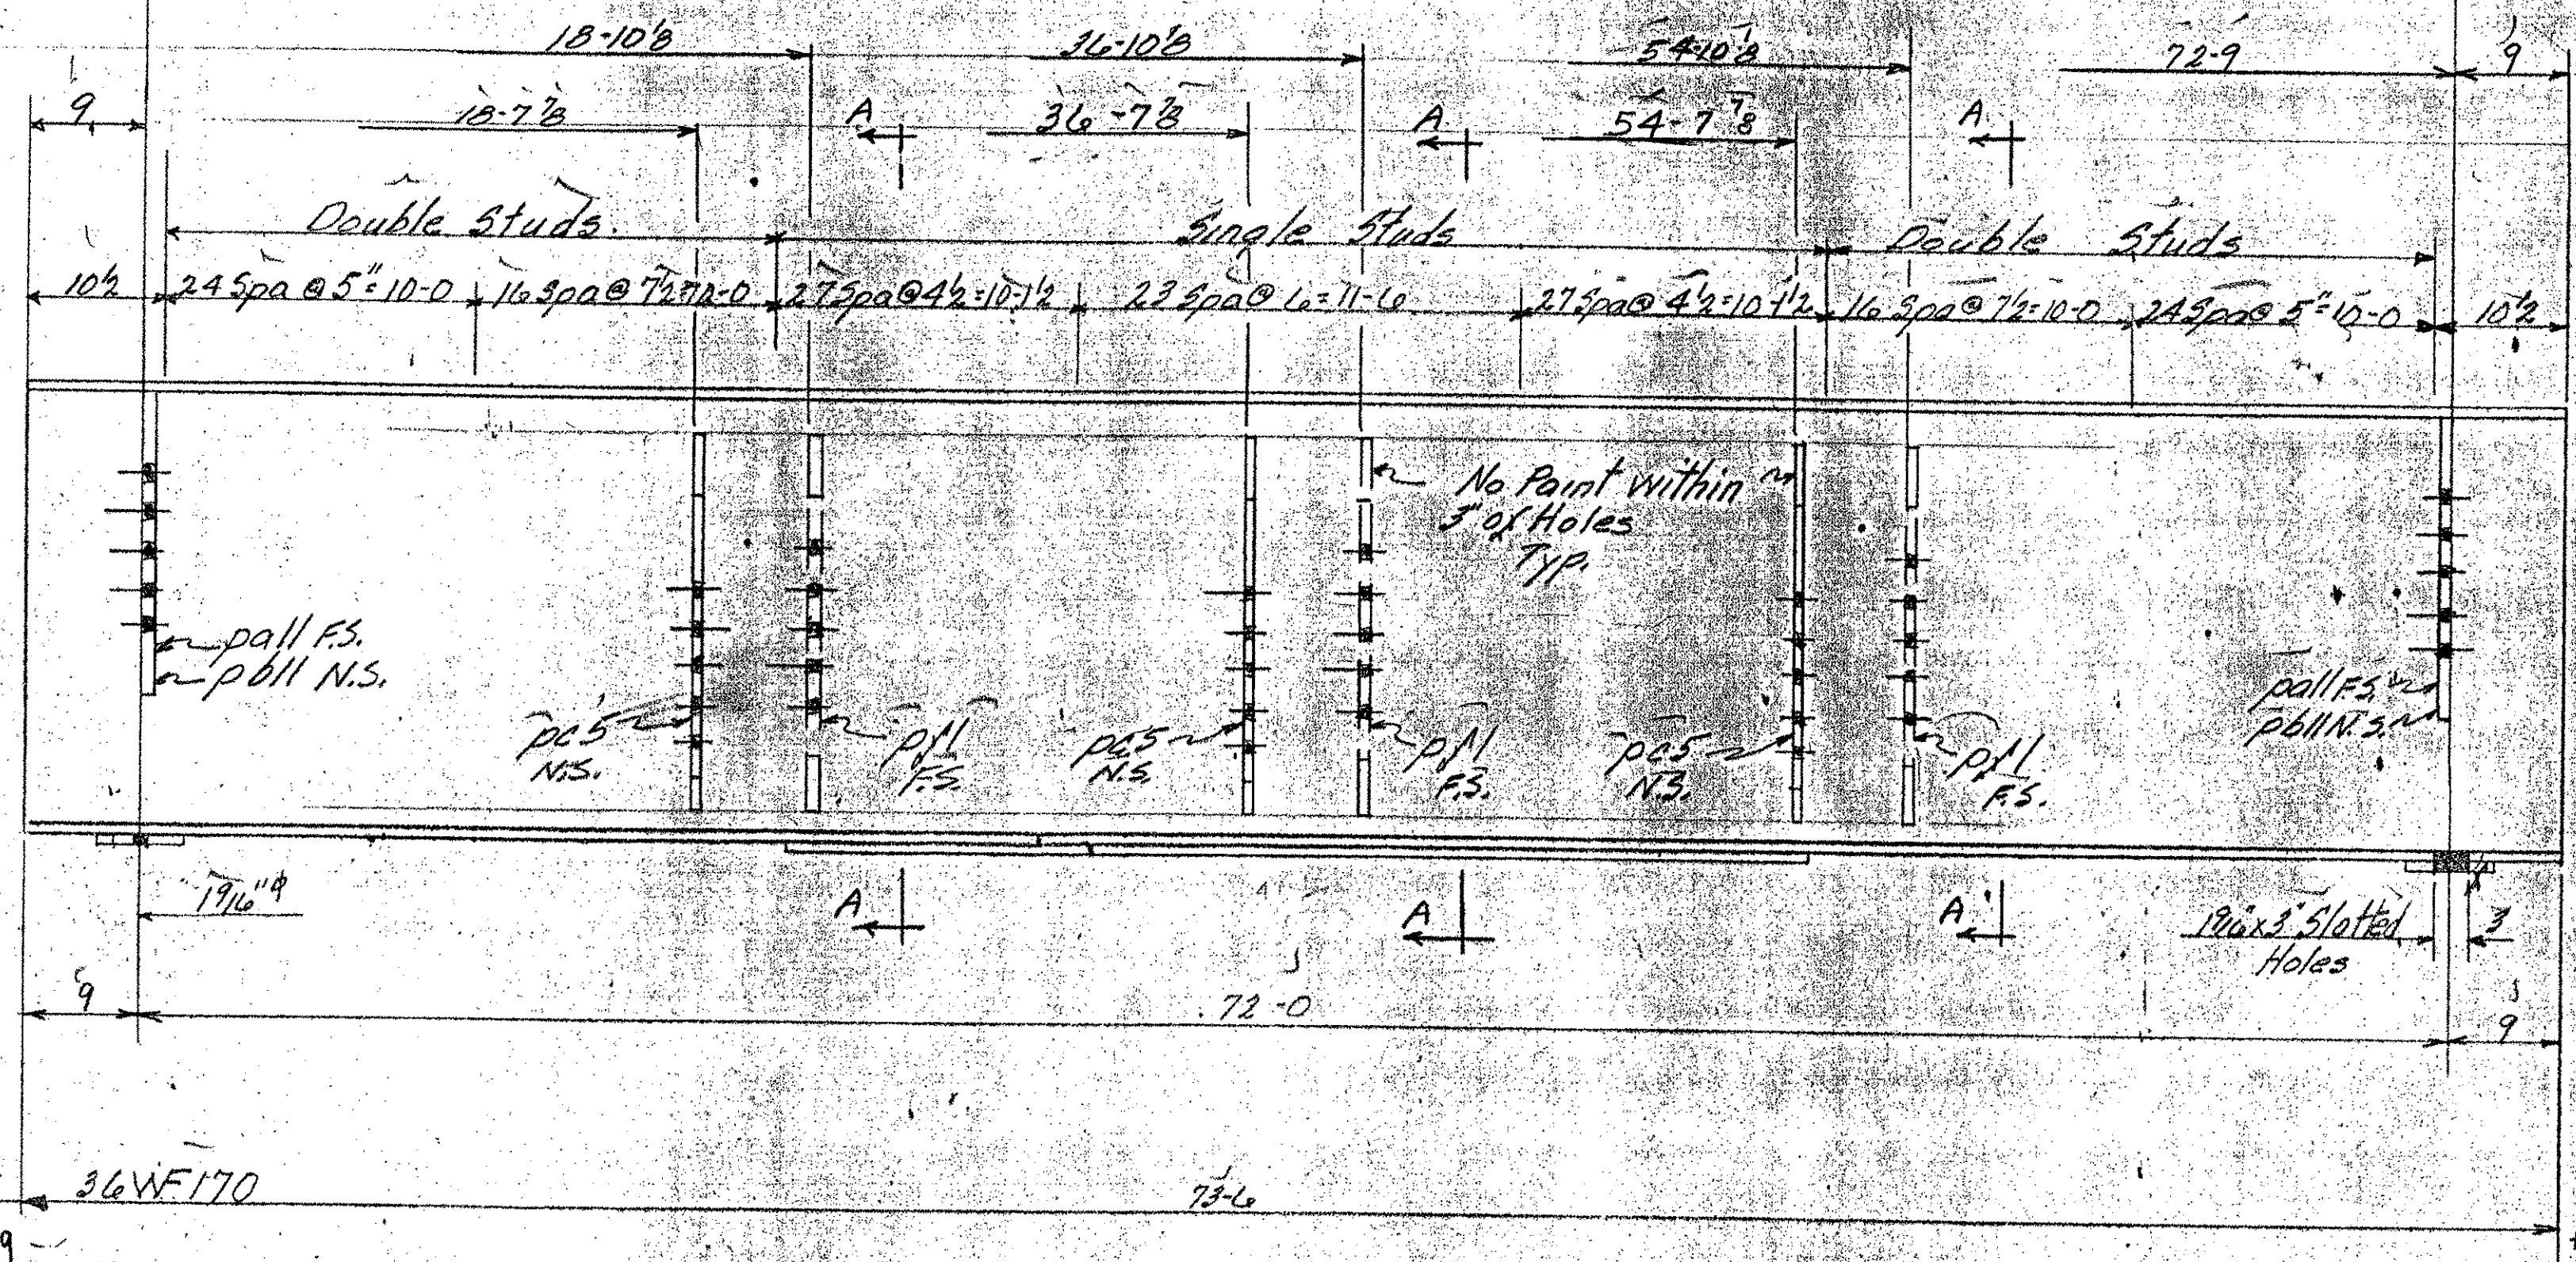
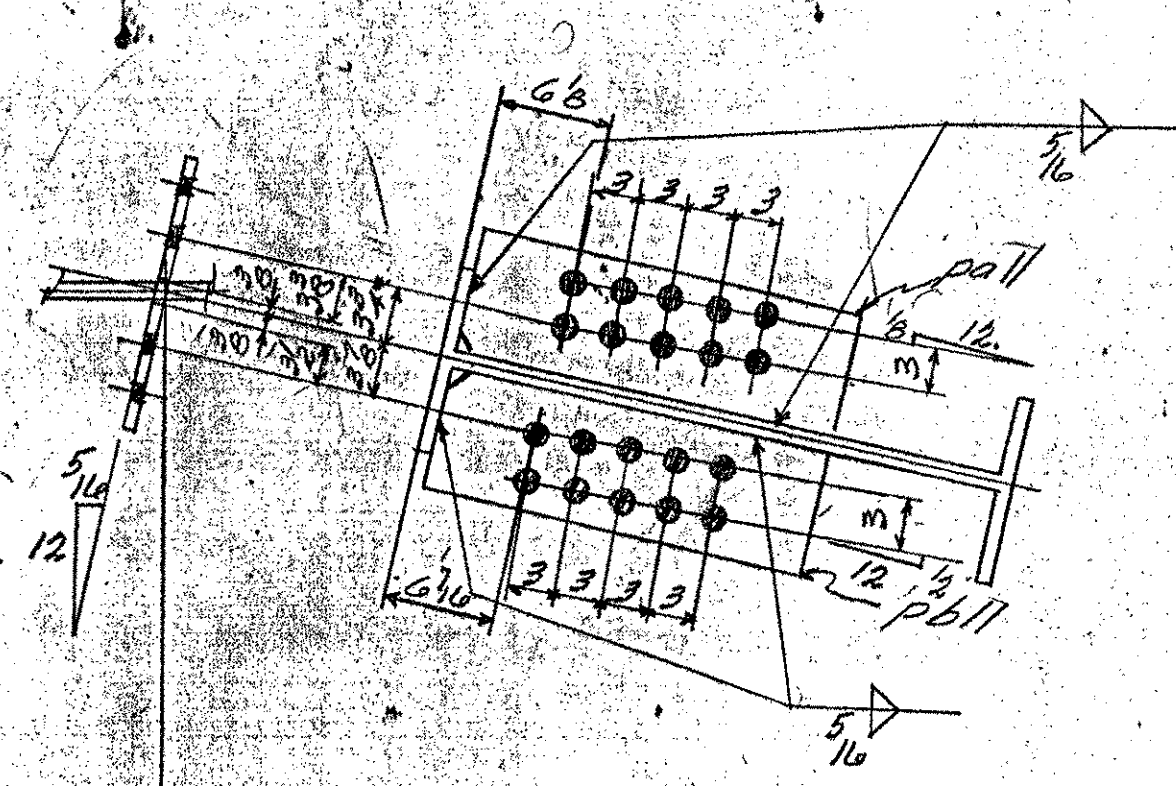


[illegible][illegible]