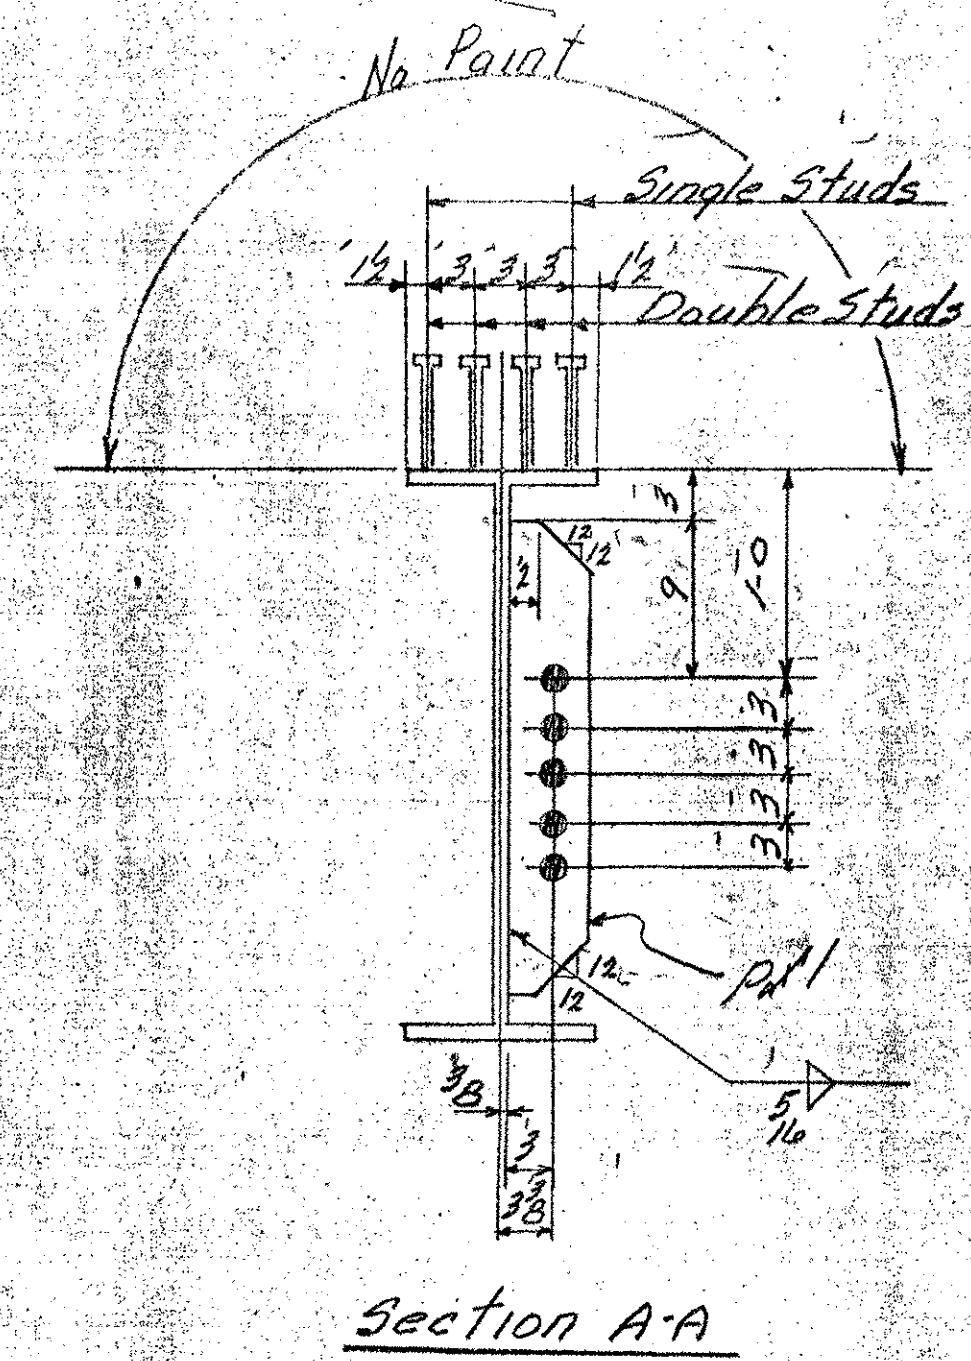
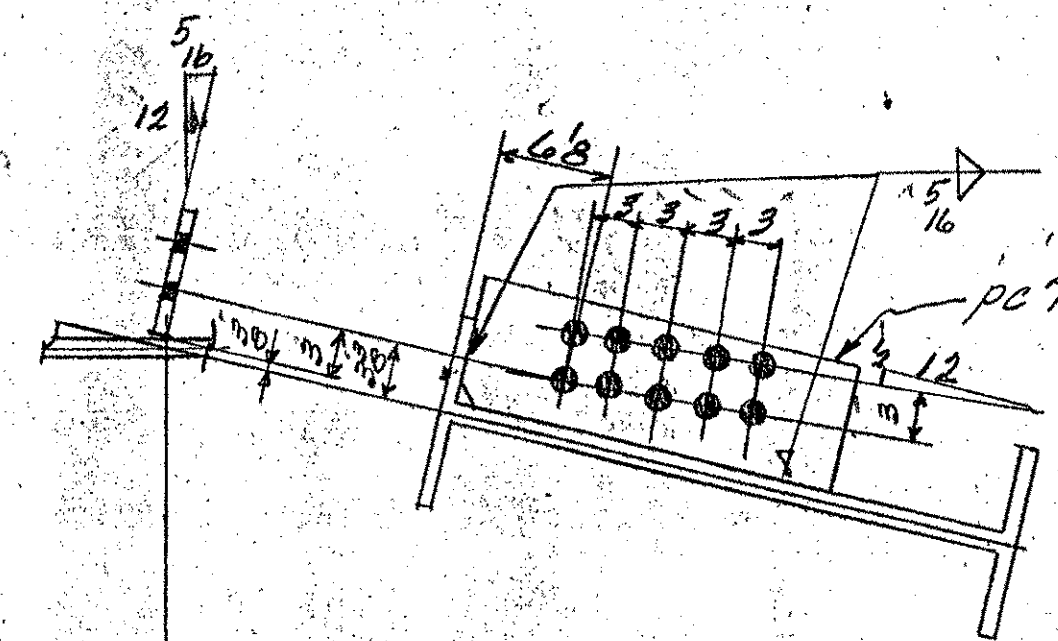
[illegible]

			VERMONT STRUCTURAL STEEL CORPORATION BURLINGTON, VT.		Proj. No 189-3135-J2				
		DATE	PROJECT 189-Over Approach Road			PRINT RECORD			
DRAWN BY		L.C. Villable	LOCATION Georgia - Fairfax - Fairfield - 51.816000			#	NO.	FOR	DATE
CHKD BY		RLM 11-22-66	CUSTOMER Lane Constr. Co.			5	APP	11-2	
MOLES 15, 10, 1 As Noted			ARCHITECT State of Vt. Dept. of Highways			2	SHOP	11-2	
BOLTS Name			JOB NO. 66-1189-200 STR. C. SHEET NO. 13			2	SHOP	12-5	
PAINT Red Lead Vt.			66-1189-226 Shear S. Tuds			2	STATE	12-8	
Specs. 195 Noted						2	LANE	12-28	