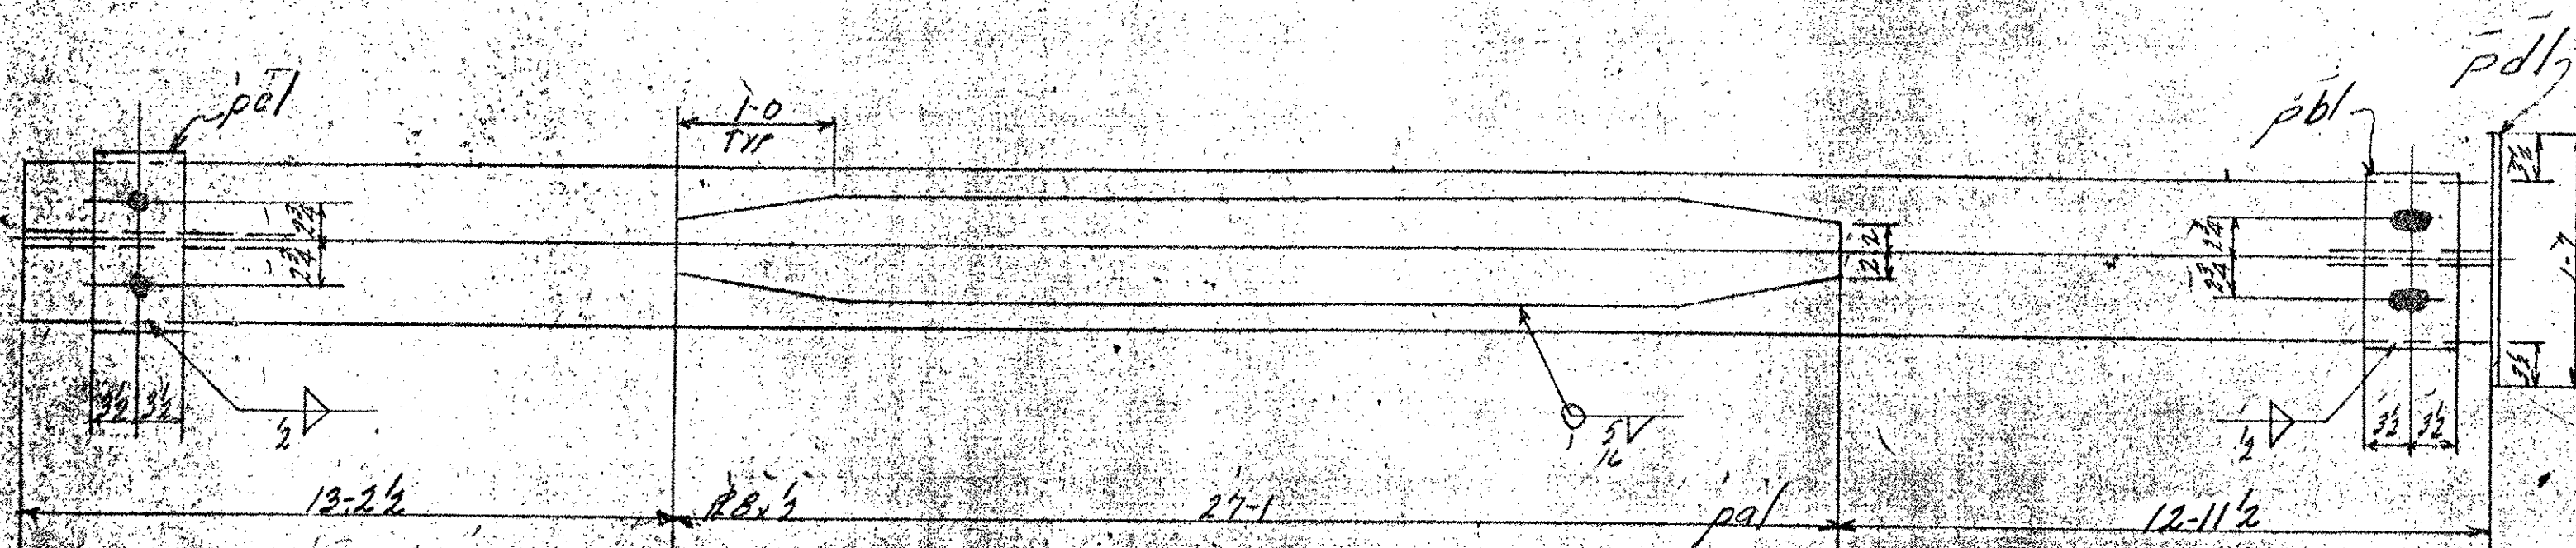


VERMONT STRUCTURAL STEEL CORPORATION BURLINGTON, VT.			Pay # 189-3135-13 PROJECT <i>I89 Over Approach Road</i> LOCATION <i>Georgetown, Fingert, Fagblet St. Albans</i> CUSTOMER <i>Lane Const. Co.</i>	
DRAWN BY	LC	DATE	PRINT RECORD	
CHK'D BY	RLM	11/8-66	NO.	FOR DATE
HOLES <i>1 1/2" Ø 2B Noted</i> BOLTS <i>Rod</i> PAINT <i>Red Lead Vt.</i> <i>Specs. 1B Noted</i>			3	APP 11-21
ARCHITECT <i>State of Vt. Dept. of Highways</i>			2P	Steel 1-21
JOB NO. <i>66-1184-240</i> SHEET NO. <i>1A</i>			20	Shop 1-25
<i>66-1184-240</i> <i>Shoor Studs</i>			2	STATE 12-8
			2	LANE 12-28