


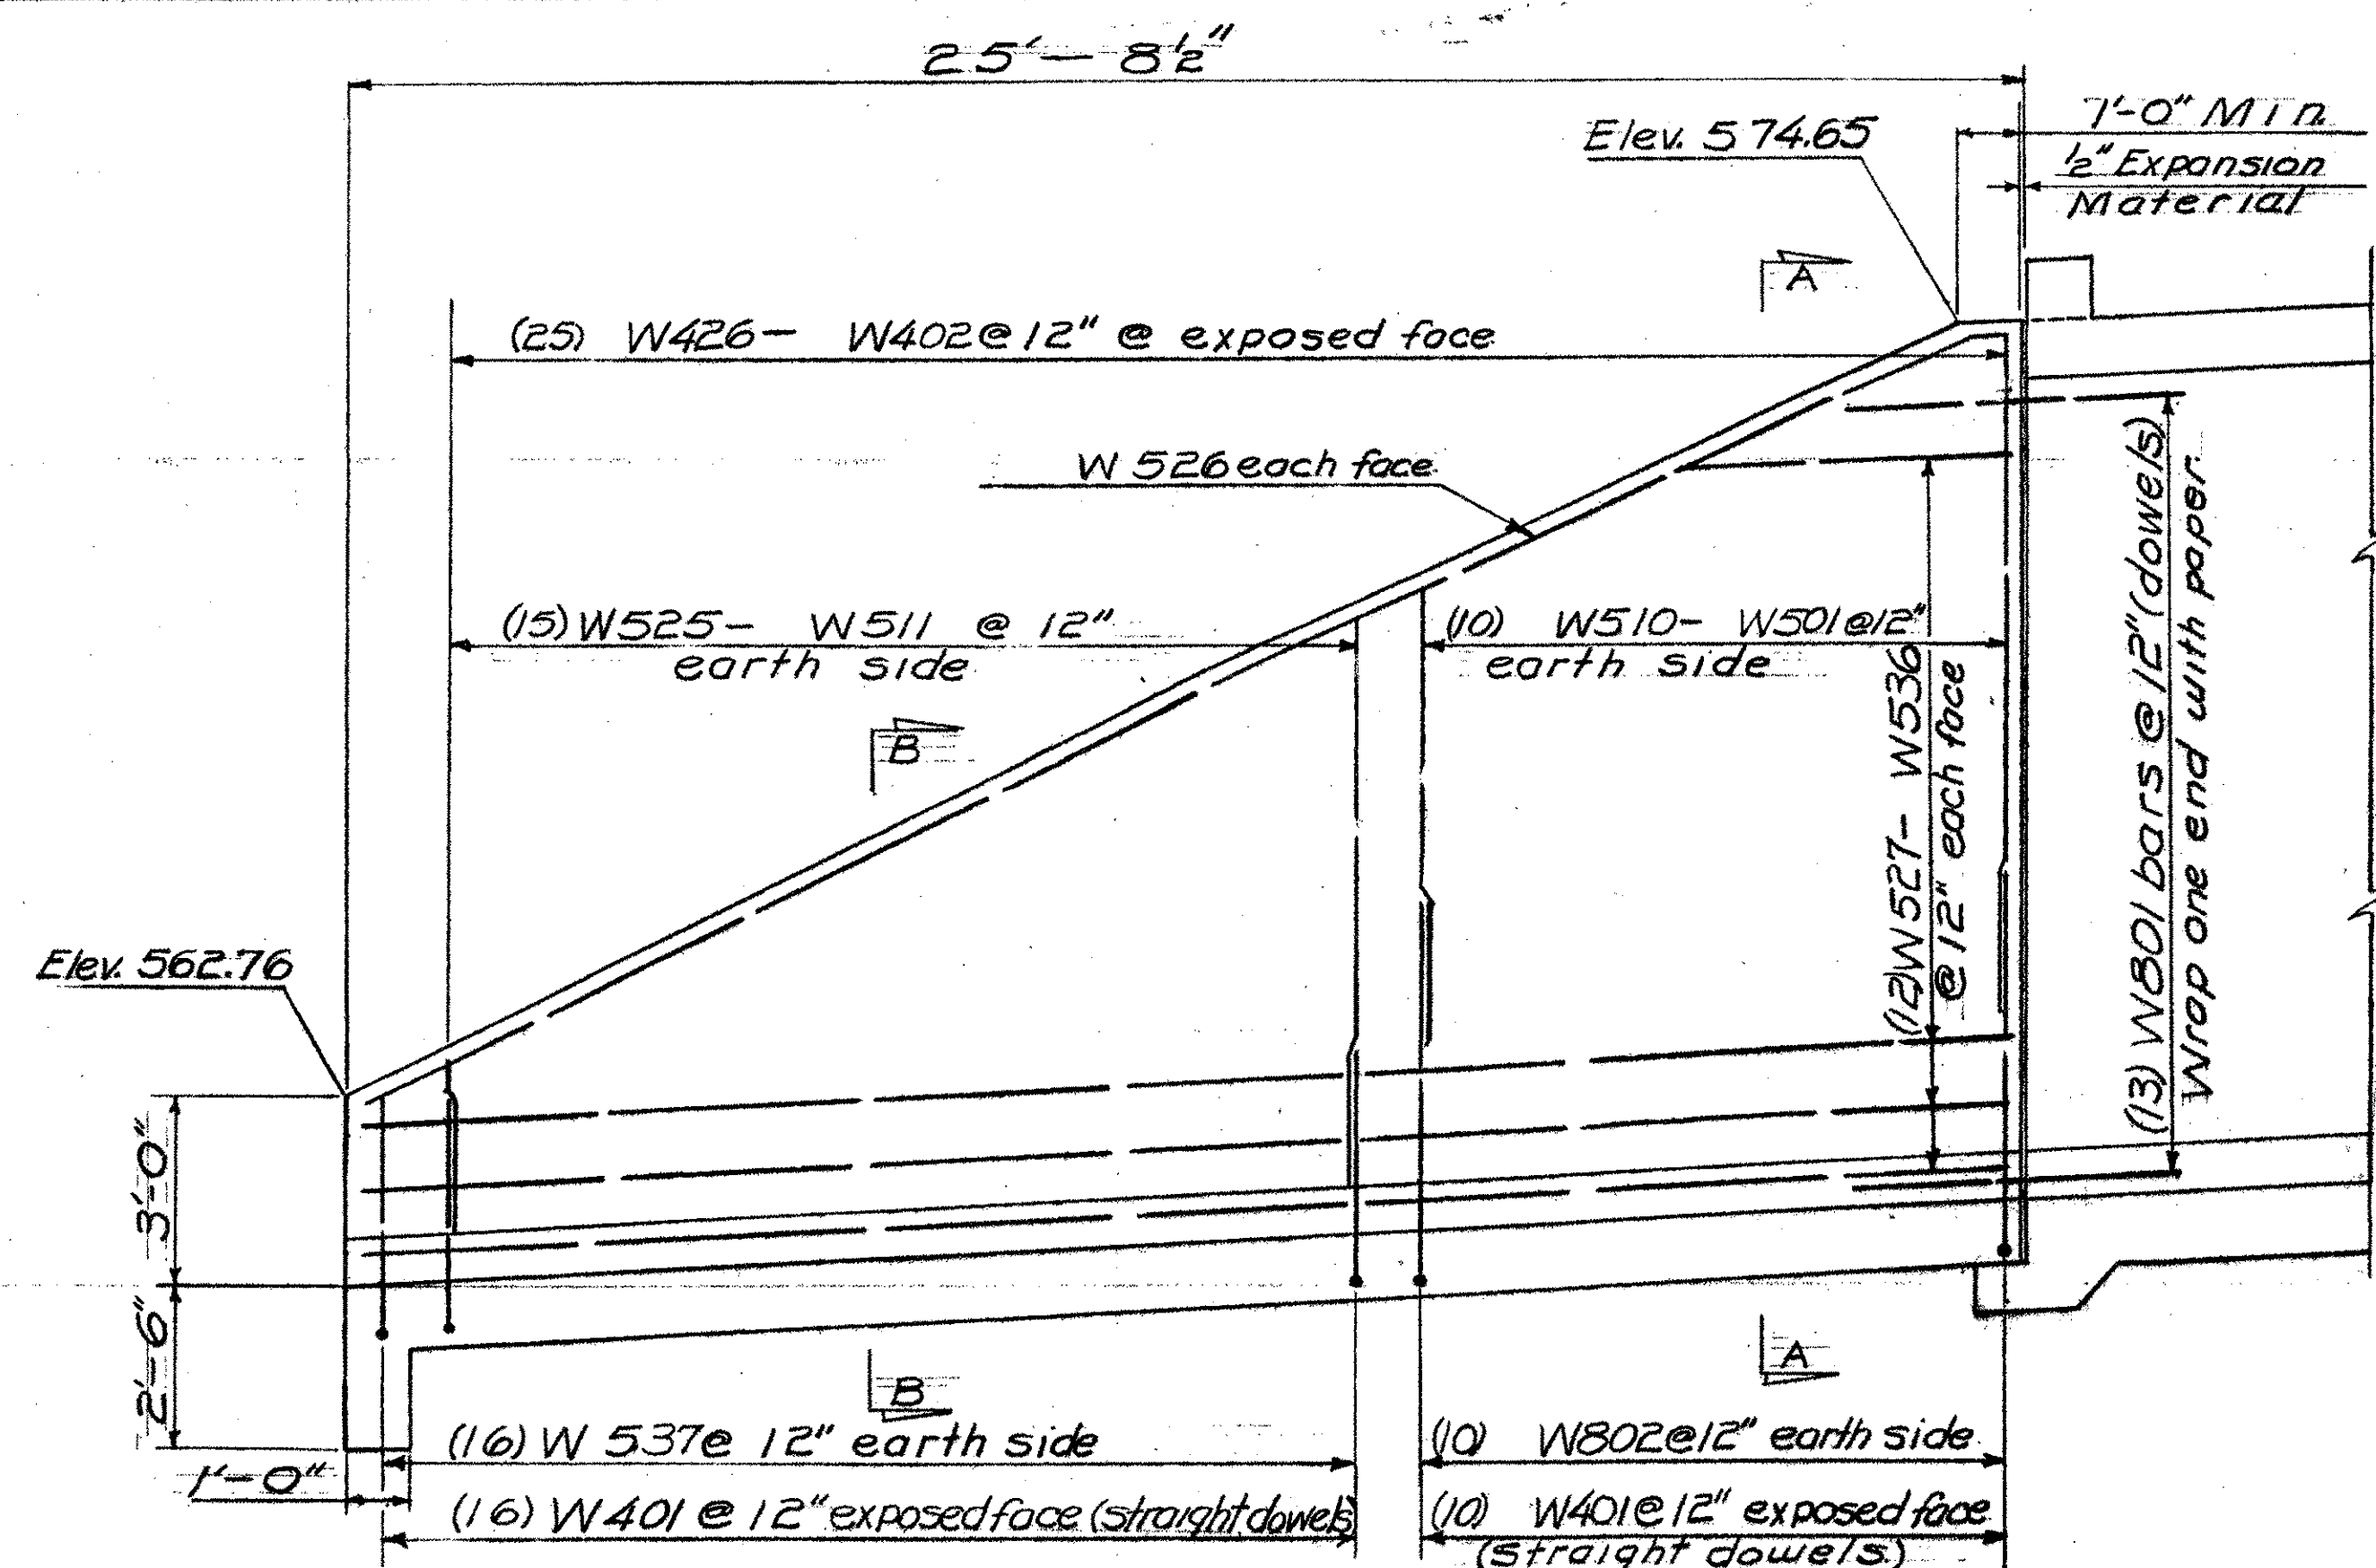


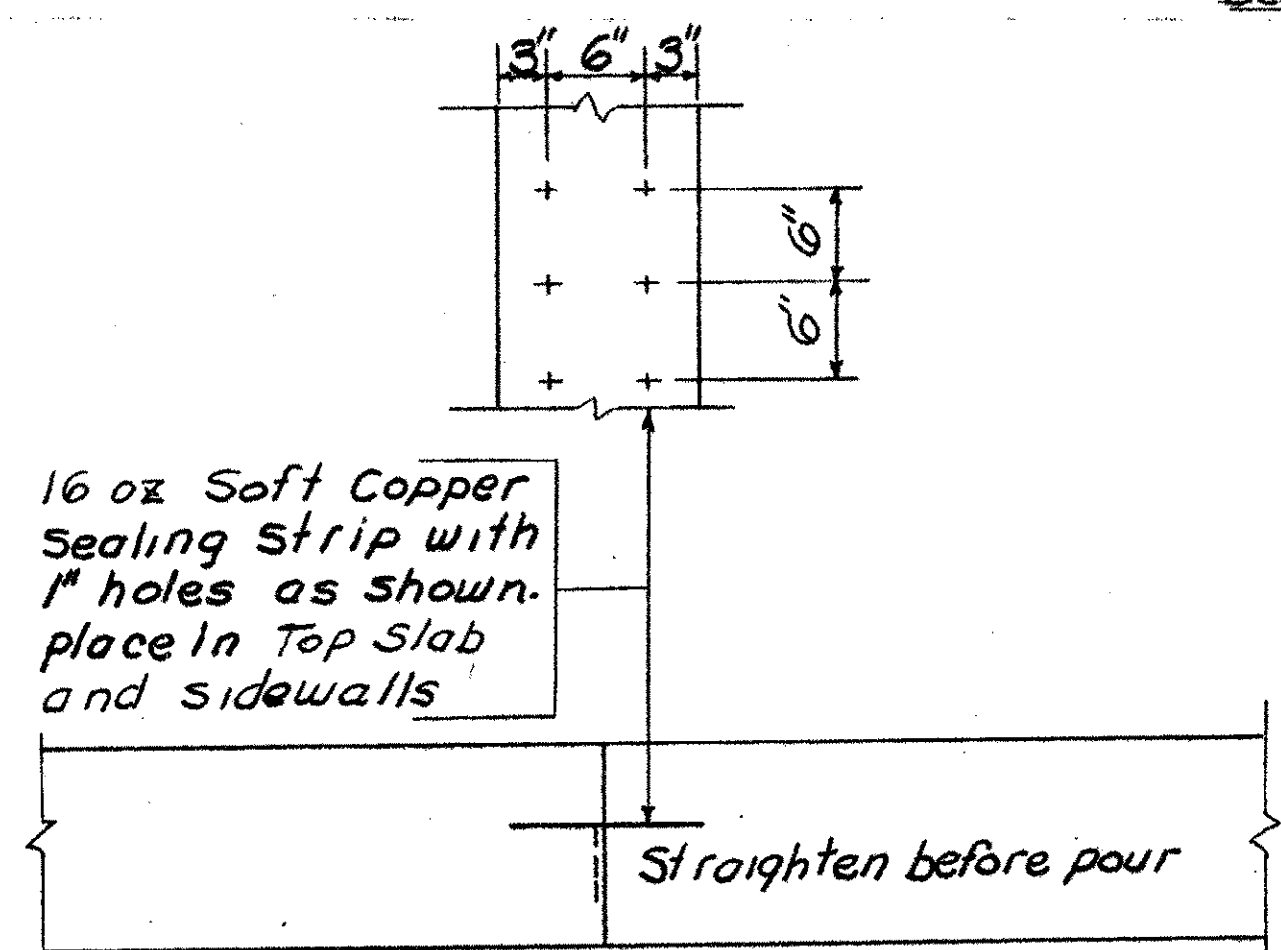


WINGS #14#2
Scale: 3/8" = 1'-0"

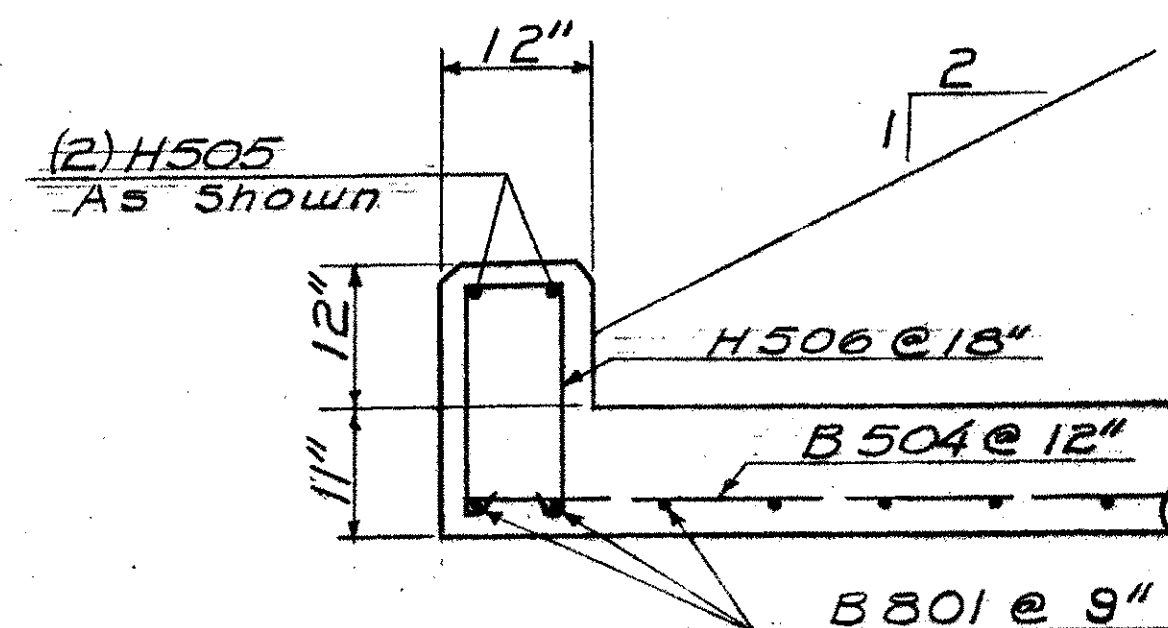

CONSTRUCTION JOINT DETAIL
Scale: 1" = 1'-0"

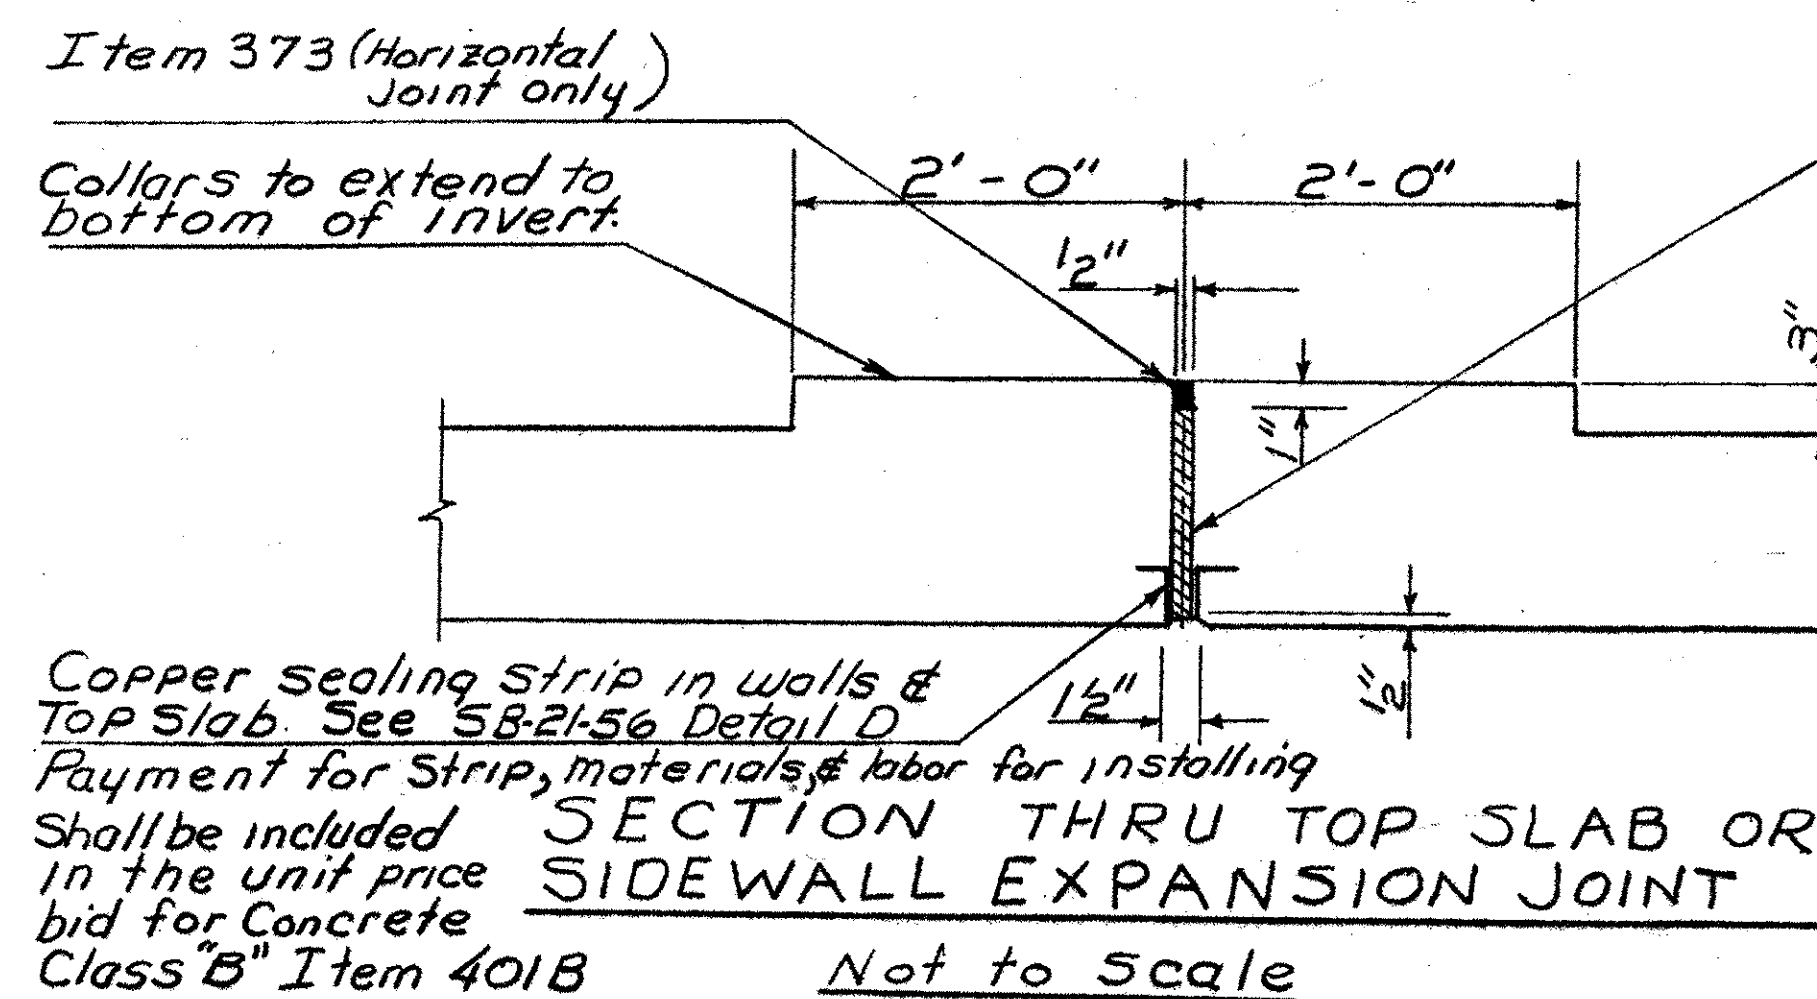



HEADER DETAIL
Scale: 3/4" = 1'-0"

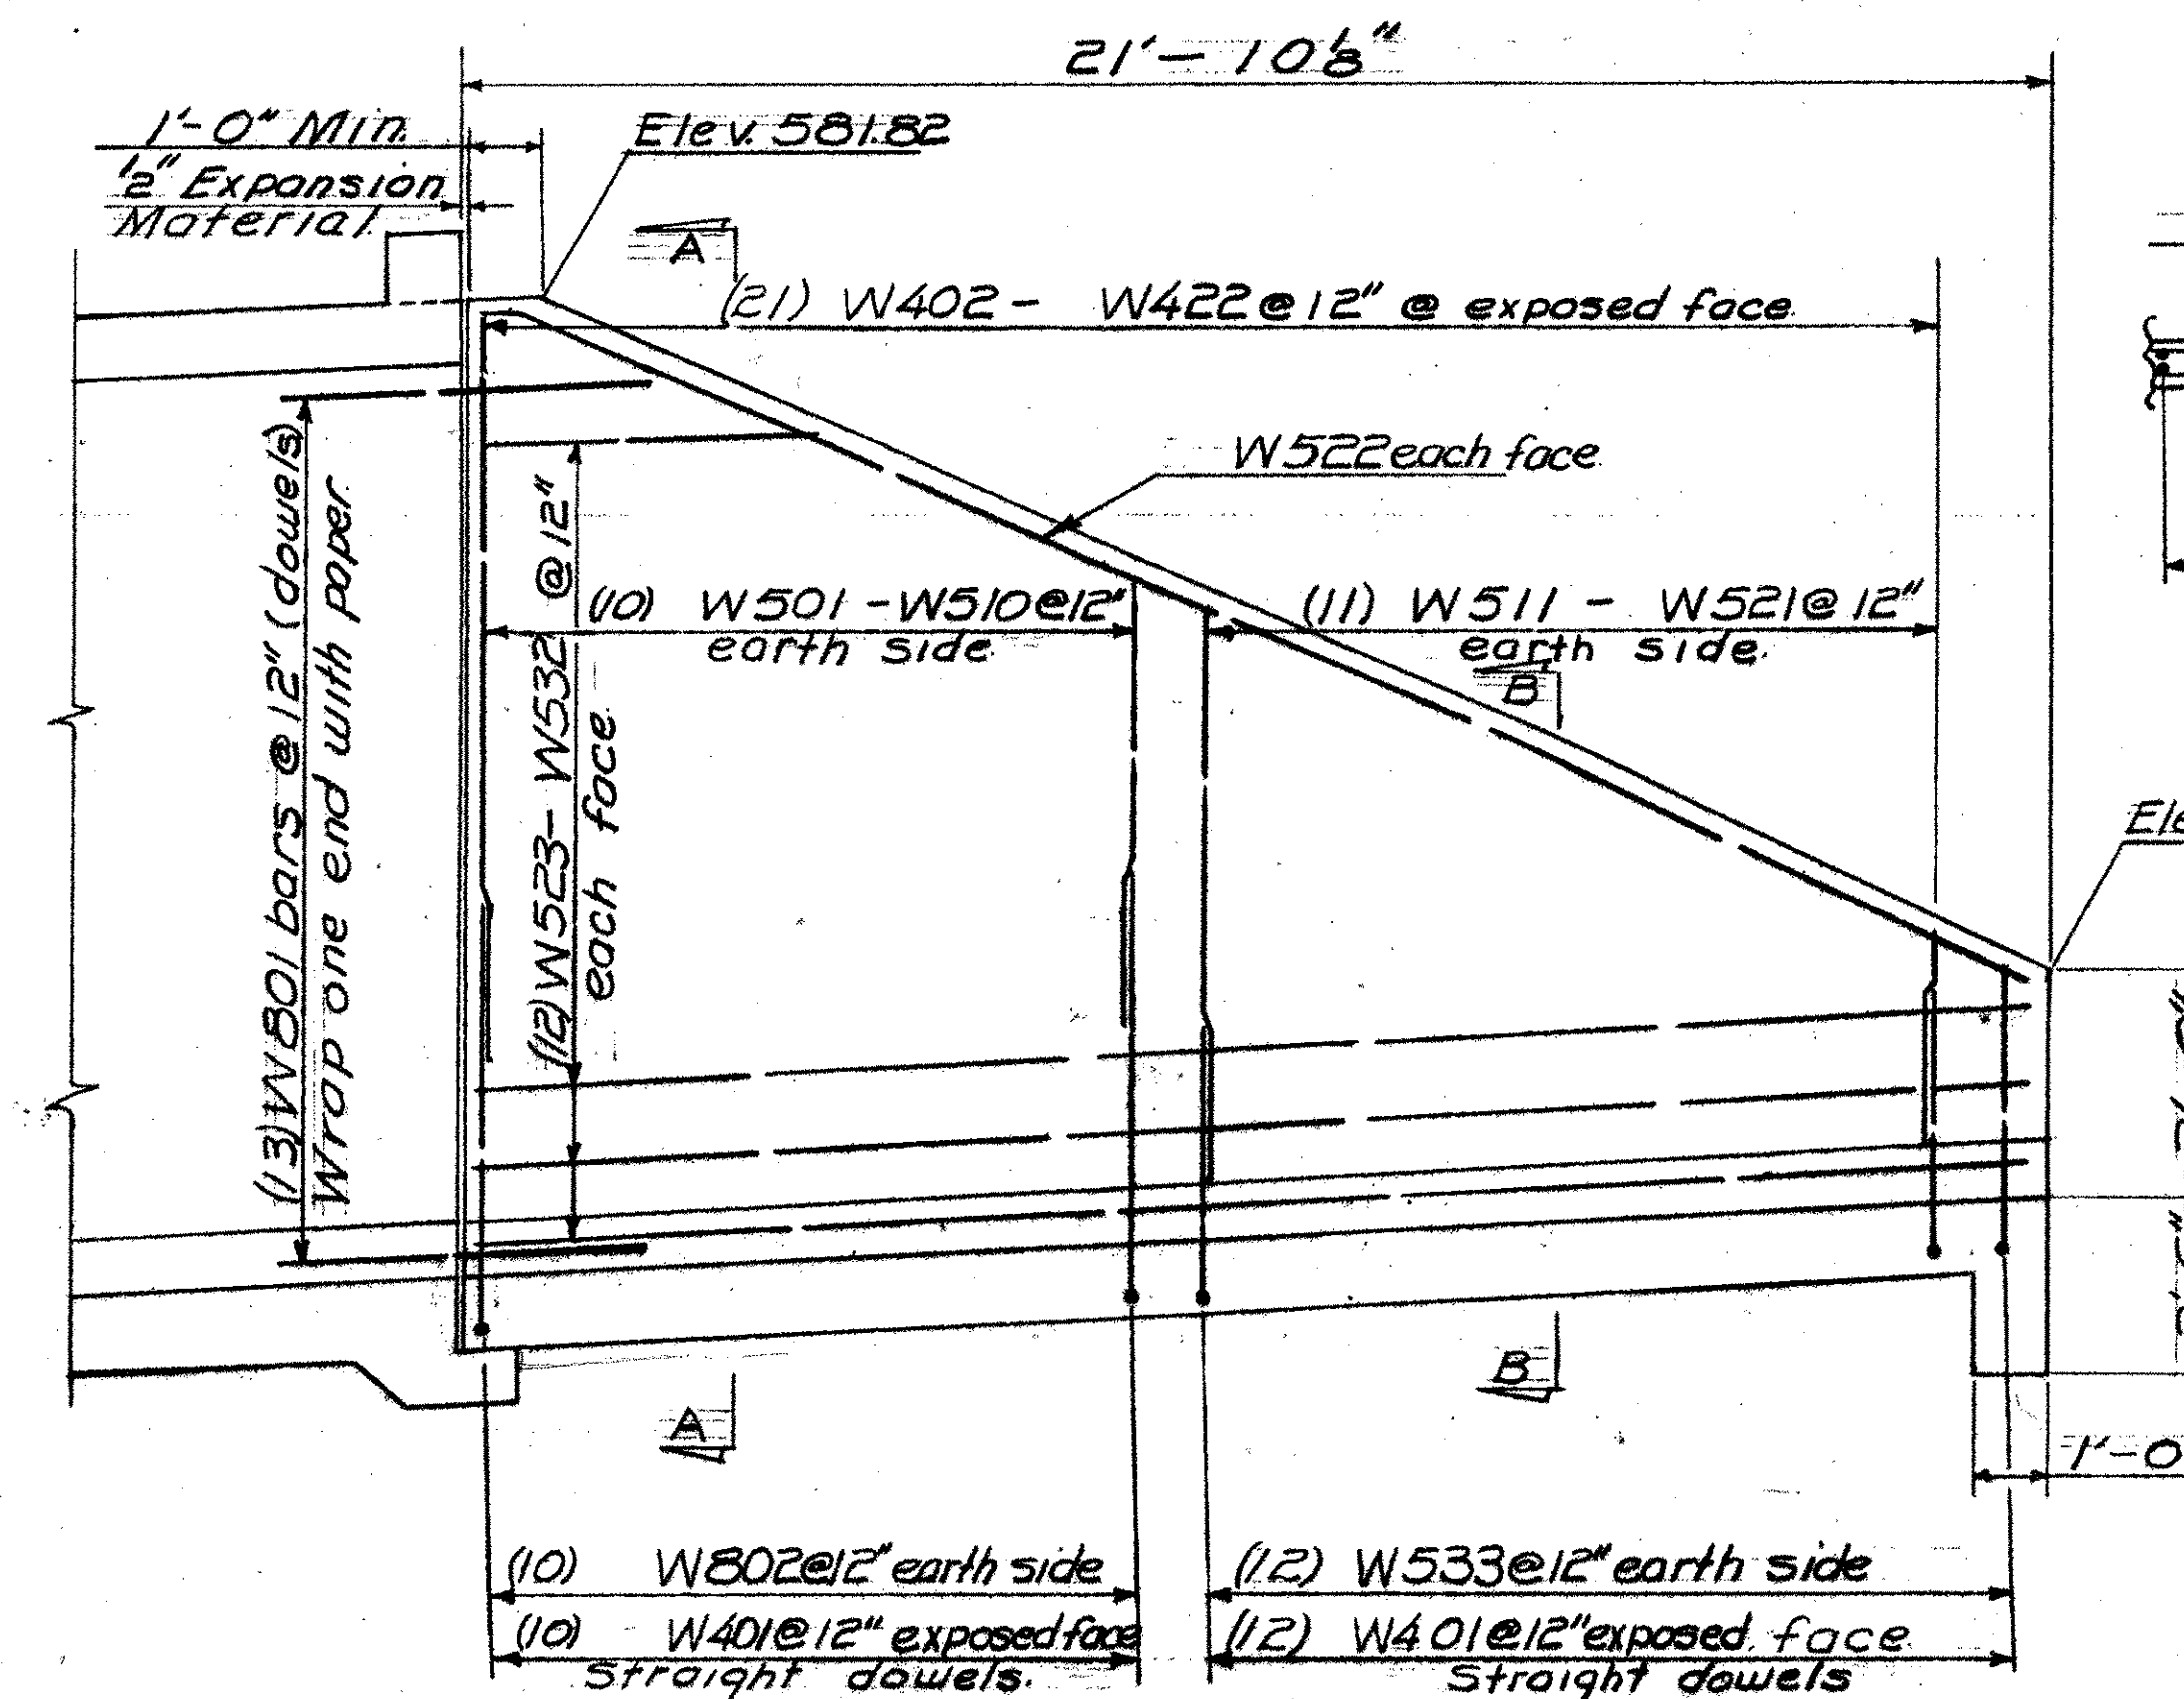


WINGS #34#4
Scale: 3/8" = 1'-0"

BRIDGE SHEET BR508
REFERENCE SHEET 3 OF 3
SHEET 252 OF 370

Premoulded Cork Expansion Material conforming to AASHTO M153 TYPE II Containing no Bituminous Material

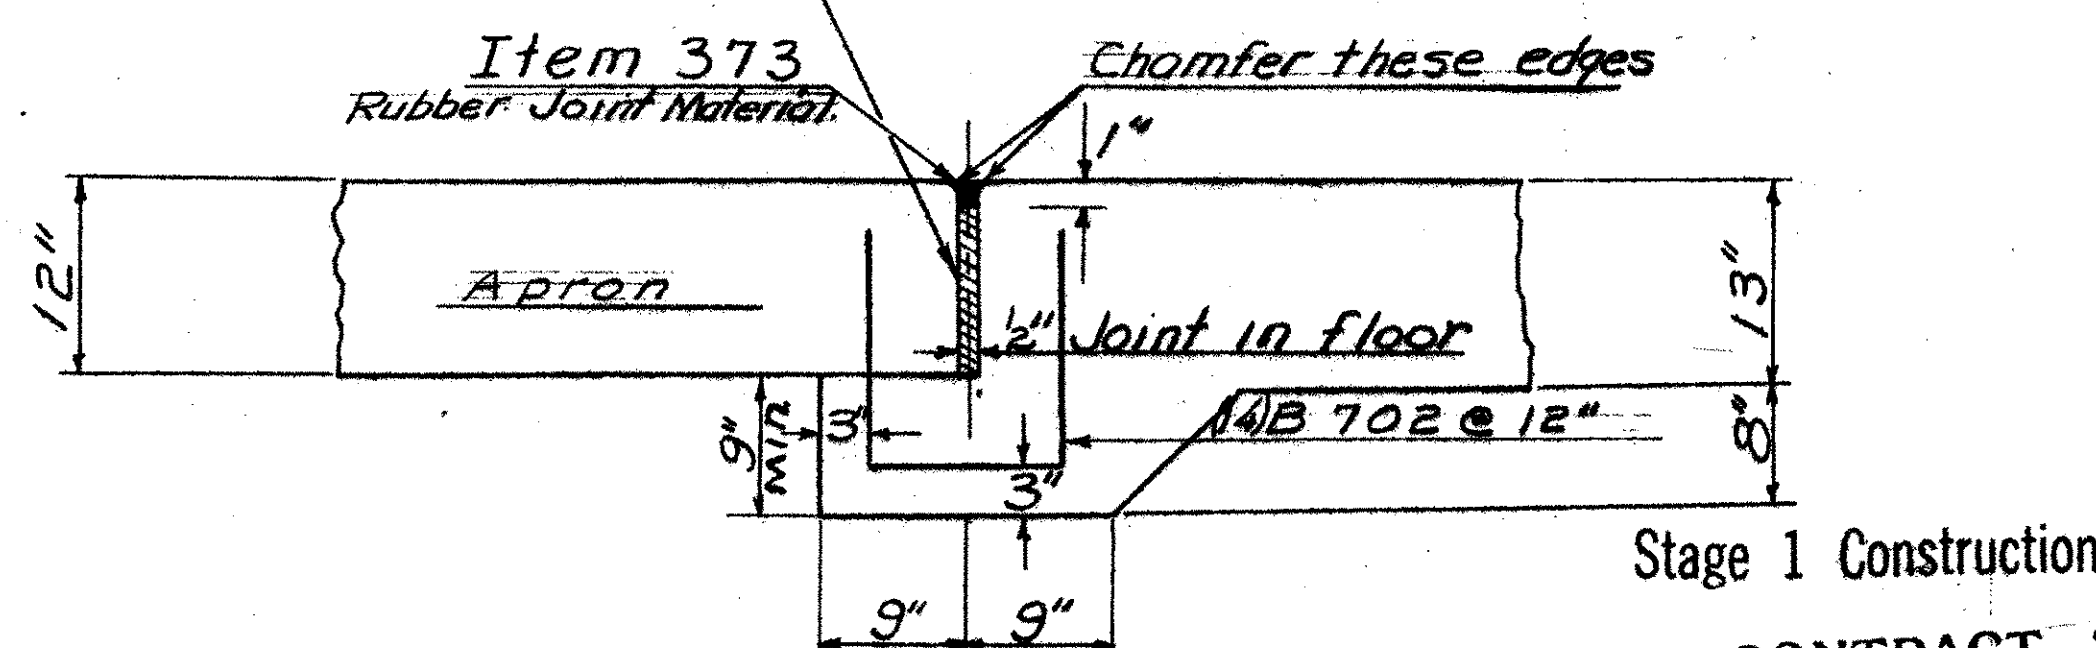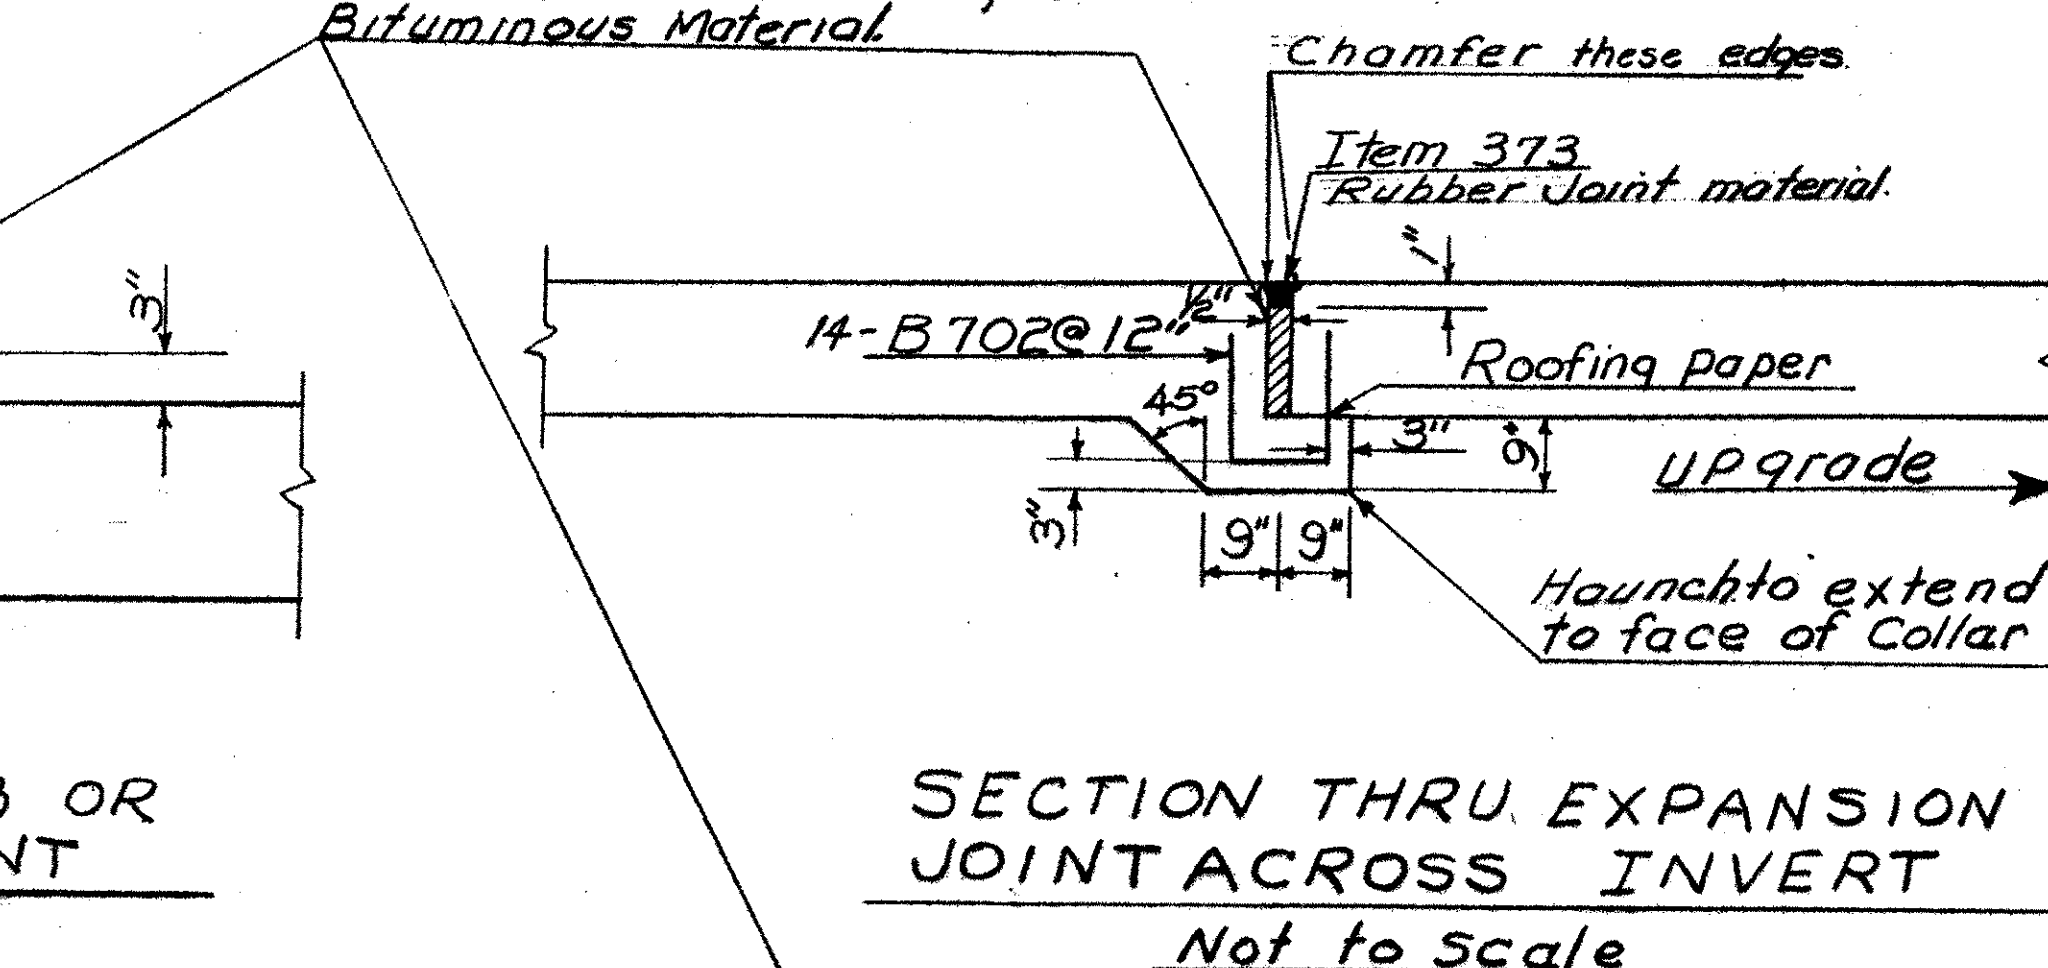

EXPANSION JOINT DETAIL AT APRONS
Scale: 1" = 1'-0"

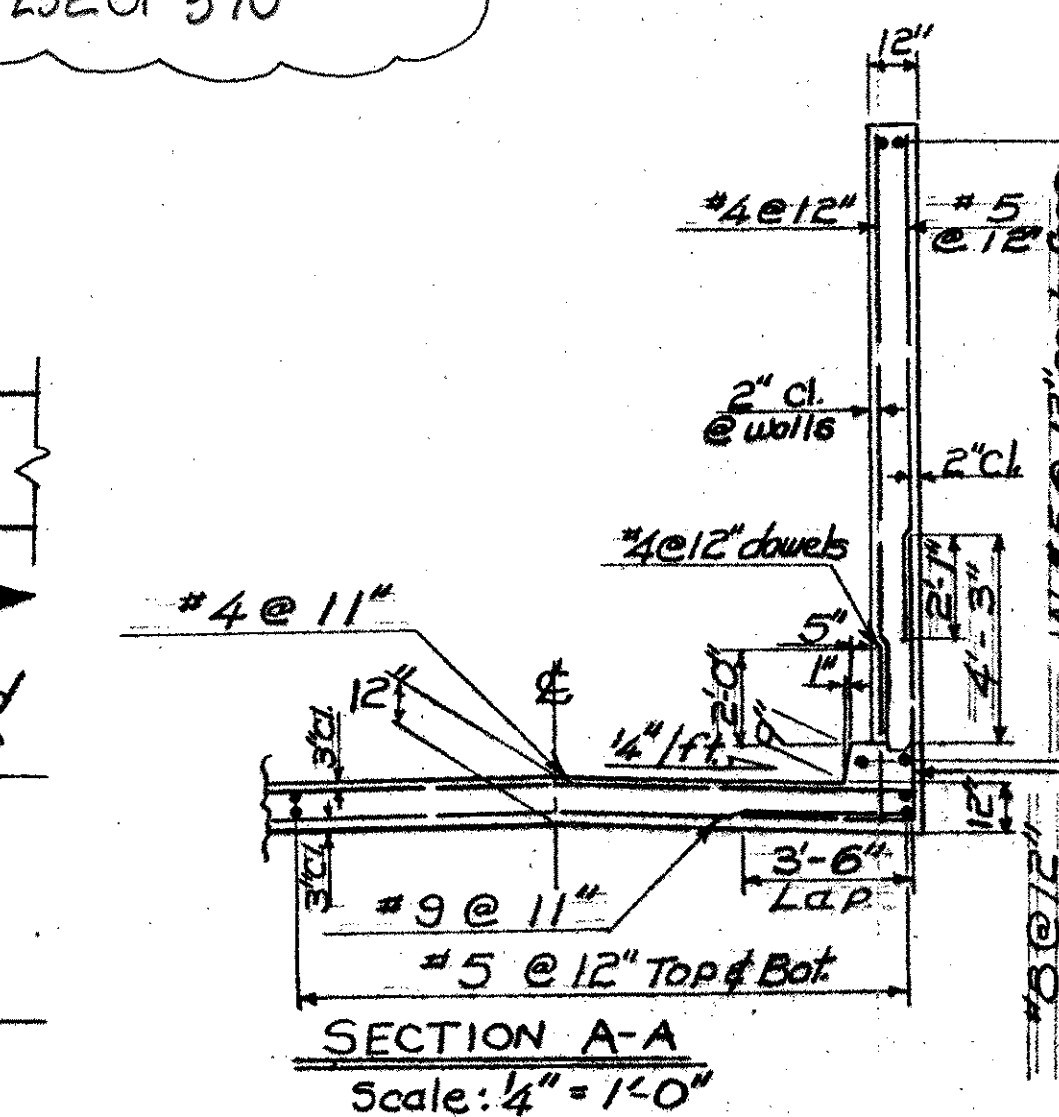

STATE OF VERMONT
DEPARTMENT OF HIGHWAYS

GEORGIA-FAIRFAX
TOWN OF FAIRFIELD-ST. ALBANS
ROUTE No. I 89 Log Sta.
Wingwall Details & Section
& Detail Drawings
SCALE As Noted
SURVEYED BY Gamsky, Millette & Spaulding
DRAWN BY G.E.H. CHECKED BY R.P.G.
S4:B6 PROJECT NO I 89-3(35) Cont #2
SHEET 212 OF 461
BR-302