

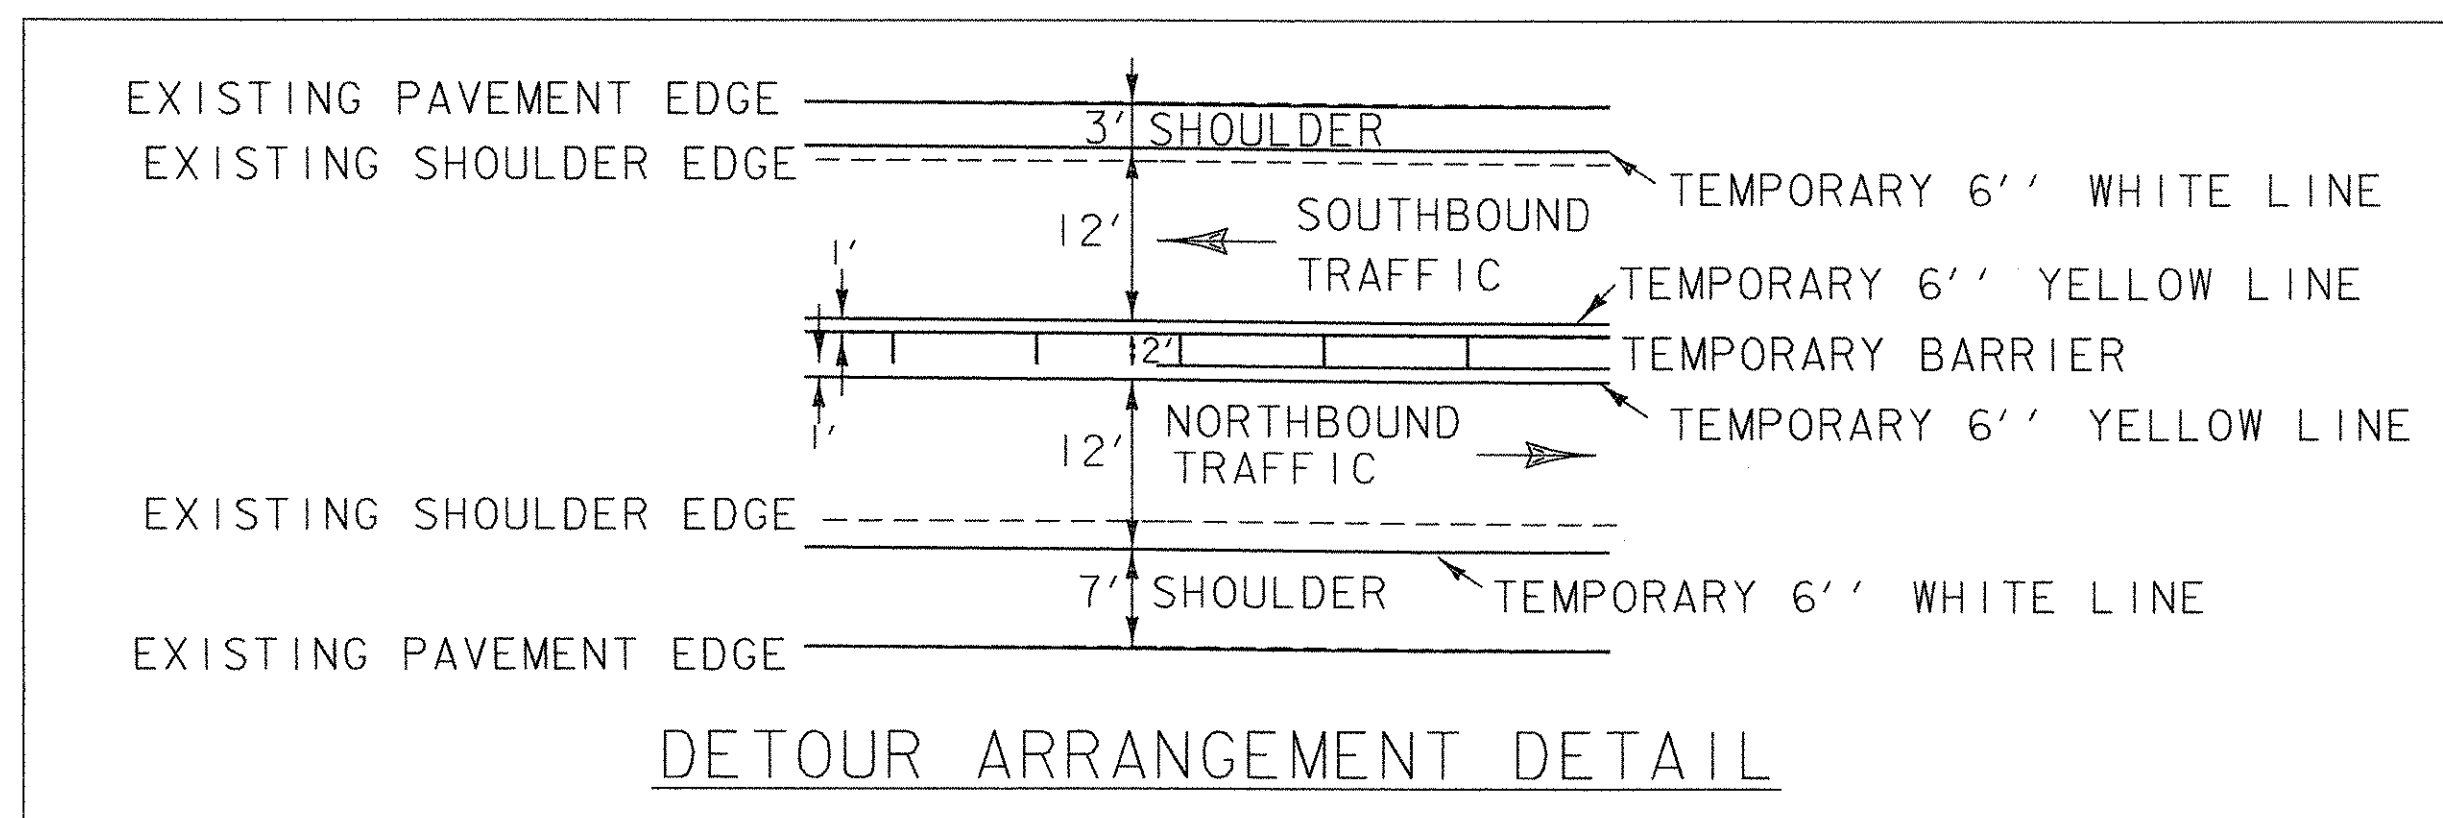


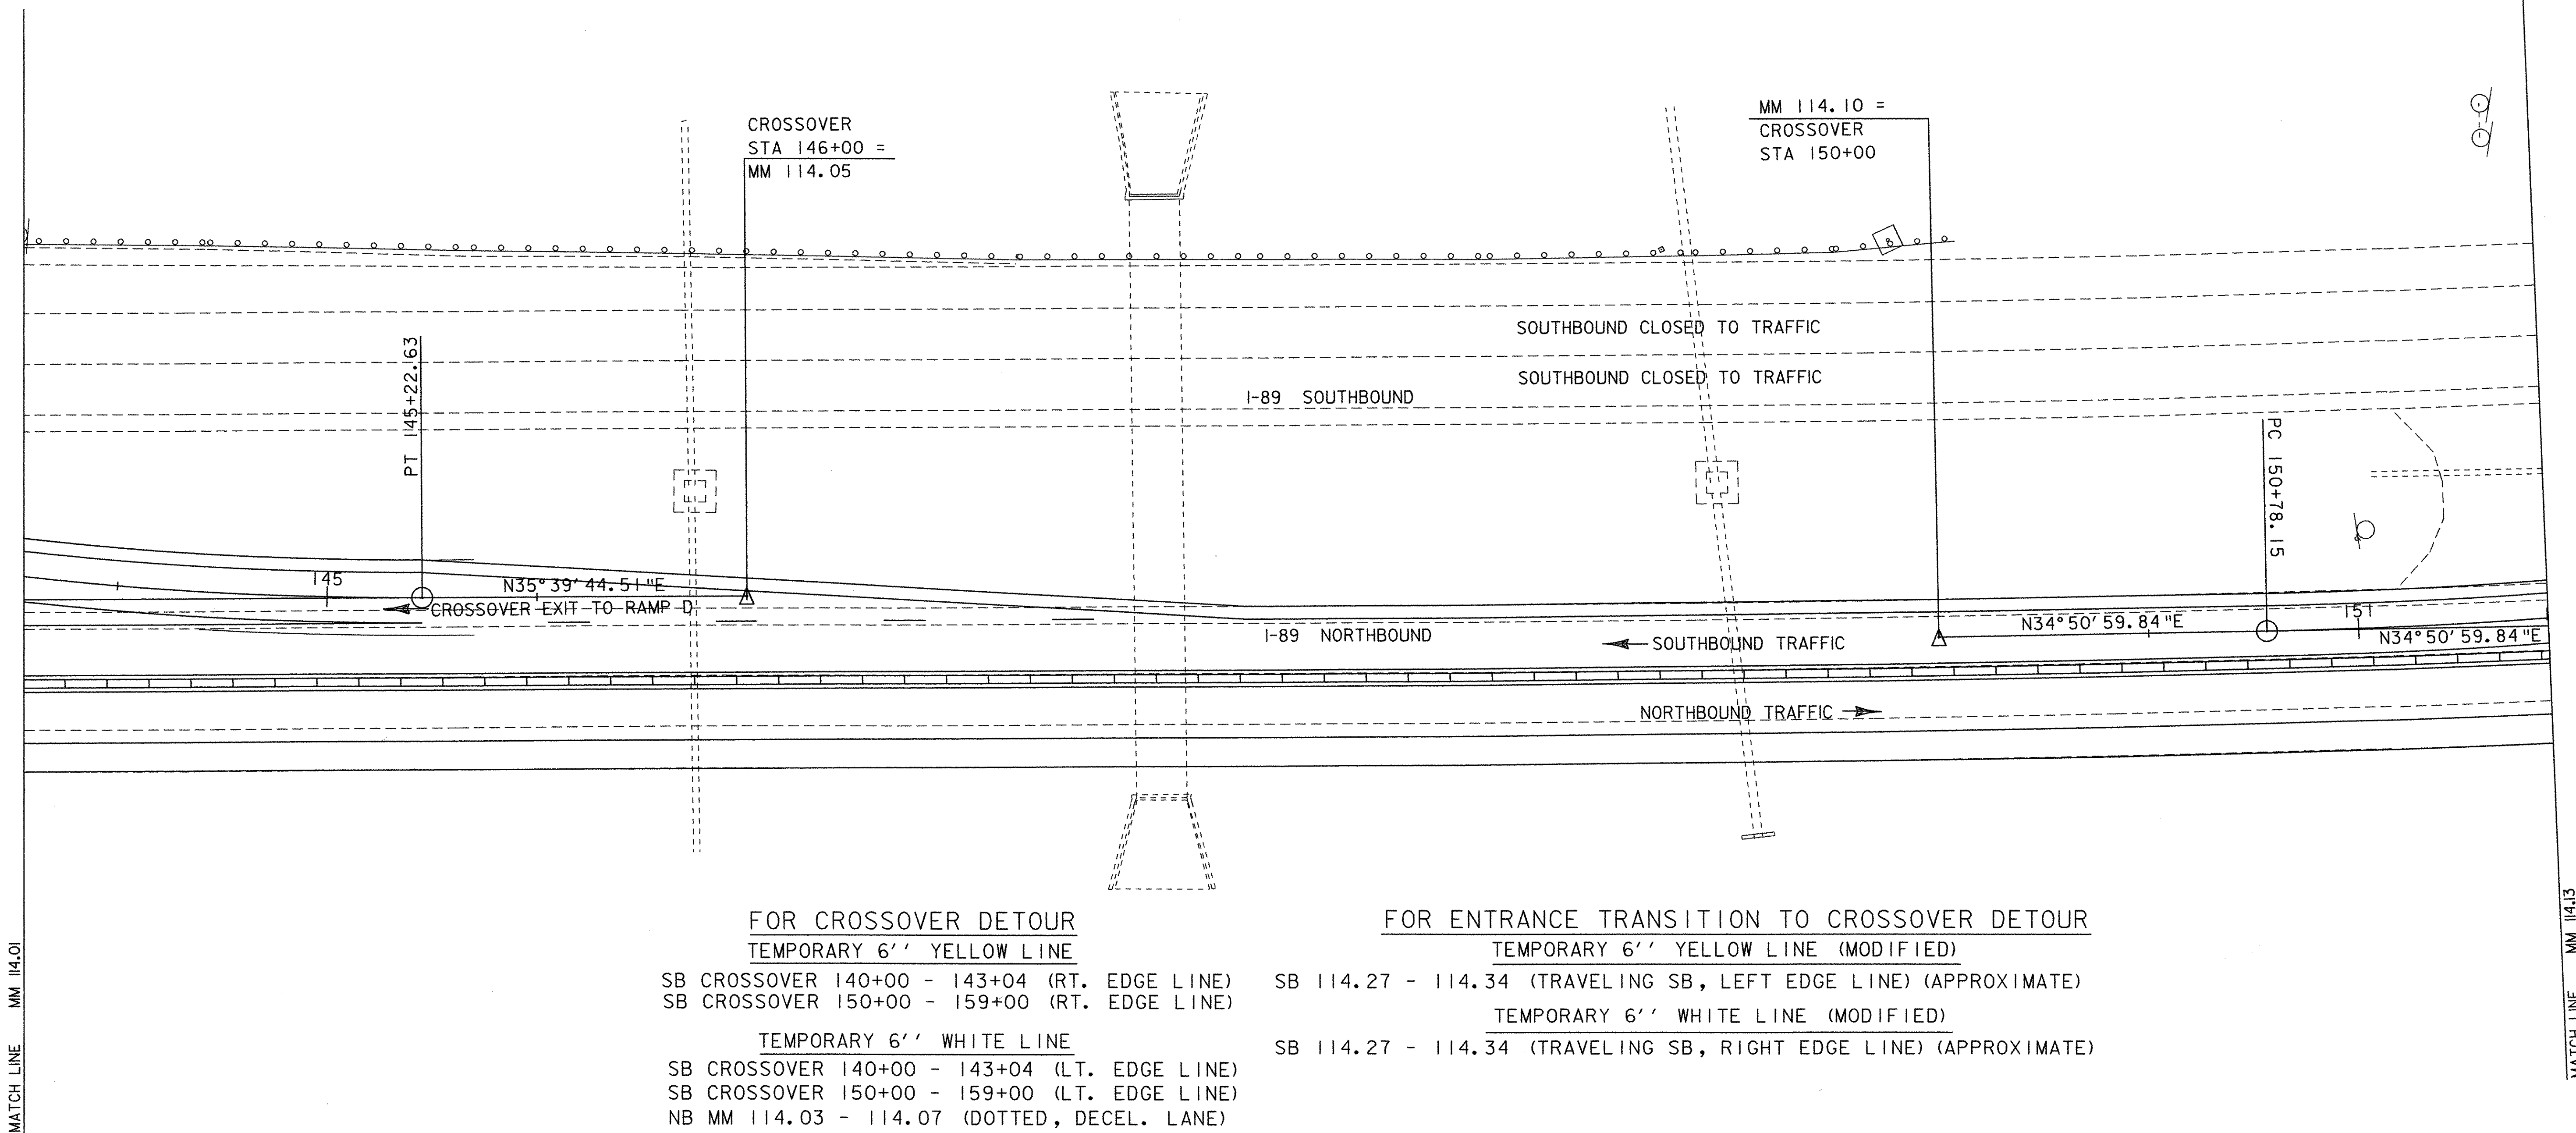

SOUTHBOUND WILL BE BUILT FIRST.


PAVEMENT MARKING SEQUENCE FOR SOUTHBOUND DETOUR

- 1) REMOVE EXISTING PAVEMENT MARKINGS ON NORTHBOUND.
- 2) INSTALL TEMPORARY PAVEMENT MARKINGS WITH MEDIAN BARRIER ON NORTHBOUND (ITEMS 646.614 AND 646.615).
- 3) WHEN SOUTHBOUND IS DONE (BEFORE WINTER):
 - A) REMOVE TEMPORARY MARKINGS AND MEDIAN BARRIER FROM NORTHBOUND.
 - B) INSTALL PAVEMENT MARKINGS FOR WINTER USE ON BOTH SOUTHBOUND AND NORTHBOUND (ITEMS 646.214 AND 646.215).

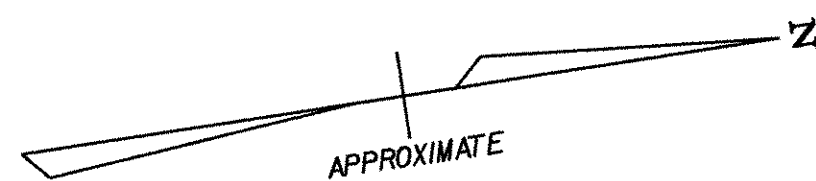

DATUM	
VERTICAL	ASSUMED
HORIZONTAL	ASSUMED

CROSSOVER TO BEGIN SOUTHBOUND DETOUR

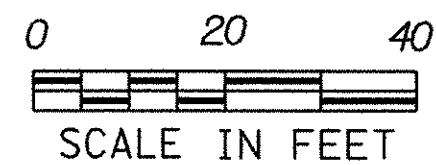

PROJECT:	FAIRFAX-FAIRFIELD-ST. ALBANS	PROJECT NO.:	IM 089-3(27)
DESIGN FILE NAME:	78TA007B/DESIGN/DA007SBC.DGN	PLOT DATE:	19-AUG-2000
IPARM FILE NAME:	DA007SCI	SURVEY DATE:	JL/95
SURVEYED BY:	GILMAN	DRAWN BY:	SQUAD B
SQUAD LEADER:	DELLA SANTA	SHEET:	264 OF 370