


Crossover Profile To Begin Southbound Detour

DATUM
 VERTICAL ASSUMED
 HORIZONTAL ASSUMED

SCALE IN FEET

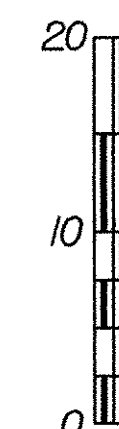

PROJECT: FAIRFAX-FAIRFIELD-ST. ALBANS		PROJECT NO.: IM 089-3(27)
DESIGN FILE NAME: /87A007B/DESIGN/DA007SBC.DGN	PLOT DATE: 19-AUG-2000	
IPARM FILE NAME: DA007CP3	SURVEY DATE: 11/95	
SURVEYED BY: GILMAN	DRAWN BY: SQUAD B	
SQUAD LEADER: DELLA SANTA	SHEET: 267 OF 370	