

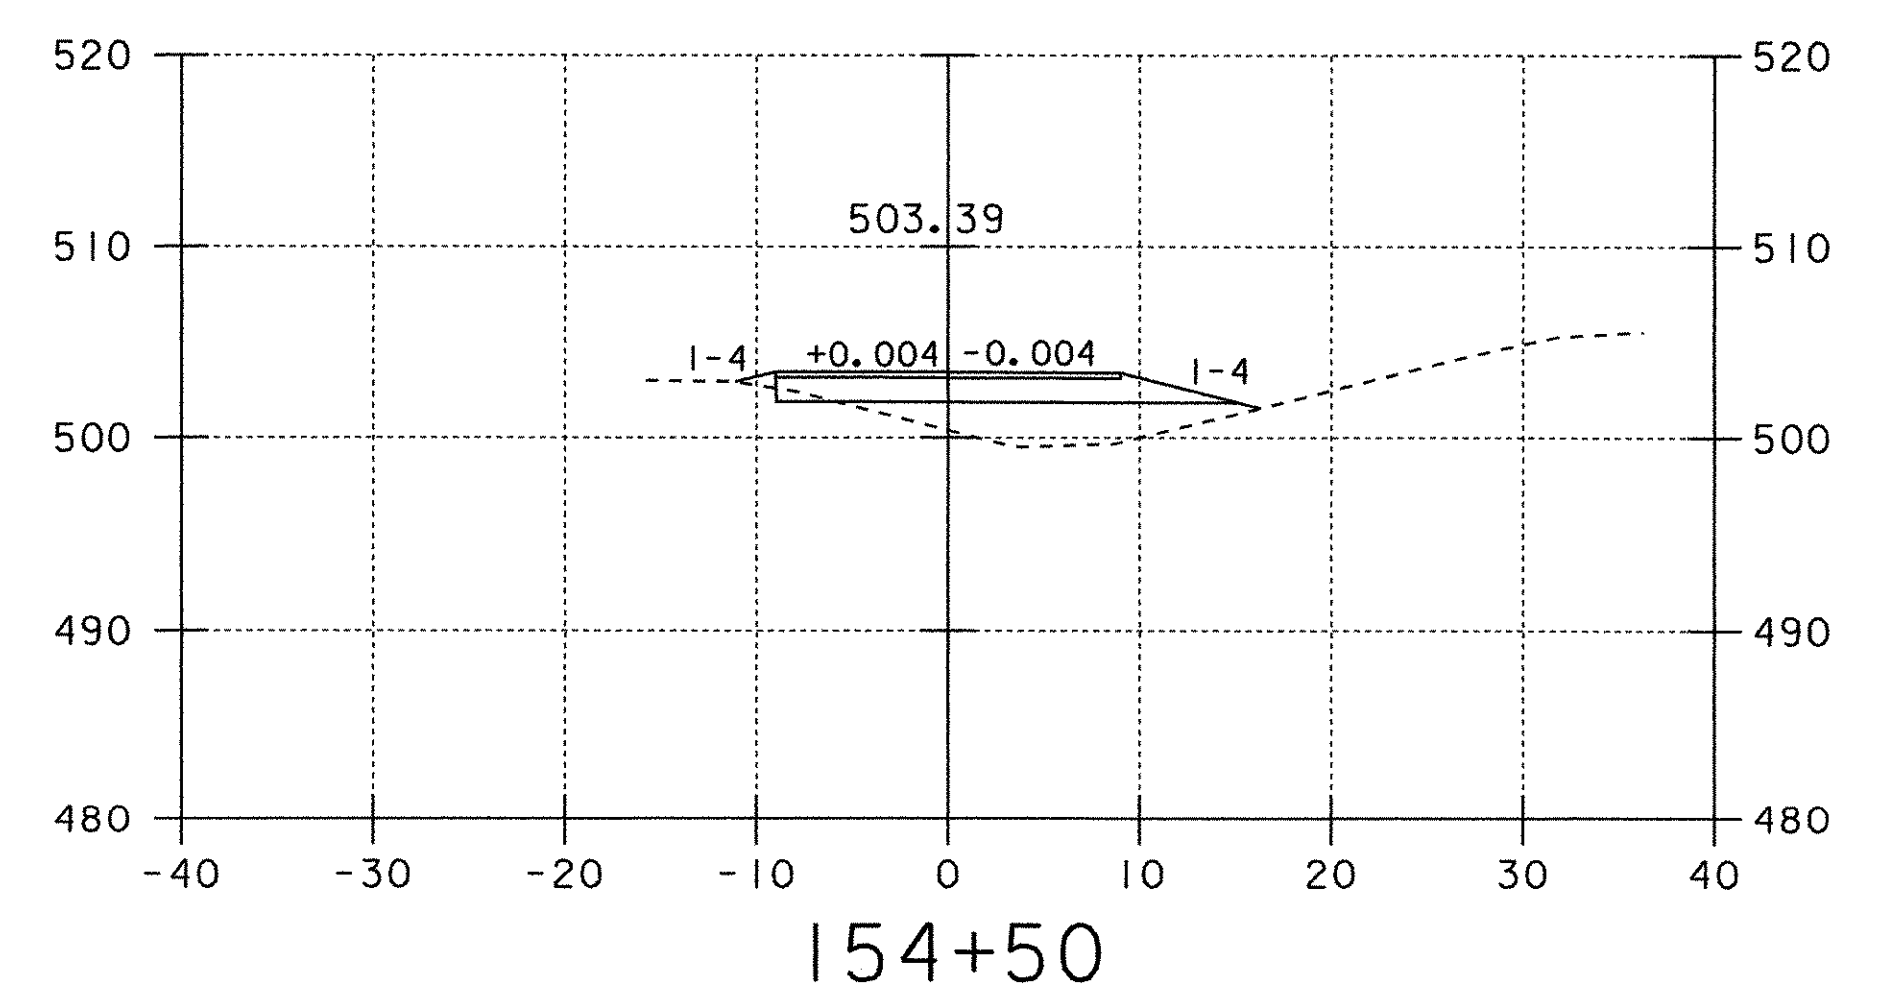
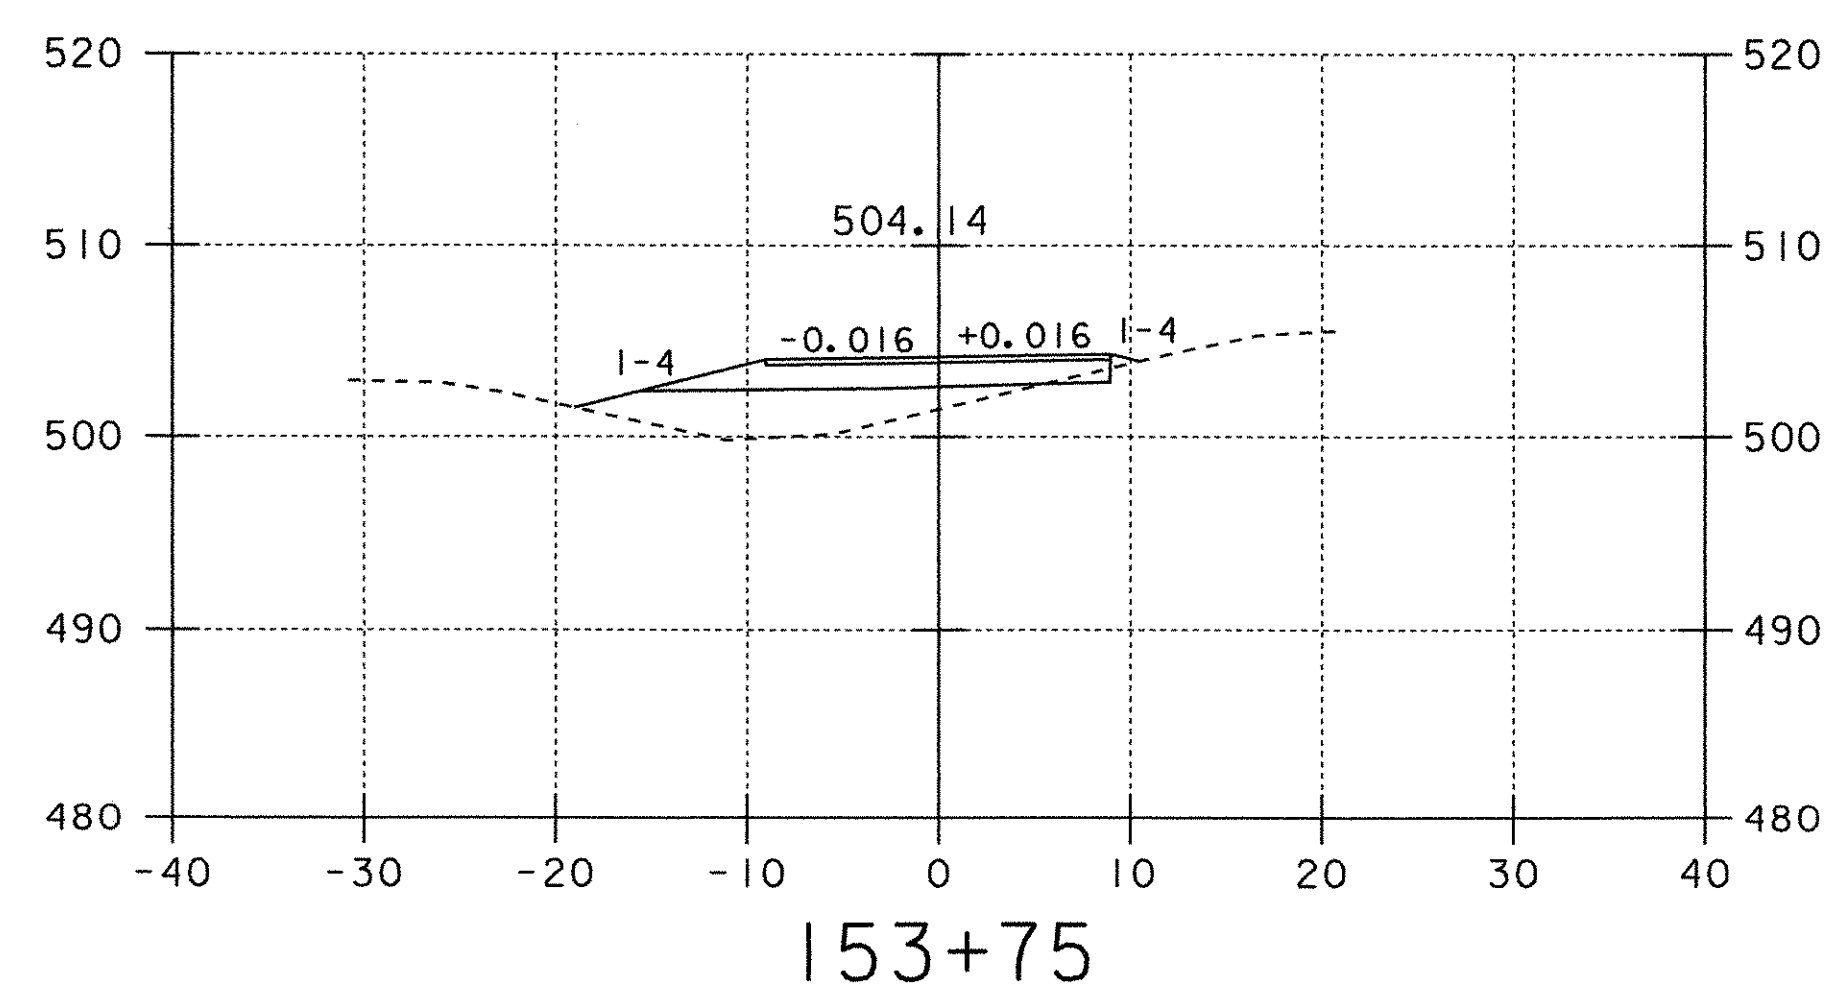
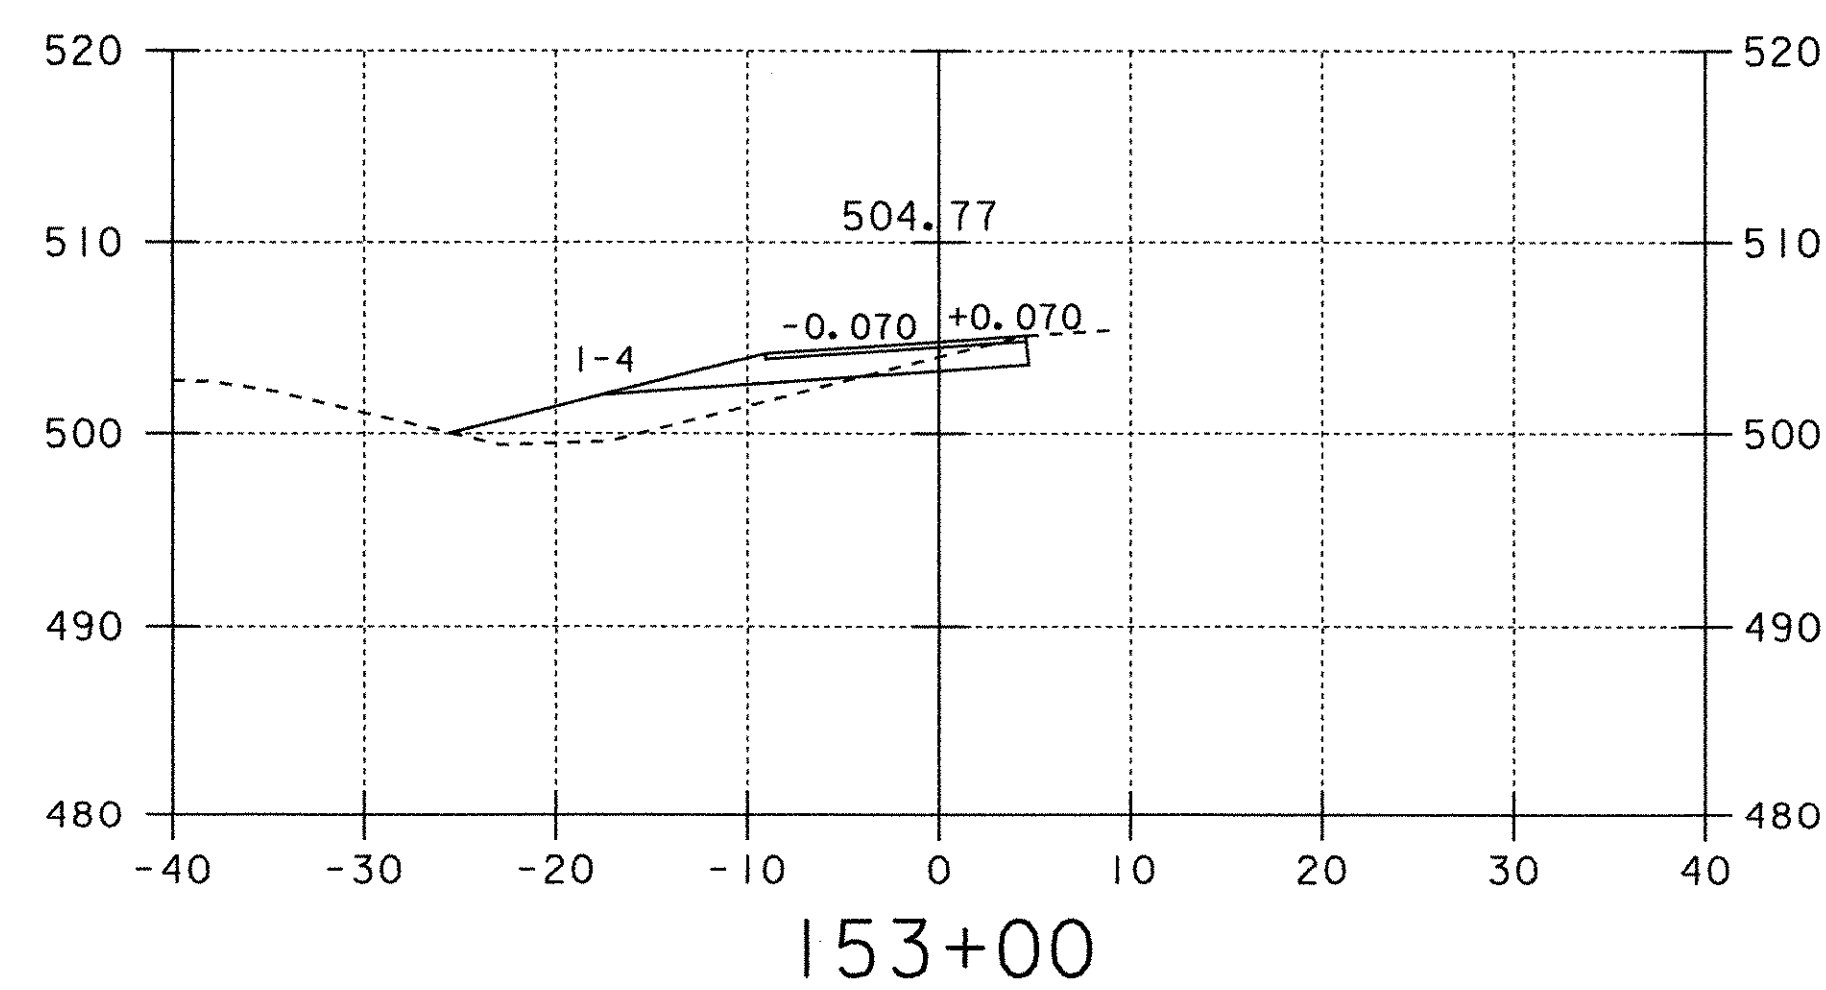
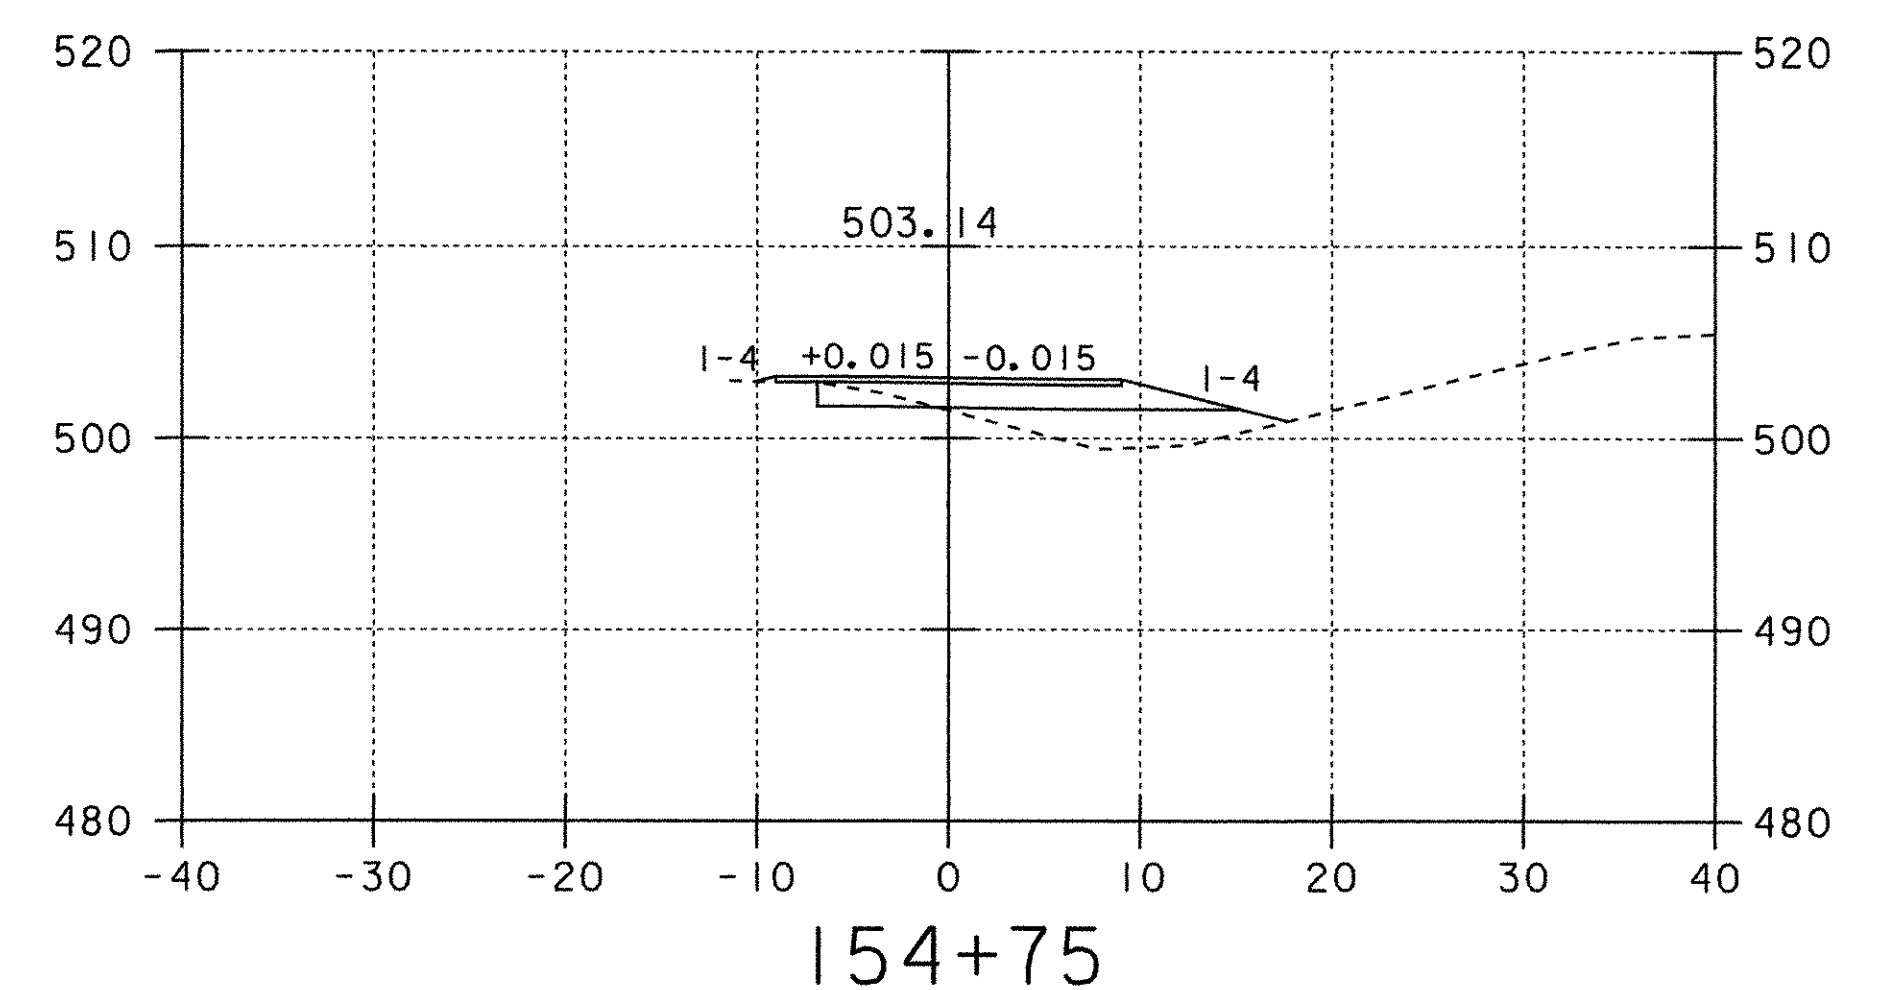
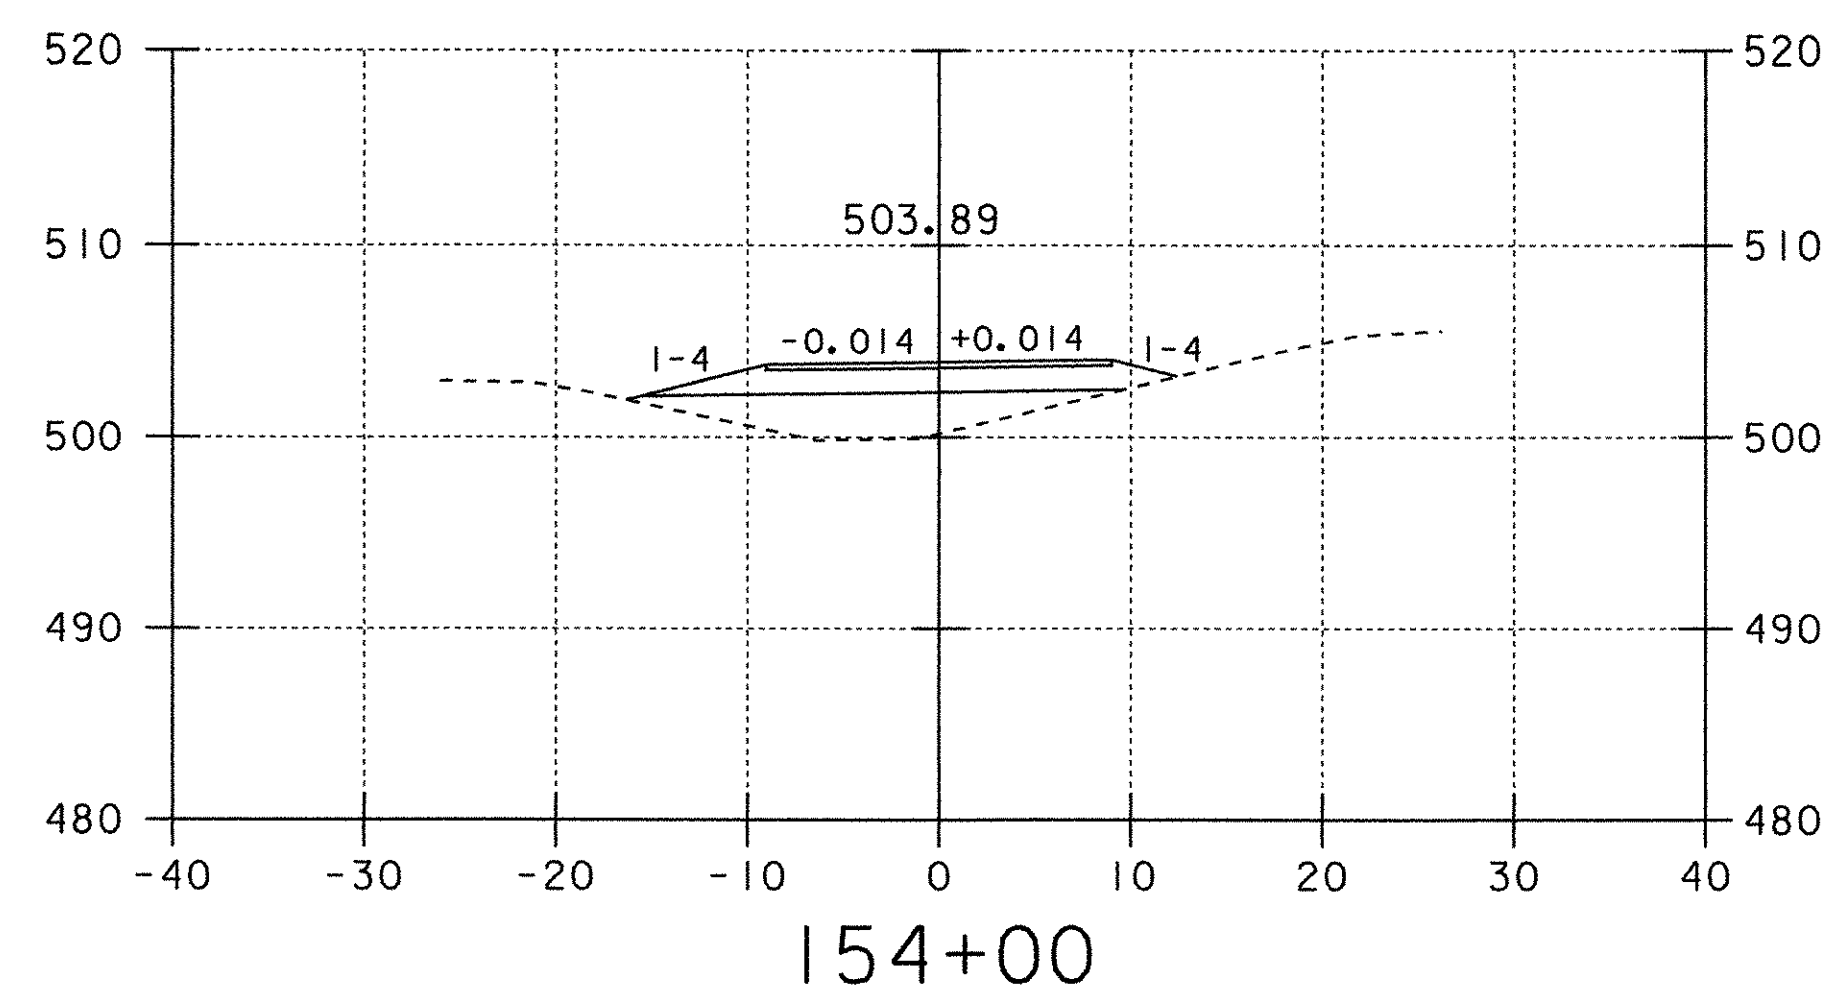
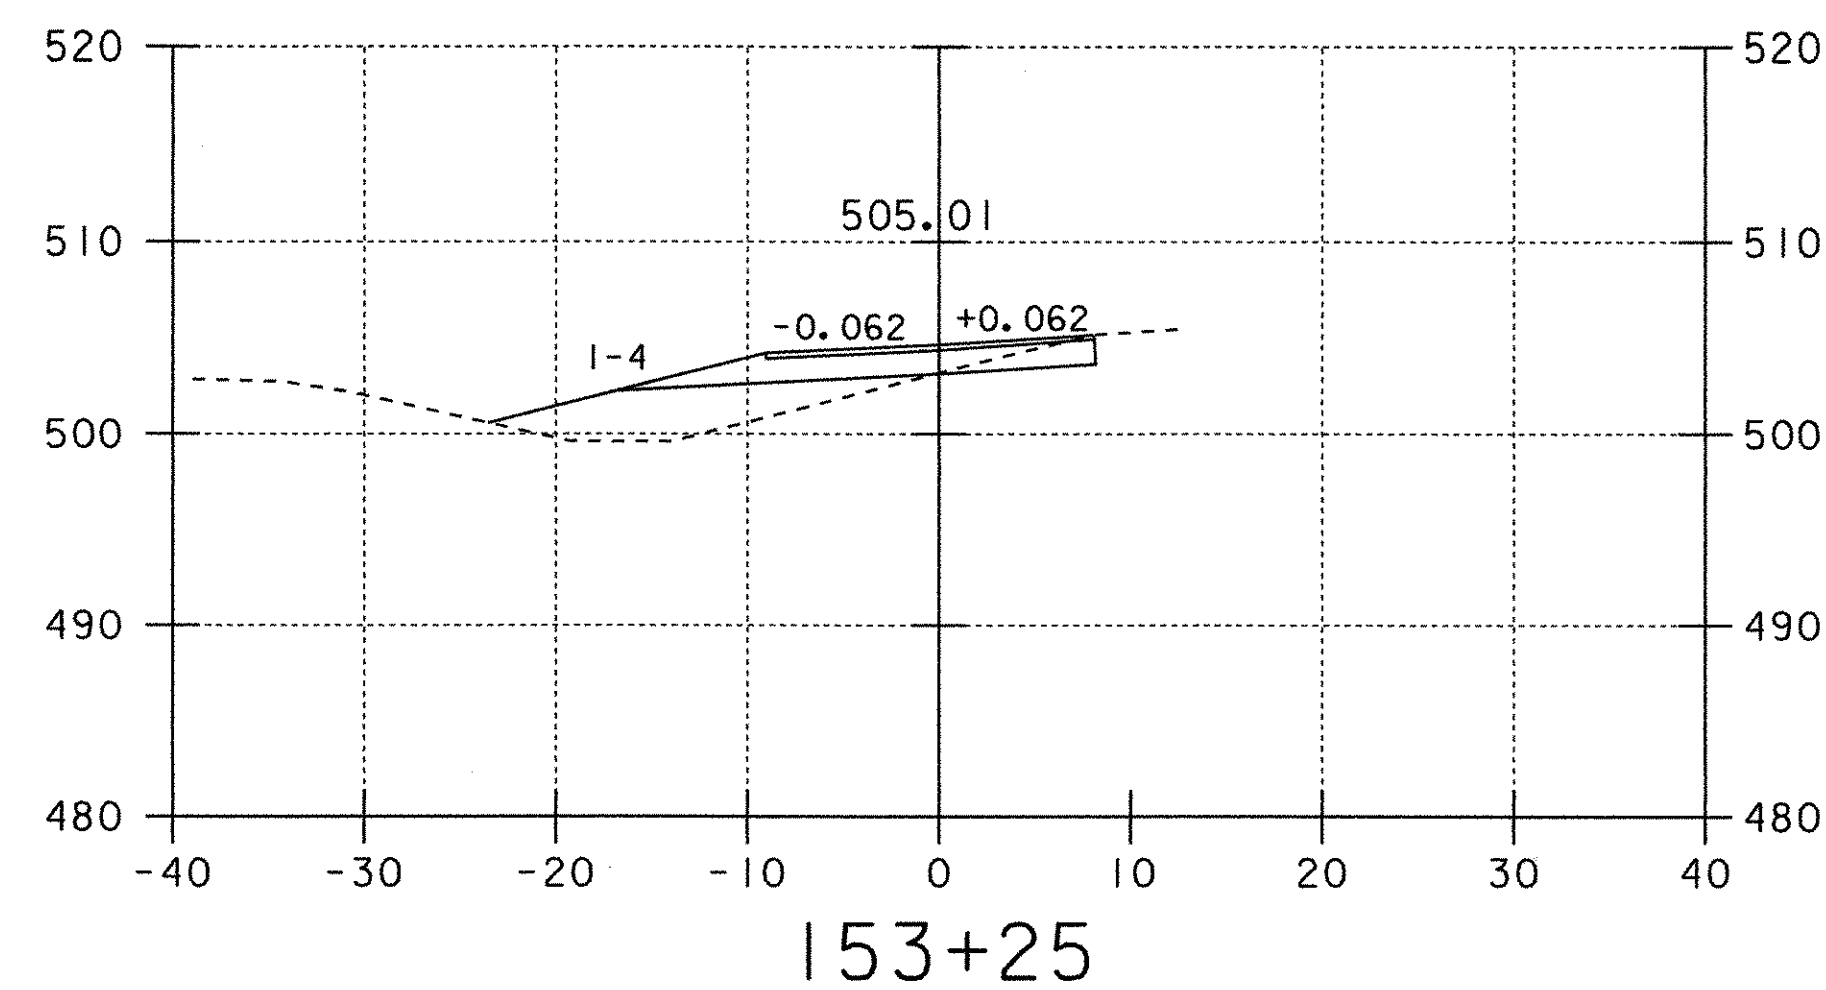
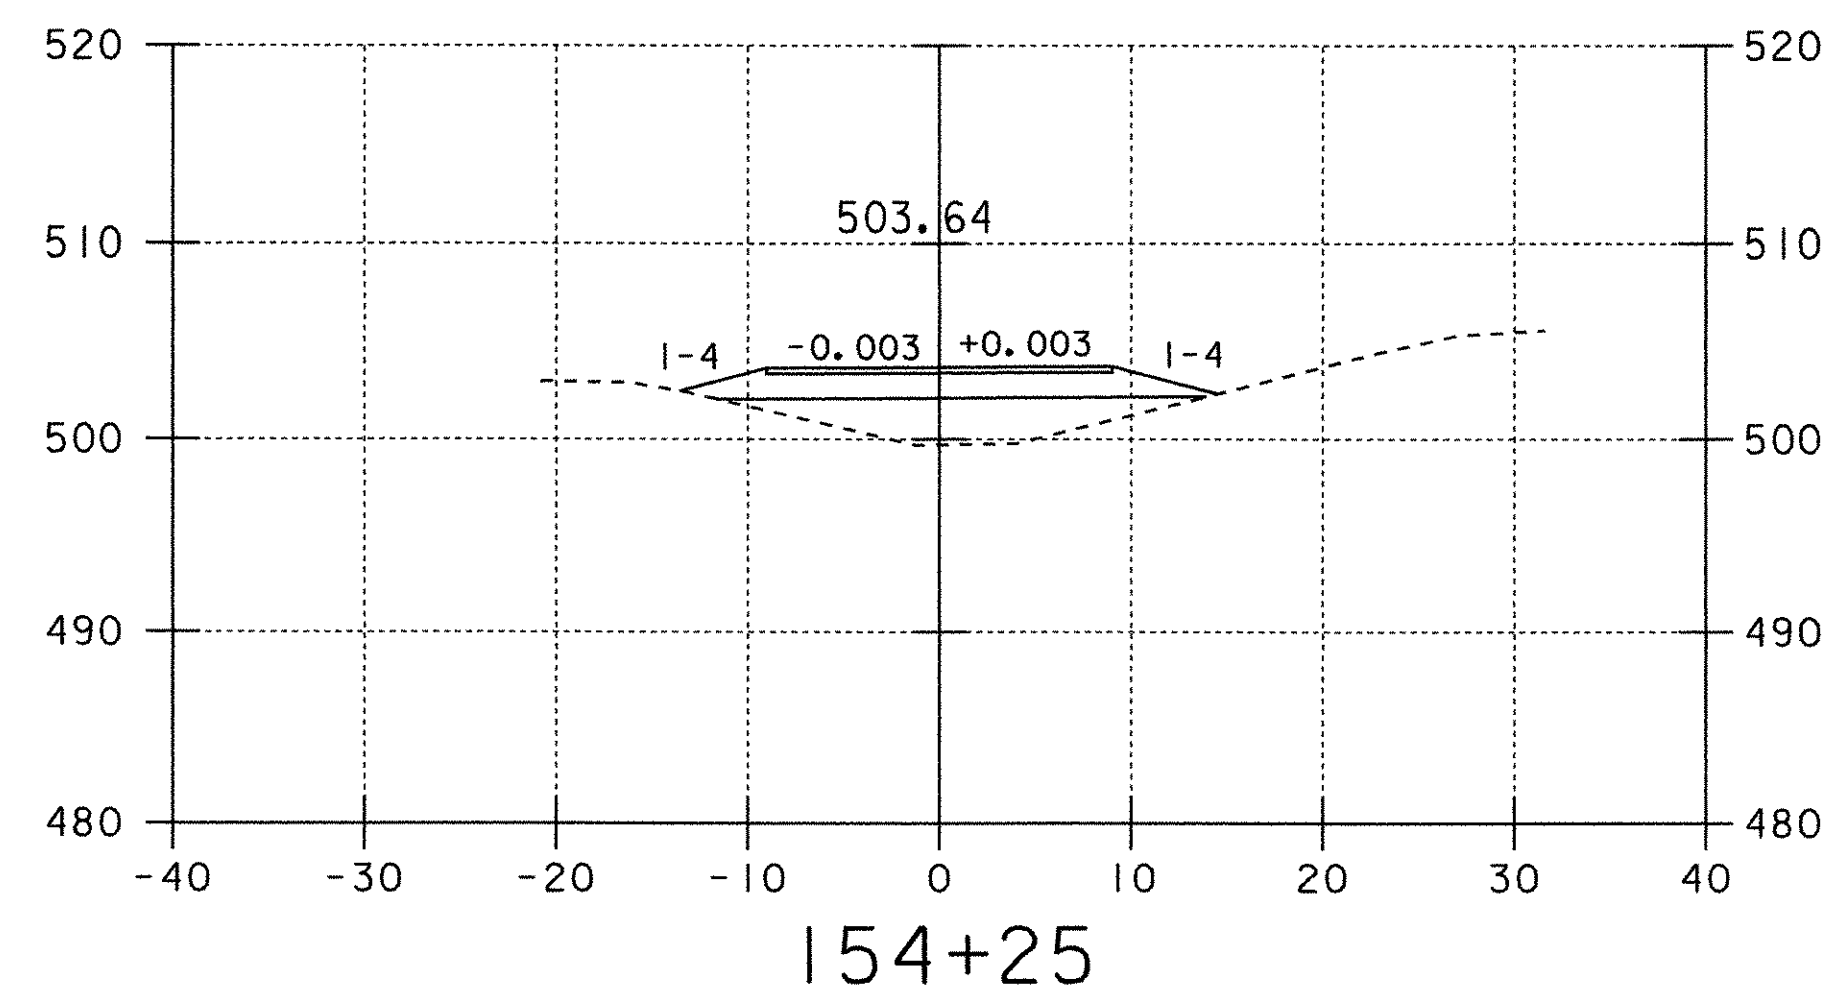


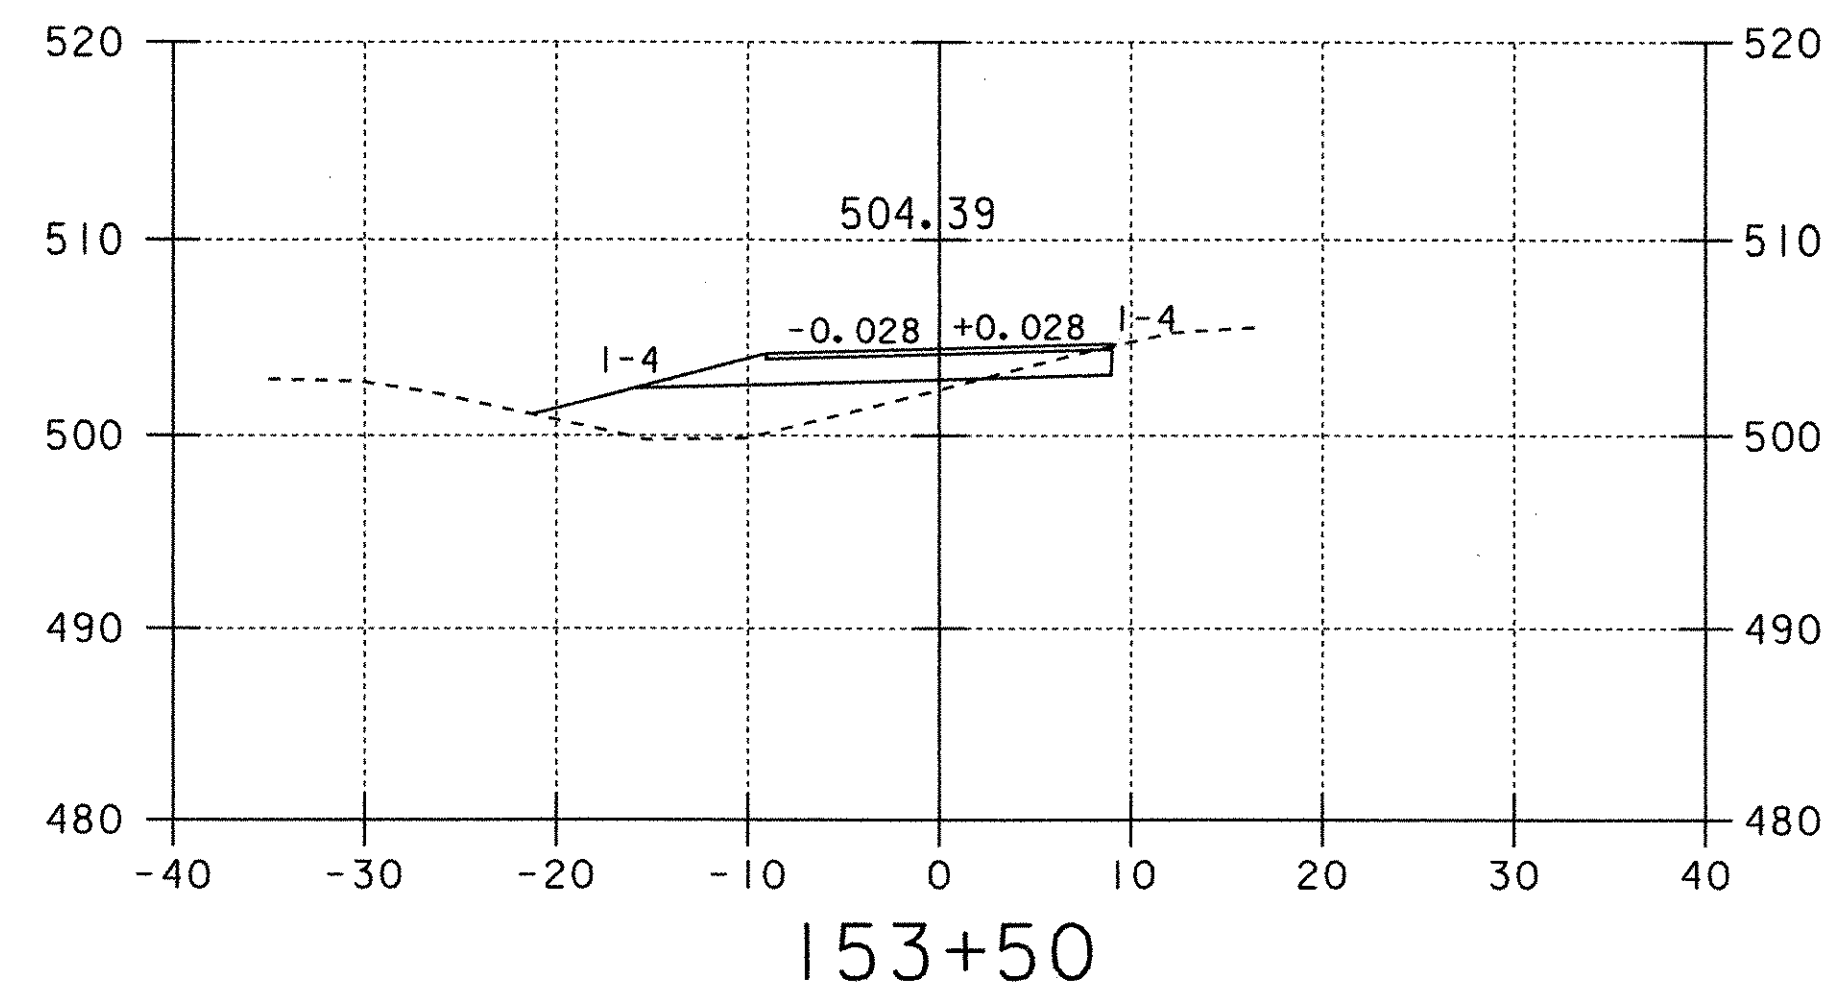

Crossover Sections To Begin Southbound Detour

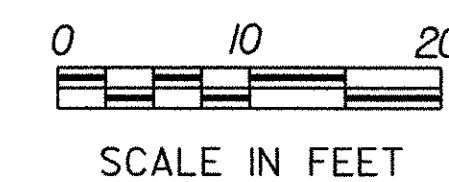

PROJECT: FAIRFAX-FAIRFIELD-ST. ALBANS		PROJECT NO.: IM 089-3(27)	
DESIGN FILE NAME:	/87A007B/DESIGN/DA007SBC.DGN		
IPARM FILE NAME:	DA007SXI		
SURVEYED BY:	GILMAN		
SQUAD LEADER:	DELLA SANTA		
	PLOT DATE: 19-AUG-2000		
	SURVEY DATE: 11/95		
	DRAWN BY: SQUAD B		
	SHEET: 268 OF 370		