




144+50

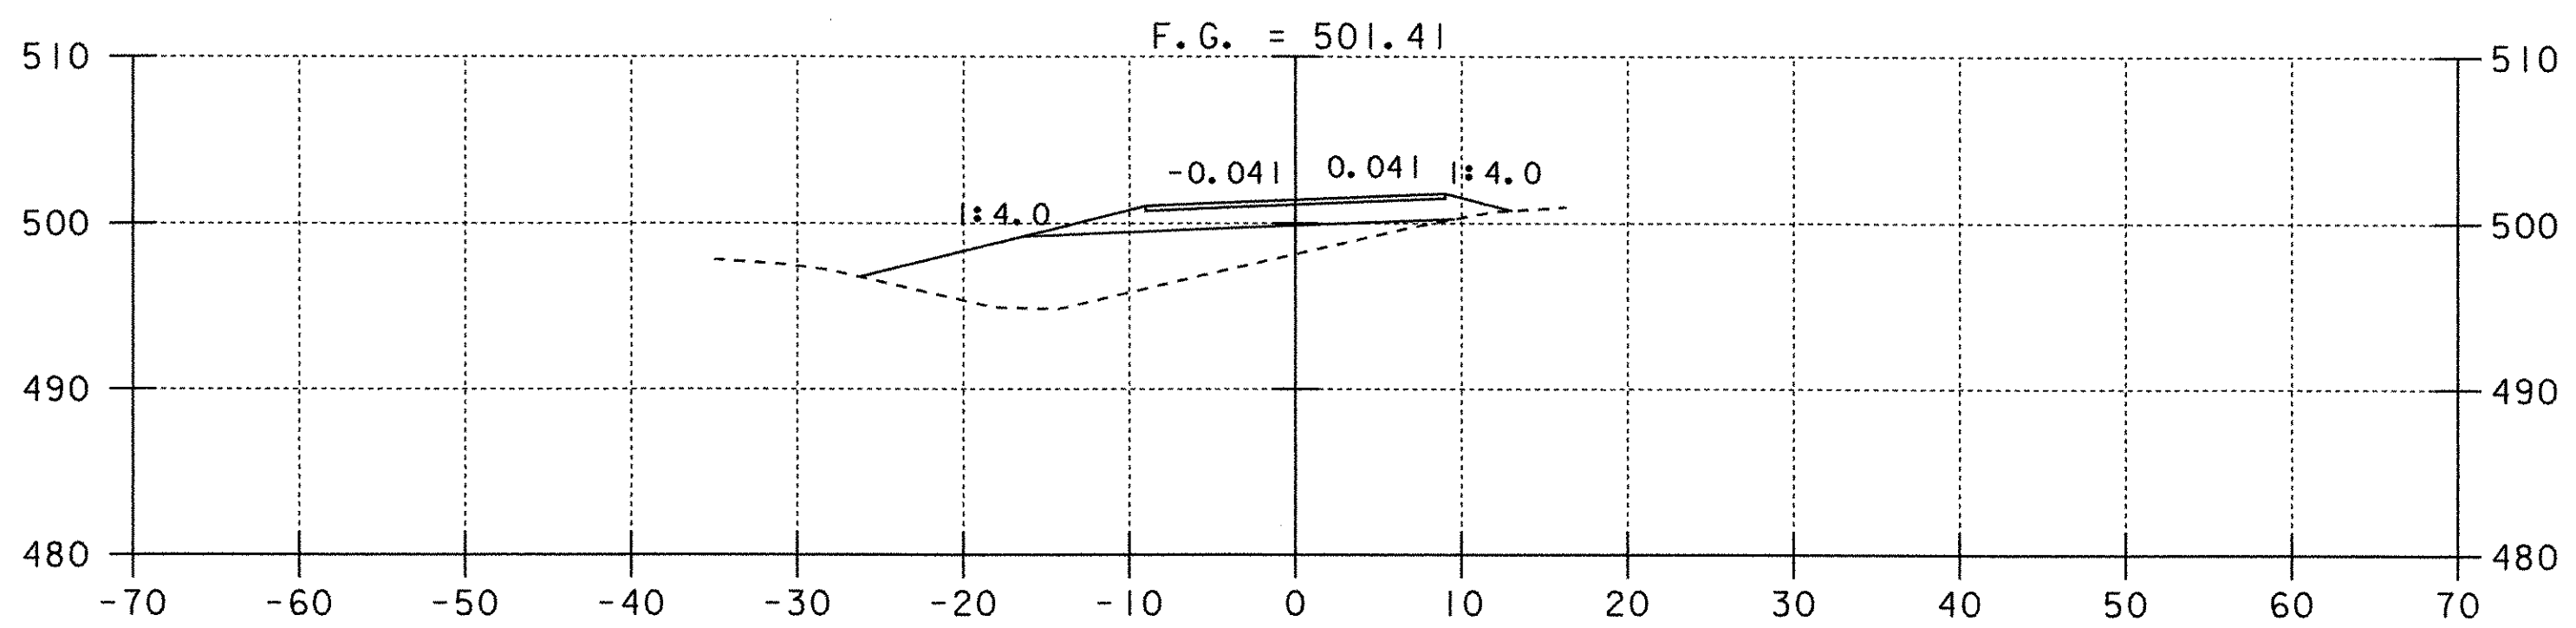


144+00

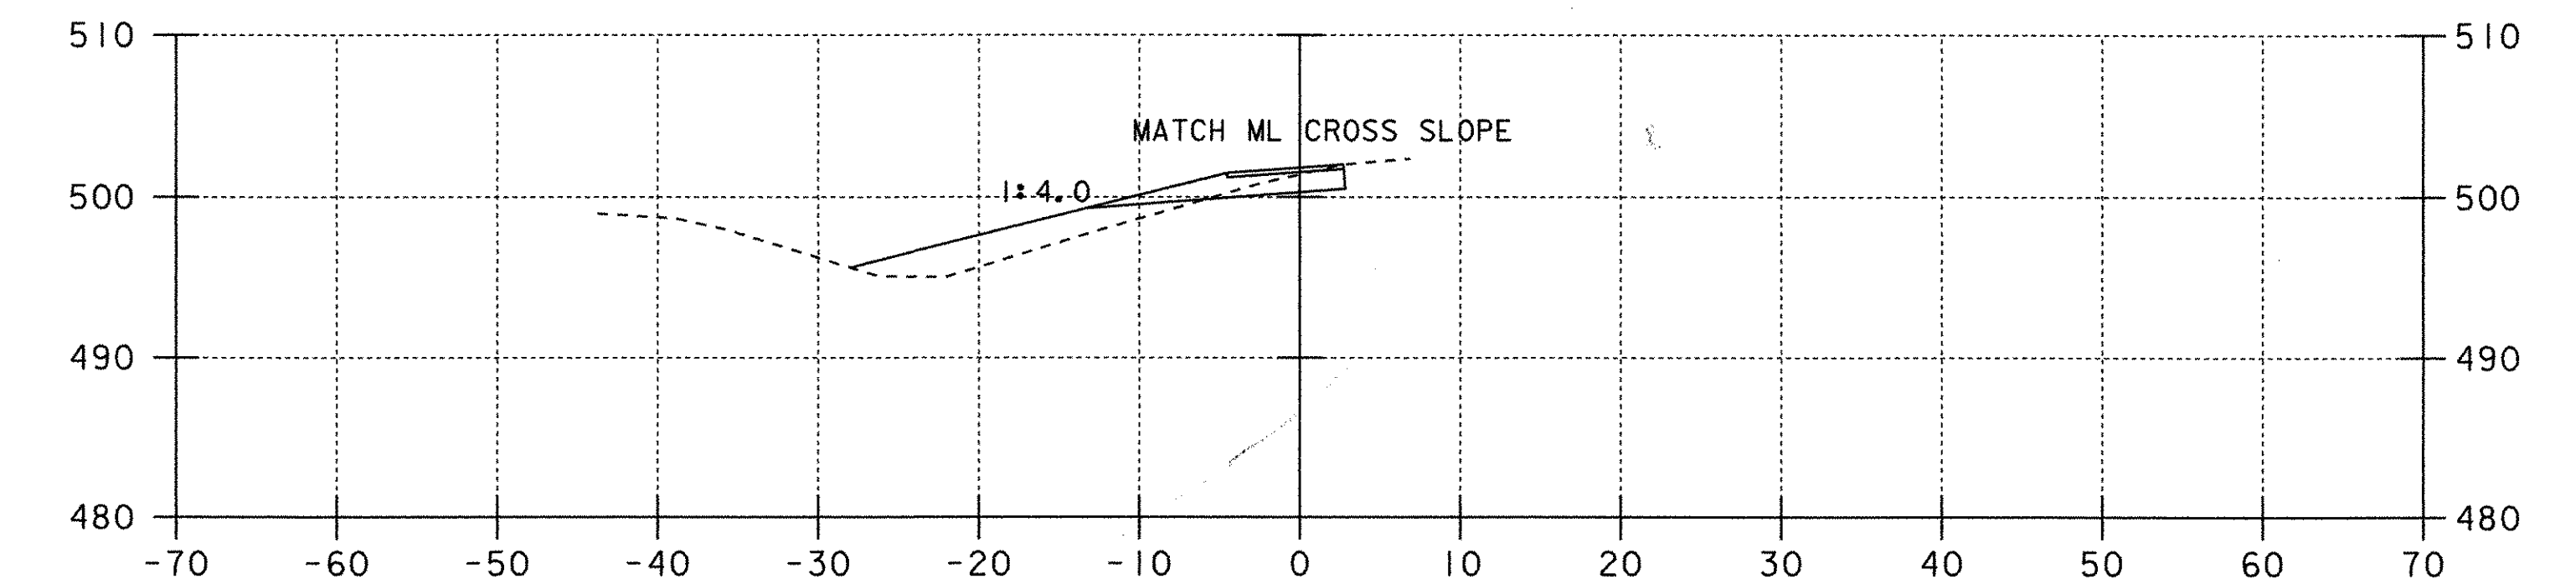


146+00

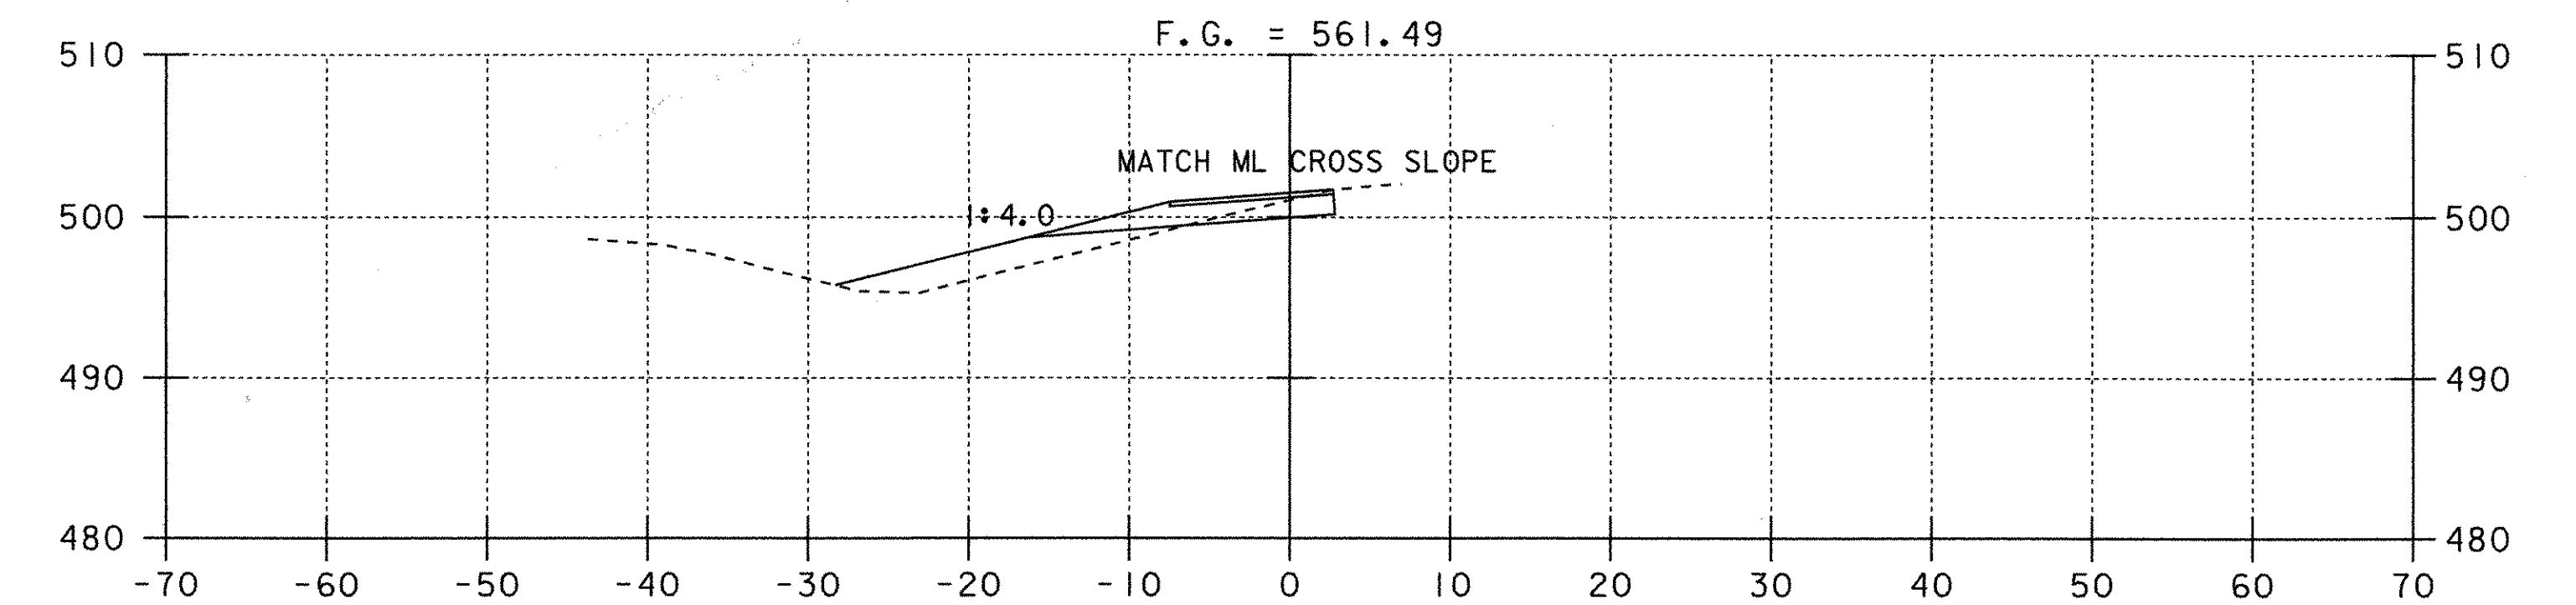


145+50

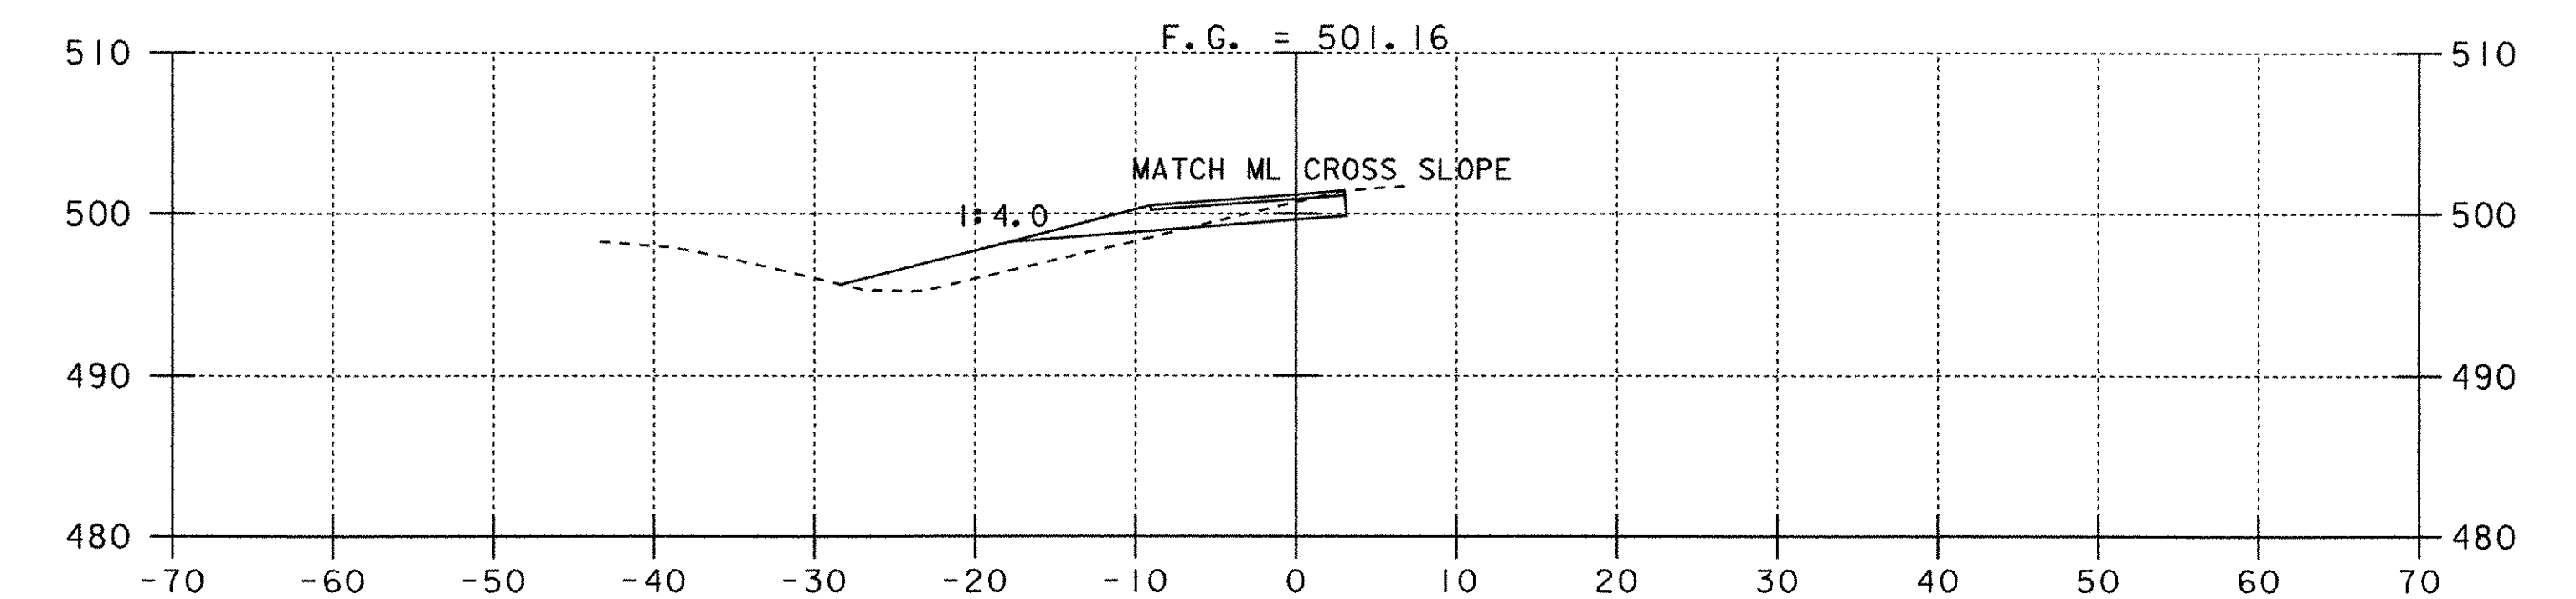

145+00

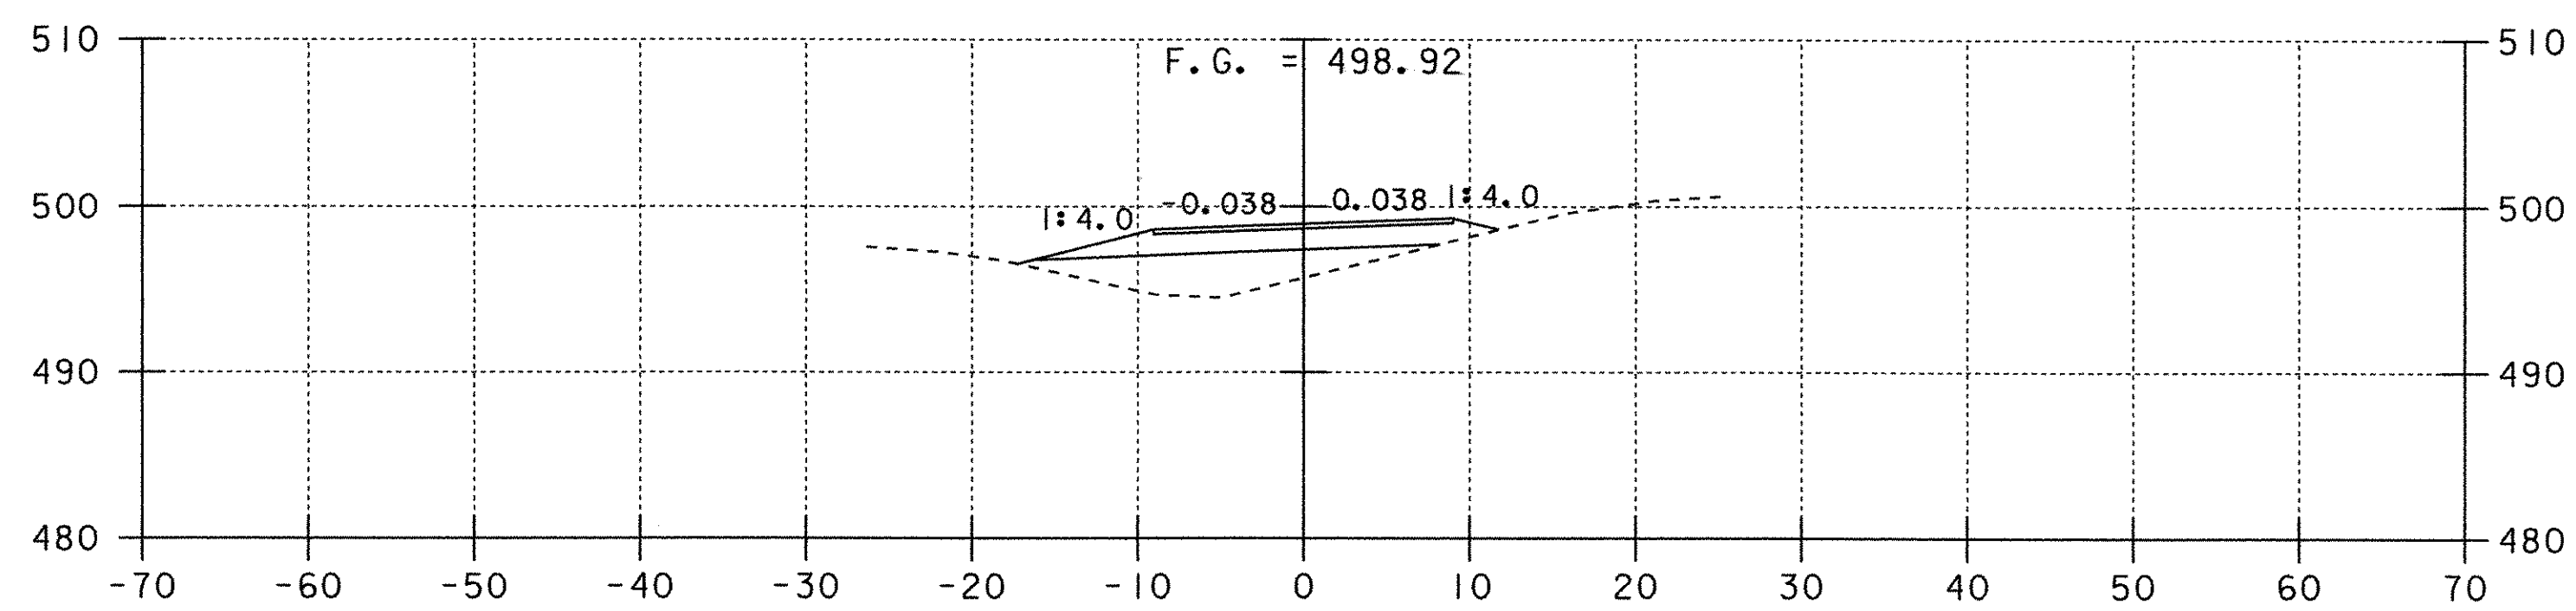


143+50

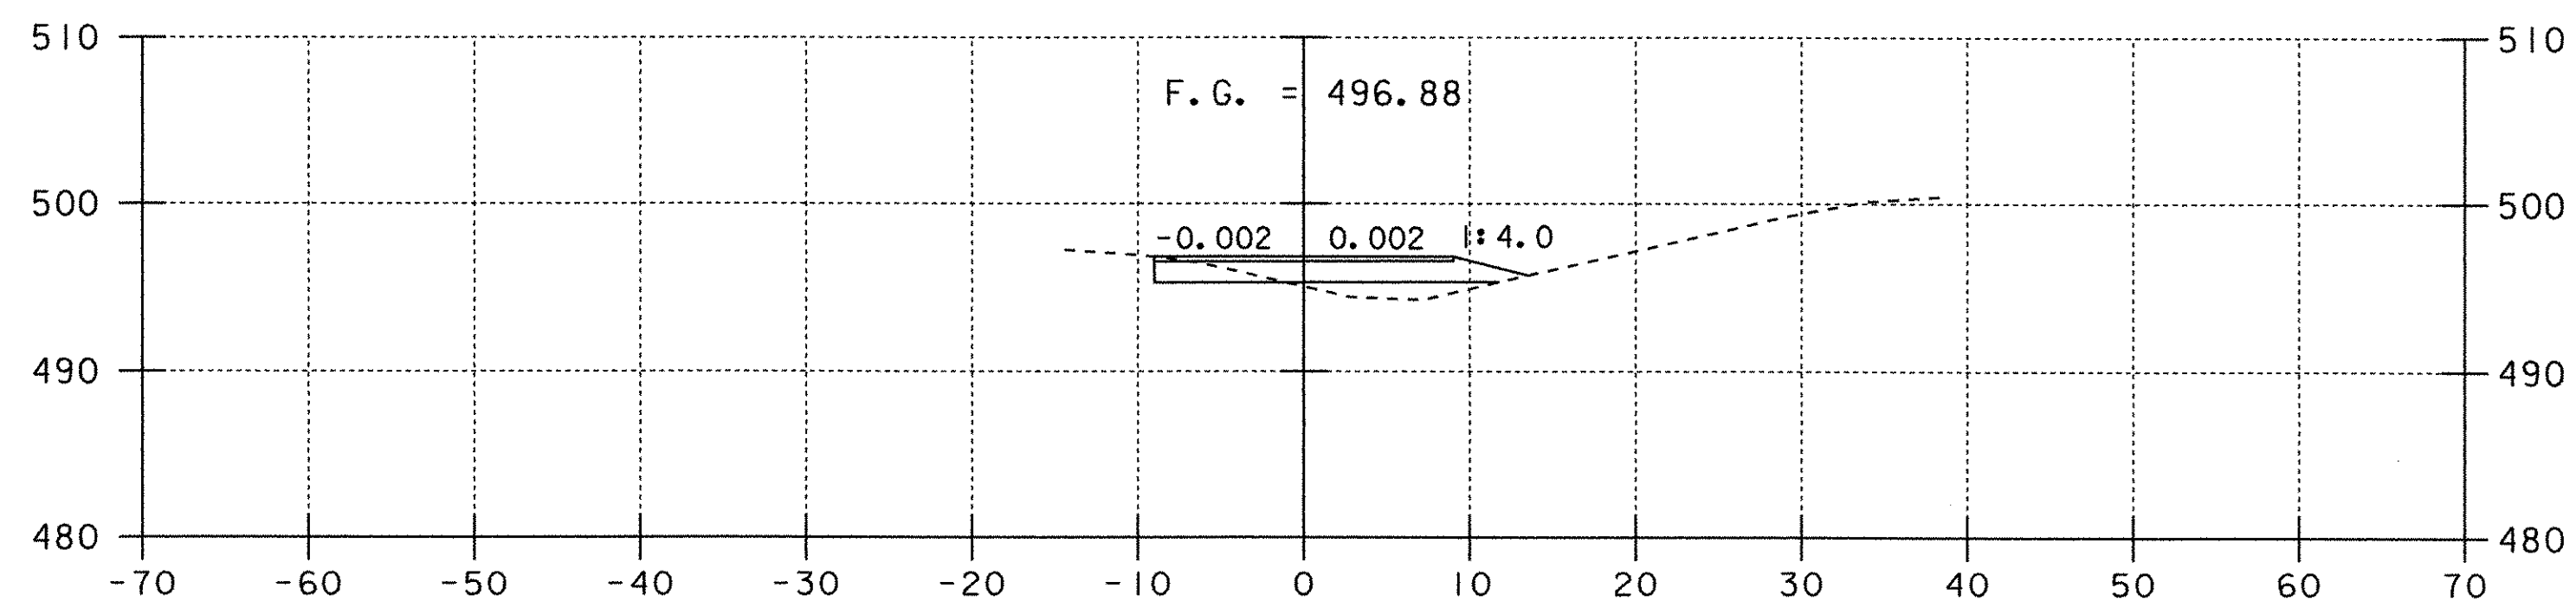

143+00

Southbound Crossover Exit Cross Sections To Ramp D

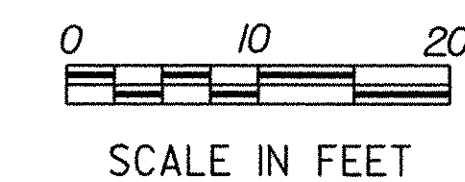

PROJECT: FAIRFAX-FAIRFIELD-ST. ALBANS	PROJECT NO.: IM 089-3(27)
DESIGN FILE NAME: /87A007B/DESIGN/DA007SBC.DGN	PLOT DATE: 19-AUG-2000
IPARM FILE NAME: DA007SX2	SURVEY DATE: 11/95
SURVEYED BY: GILMAN	DRAWN BY: SQUAD B
SQUAD LEADER: DELLA SANTA	SHEET: 271 OF 370