


Crossover Sections To End Southbound Detour

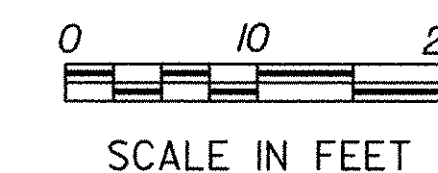

| | | | |
|-------------------|------------------------------|--------------|--------------|
| PROJECT: | FAIRFAX-FAIRFIELD-ST. ALBANS | PROJECT NO.: | IM 089-3(27) |
| DESIGN FILE NAME: | /87A007B/DESIGN/DA007SBA.DGN | PLOT DATE: | 13-SEP-2000 |
| IPARM FILE NAME: | DA007SX5 | SURVEY DATE: | 11/95 |
| SURVEYED BY: | ORVIS | DRAWN BY: | SQUAD B |
| SQUAD LEADER: | DELLA SANTA | SHEET: | 279 OF 370 |