

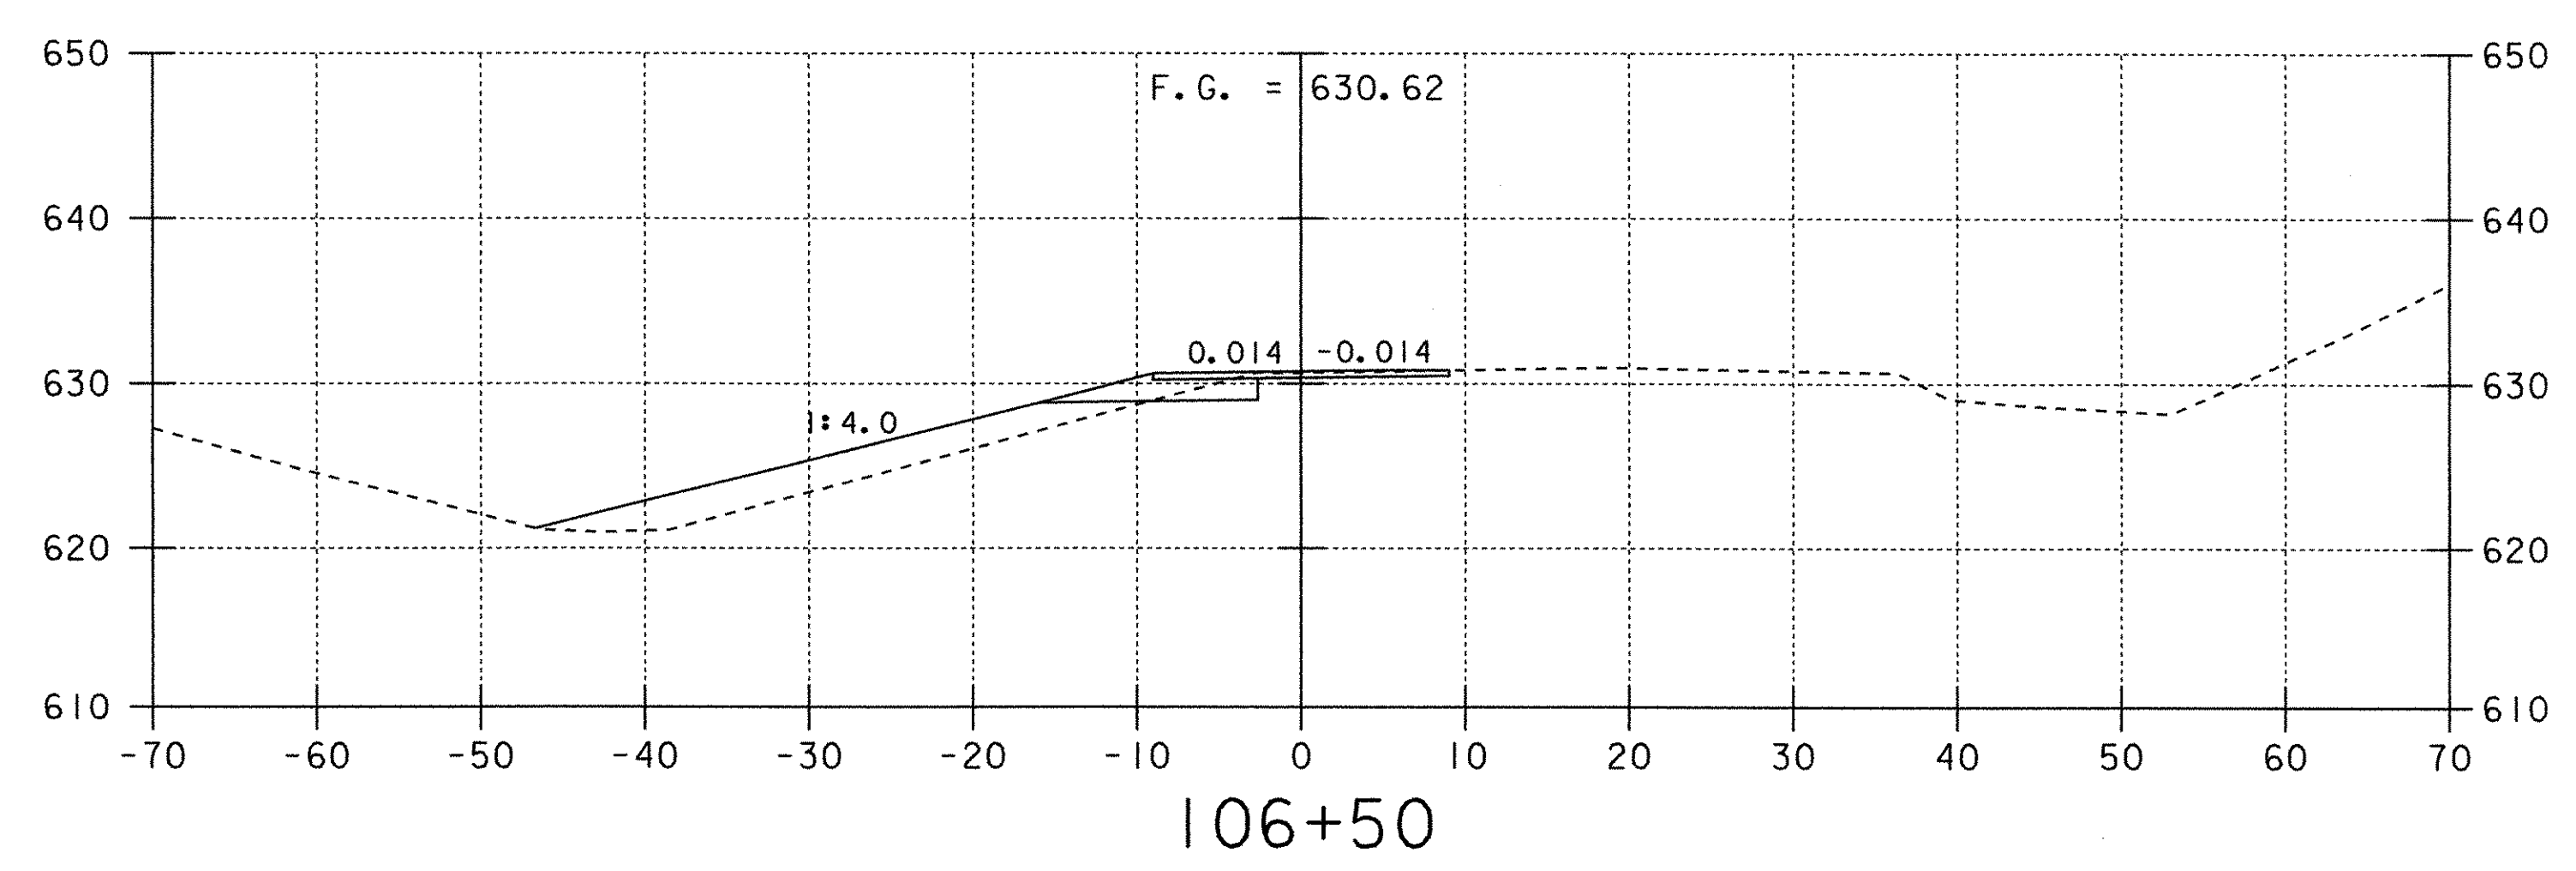


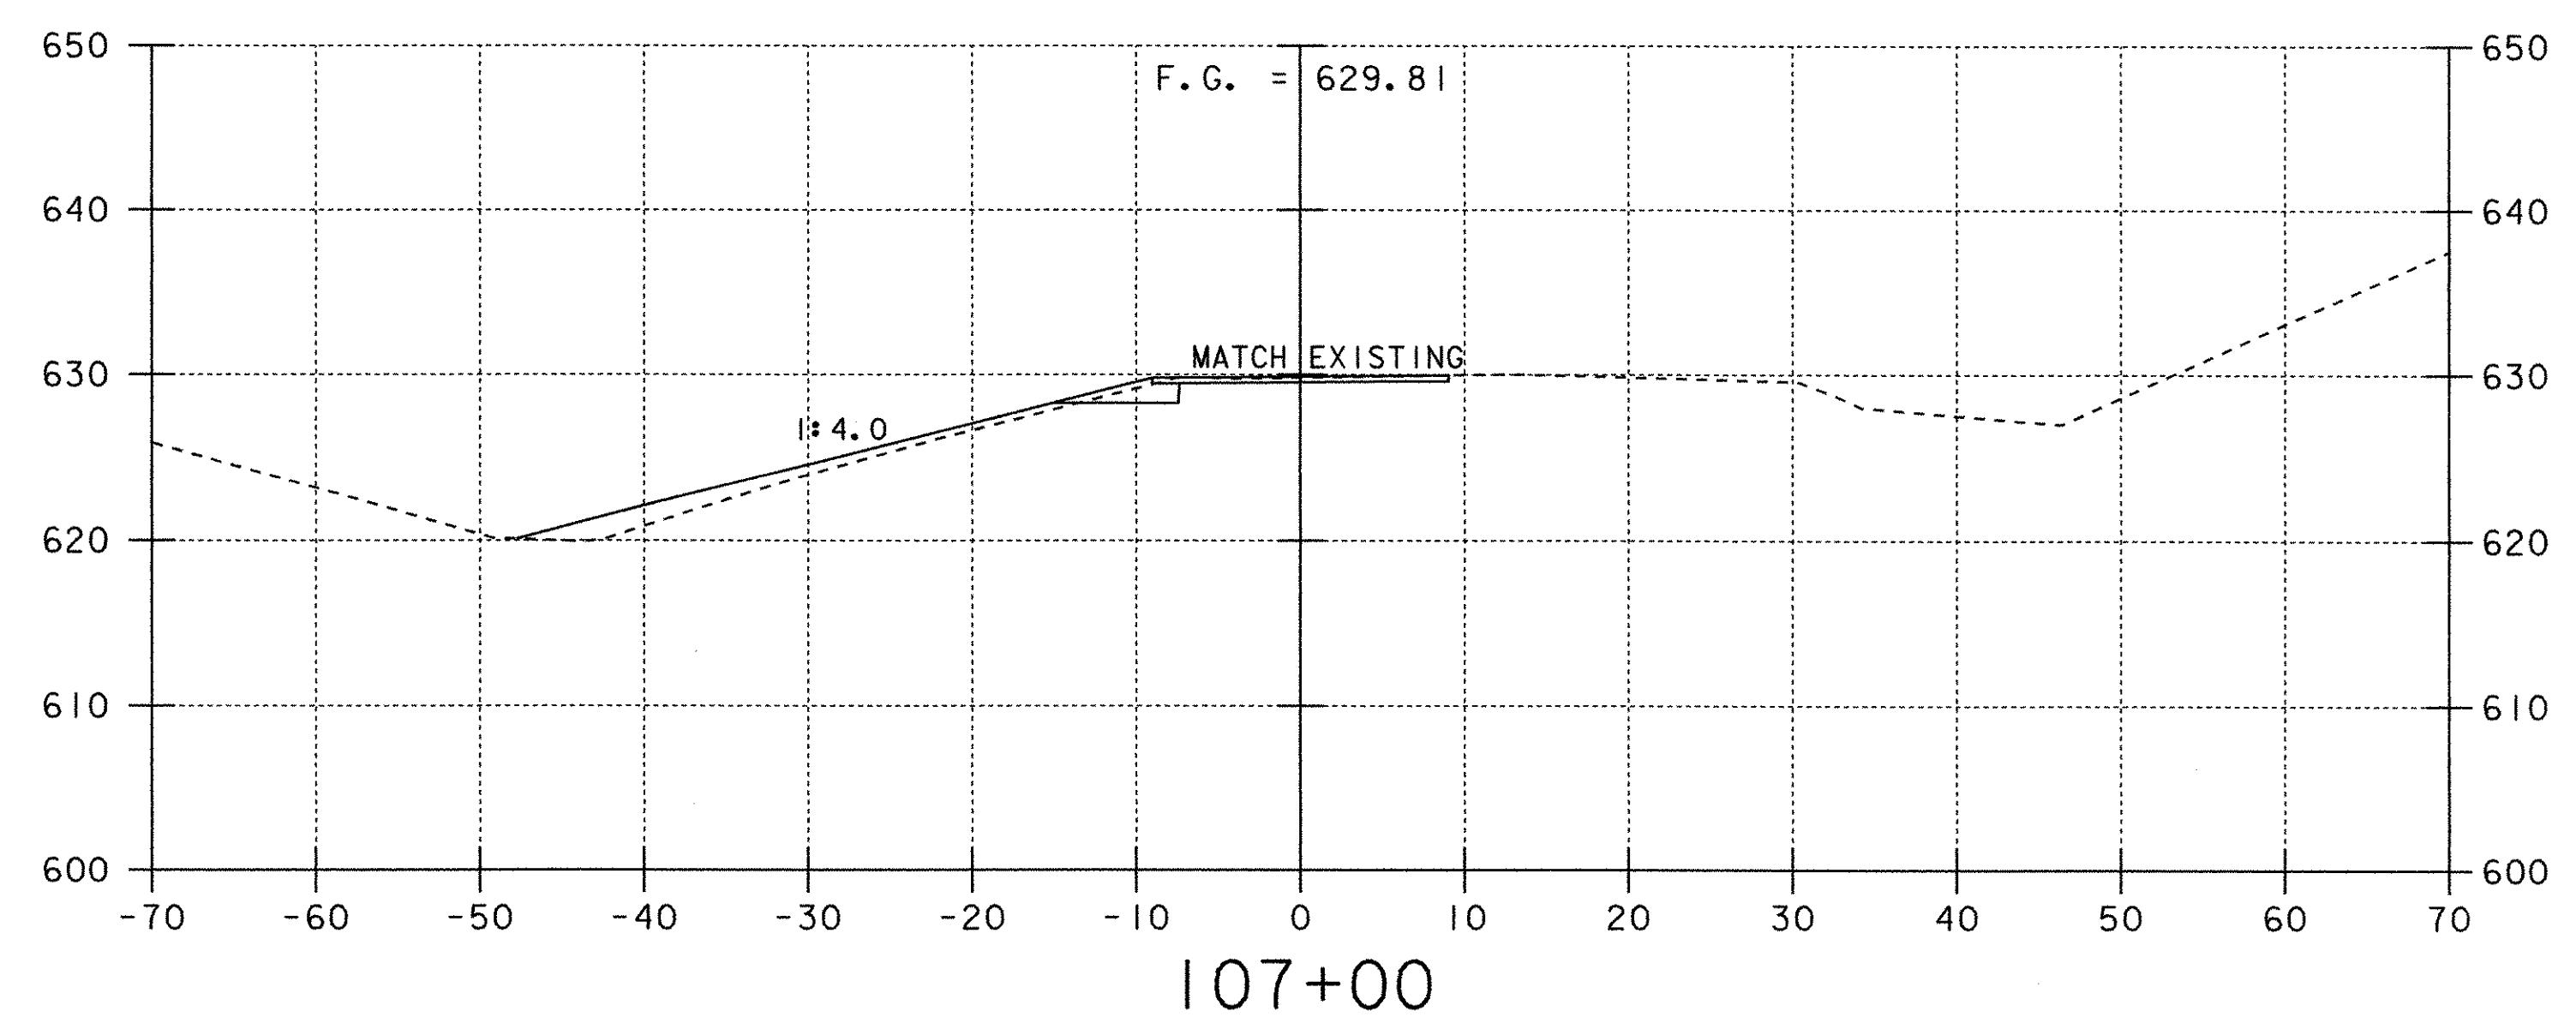

Crossover Sections To End Southbound Detour

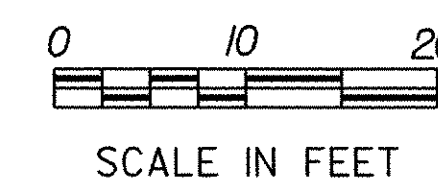

PROJECT:	FAIRFAX-FAIRFIELD-ST. ALBANS	PROJECT NO.:	IM 089-3(27)
DESIGN FILE NAME:	/87A007B/DESIGN/DA007SBA.DGN	PLOT DATE:	14-SEP-2000
IPARM FILE NAME:	DA007SX7	SURVEY DATE:	11/95
SURVEYED BY:	ORVIS	DRAWN BY:	SQUAD B
SQUAD LEADER:	DELLA SANTA	SHEET:	281 OF 370