
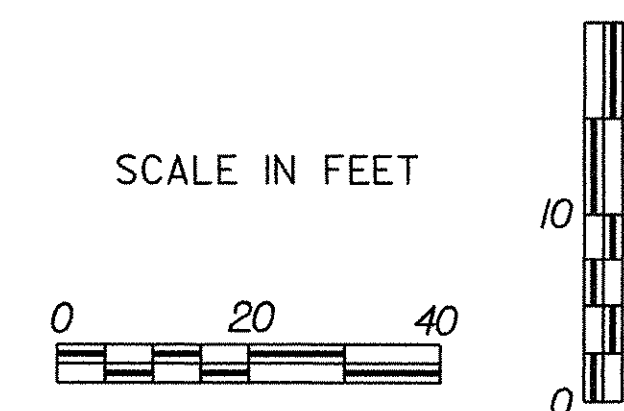
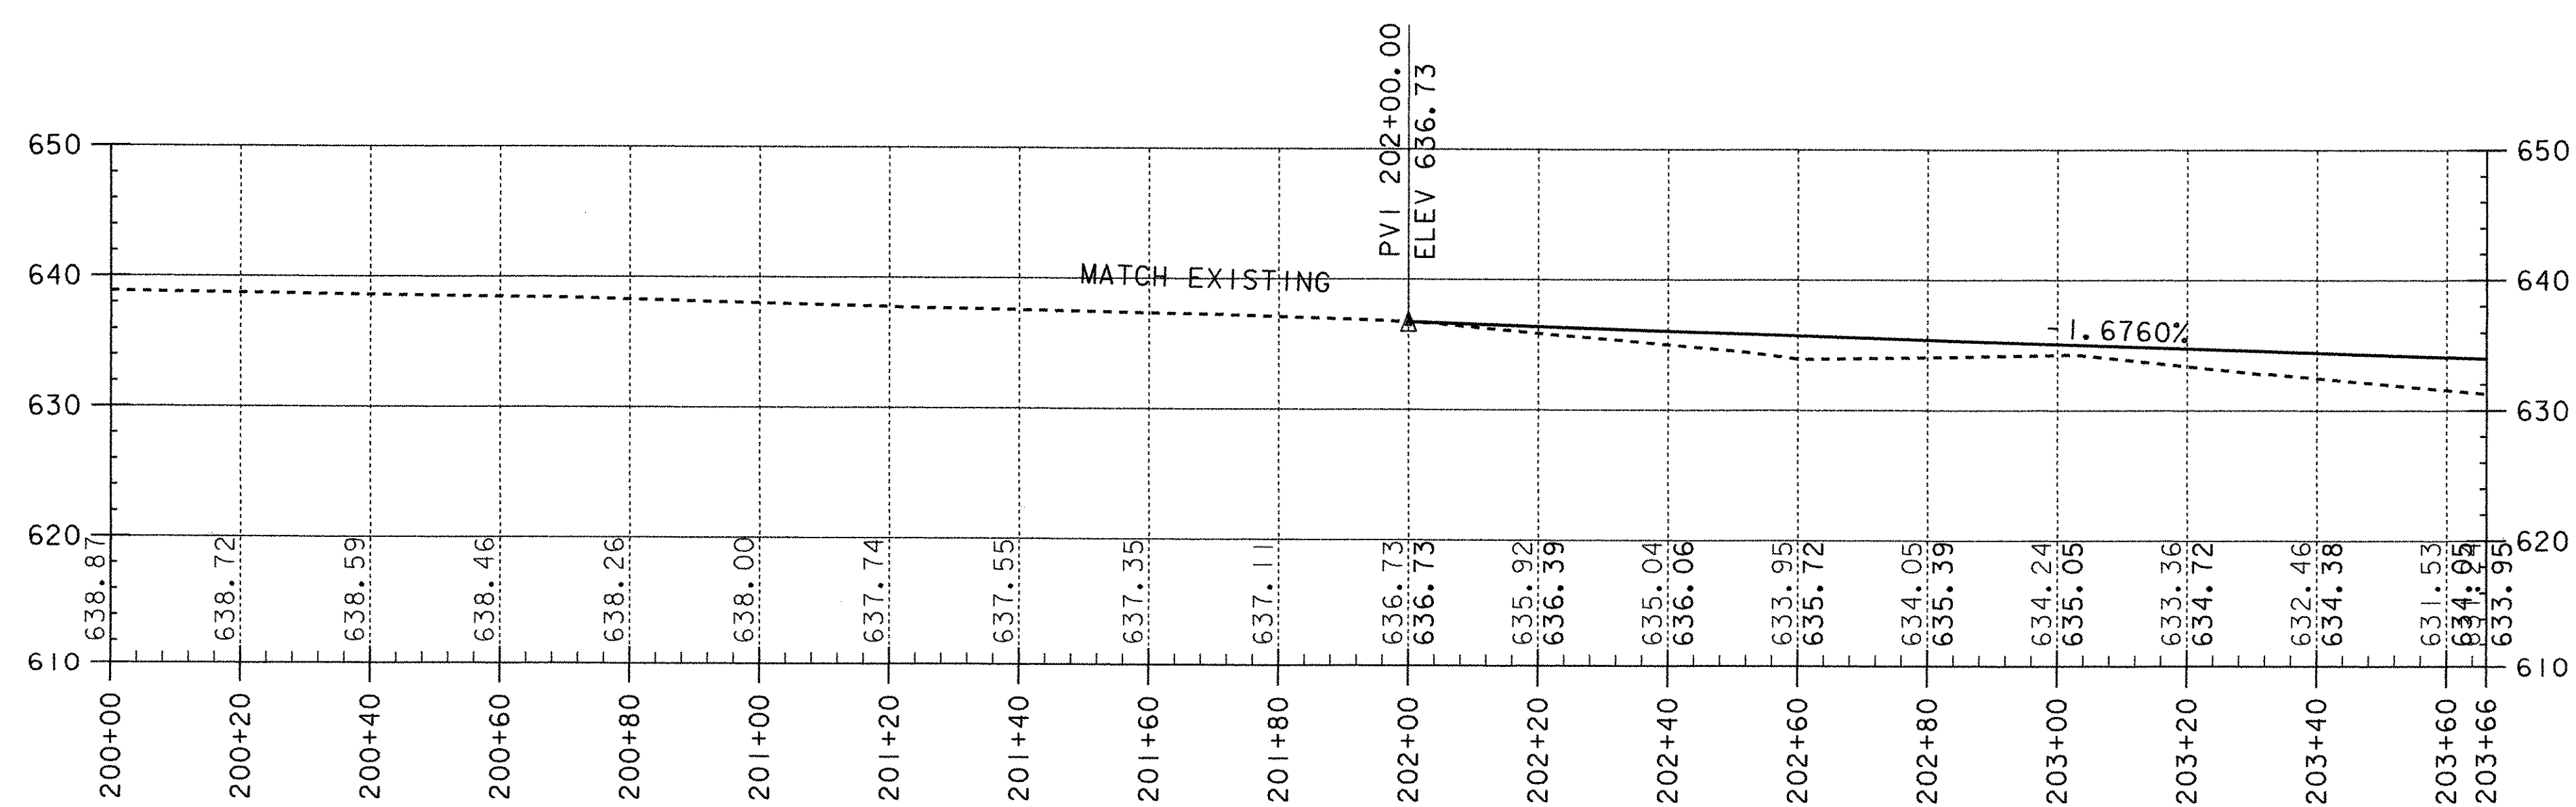


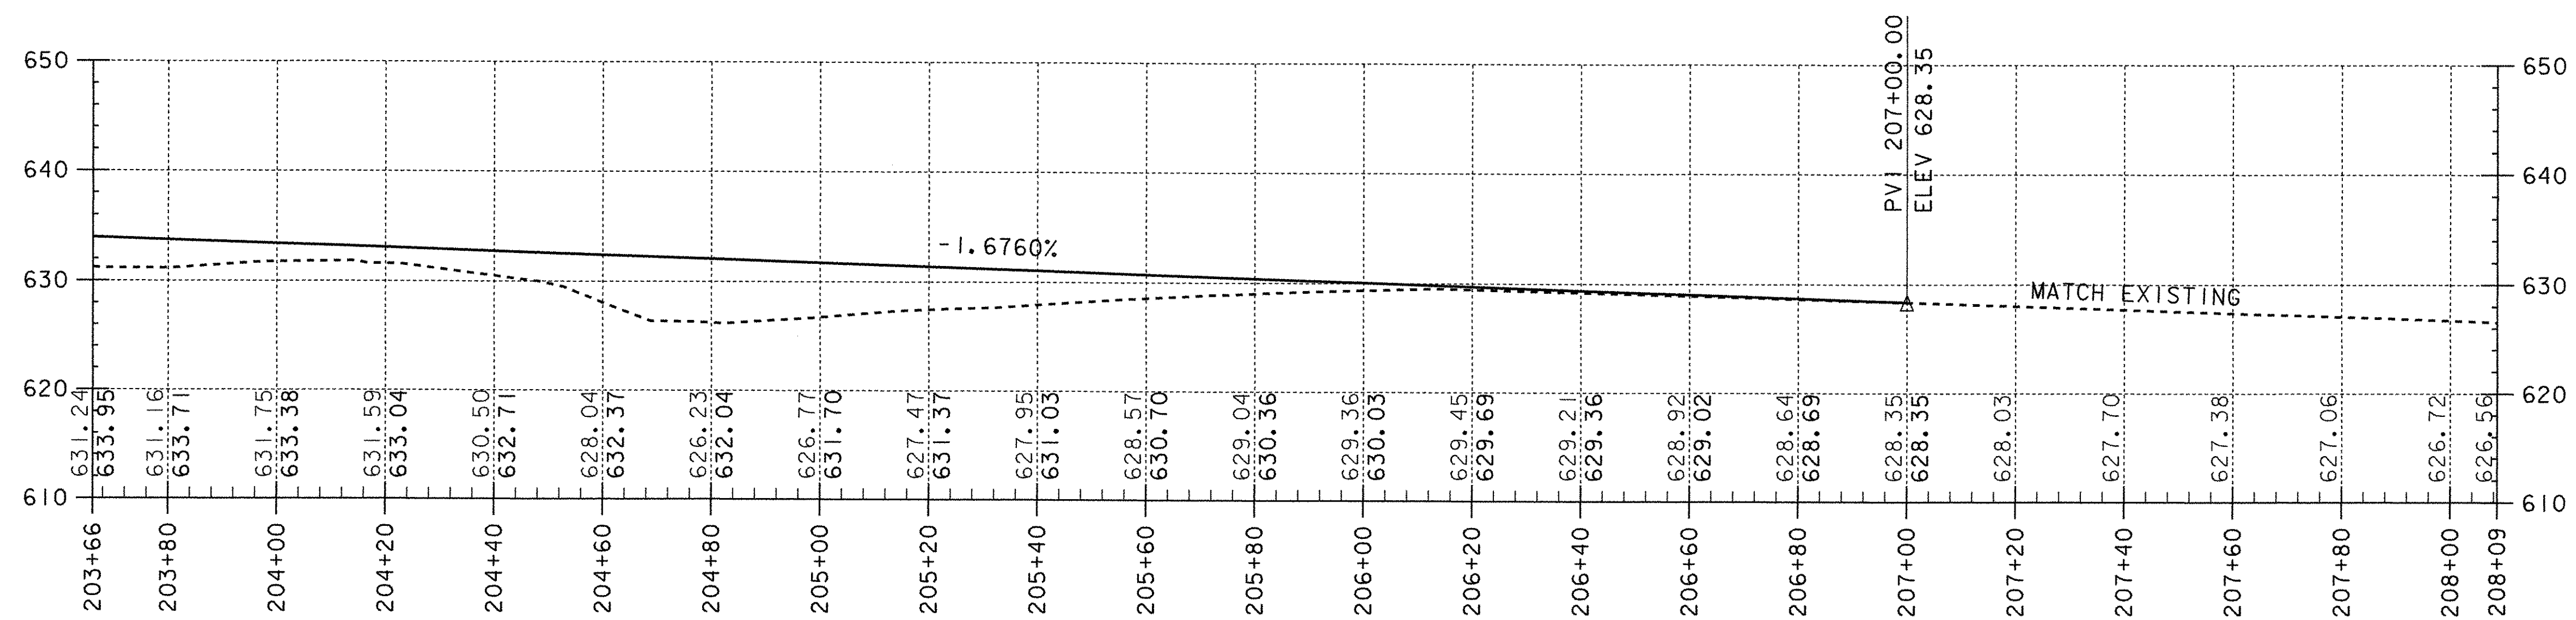

Crossover Profile To Begin Northbound Detour

DATUM	
VERTICAL	NAVD88
HORIZONTAL	NAD83(92)

PROJECT:	FAIRFAX-FAIRFIELD-ST. ALBANS	PROJECT NO.:	IM 089-3(27)
DESIGN FILE NAME:	/87A007B/DESIGN/DA007NBA.DGN	PLOT DATE:	22-AUG-2000
IPARM FILE NAME:	DA007NCP	SURVEY DATE:	11/95
SURVEYED BY:	ORVIS	DRAWN BY:	SQUAD B
SQUAD LEADER:	DELLA SANTA	SHEET:	285 OF 370