
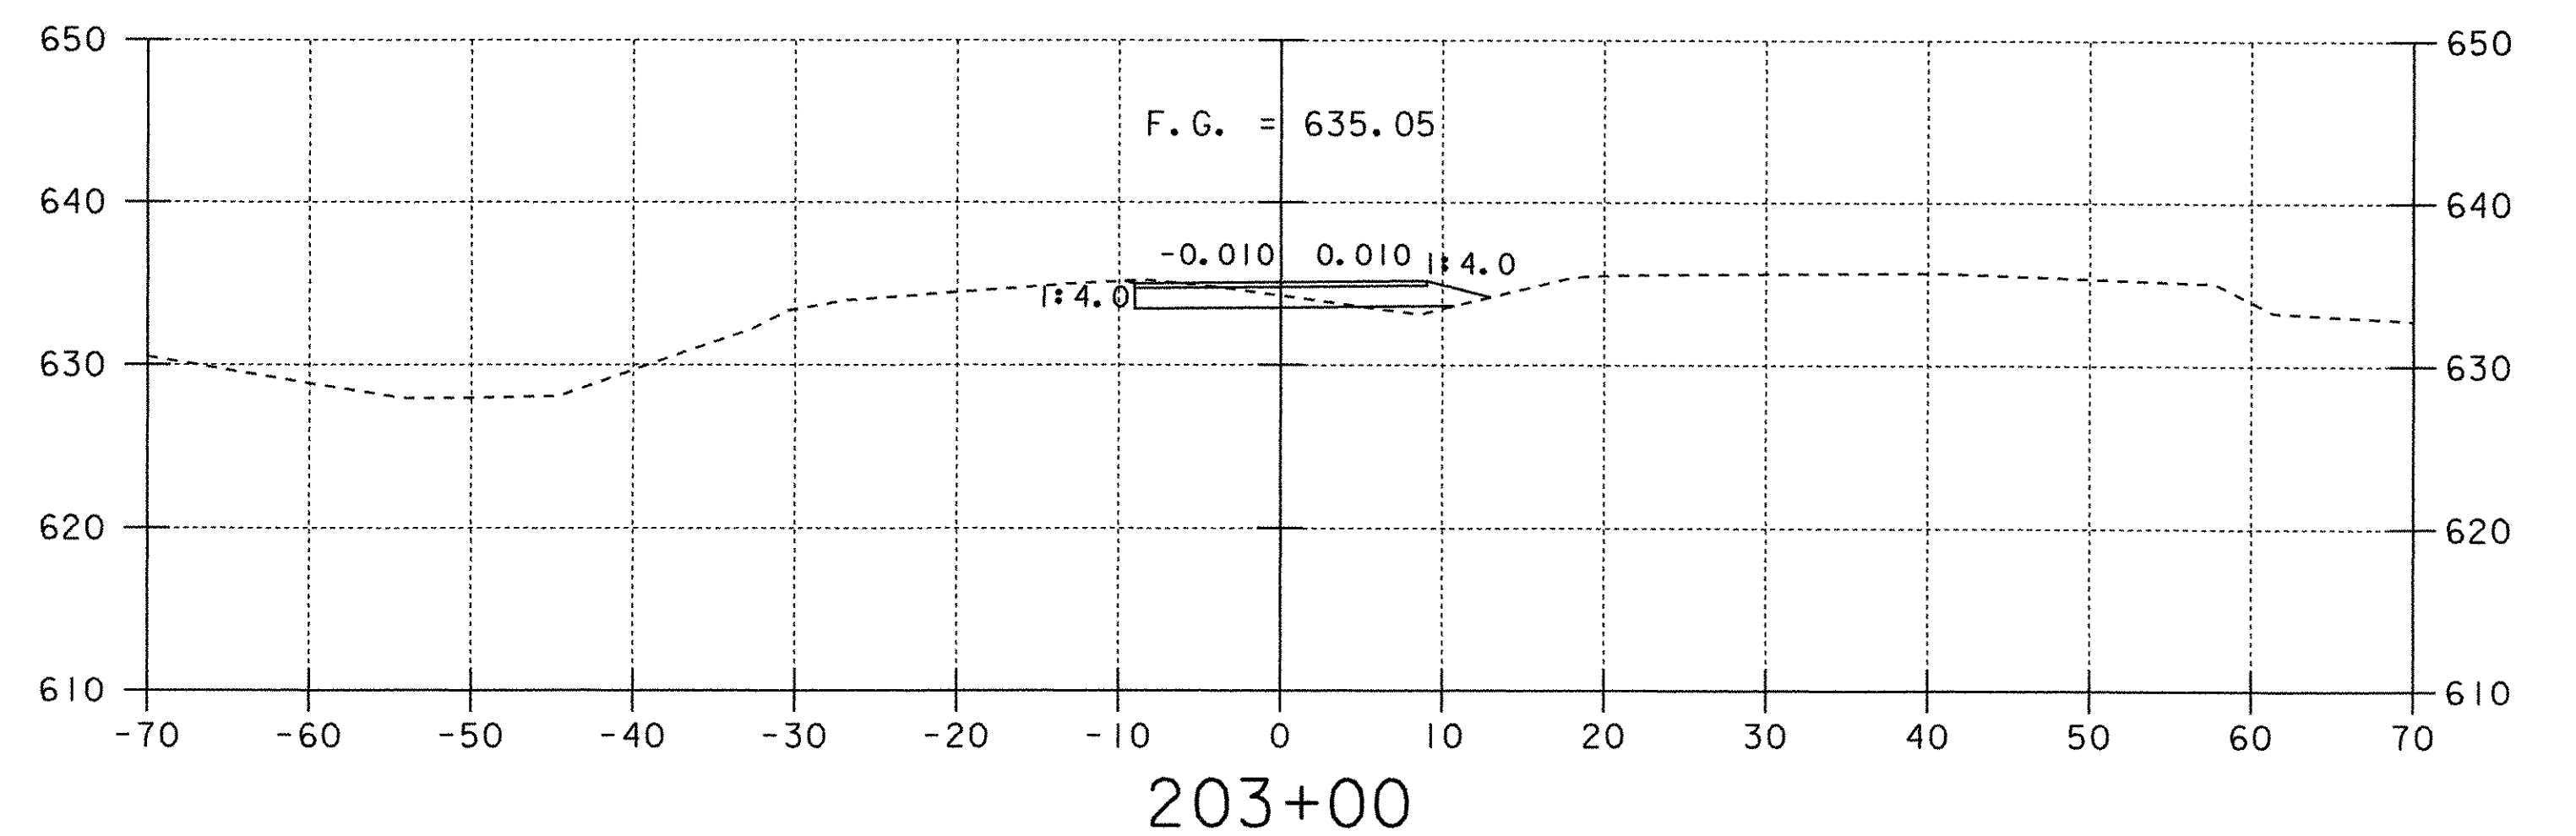
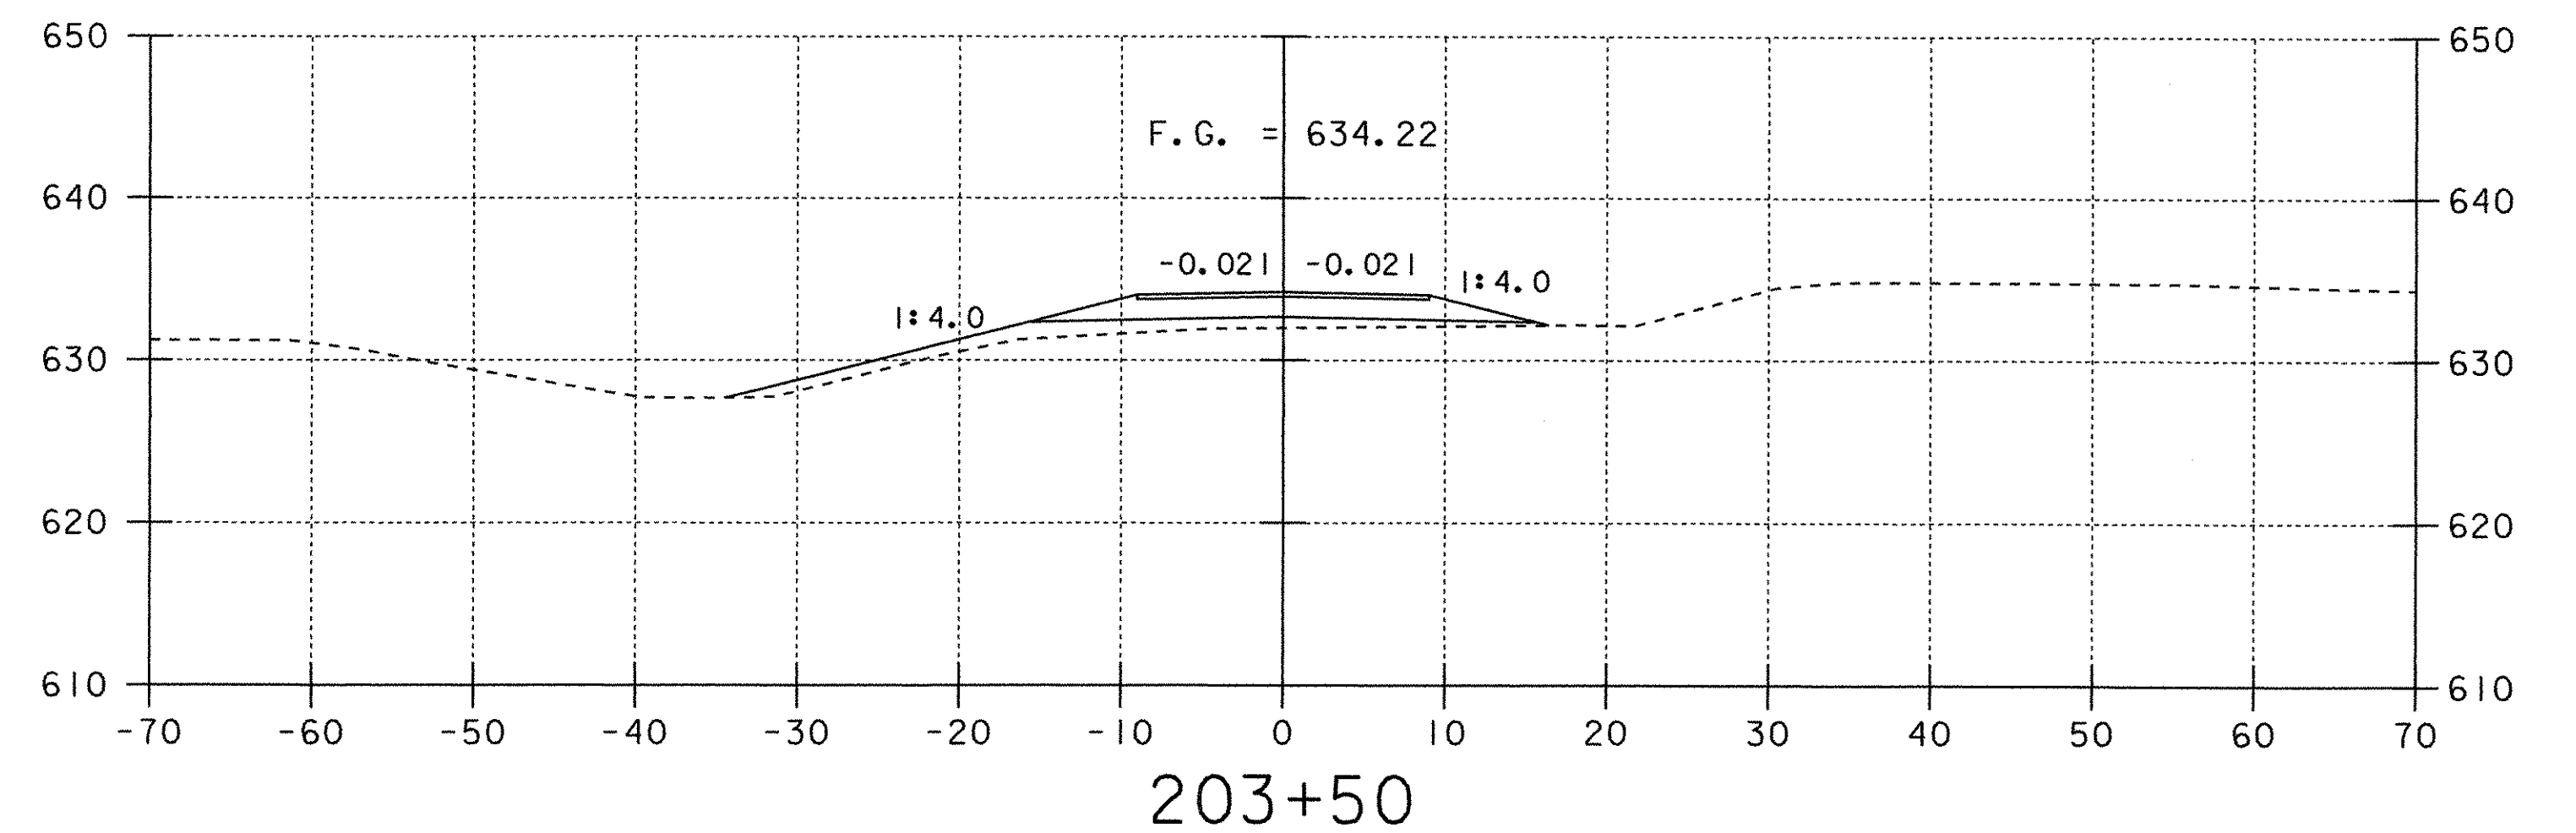
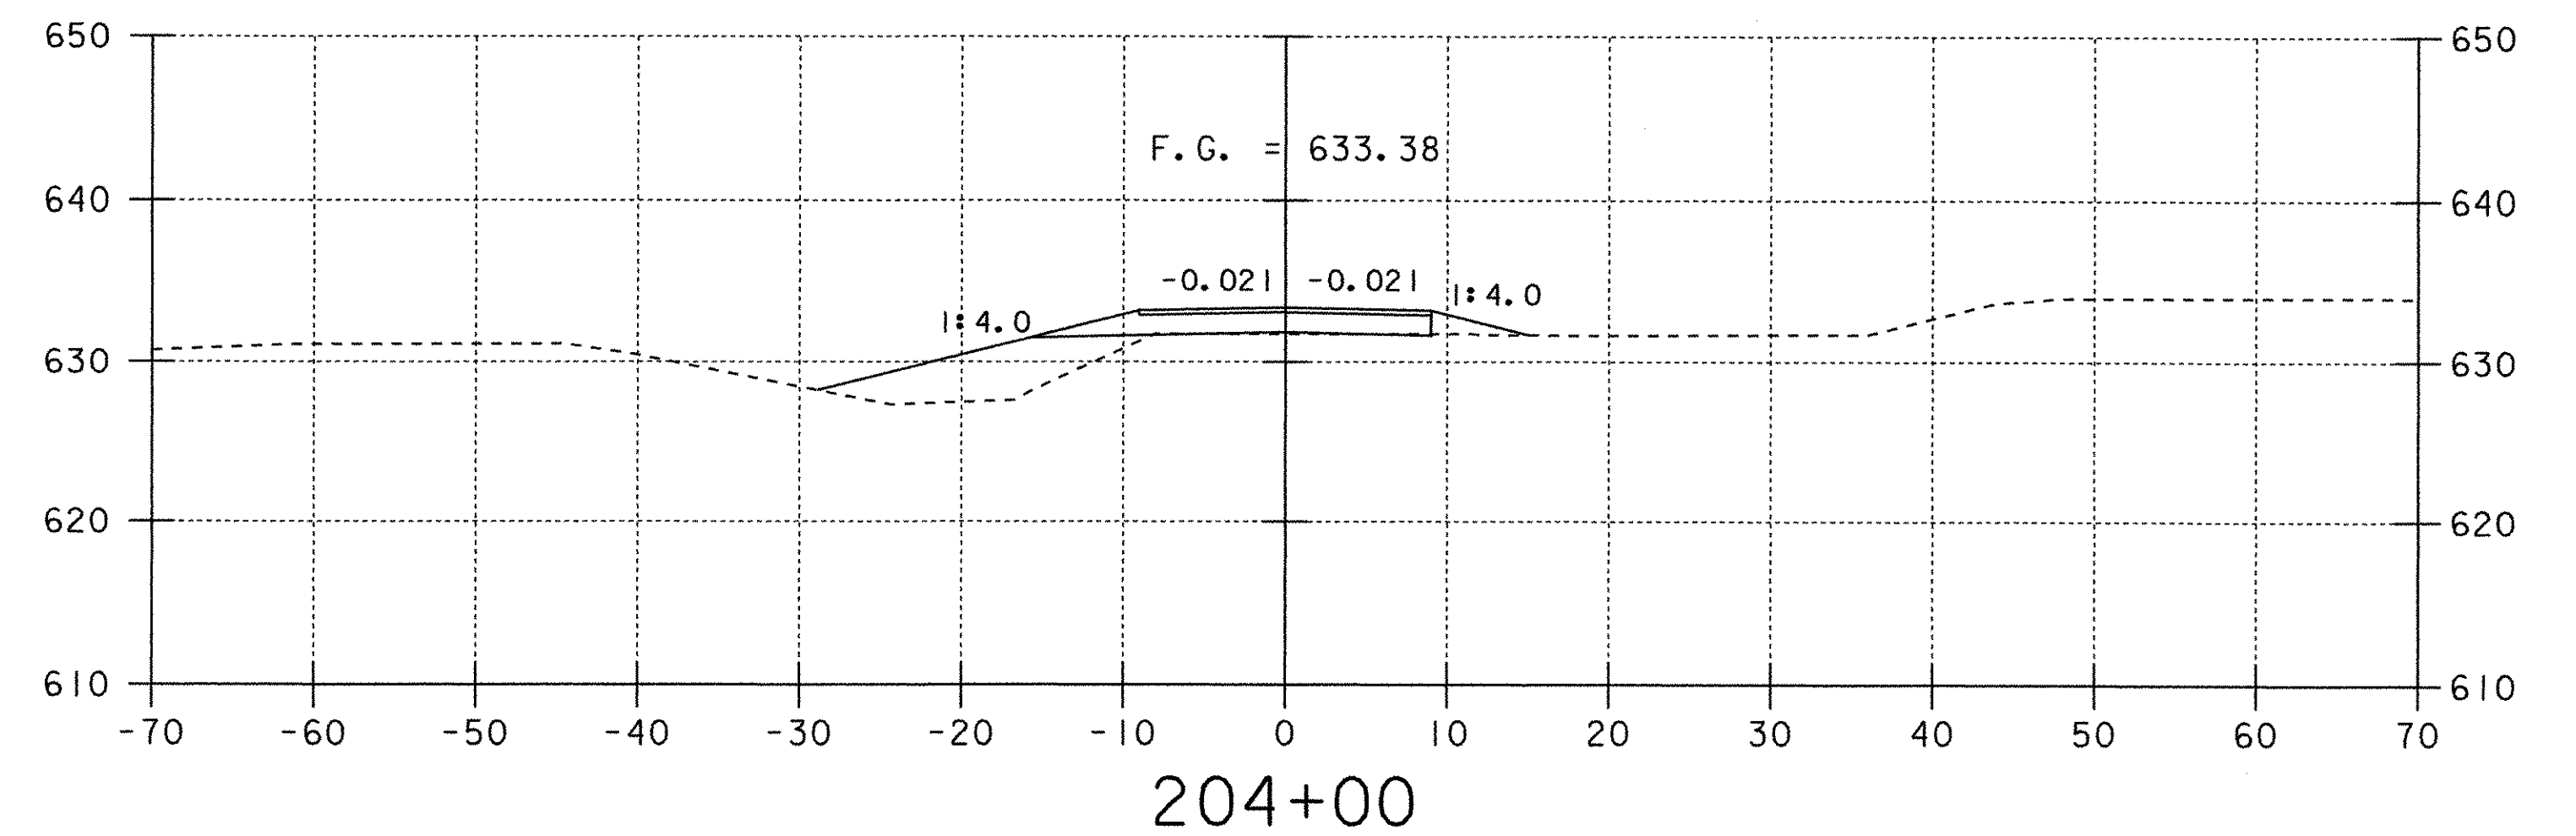
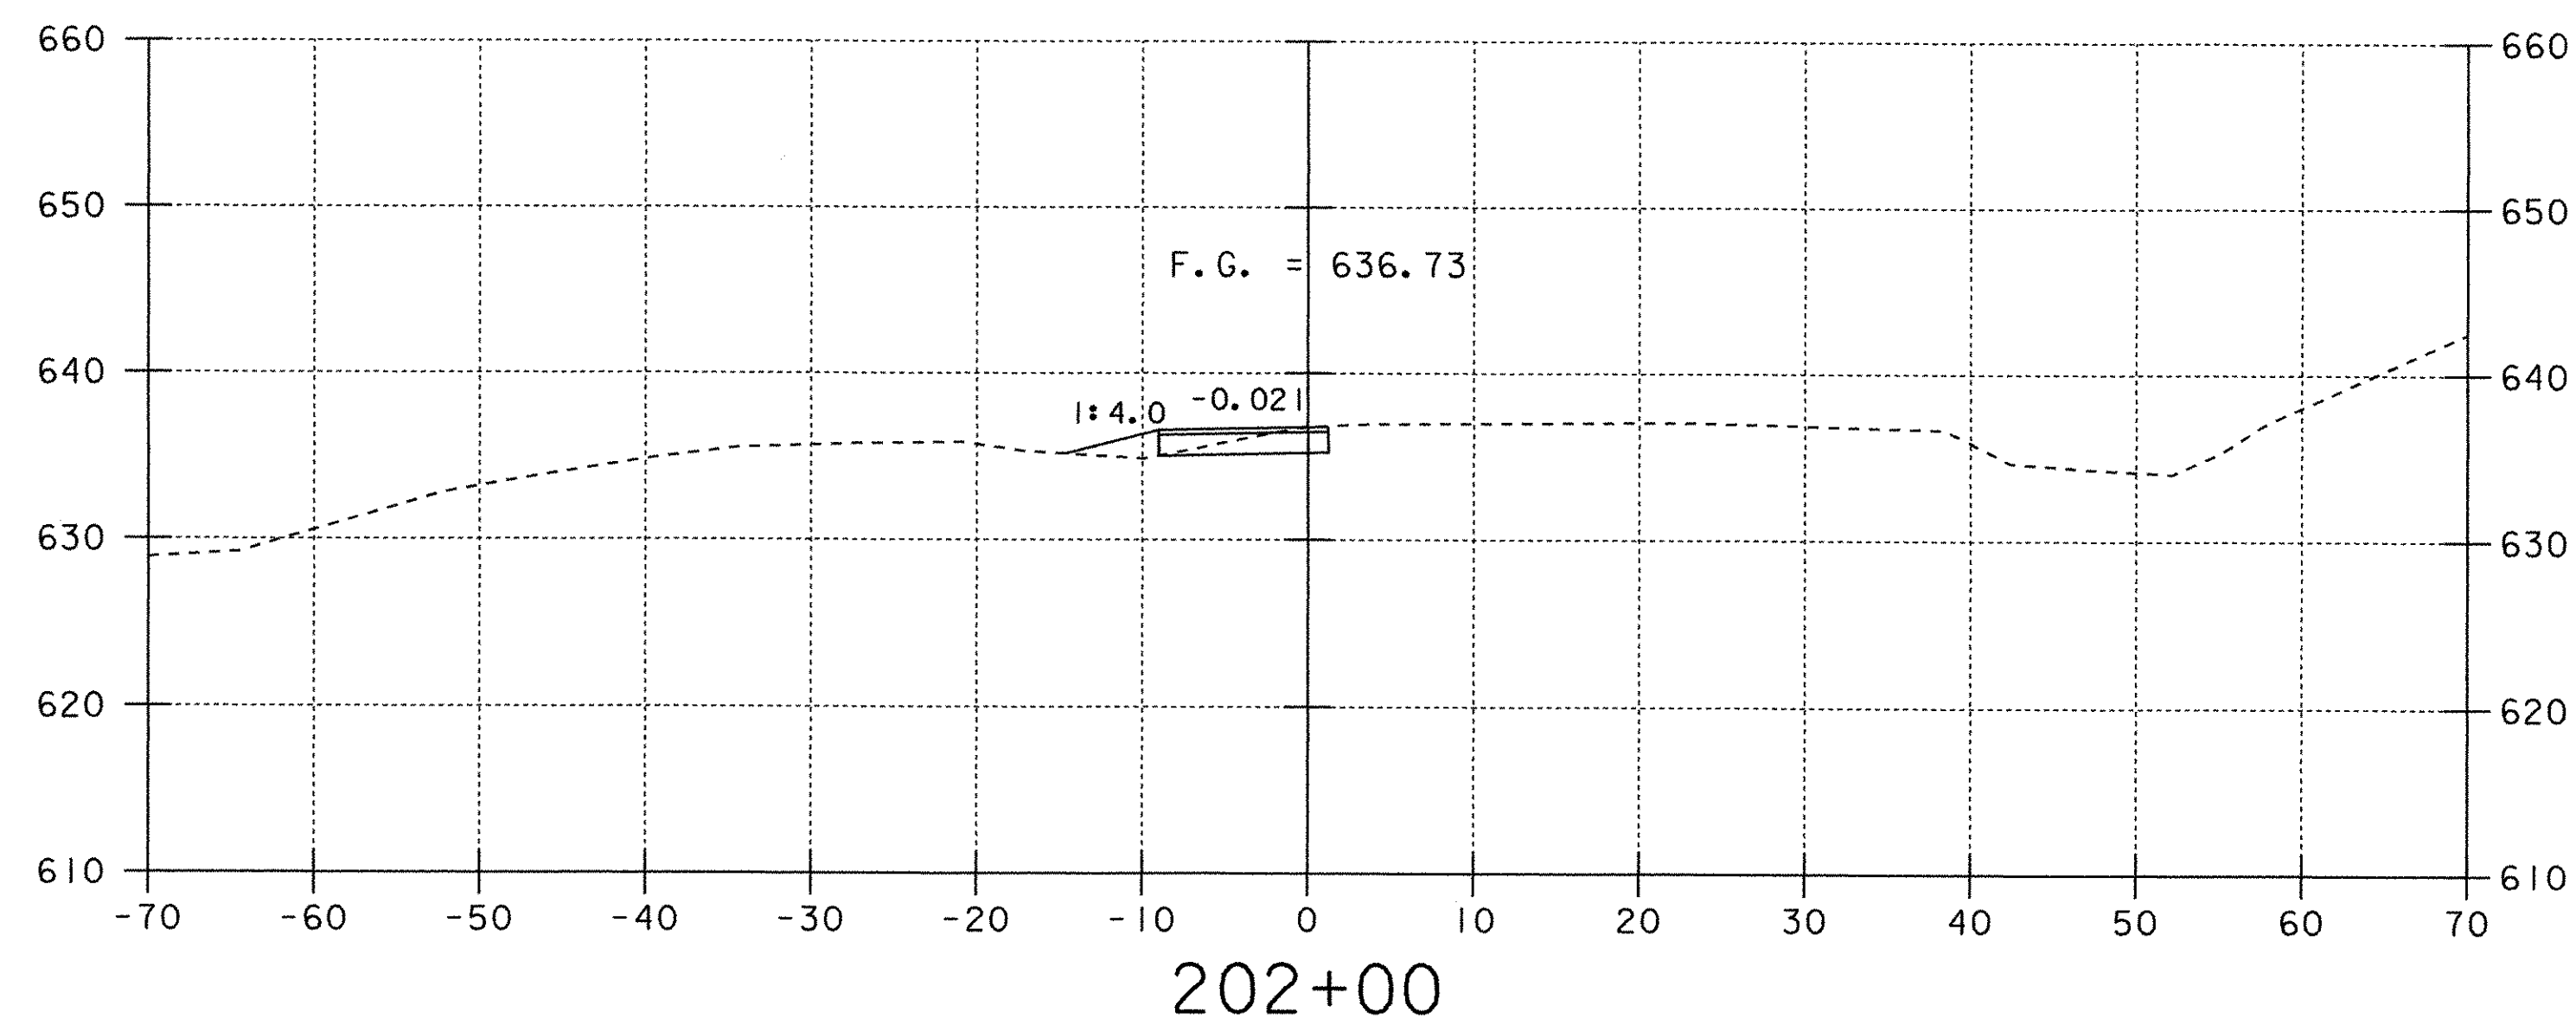


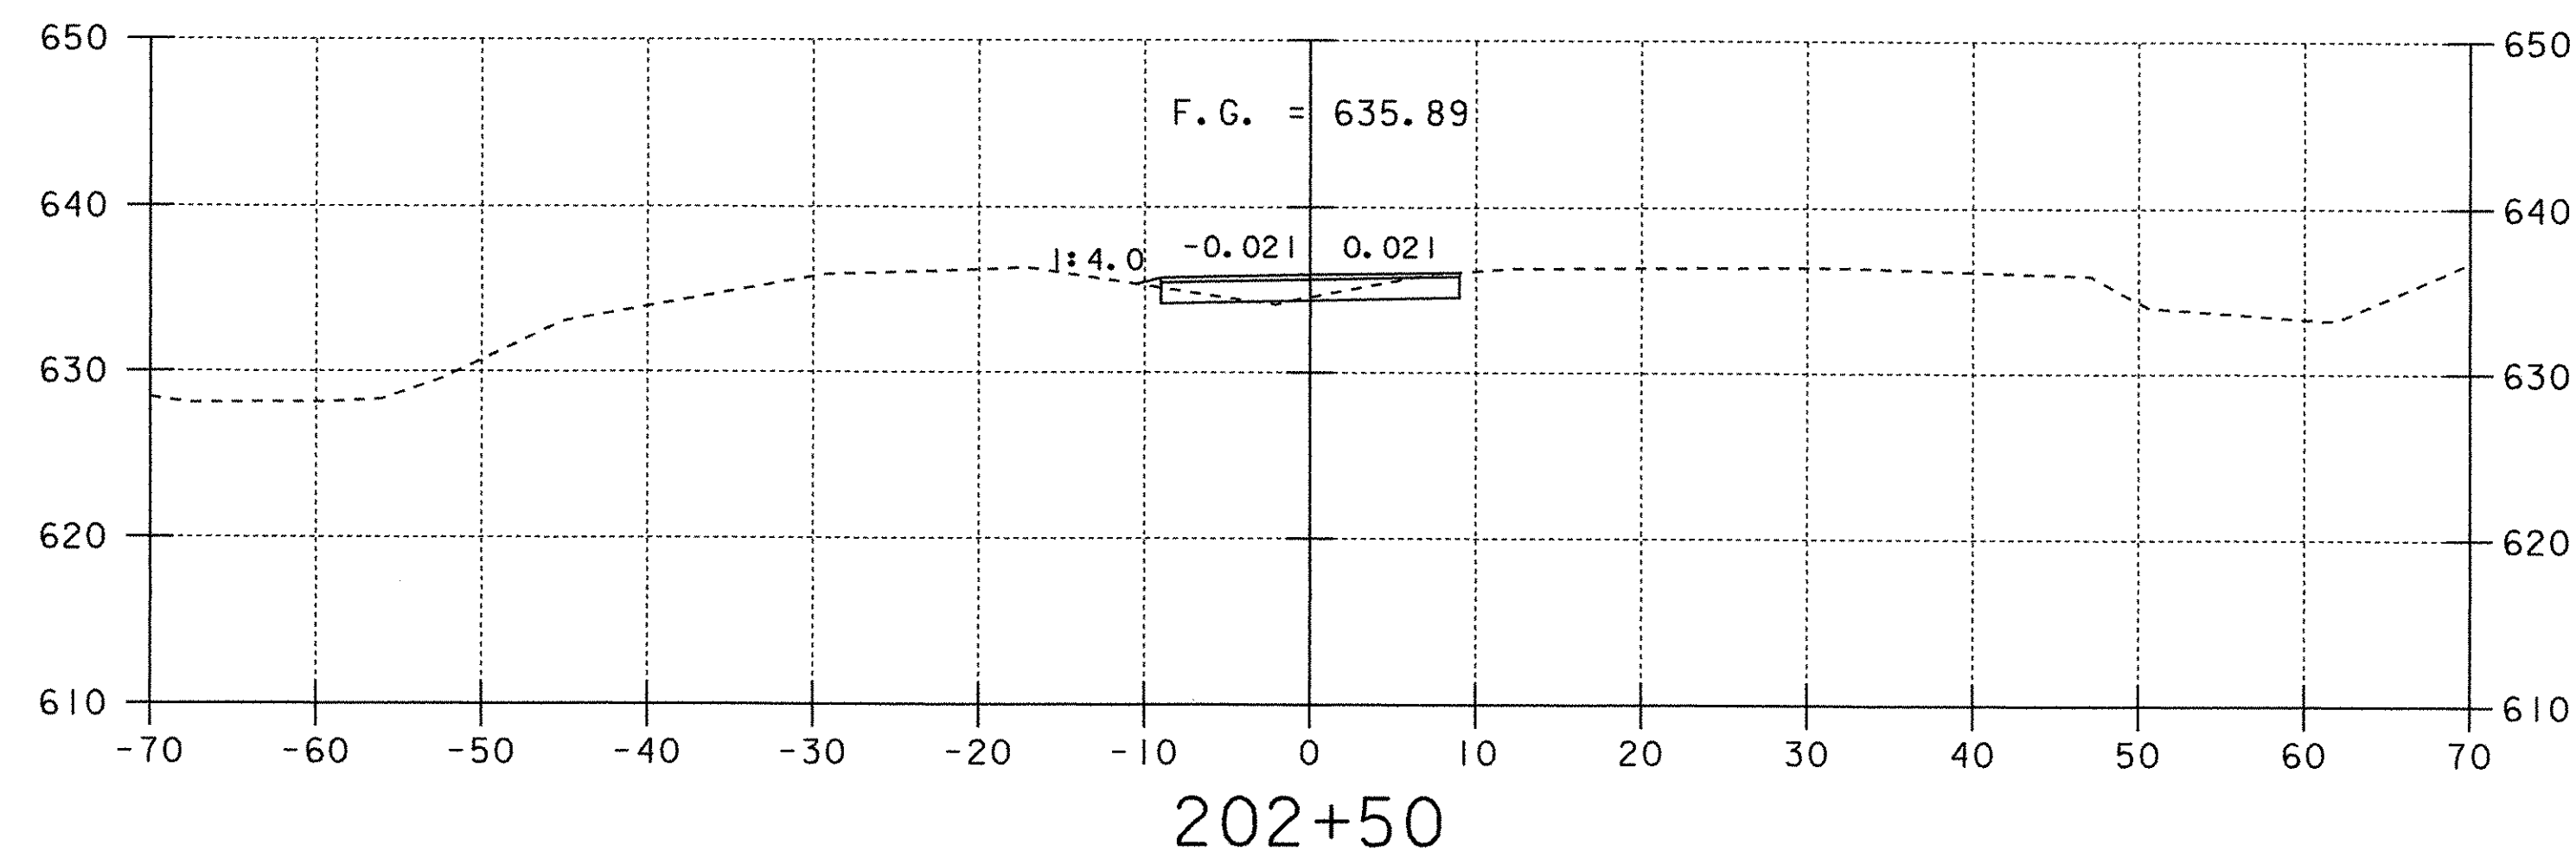

Crossover Cross Sections To Begin Northbound Detour

0 10 20
SCALE IN FEET

PROJECT:	FAIRFAX-FAIRFIELD-ST. ALBANS	PROJECT NO.:	IM 089-3(27)
DESIGN FILE NAME:	/87A007B/DESIGN/DA007NBA.DGN	PLOT DATE:	22-AUG-2000
IPARM FILE NAME:	DA007NXI	SURVEY DATE:	11/95
SURVEYED BY:	ORVIS	DRAWN BY:	SQUAD B
SQUAD LEADER:	DELLA SANTA	SHEET:	286 OF 370