

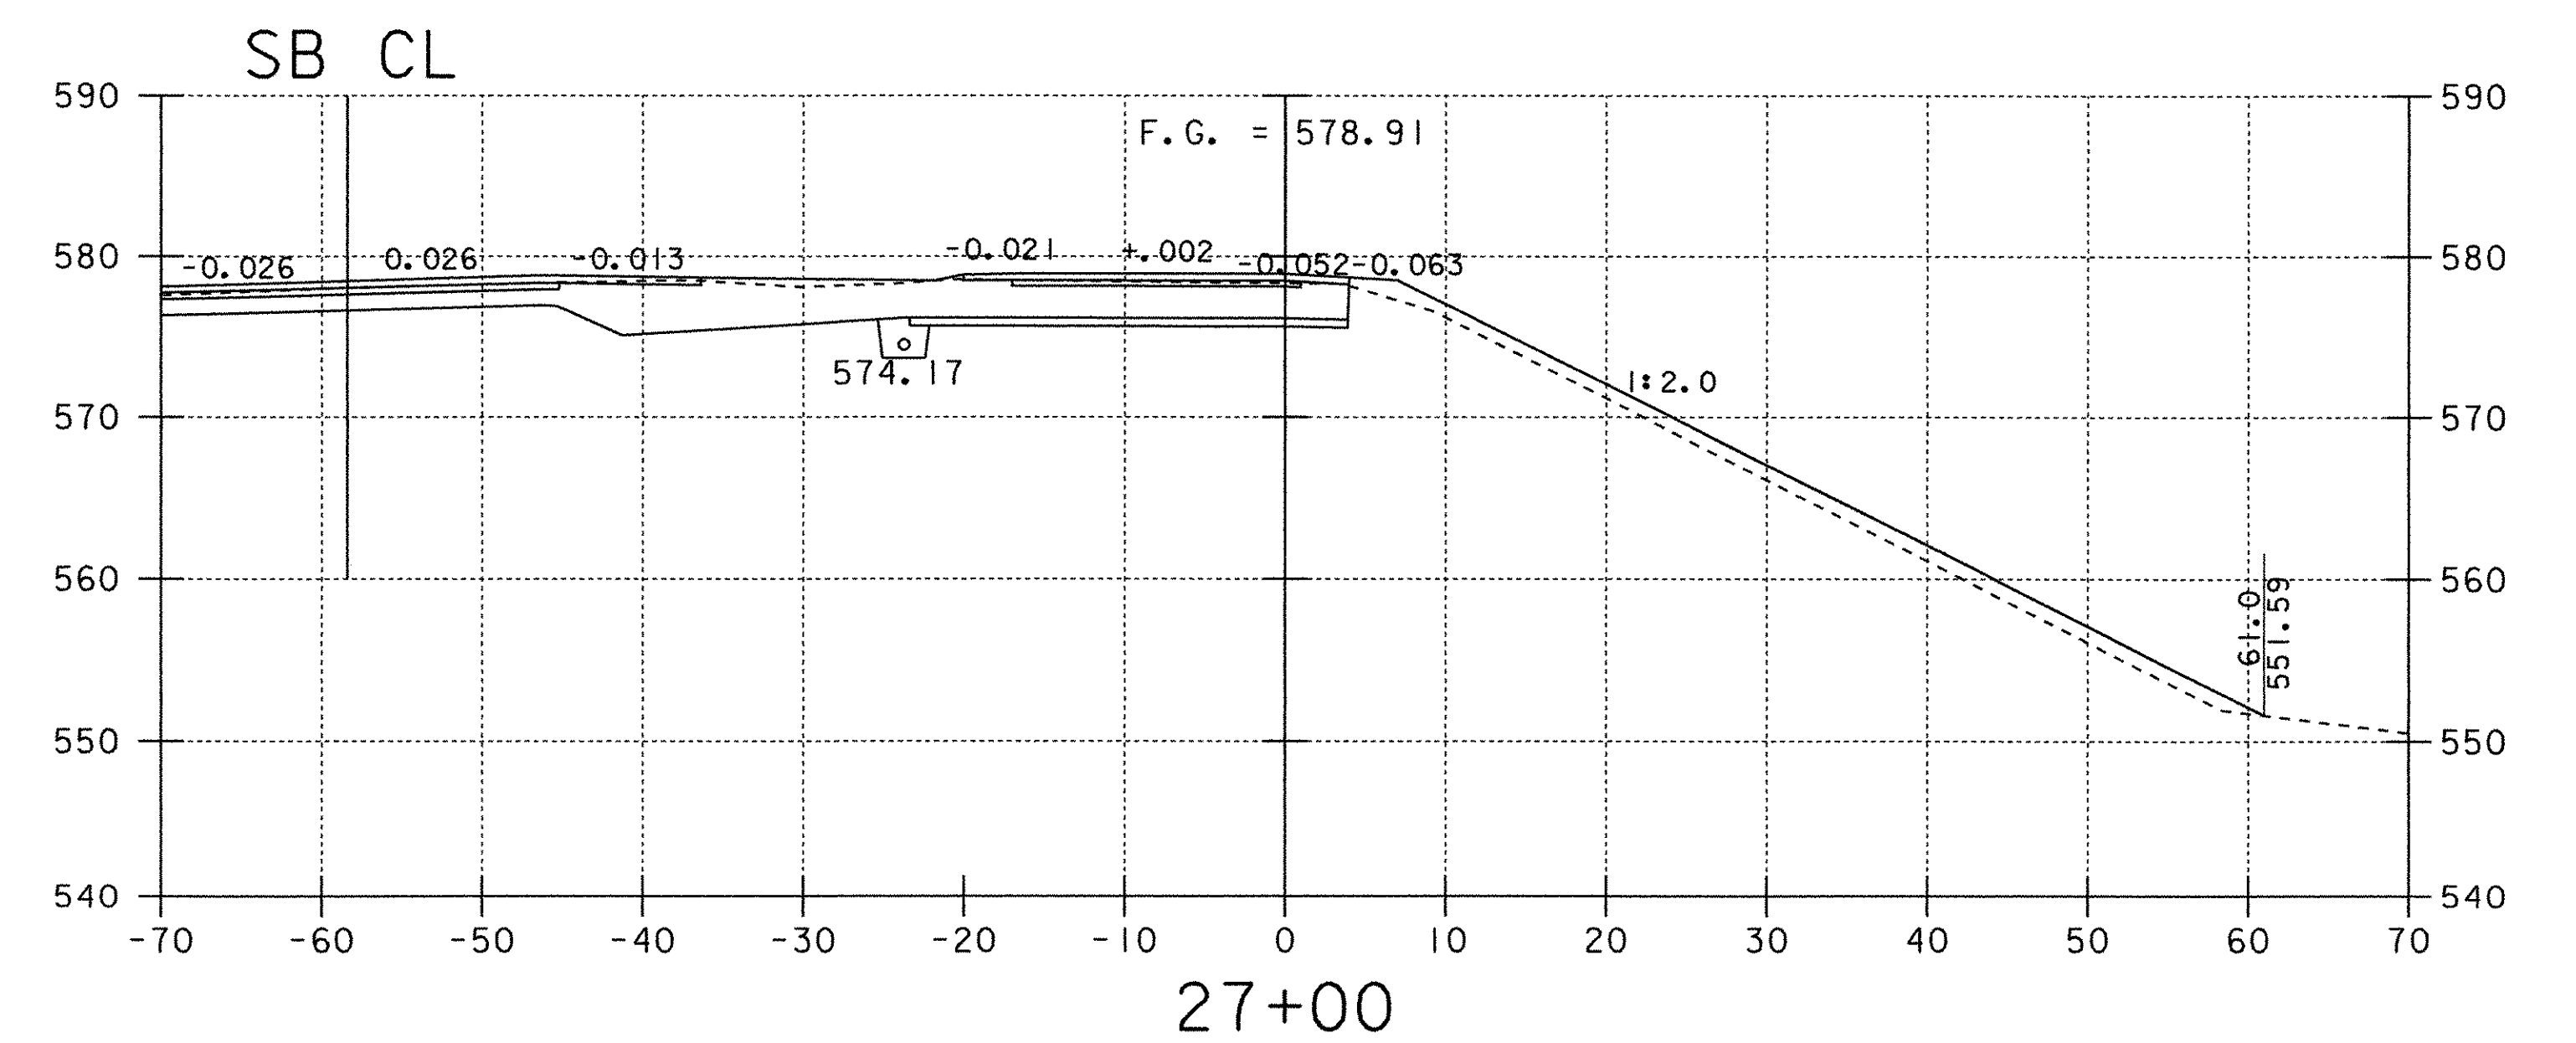
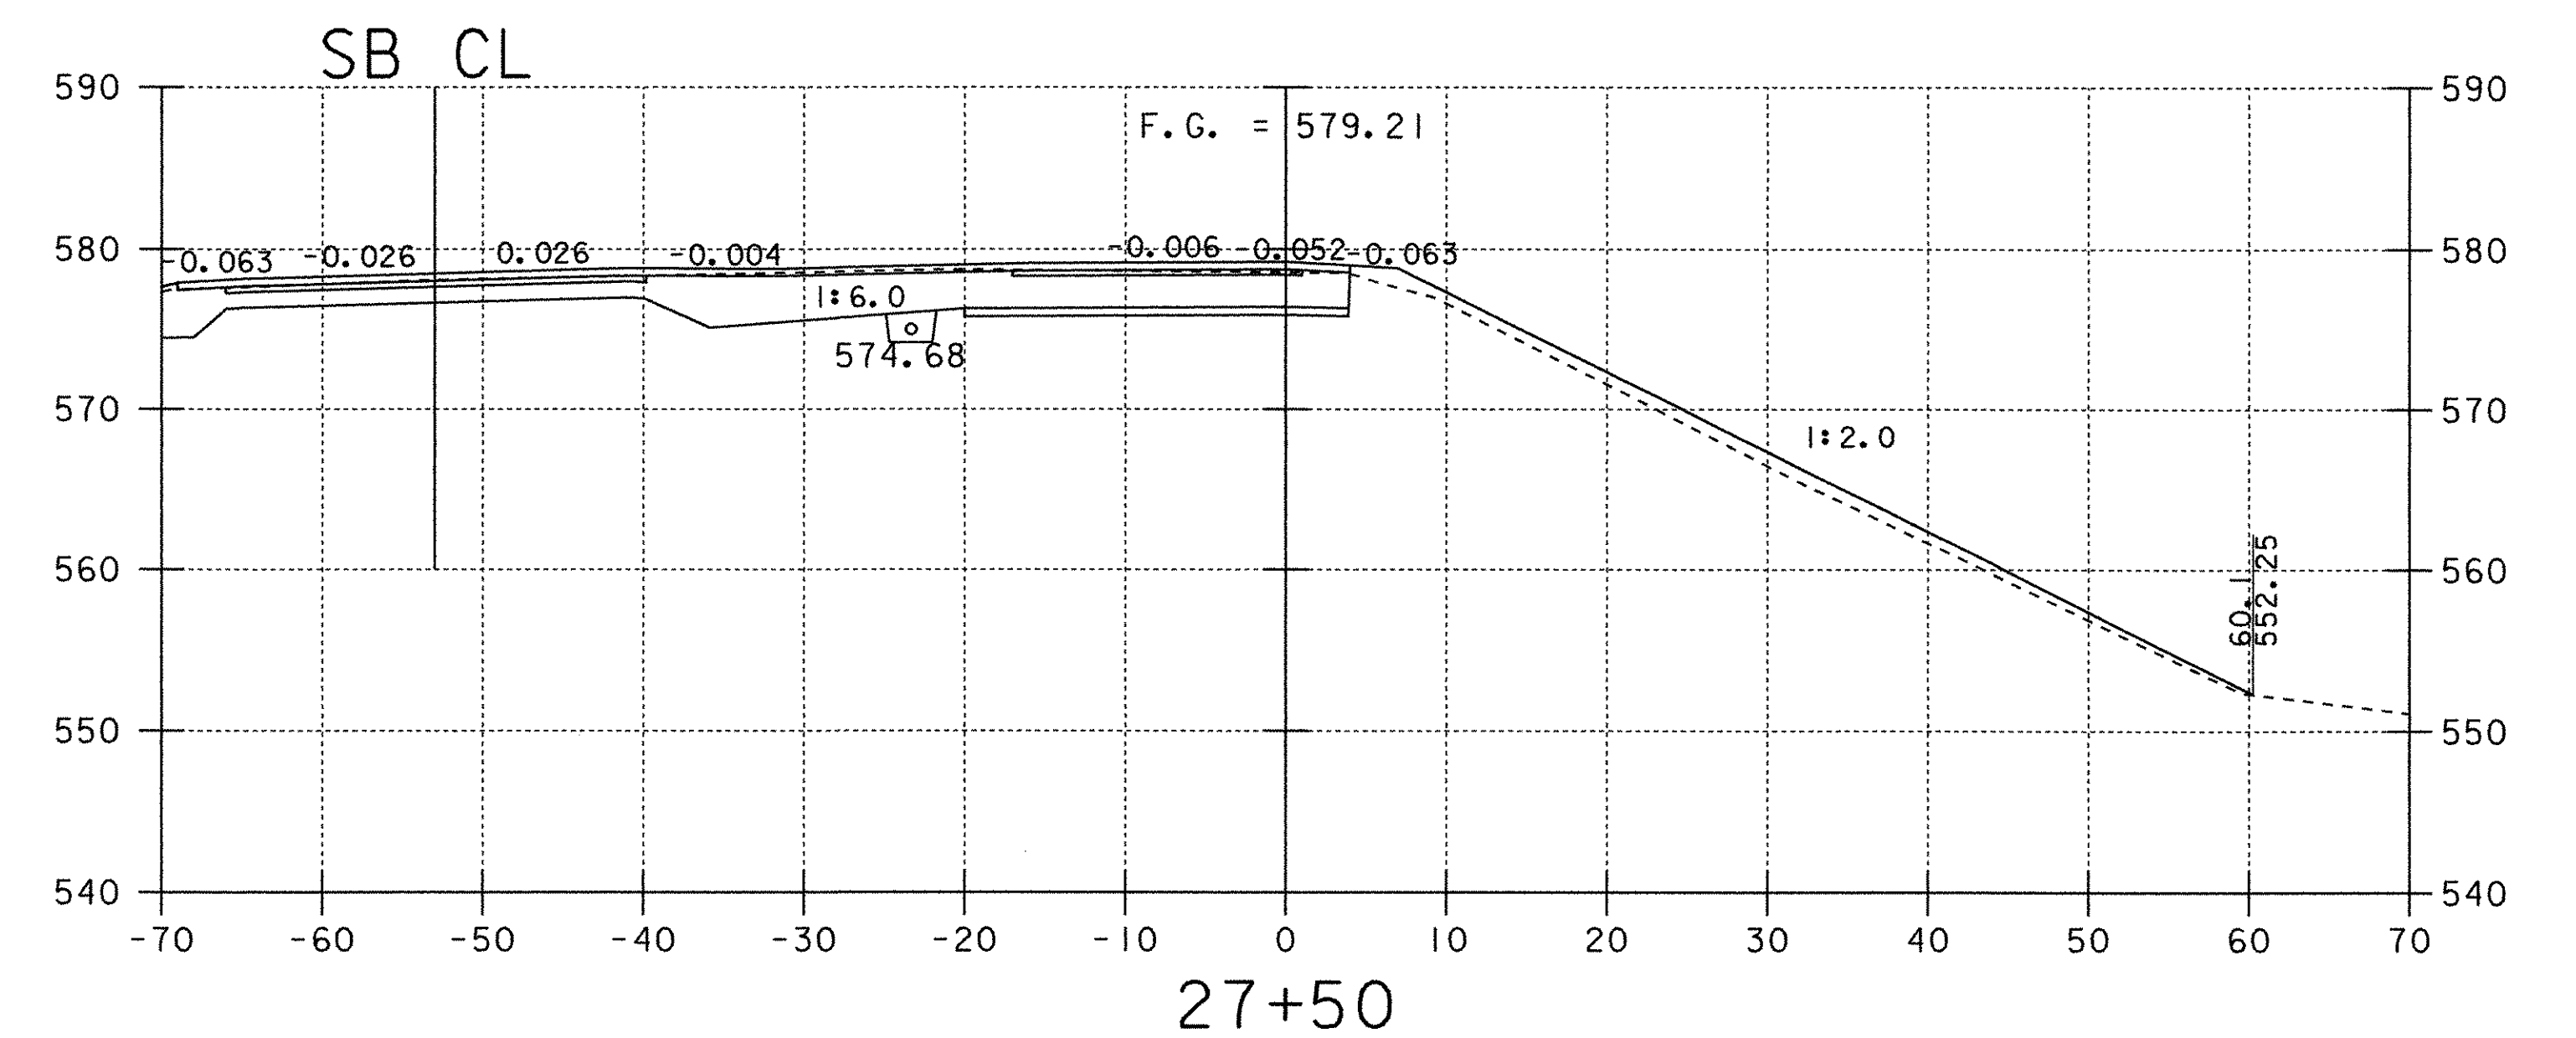
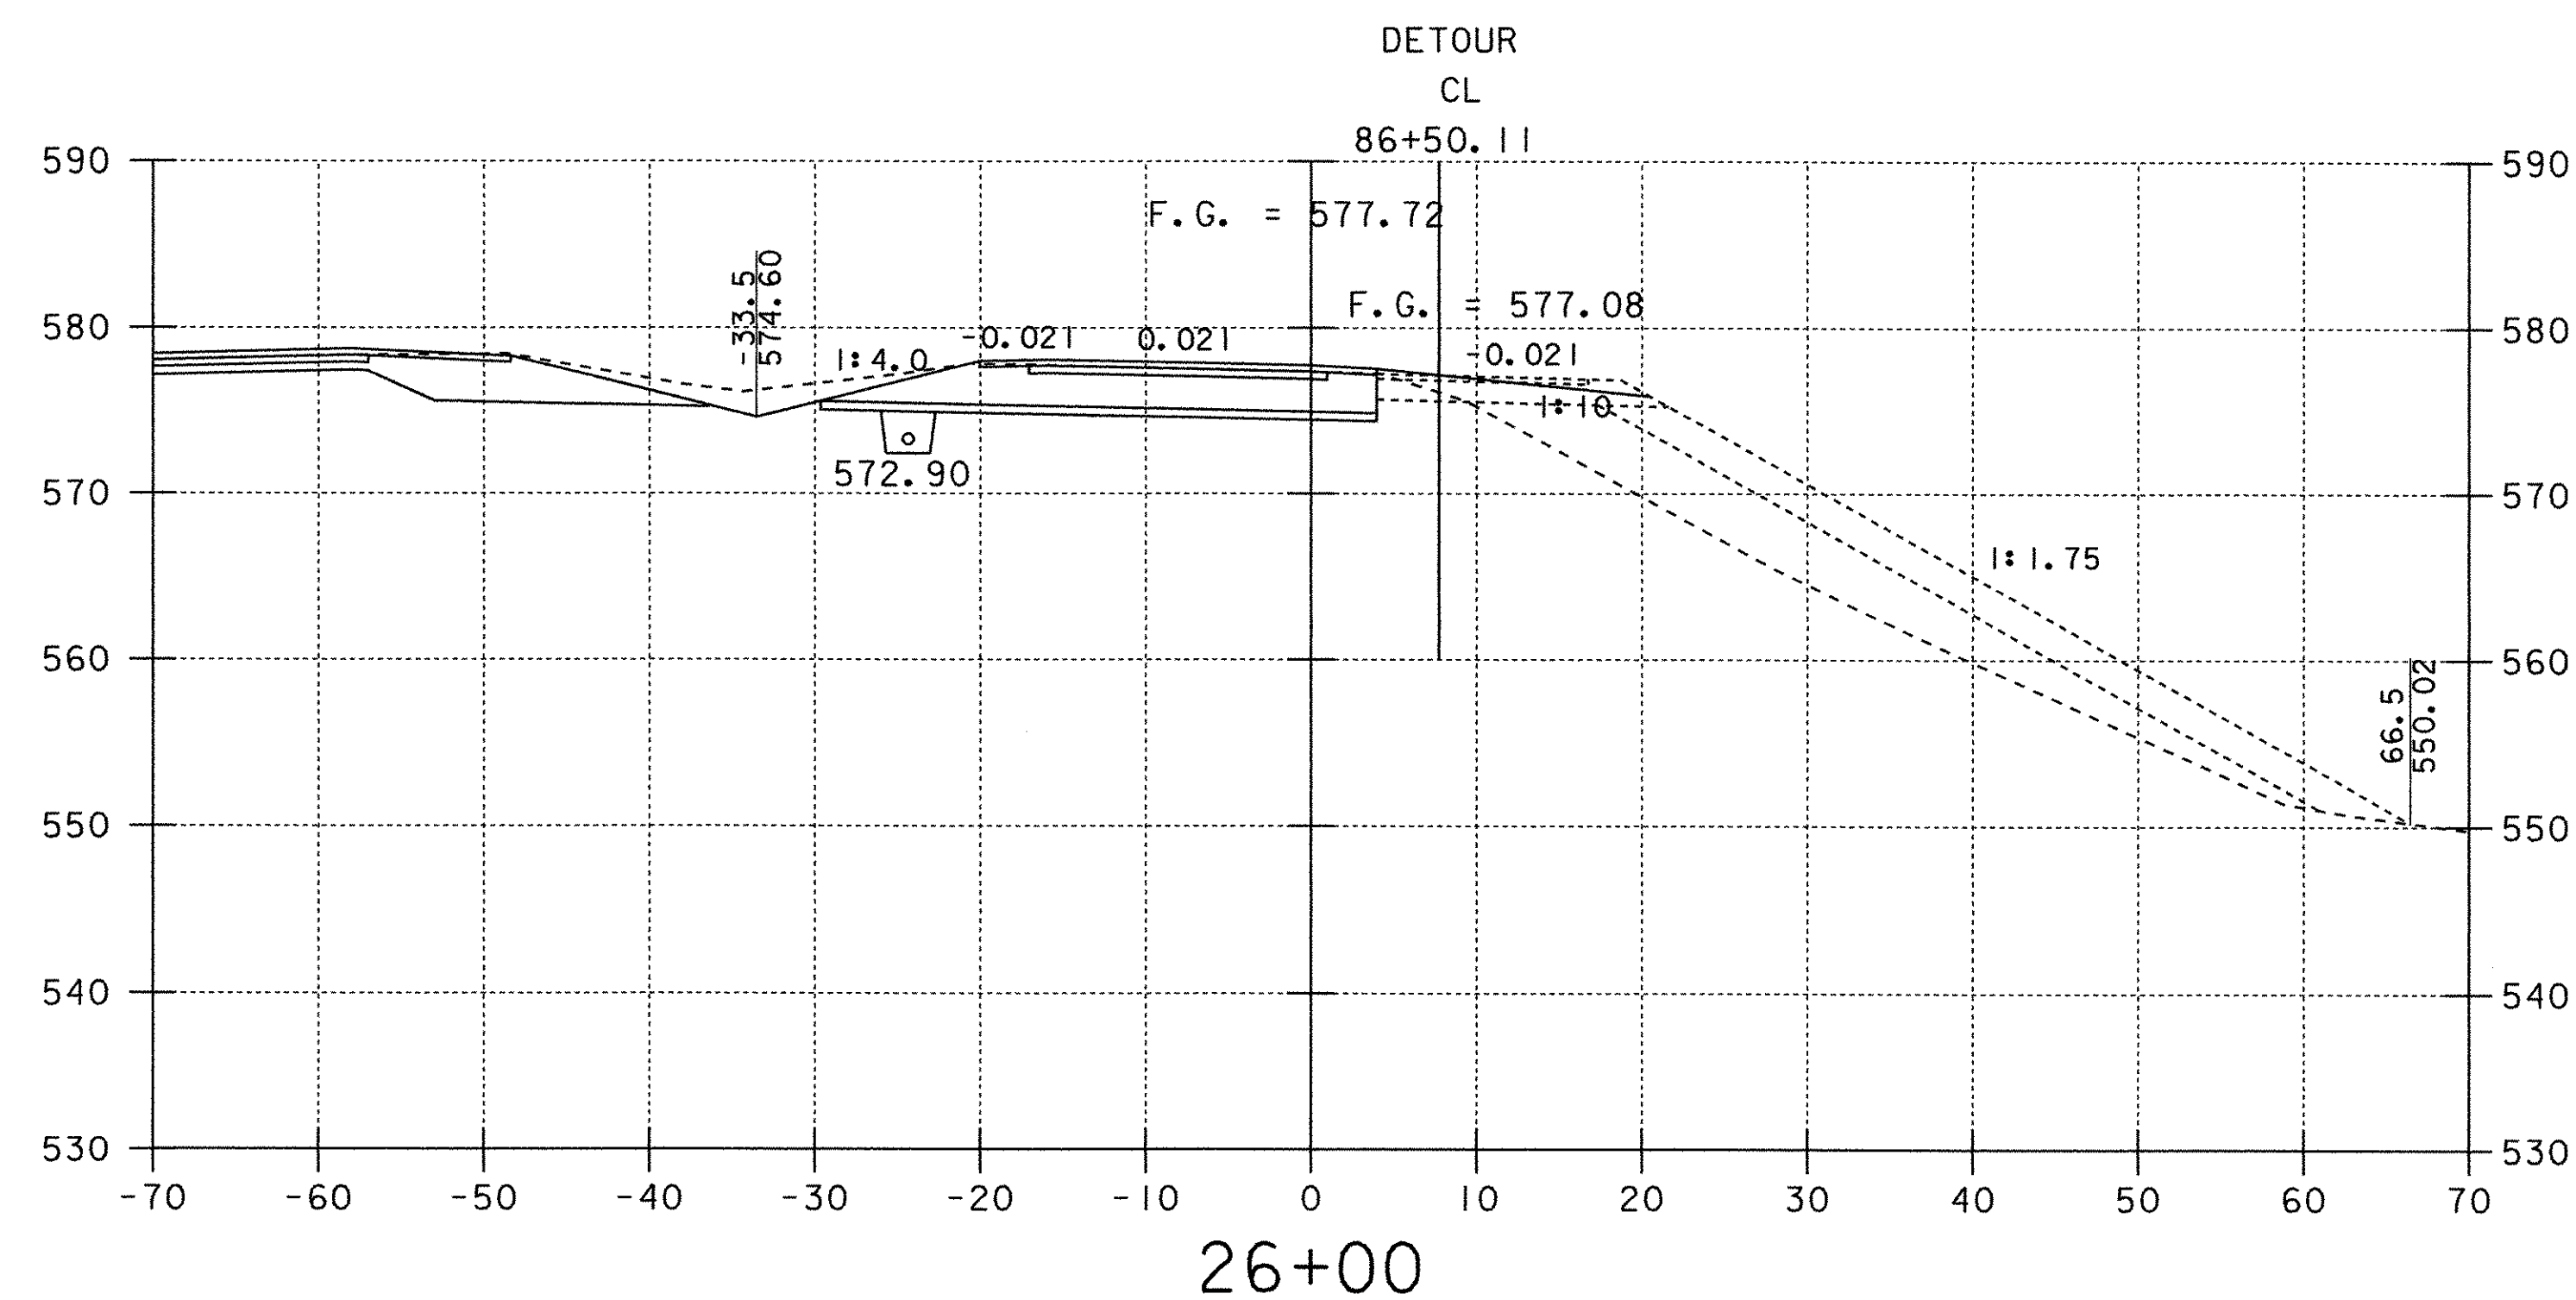


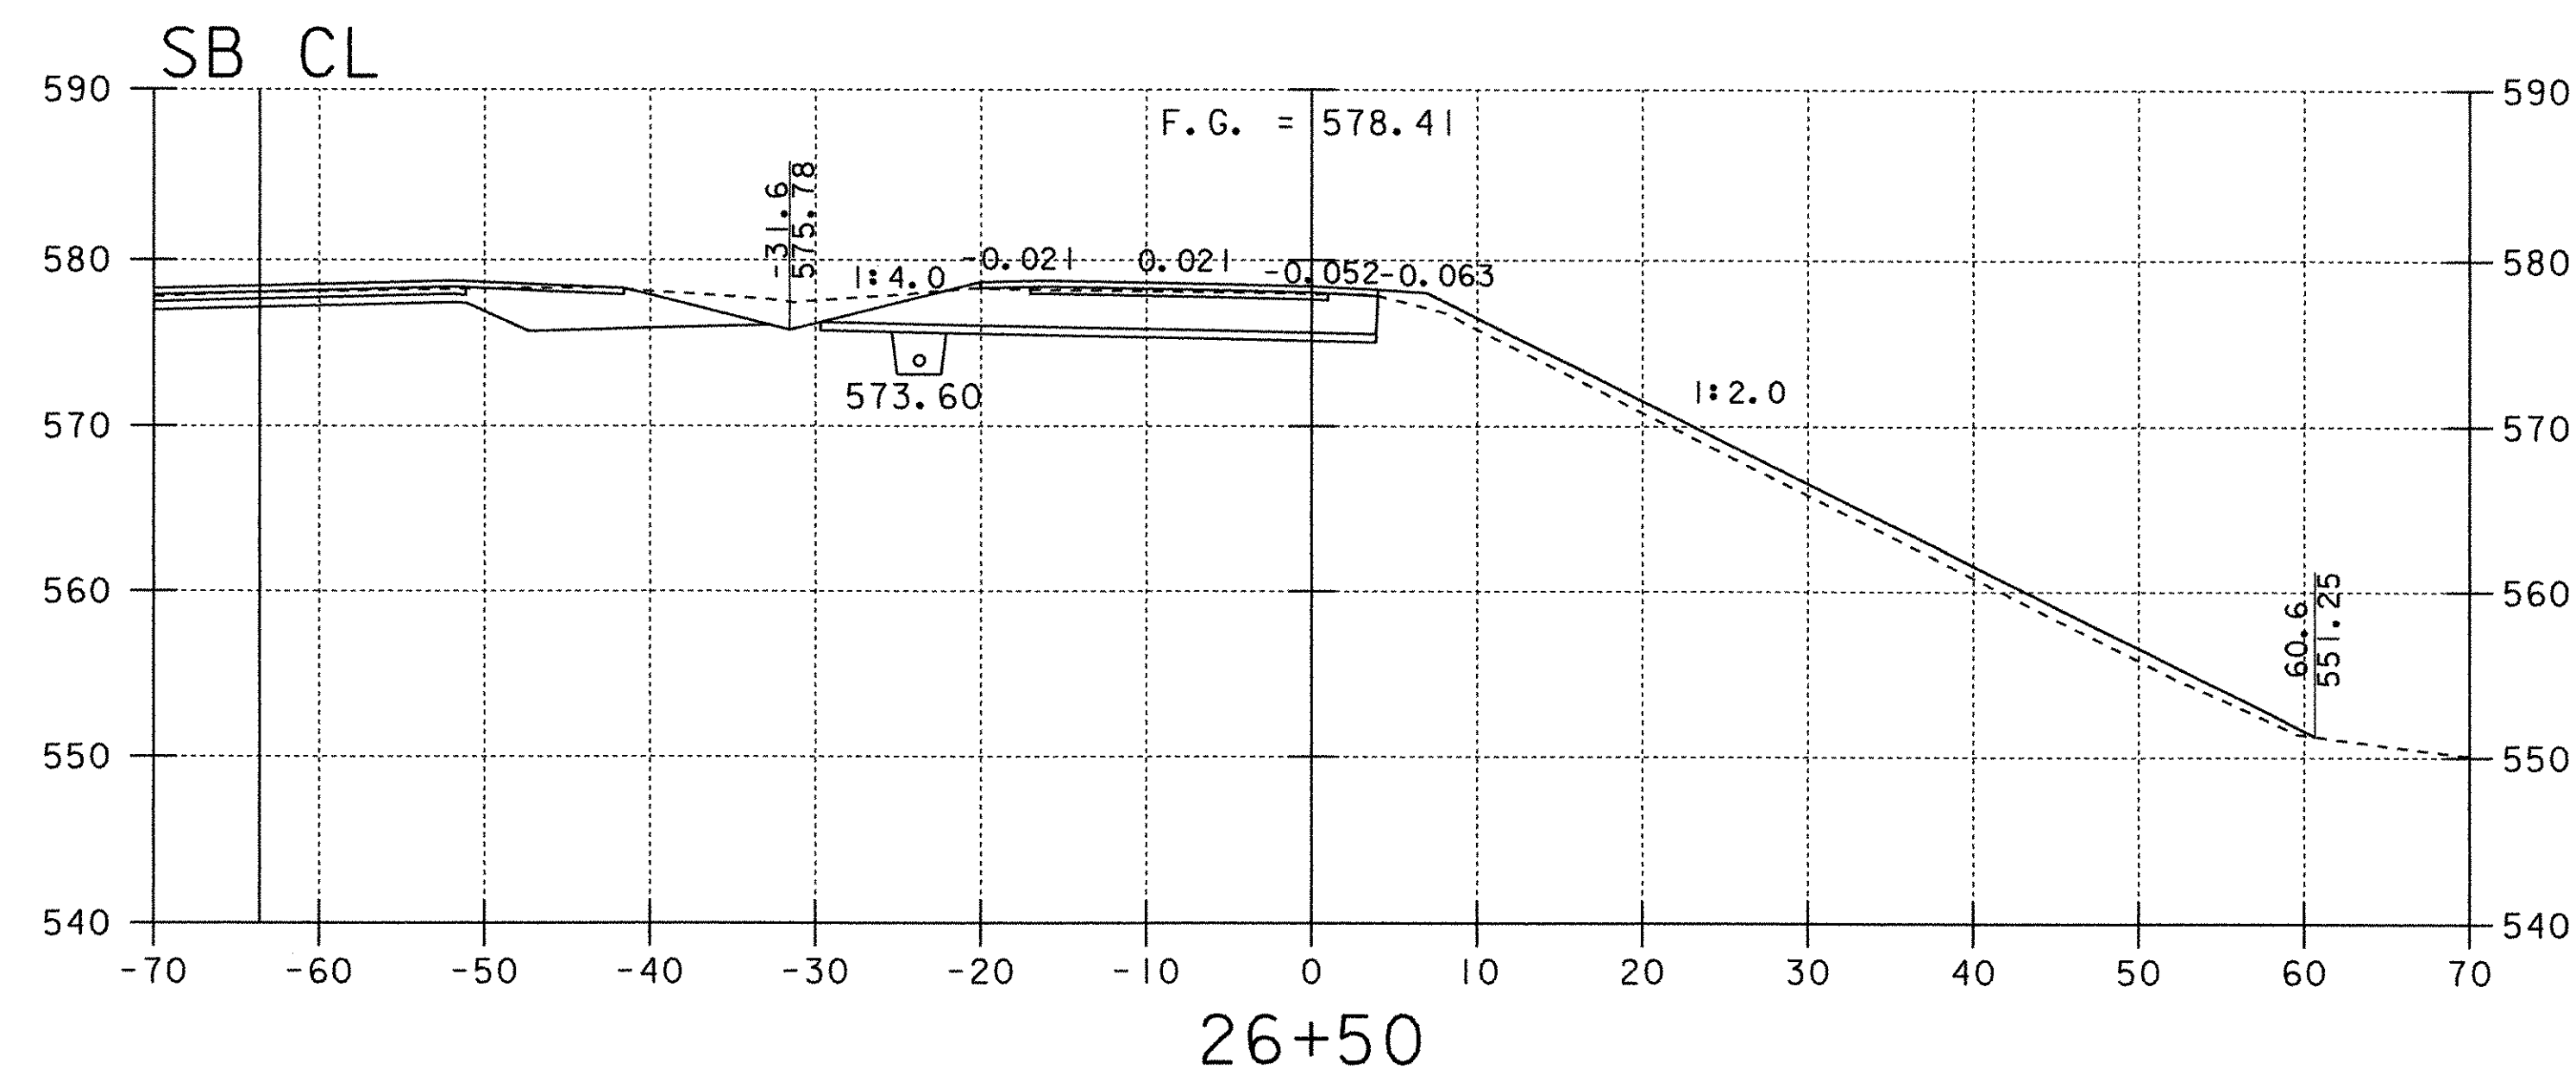

NOTE: OFFSET DISTANCES ARE MEASURED FROM THE GRADE LINE.

# RAMP C CROSS SECTIONS

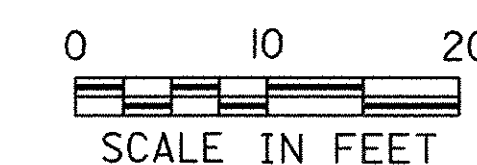

|                   |                                  |              |              |
|-------------------|----------------------------------|--------------|--------------|
| PROJECT:          | FAIRFAX - FAIRFIELD - ST. ALBANS | PROJECT NO.: | IM 089-3(27) |
| DESIGN FILE NAME: | /B7A007B/DESIGN/DA007RMC.DGN     | PLOT DATE:   | 18-AUG-2000  |
| IPARM FILE NAME:  | DA007X47                         | SURVEY DATE: | 6/98         |
| SURVEYED BY:      | ORVIS                            | DRAWN BY:    | SQUAD B      |
| SQUAD LEADER:     | DELLA SANTA                      | SHEET:       | 324 OF 370   |