

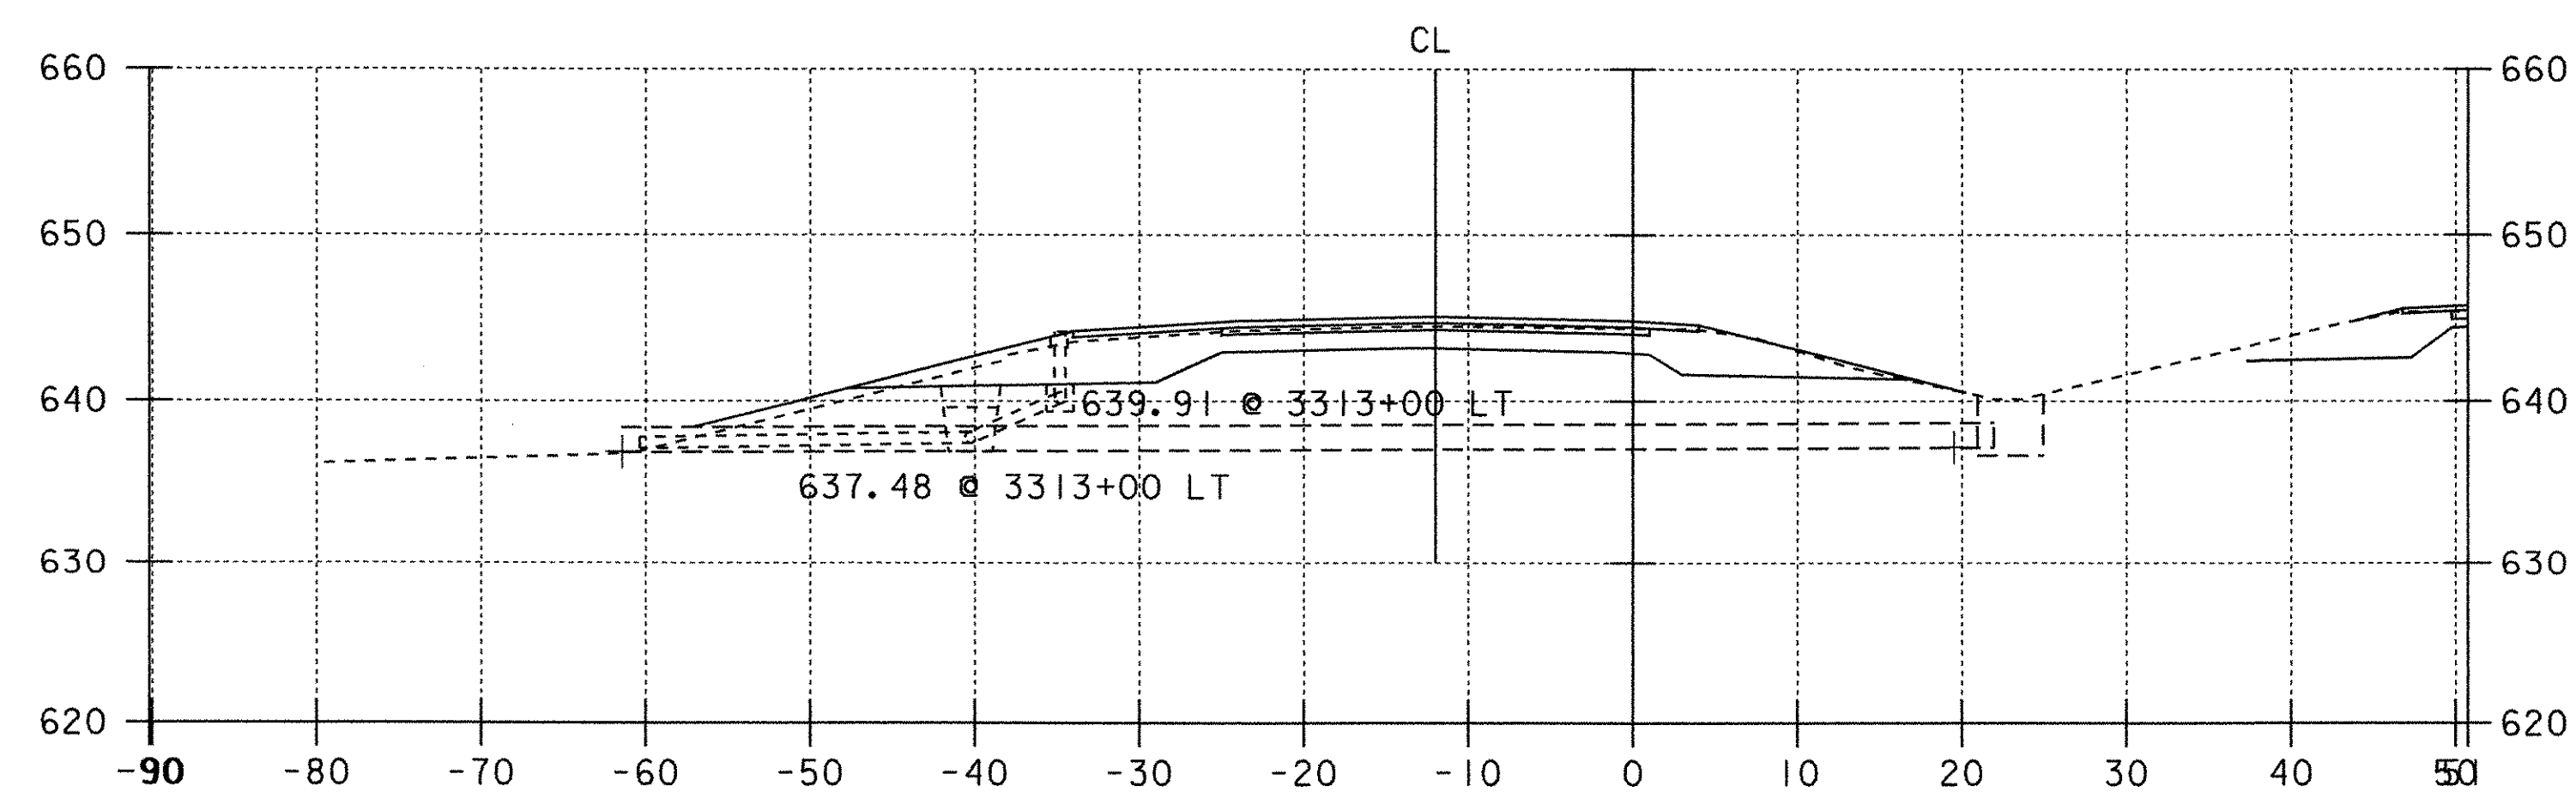
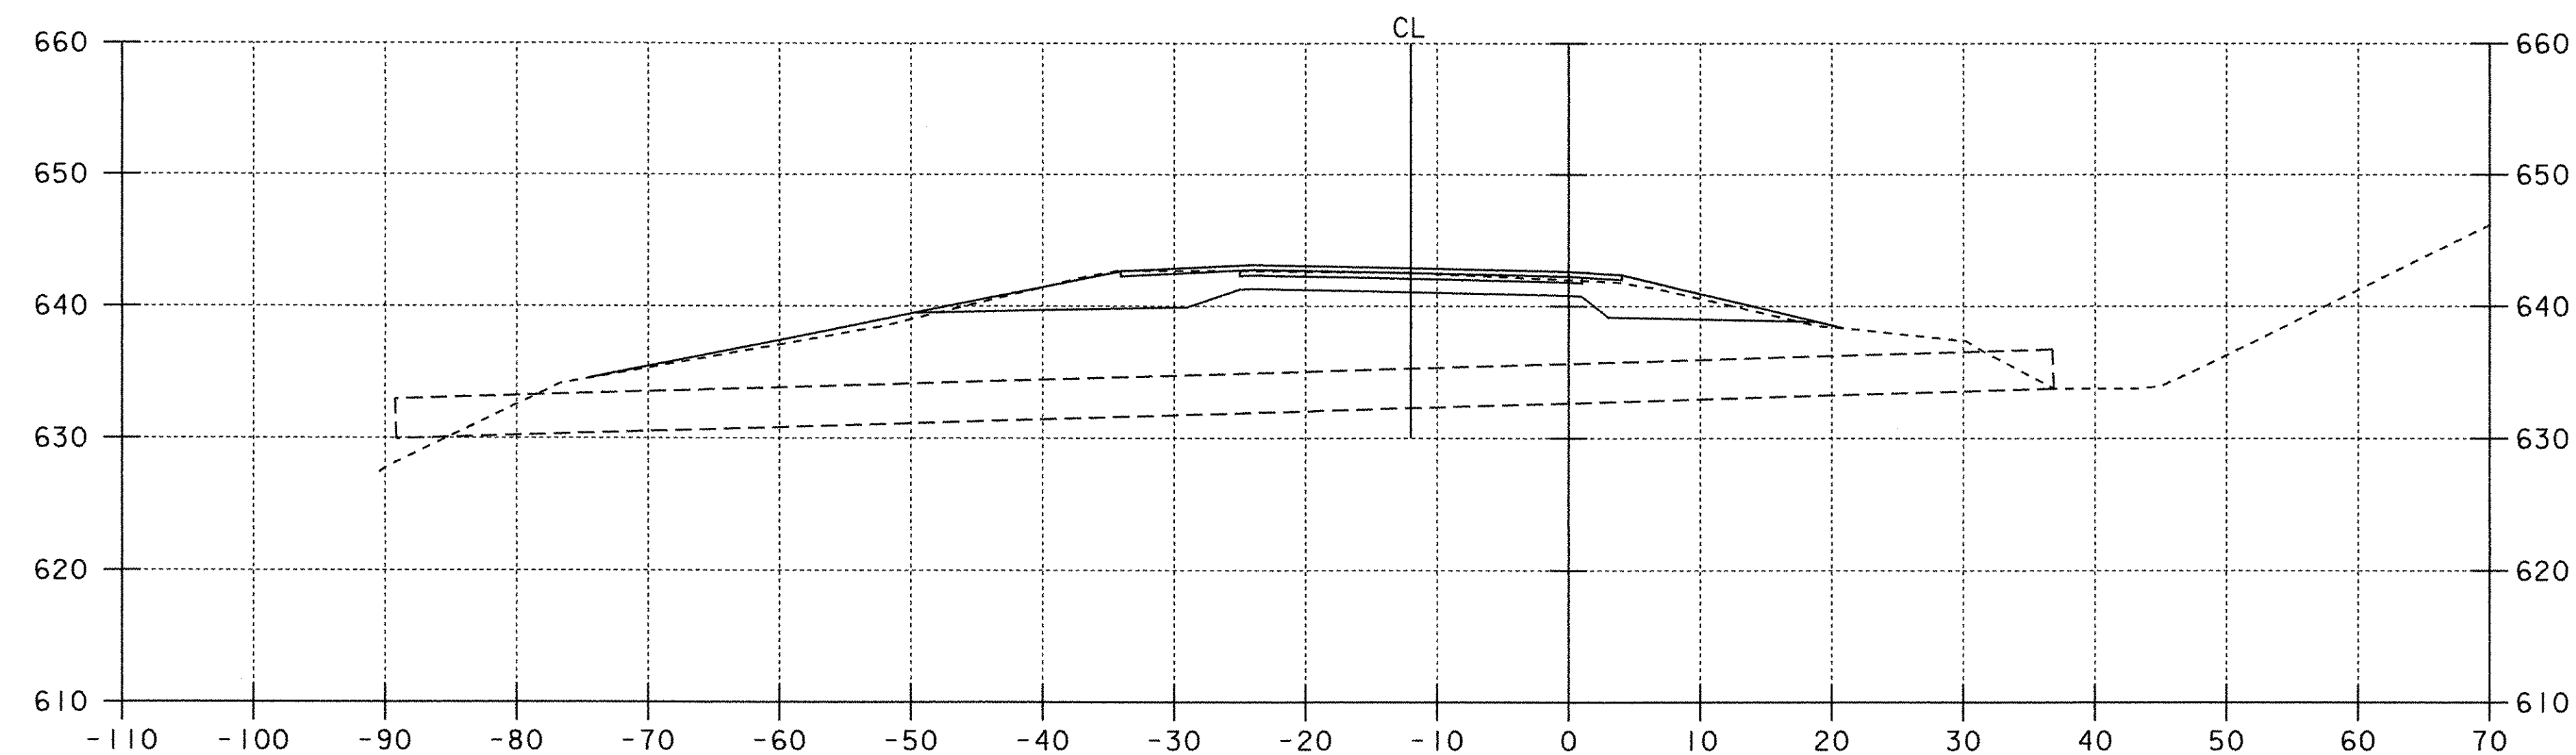


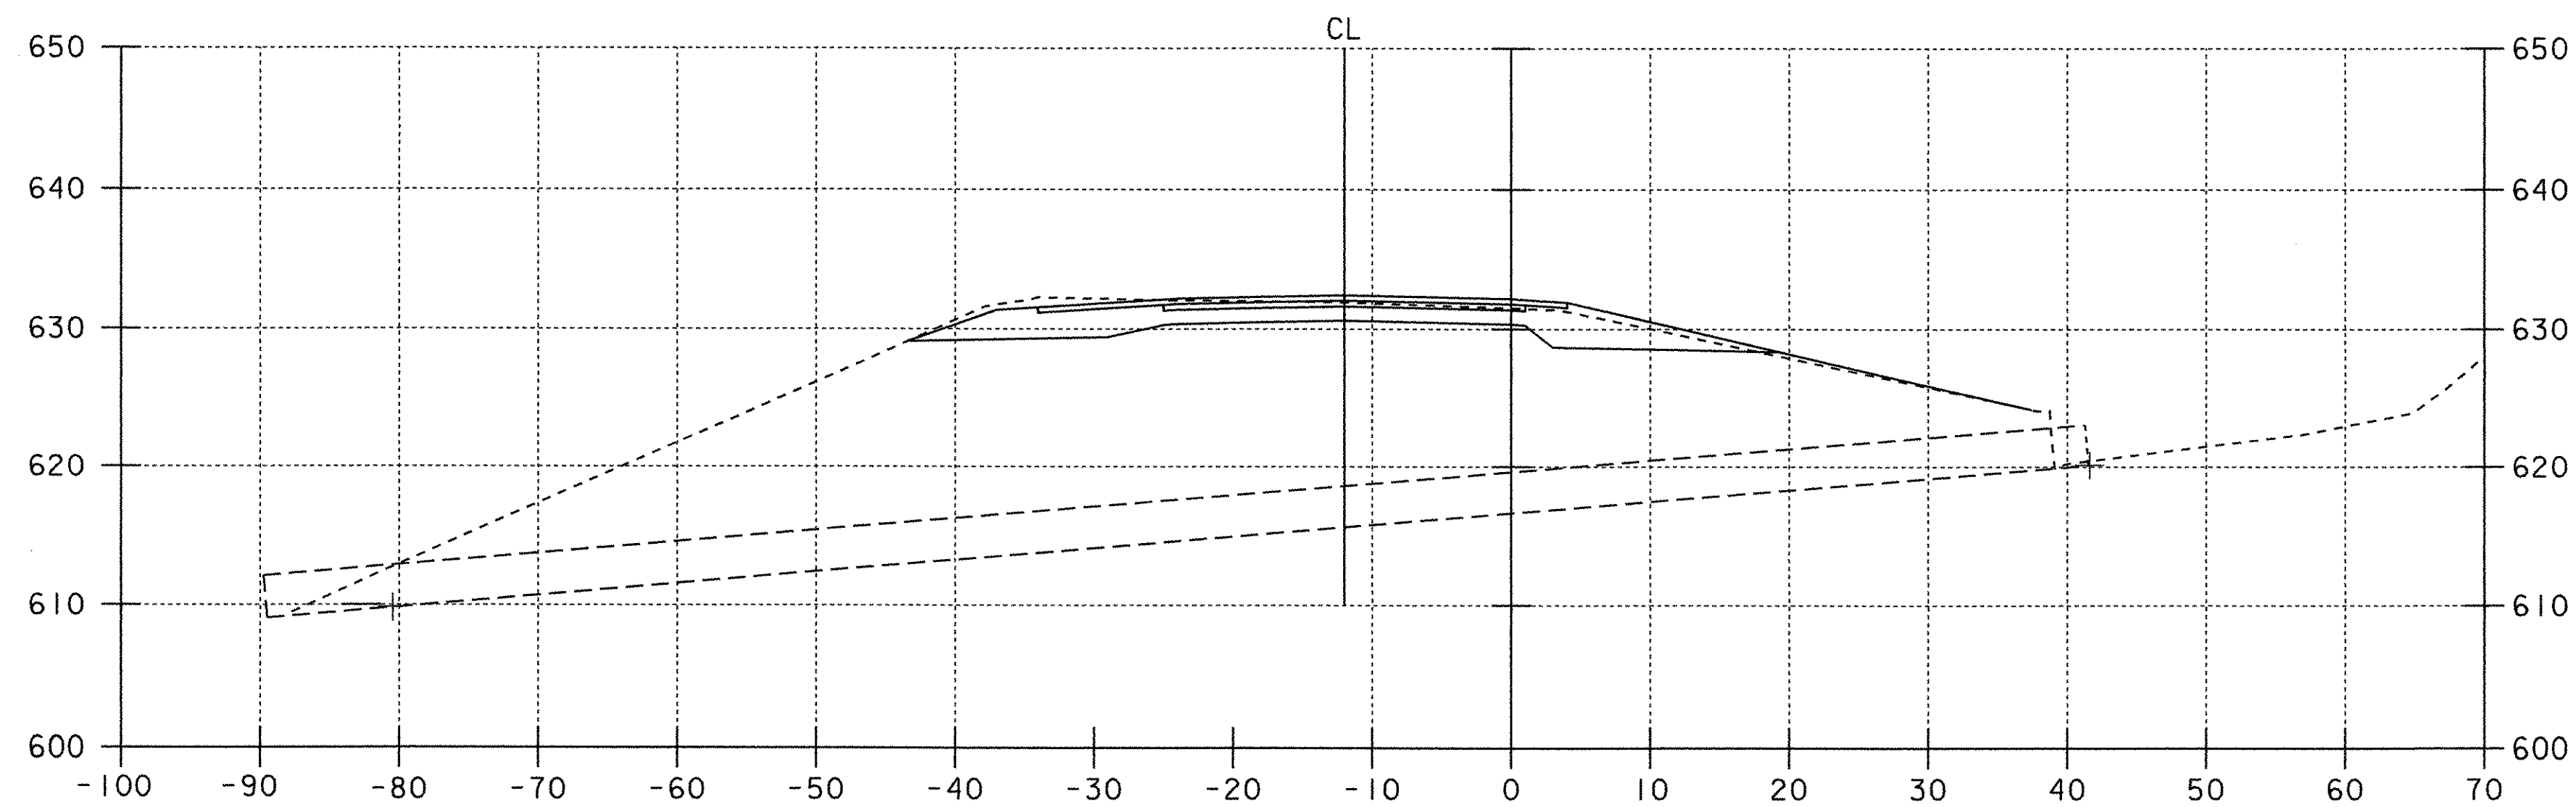

SOUTHBOUND DRAINAGE CROSS SECTIONS

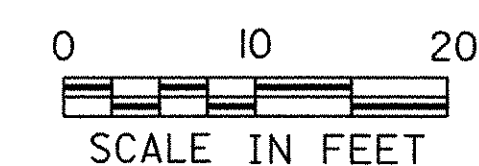

PROJECT:	FAIRFAX - FAIRFIELD - ST. ALBANS	PROJECT NO.:	IM 089-3(27)
DESIGN FILE NAME:	/87A007B/DESIGN/DA007DXS.DGN	PLOT DATE:	18-AUG-2000
IPARM FILE NAME:	DA007X52	SURVEY DATE:	6/98
SURVEYED BY:	ORVIS	DRAWN BY:	SQUAD B
SQUAD LEADER:	DELLA SANTA	SHEET:	329 OF 370