
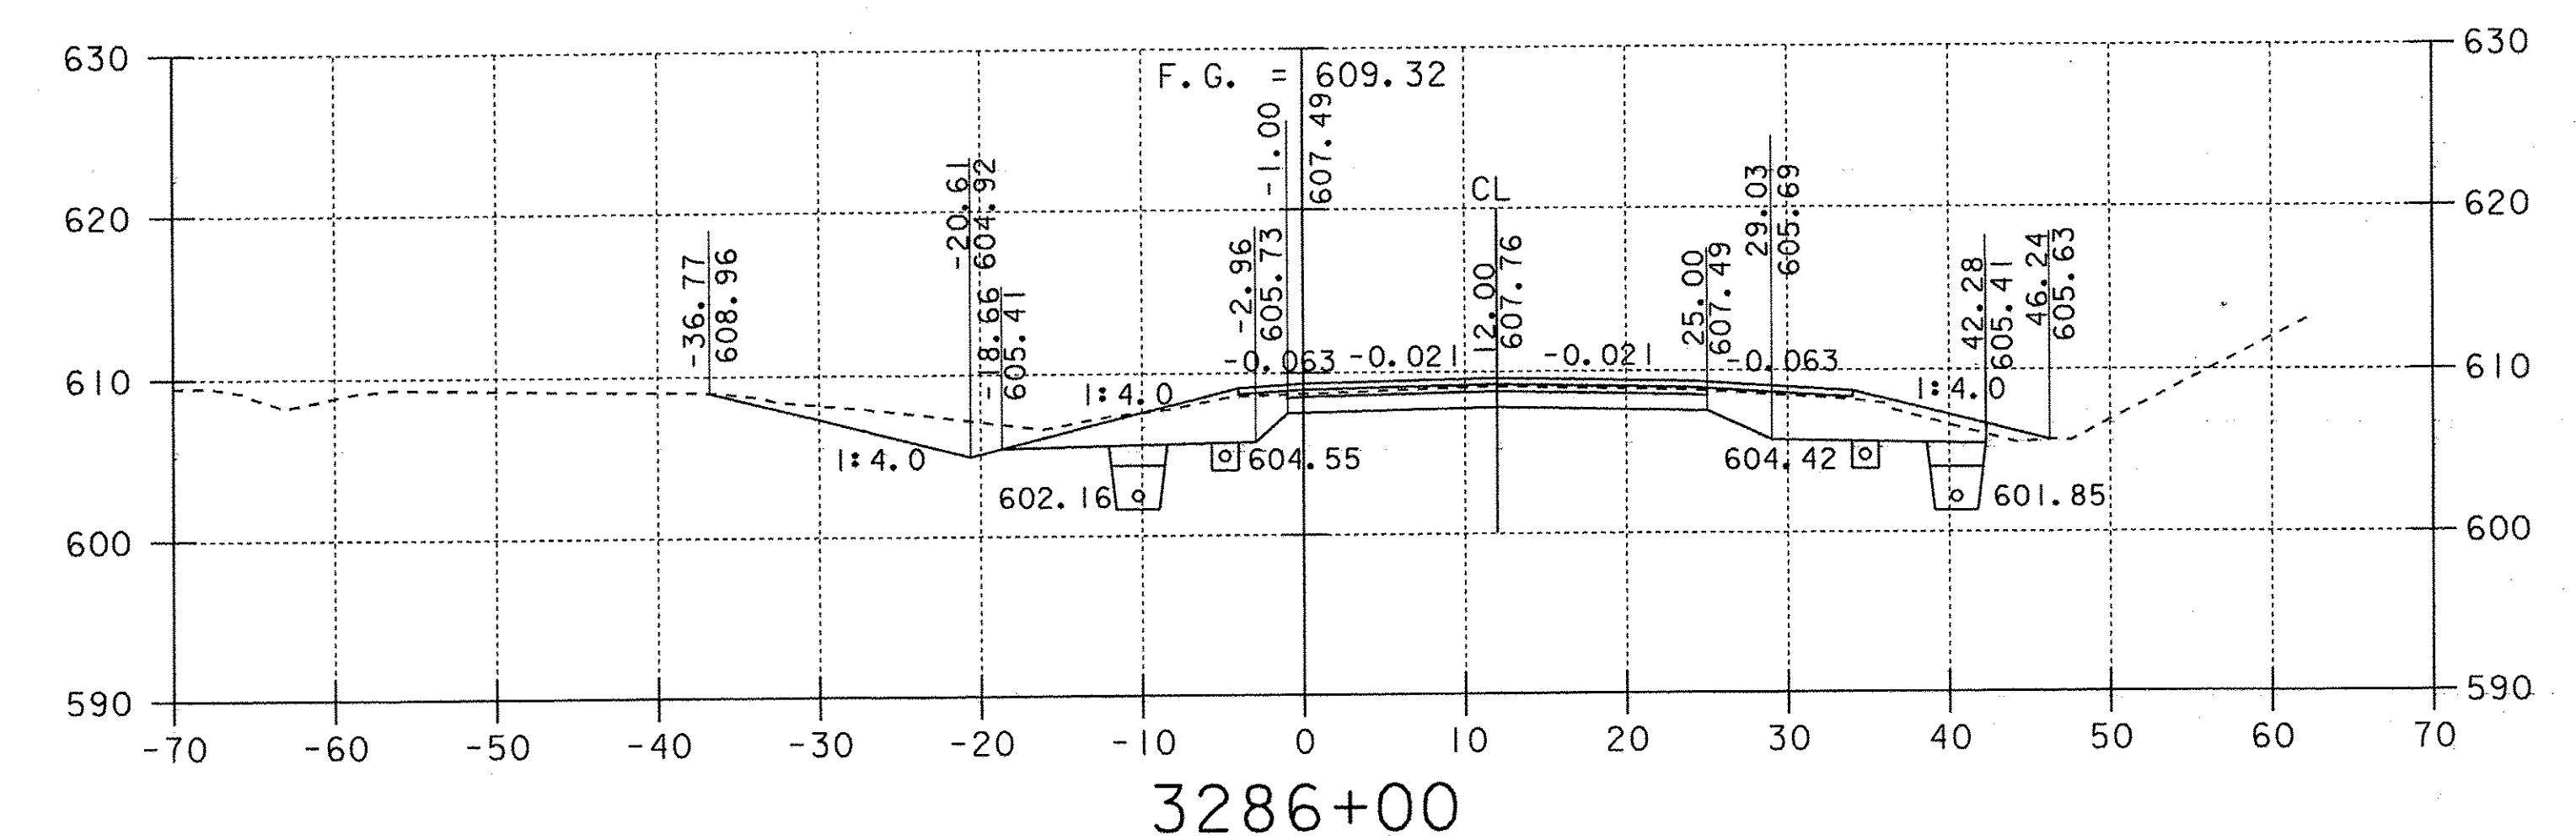


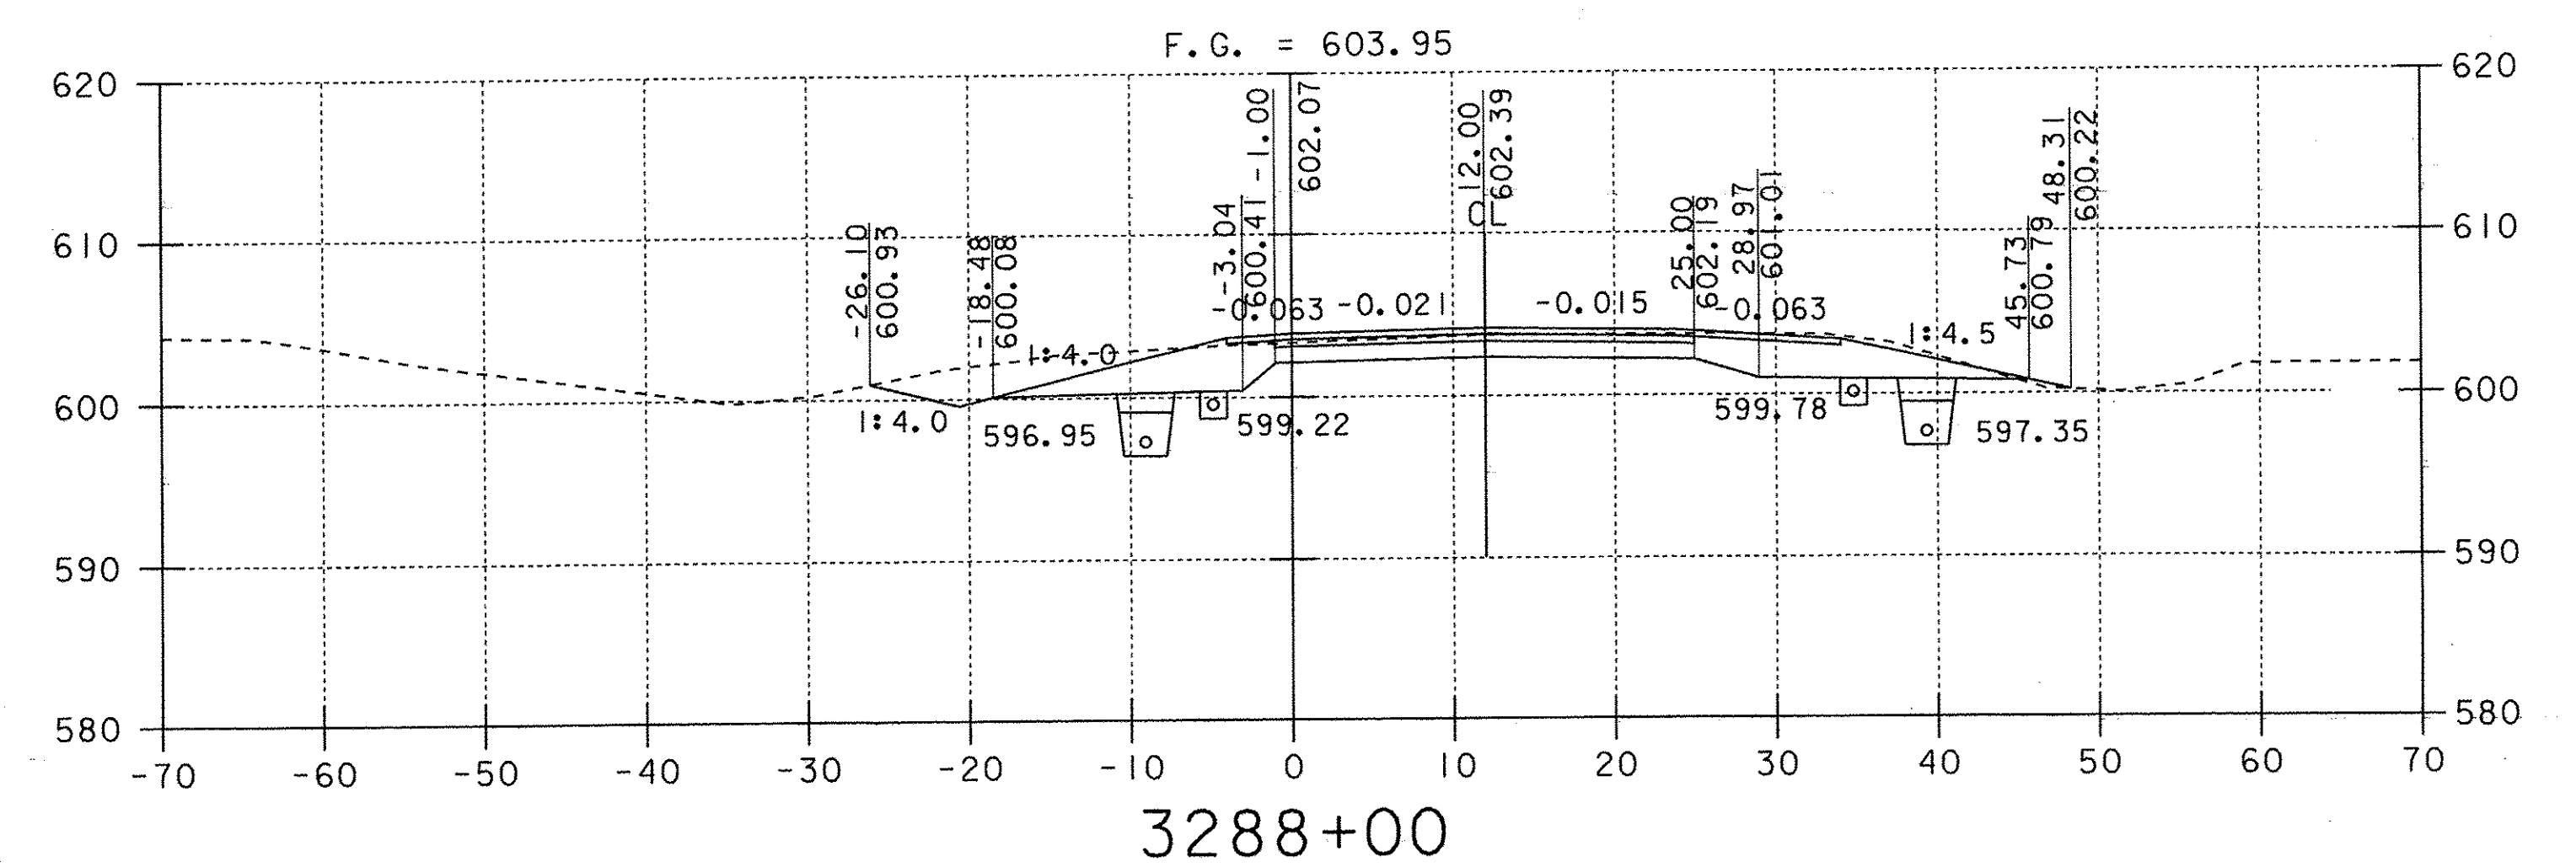

0 10 20
SCALE IN FEET

NORTHBOUND CROSS SECTIONS

PROJECT: FAIRFAX - FAIRFIELD - ST. ALBANS		PROJECT NO. : IM 089-3(27)	
DESIGN FILE NAME:	/87A007B/DESIGN/DA007XS.DGN		
IPARM FILE NAME:	DA007X0I	PLOT DATE: 25-JAN-2002	
SURVEYED BY:	ORVIS	SURVEY DATE: 6/98	
SQUAD LEADER:	DELLA SANTA	DRAWN BY: SQUAD B	
		SHEET: 340 OF 370	