

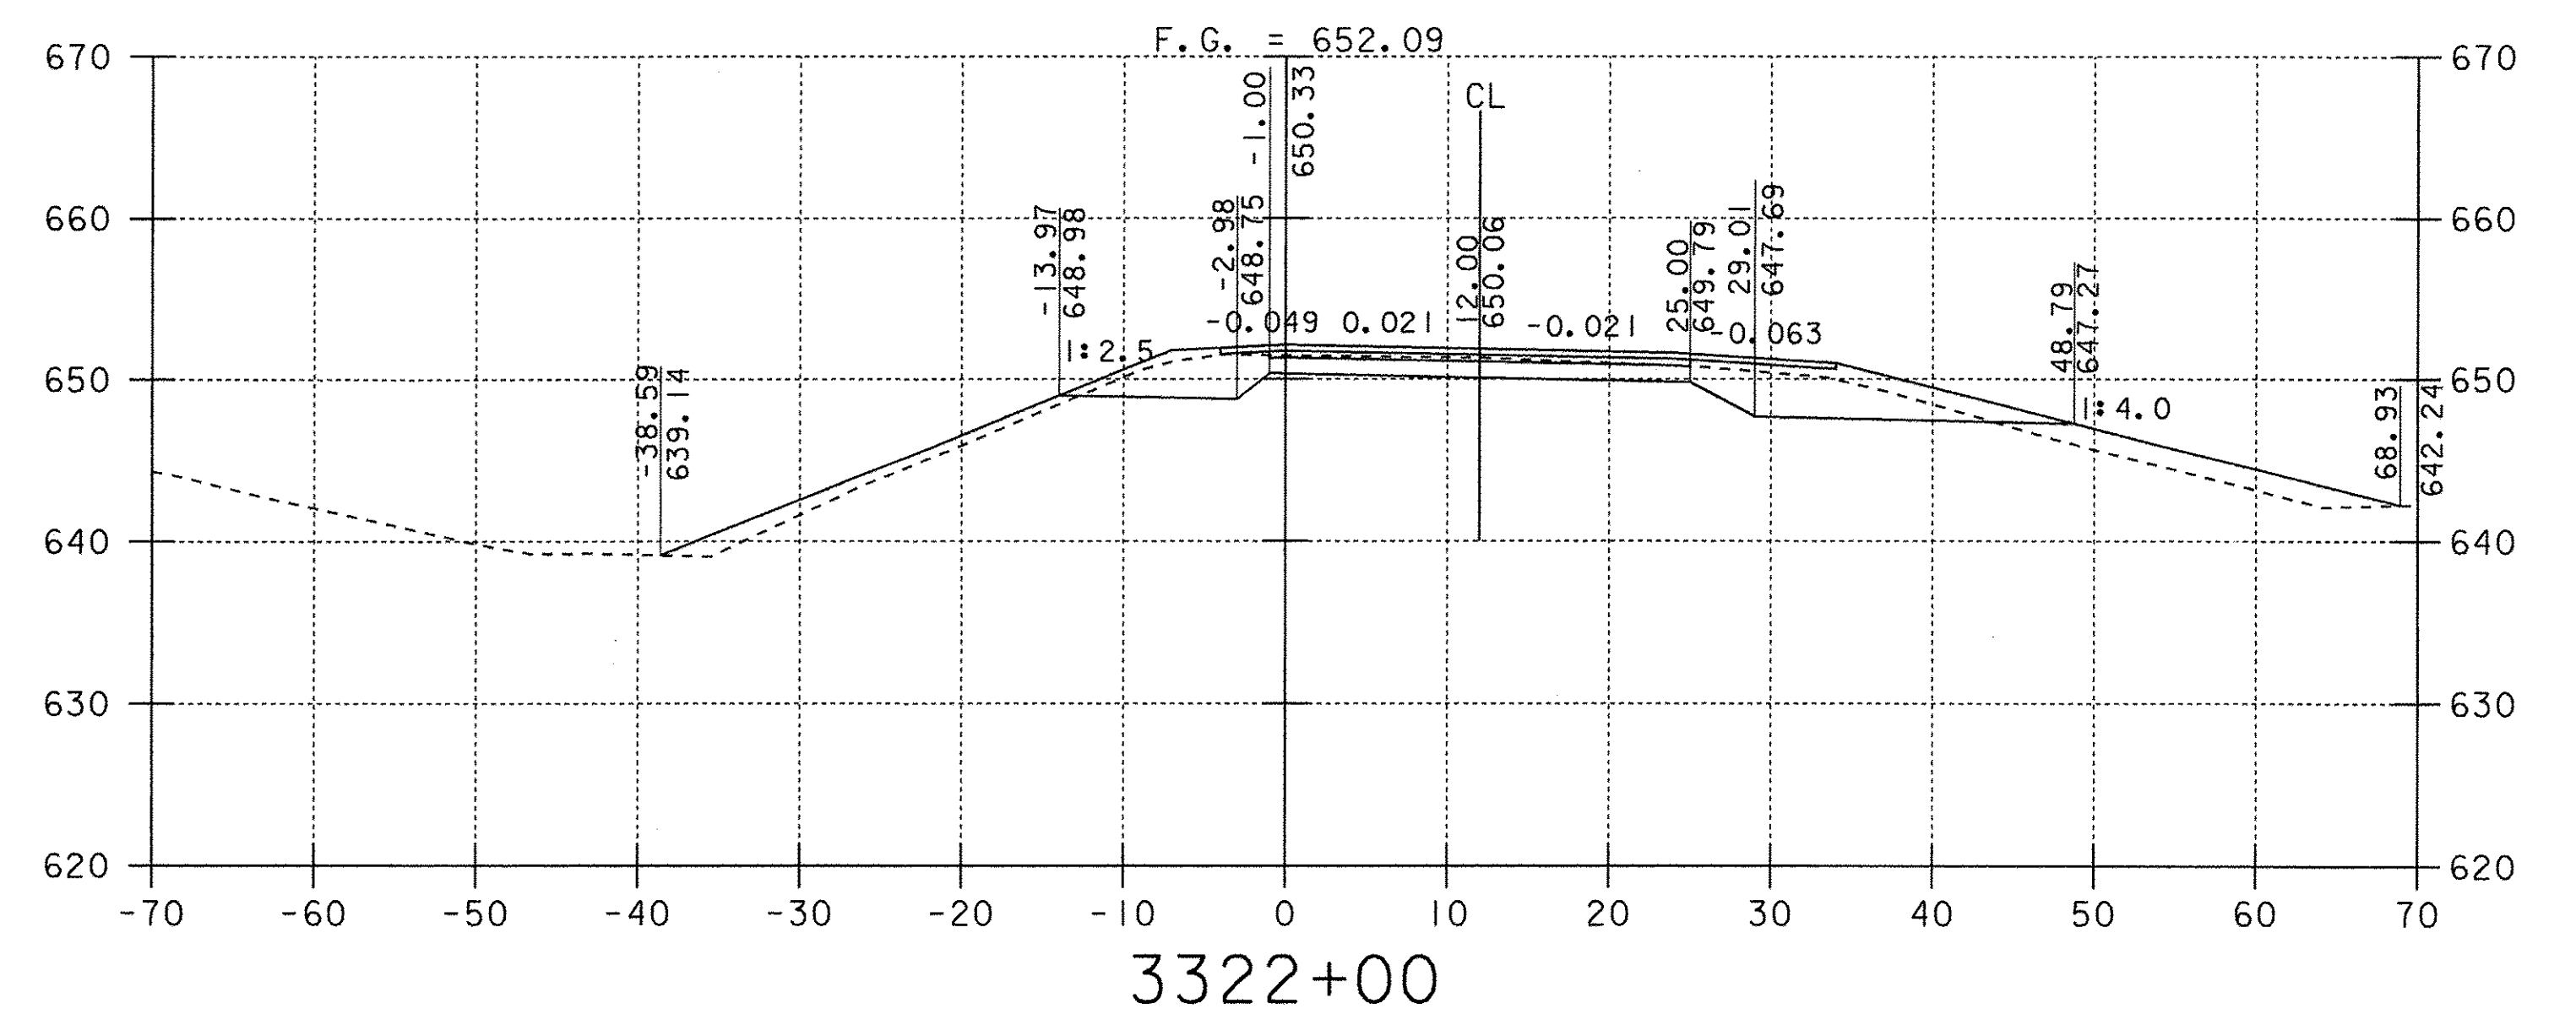
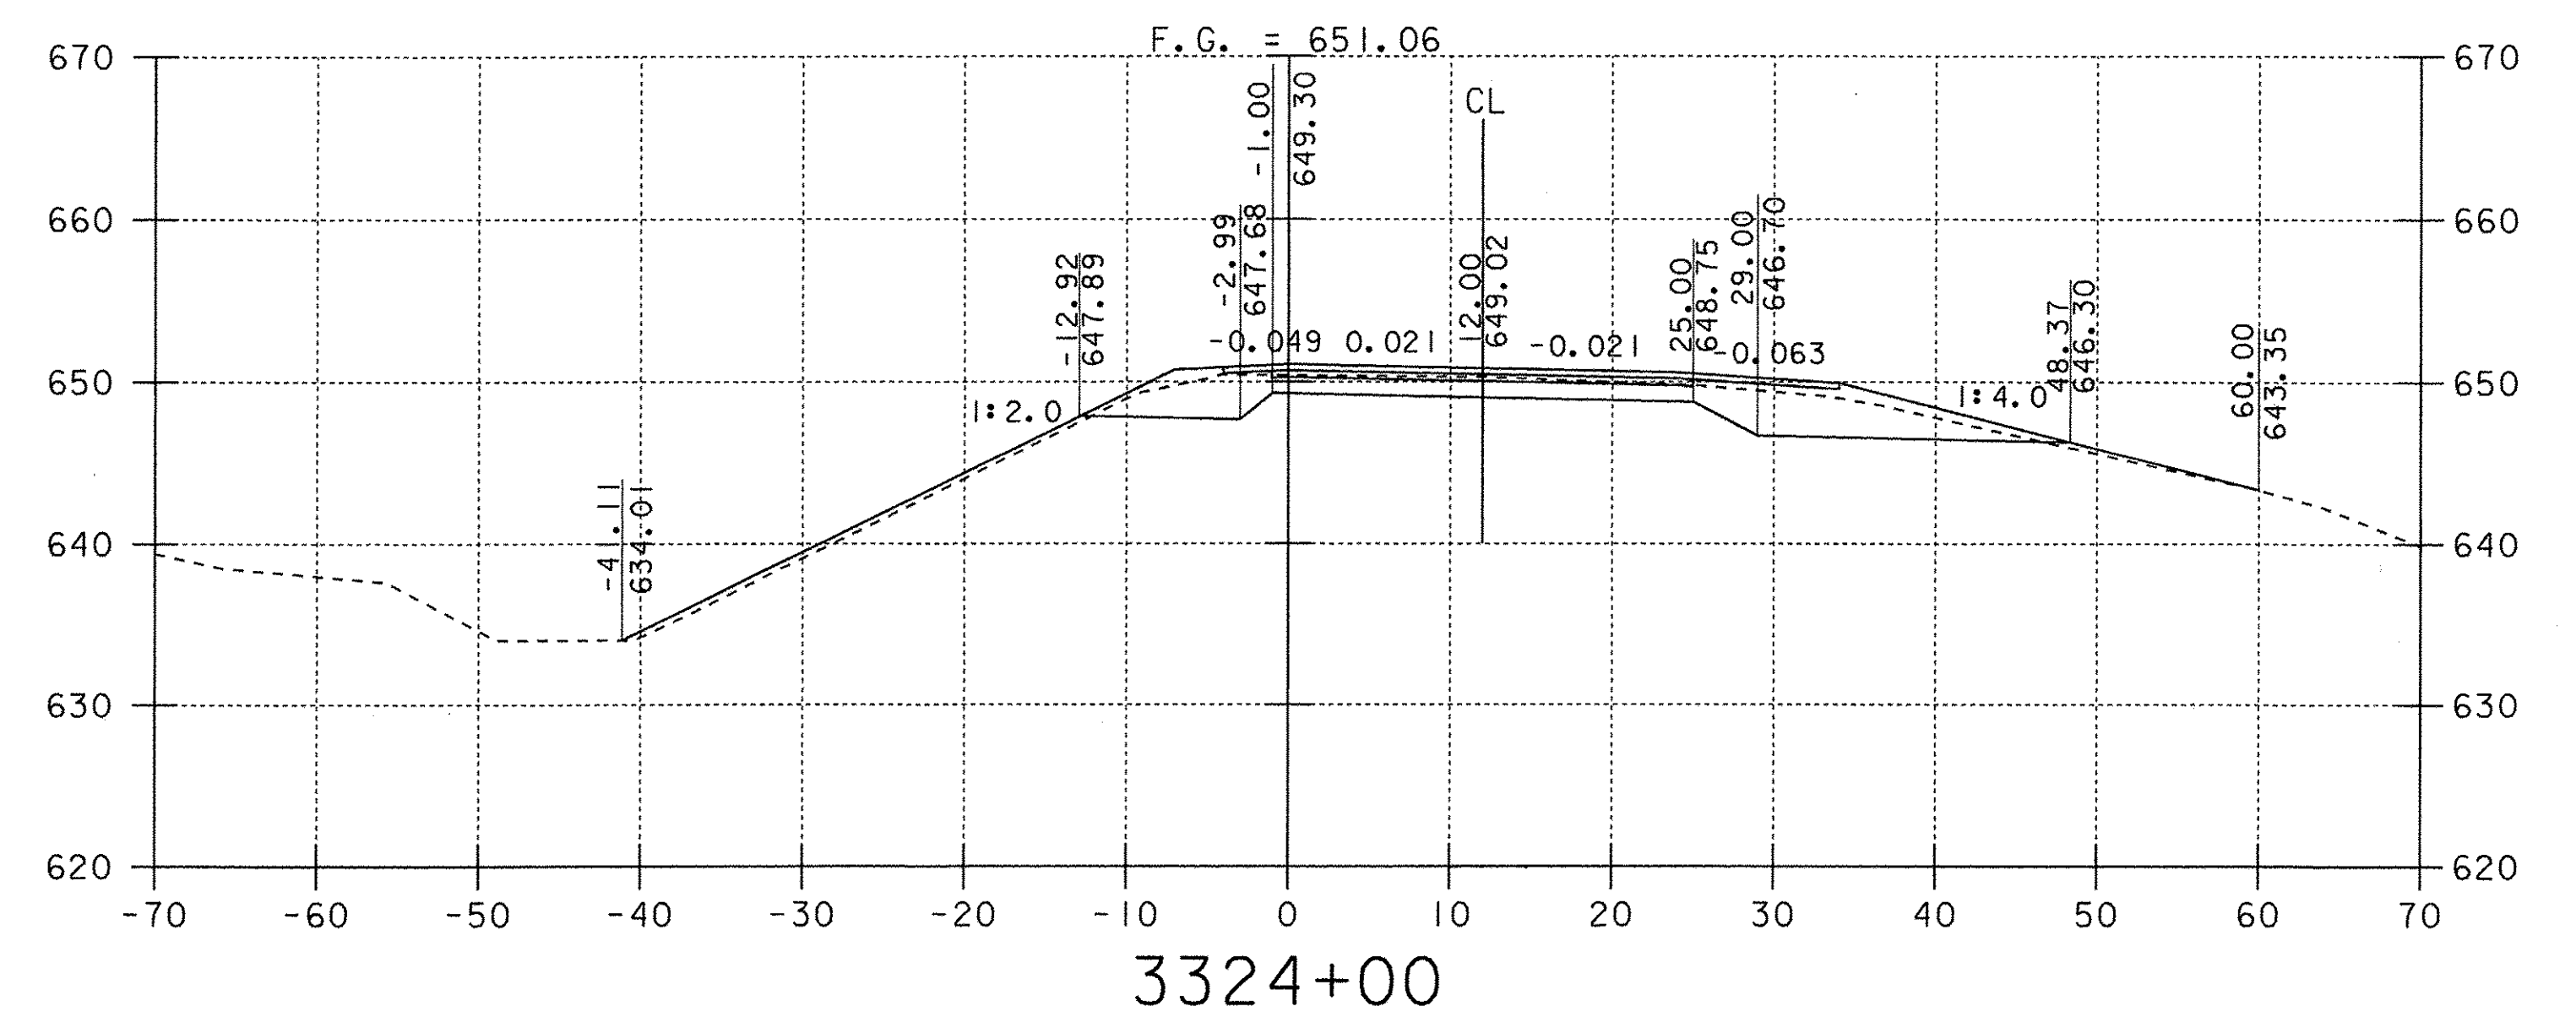
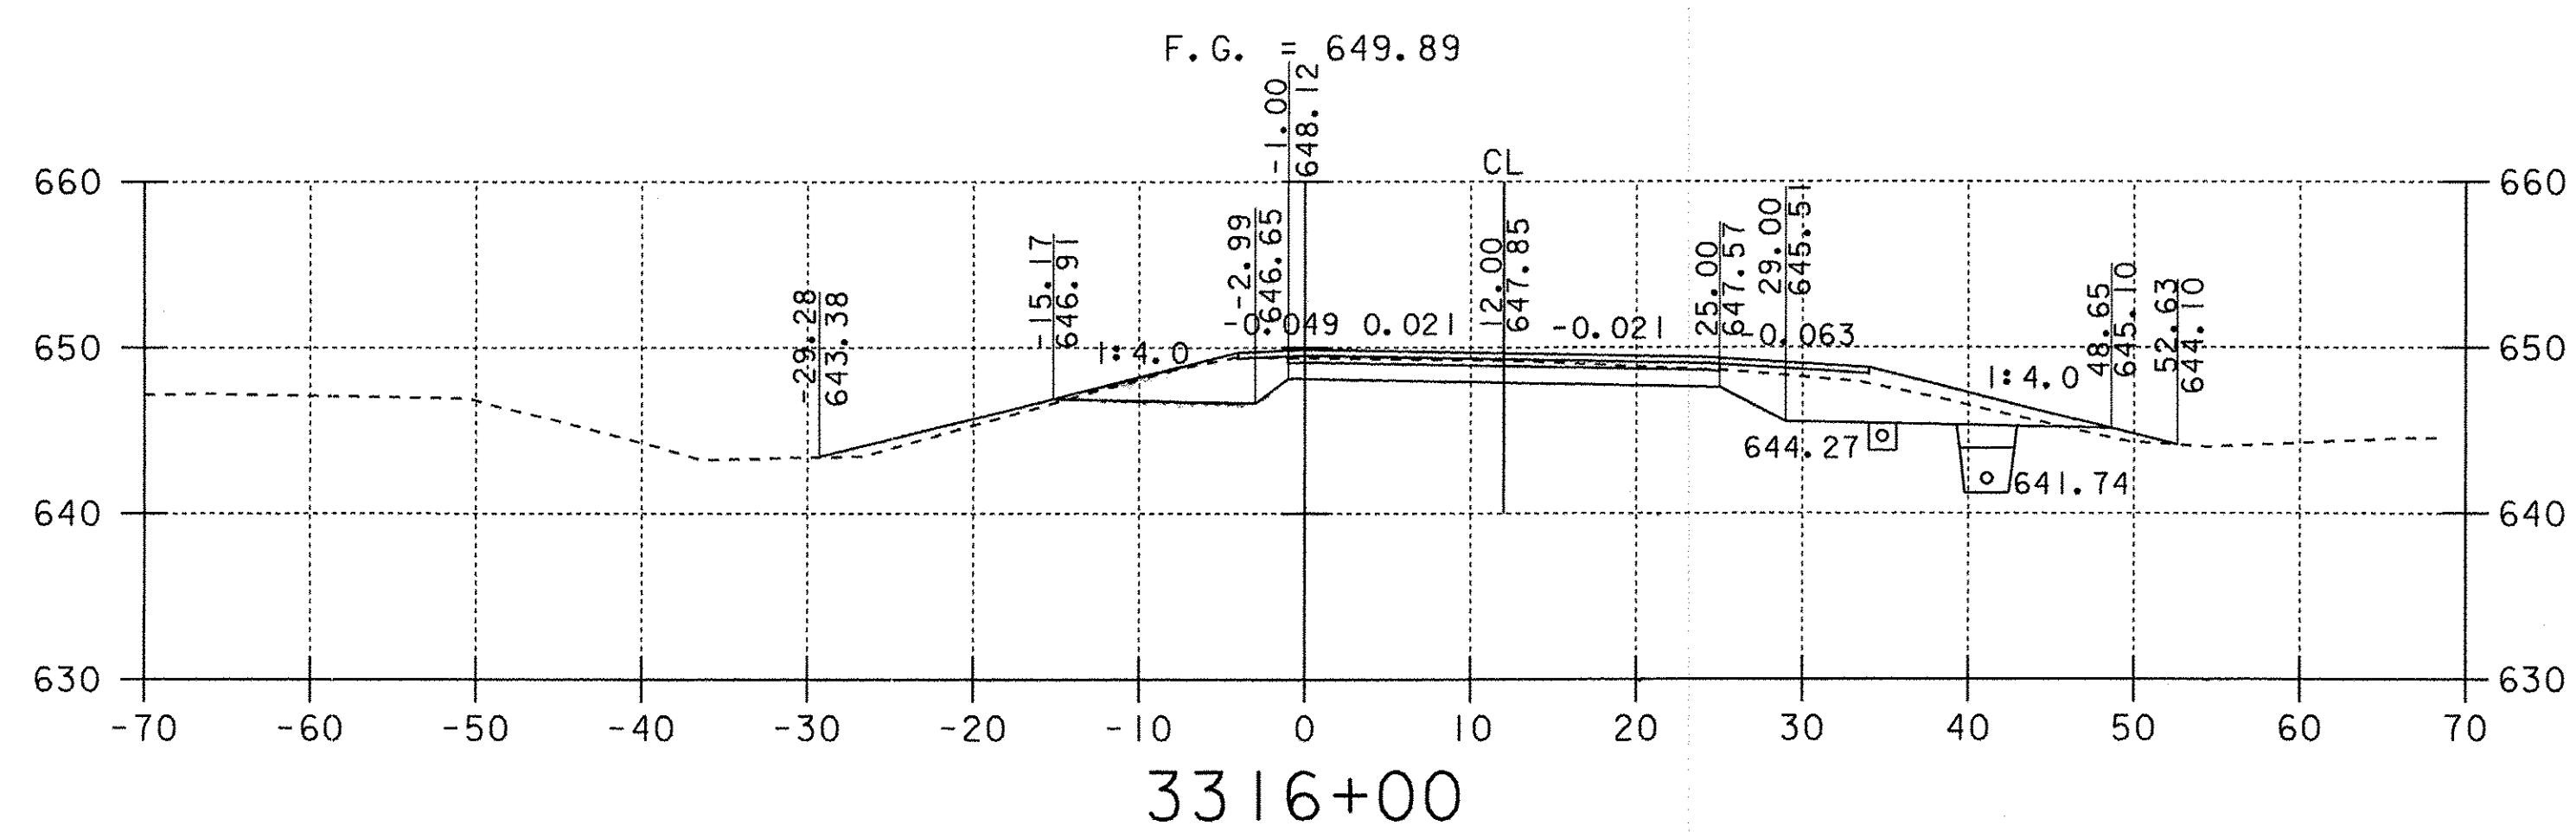
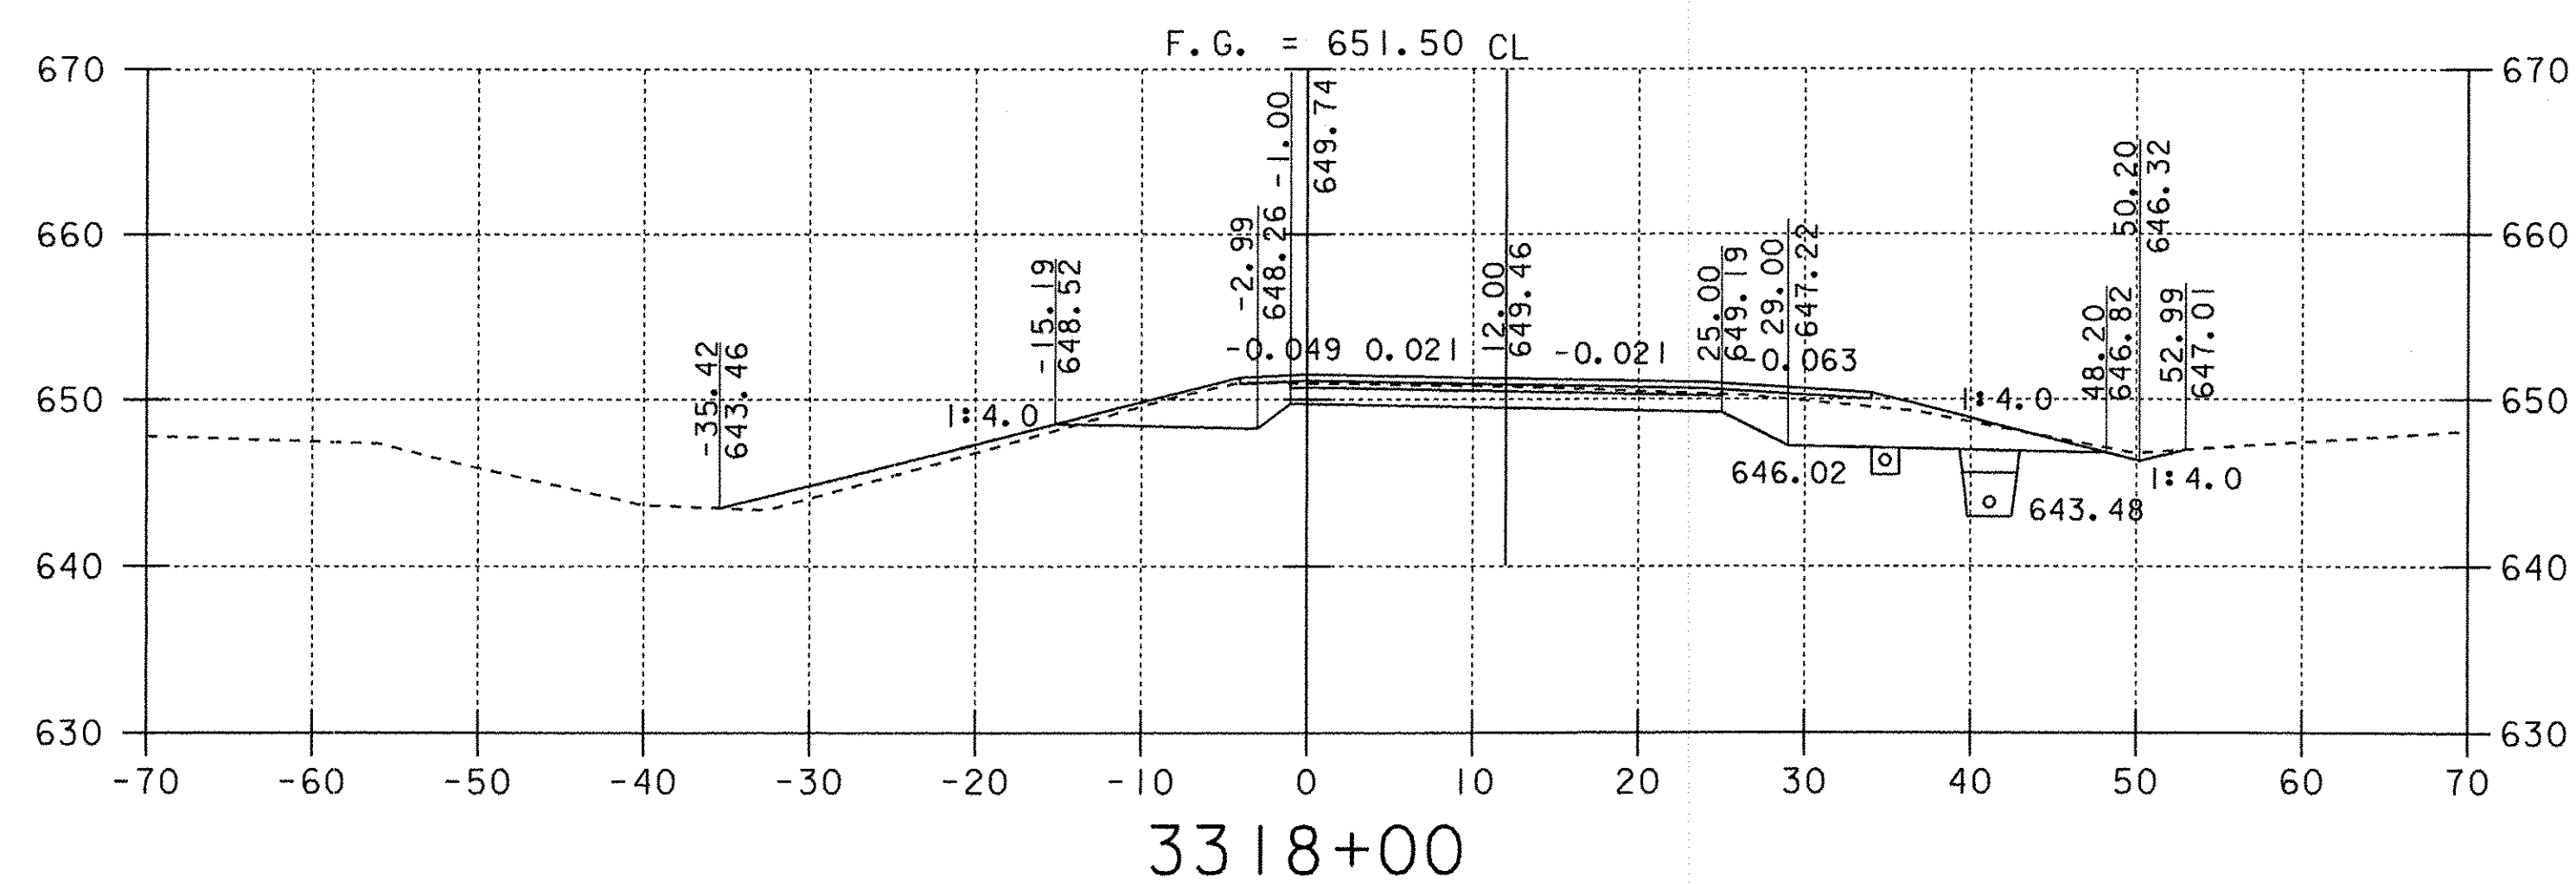


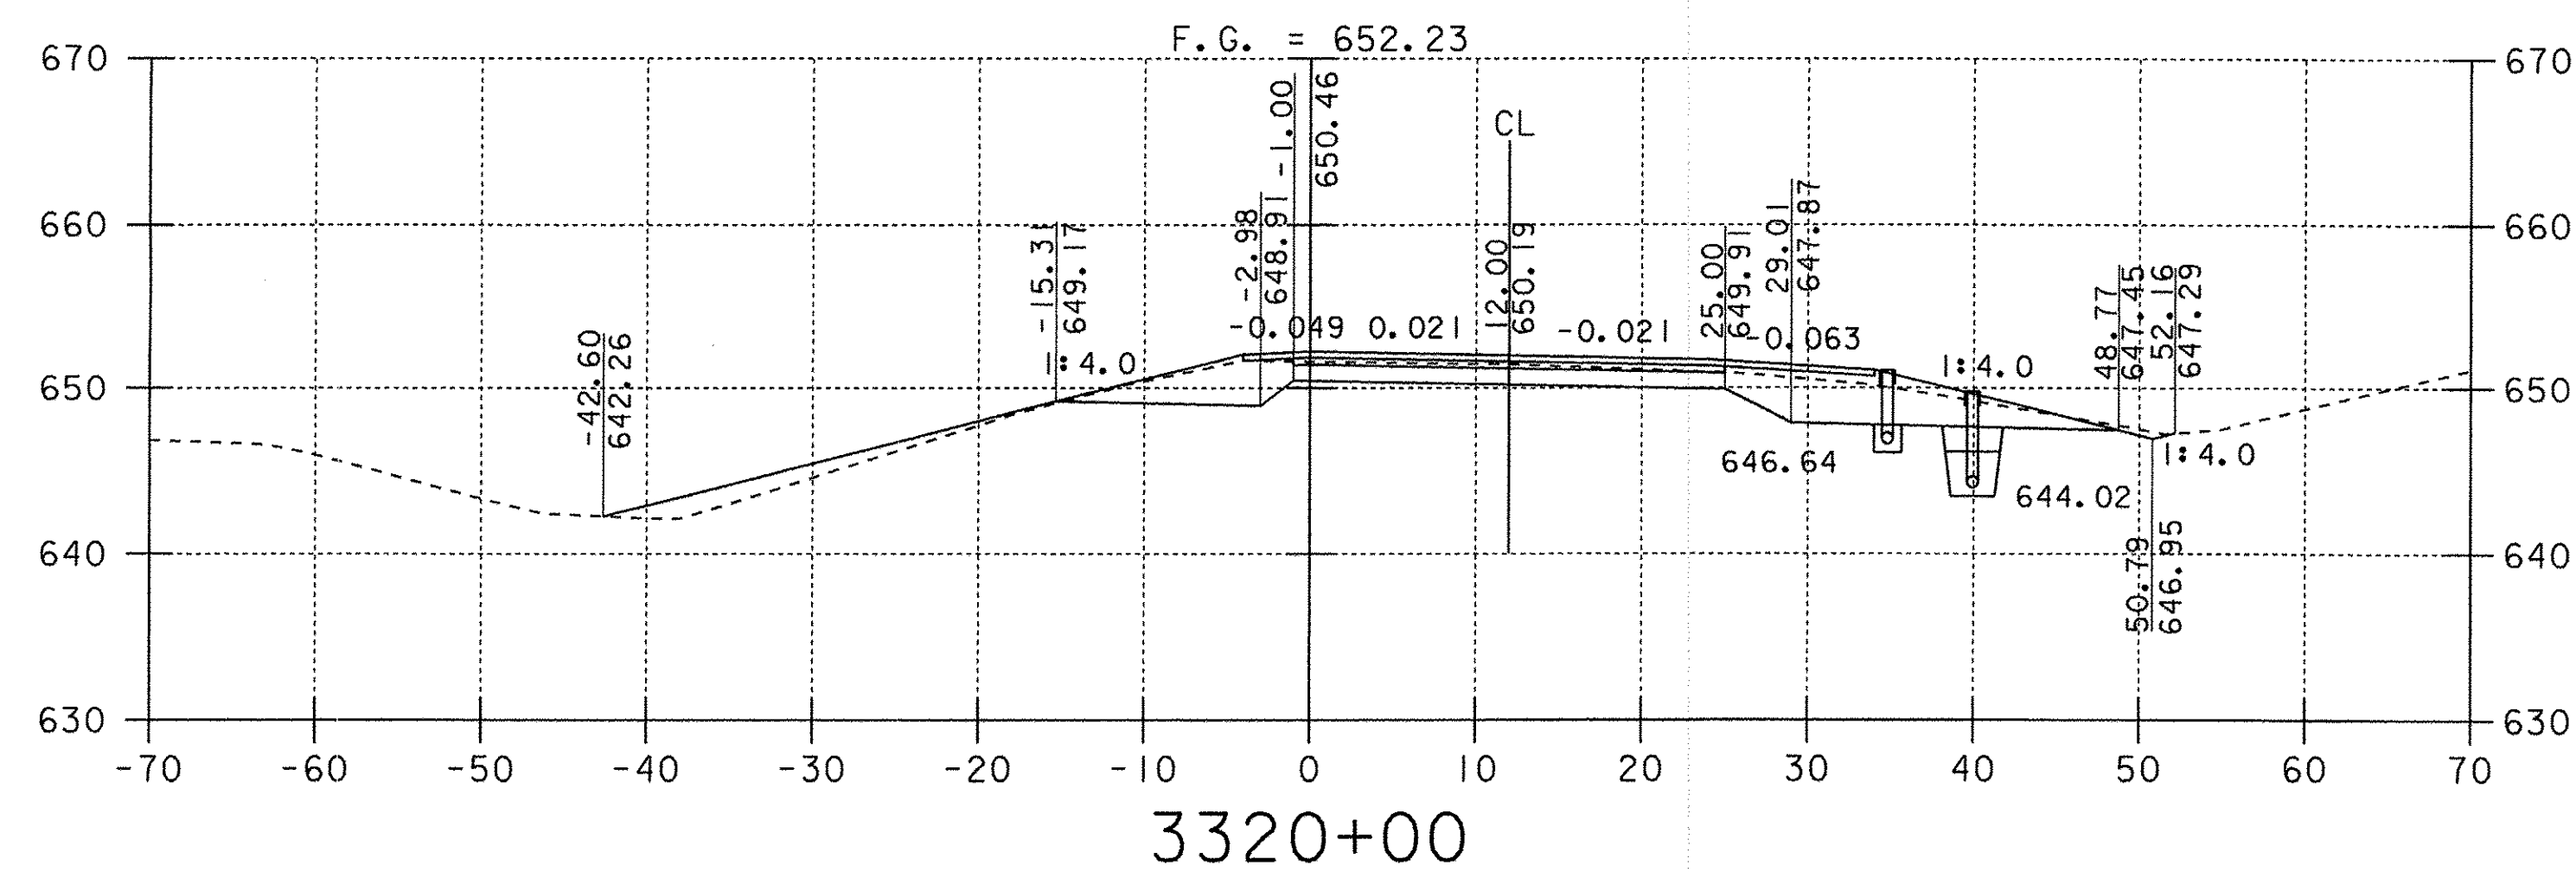

NOTE: OFFSET DISTANCES ARE MEASURED FROM THE GRADE LINE.

## NORTHBOUND CROSS SECTIONS

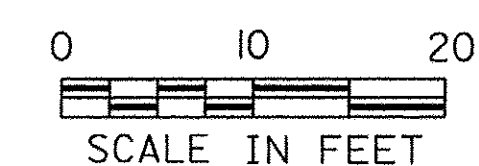

|                                                |                               |
|------------------------------------------------|-------------------------------|
| PROJECT:<br>FAIRFAX - FAIRFIELD - ST. ALBANS   | PROJECT NO. :<br>IM 089-3(27) |
| DESIGN FILE NAME: /87A007B/DESIGN/DA007XSL.DGN |                               |
| IPARM FILE NAME: DA007X05                      | PLOT DATE: 01-MAR-2002        |
| SURVEYED BY: ORVIS                             | SURVEY DATE: 6/98             |
| SQUAD LEADER: DELLA SANTA                      | DRAWN BY: SQUAD B             |
|                                                | SHEET: 344 OF 370             |