

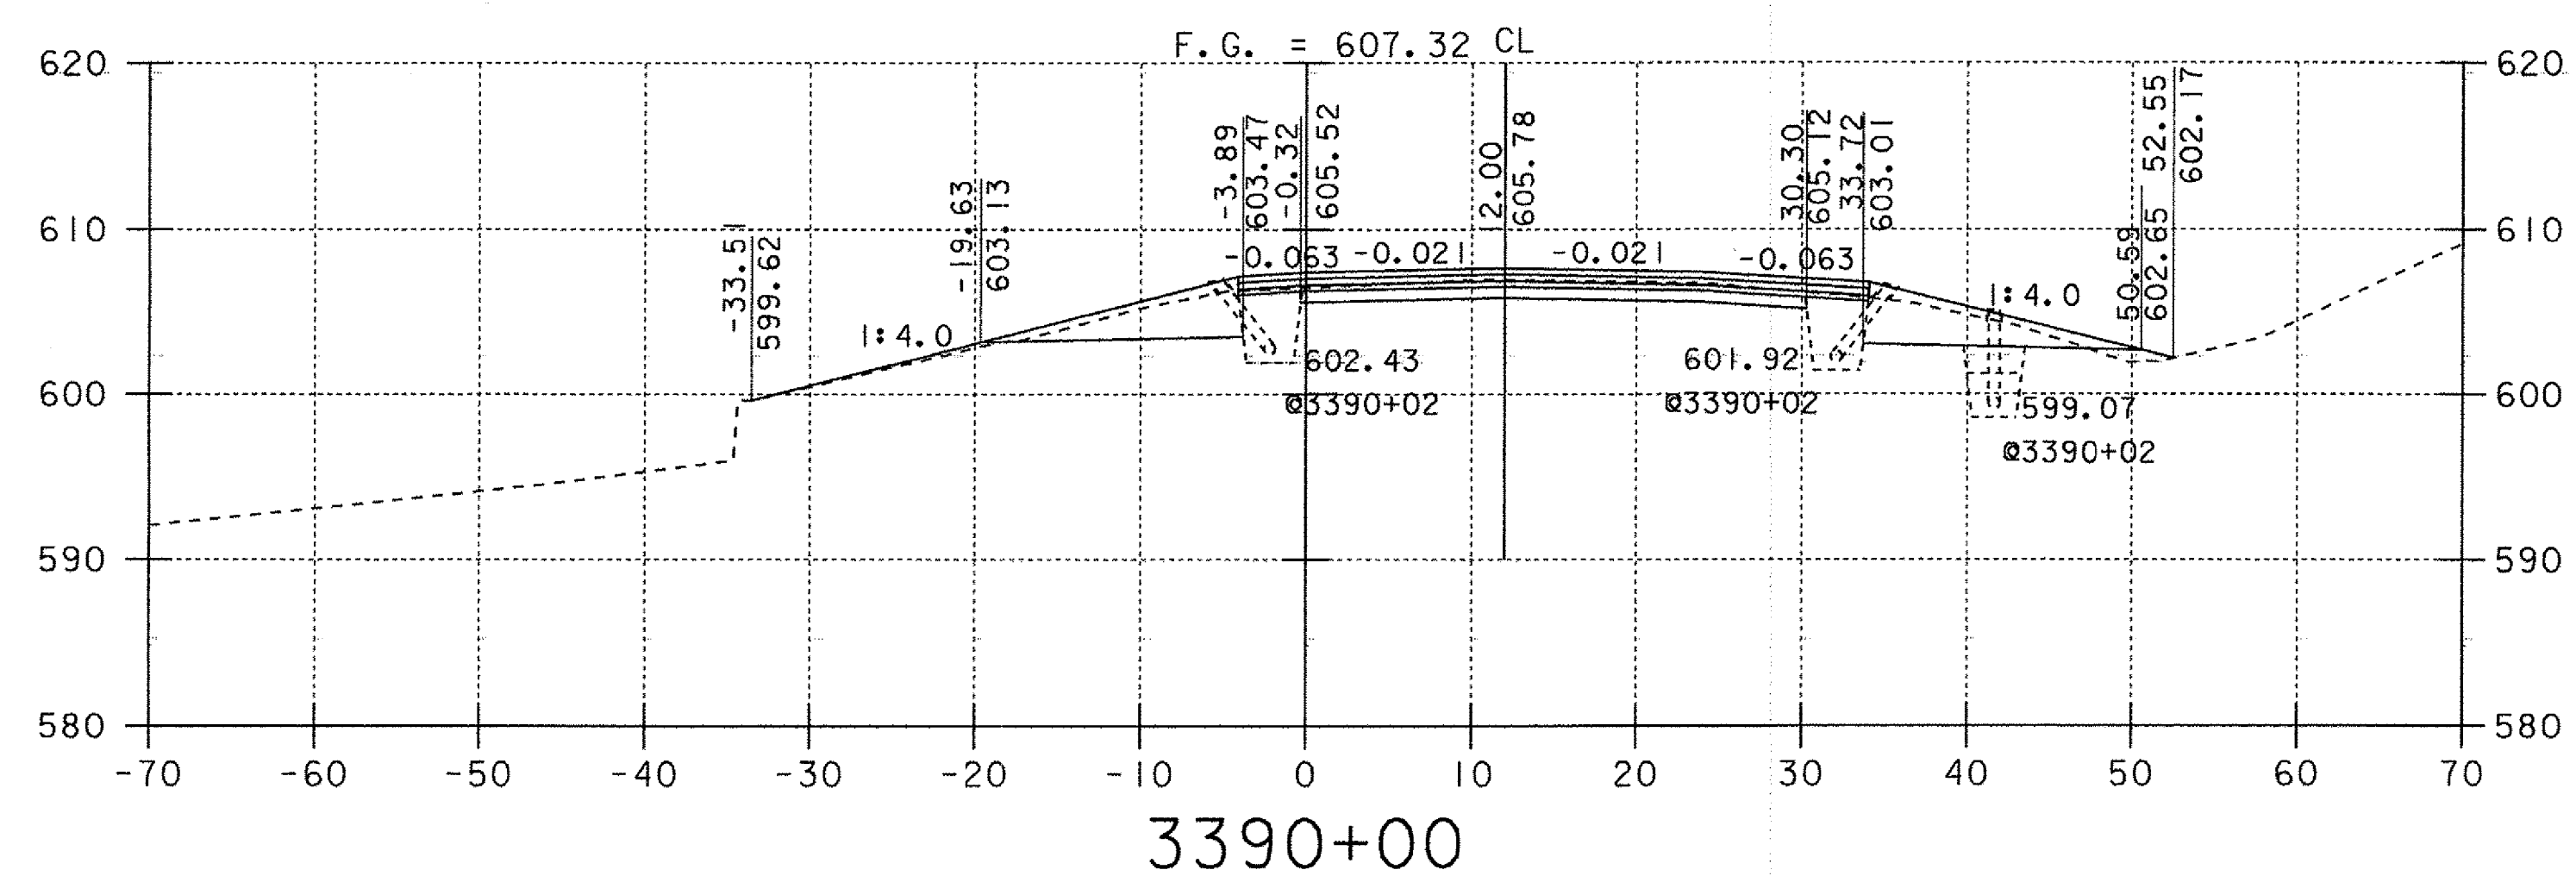


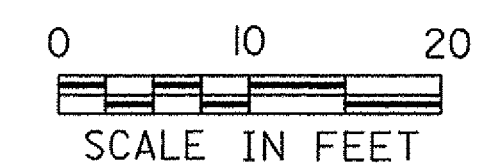

NORTHBOUND CROSS SECTIONS

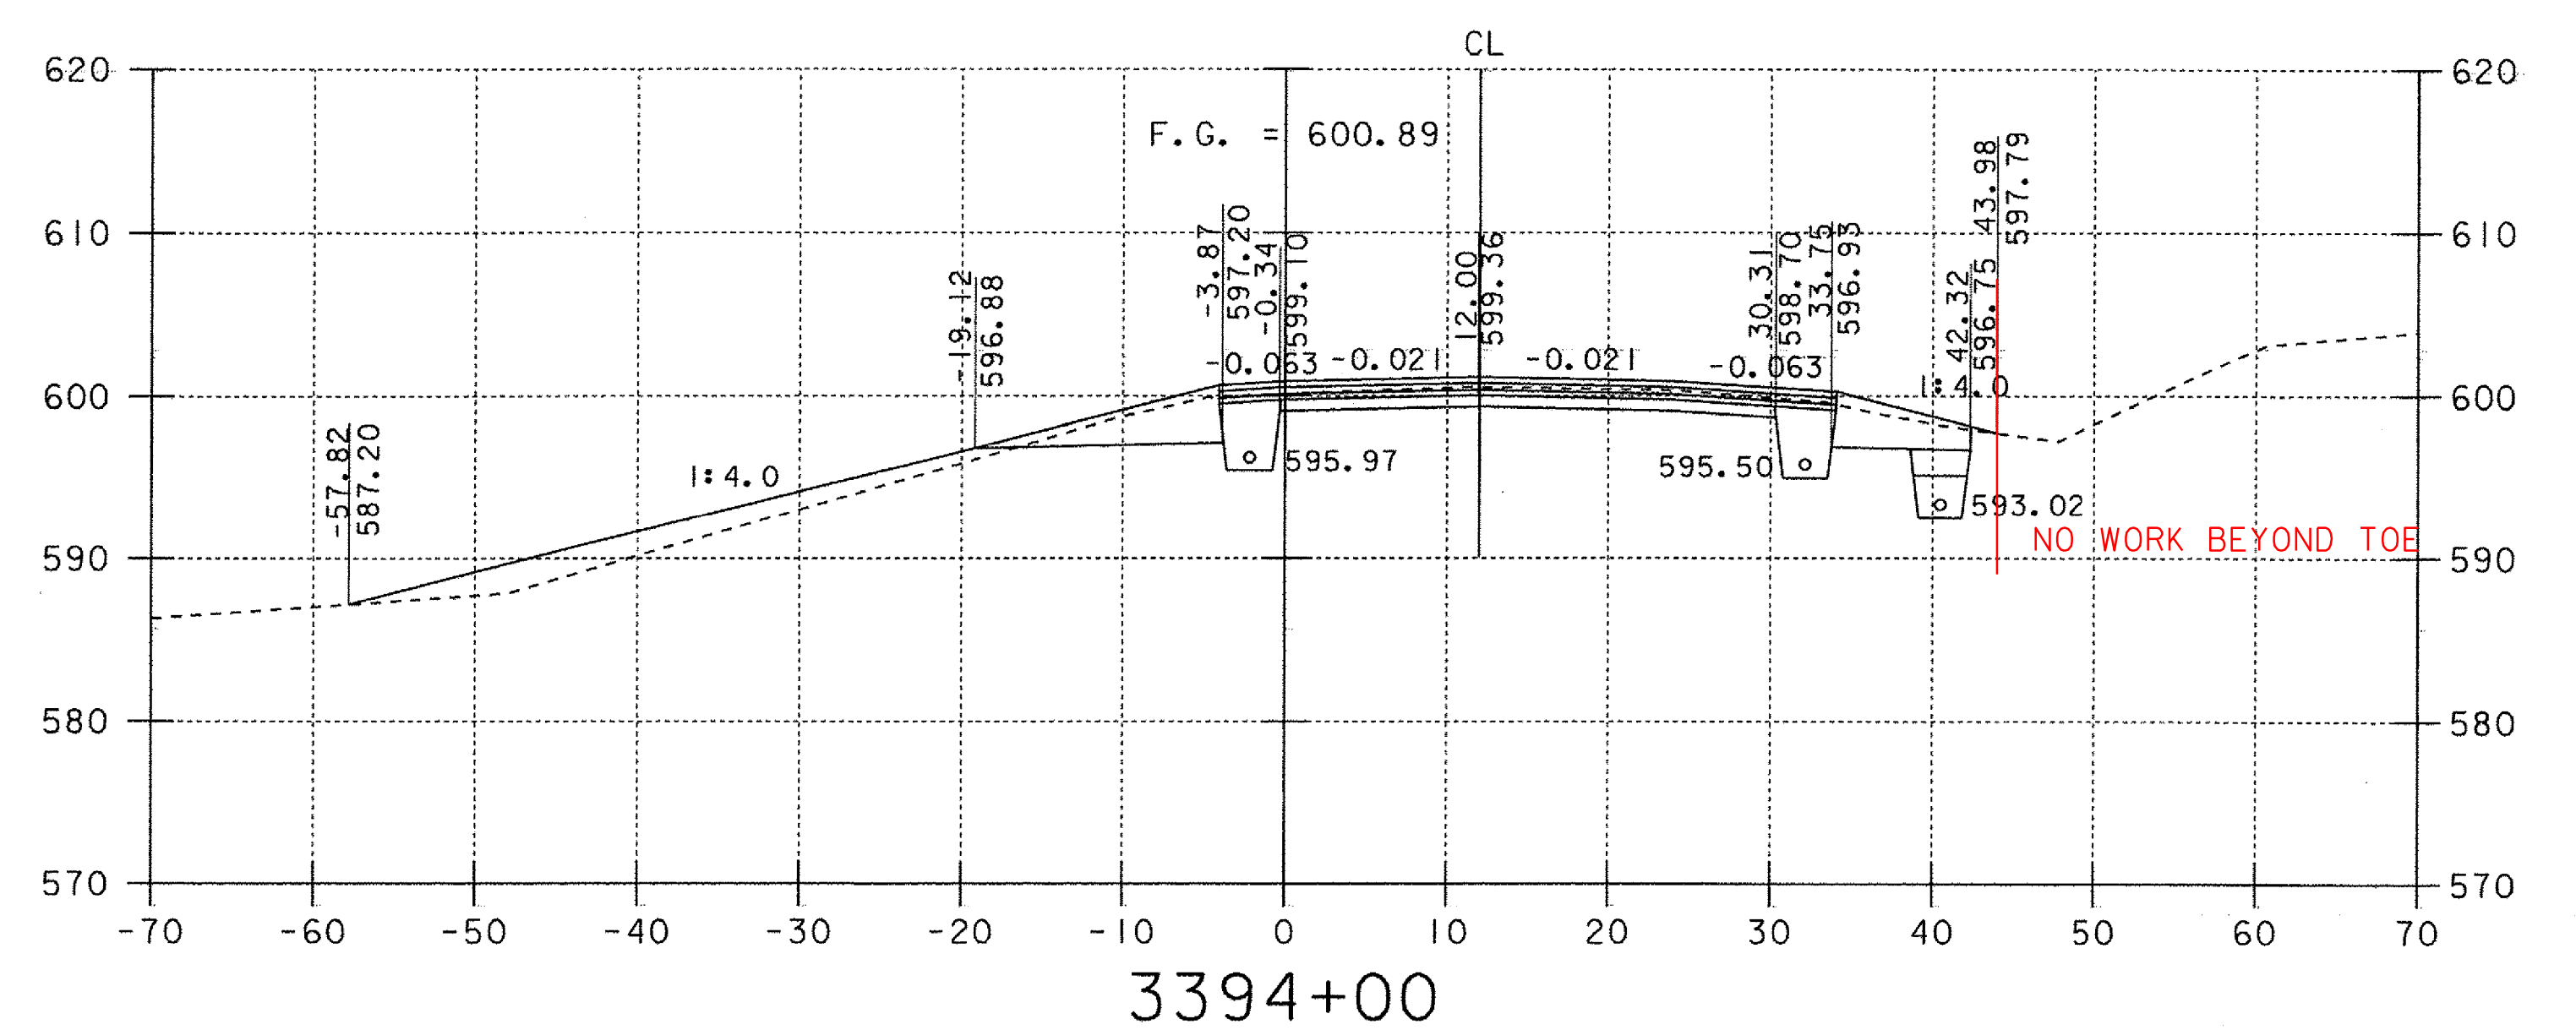

PROJECT:		PROJECT NO. :	
FAIRFAX - FAIRFIELD - ST. ALBANS		IM 089-3(27)	
DESIGN FILE NAME:	/78A007B/DESIGN/DA007XSL.DGN	PLOT DATE:	25-JAN-2002
IPARM FILE NAME:	DA007XI4	SURVEY DATE:	6/98
SURVEYED BY:	ORVIS	DRAWN BY:	SQUAD B
SQUAD LEADER:	DELLA SANTA	SHEET:	353 OF .370