


NOTE: OFFSET DISTANCES ARE MEASURED FROM THE GRADE LINE.

NORTHBOUND CROSS SECTIONS

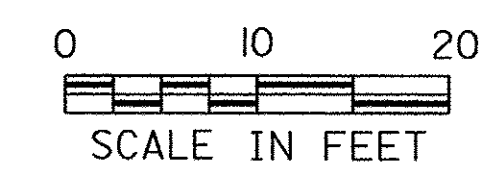

PROJECT: FAIRFAX - FAIRFIELD - ST. ALBANS		PROJECT NO.: IM 089-3(27)
DESIGN FILE NAME:	/87A007B/DESIGN/DA007XSI.DGN	PLOT DATE: 01-MAR-2002
IPARM FILE NAME:	DA007X16	SURVEY DATE: 6/98
SURVEYED BY:	ORVIS	DRAWN BY: SQUAD B
SQUAD LEADER:	DELLA SANTA	SHEET: 355 OF 370